

Kleinburg Glen - 10 - 1 - 38-6 Elev.B WYNDHAM
CENTRAL VAC AND WIRING

Inv.584	6 - THROUGHOUT - CAT 6 WIRING - UPGRADE AN OUTLET TO CAT 6 - GREAT ROOM, DEN (IN LIEU OF KITCHEN-DELETE KITCHEN CAT 5 WIRING), ALL BEDROOMS. Please see floor plan for locations.
Line7102	Note:
17Jun16 / 30Oct16	
Inv.584	1 - LAUNDRY: ADD SECURITY KEYPAD RIGHT OF DOOR. Please see floor plan for location
Line7111	Note:
17Jun16 / 30Oct16	
Inv.584	1 - GREAT ROOM: RELOCATE UPGRADED CAT 6 CABLE FROM KITCHEN TO ABOVE FIREPLACE APPROX 66" AFF.
Line8847	Note:
17Jun16 / 30Oct16	
Inv.584	3 - ALL BEDROOMS: ADD RG6 CABLE OUTLET. PLEASE SEE FLOORPLAN FOR LOCATIONS
Line8854	Note:
17Jun16 / 30Oct16	

DRYWALL

Inv.584	1 - SMOOTH CEILINGS - (2 - Story Design) SECOND FLOOR
Line8855	Note:
17Jun16 / 30Oct16	

ELECTRICAL

Inv.584	1 - GREAT ROOM: ADD 110V WALL RECEPTACLE ON NORMAL CIRCUIT - ABOVE FIREPLACE BESIDE STD CABLE APPROX 66" AFF Please see floor plan for location
Line7101	Note:
17Jun16 / 30Oct16	
Inv.584	1 - THROUGHOUT - 200 AMP ELECTRICAL SERVICE
Line7103	Note:
17Jun16 / 30Oct16	
Inv.584	1 - KITCHEN: KITCHEN CABINET STRIP VALANCE LIGHTS (UNDER CABINETS) - ROUGH - IN - DOES NOT INCLUDE (AND REQUIRES) KITCHEN UPGRADE PRICING. SWITCH TO BE ON BACKSPLASH, LEFT OF WALL OVEN.
Line7106	Note:
17Jun16 / 30Oct16	
Inv.584	1 - KITCHEN: RELOCATE OVEN TO LEFT OF FRIDGE. WILL BE A DOUBLE WALL OVEN. Please see floor plan for location. Cooktop to remain.
Line7114	Note:
17Jun16 / 30Oct16	
Inv.584	1 - MASTER BEDROOM: ADD 110V WALL RECEPTACLE ON NORMAL CIRCUIT - APPROX 54" AFF. PLEASE SEE FLOOR PLAN FOR LOCATION
Line7118	Note:
17Jun16 / 30Oct16	
Inv.584	1 - KITCHEN: 110V WALL RECEPTACLE ON DEDICATED CIRCUIT - GAS FIRED APPLIANCE - FOR AUX. EQUIPMENT - NOT A STOVE PLUG
Line8848	Note:
17Jun16 / 30Oct16	
Inv.584	1 - KITCHEN: ADD 110V WALL RECEPTACLE ON DEDICATED CIRCUIT - FOR MICROWAVE - MICROWAVE NOT INCLUDED. LOCATED ABOVE BACKSPLASH IN UPPER CABINETS LEFT OF HOODVENT. PLEASE SEE FLOORPLAN FOR LOCATION
Line8849	Note:
17Jun16 / 30Oct16	

Kleinburg Glen - 10 - 1 - 38-6 Elev.B WYNDHAM

Inv.584	1 - KITCHEN: 240V WALL RECEPTICAL ON DEDICATED CIRCUIT - FOR BUILT IN DOUBLE CONVECTION OVEN. Please see floorplan for location
Line8850	Note:
17Jun16 / 30Oct16	
Inv.584	1 - ROUGH - IN CEILING OUTLET ON SAME SWITCH - DOES NOT INCLUDE FIXTURE - OVER ISLAND LEFT SIDE. CONNECTED TO LEFT SIDE OVER ISLAND LIGHT
Line9305	Note:
17Jun16 / 30Oct16	
Inv.584	1 - KITCHEN: ROUGH - IN CEILING OUTLET & SWITCH (WITH COVER PLATE) - DOES NOT INCLUDE FIXTURE - OVER ISLAND RIGHT SIDE. CONNECTED TO RIGHT SIDE OVER ISLAND LIGHT
Line9304	Note:
17Jun16 / 30Oct16	
Inv.989	1 - INSTALL POTLIGHT IN SHOWER FOR BEDROOM 2 BATHROOM
Line14121	Note:
16Nov16 / 16Nov16	

EXTERIOR COLOURS

Inv.584	1 - EXTERIOR COLOUR PACKAGE 9
Line12207	Note:
17Jun16 / 30Oct16	

FRAMING

Inv.584	1 - KITCHEN: DELETE BULKHEAD IN KITCHEN. Furring panel and crown moulding are to be purchased at time of colours. Site approval is required and can change.
Line9306	Note:
17Jun16 / 30Oct16	
Inv.584	1 - MAIN FLOOR: STANDARD DOOR EXTENDED HEIGHT 96 INCH (PRICE PER DOOR) . x6 DOORS
Line12205	Note:
17Jun16 / 30Oct16	
Inv.584	1 - MAIN FLOOR: EXTENDED HEIGHT ARCHWAY (PRICE PER DOORWAY) - INCLUDE FRAMING NOTE. DINING ROOM ARCHWAY AND GREAT ROOM ARCHWAY
Line12206	Note:
17Jun16 / 30Oct16	
Inv.584	1 - BEDROOM 2: SHOWER IN LIEU OF TUB- FRAMED SHOWER ENCLOSURE WITH POTLIGHT
Line12208	Note:
17Jun16 / 30Oct16	

GLASS AND MIRROR

Inv.584	1 - BEDROOM 2: SHOWER IN LIEU OF TUB- FRAMED SHOWER ENCLOSURE WITH POTLIGHT
Line7110	Note:
17Jun16 / 30Oct16	

HVAC

Inv.584	1 - KITCHEN: GAS LINE ROUGH - GROUND FLOOR FOR FUTURE GAS COOKTOP. Please see floor plan for location
Line7104	Note:
17Jun16 / 30Oct16	

INTERIOR TRIM AND DOORS

Kleinburg Glen - 10 - 1 - 38-6 Elev.B WYNDHAM

Inv.584	6 - MAIN FLOOR: STANDARD DOOR EXTENDED HEIGHT 96 INCH (PRICE PER DOOR) . x6 DOORS
Line7112	Note:
17Jun16 / 30Oct16	
Inv.584	2 - MAIN FLOOR: EXTENDED HEIGHT ARCHWAY (PRICE PER DOORWAY) - INCLUDE FRAMING NOTE. DINING ROOM ARCHWAY AND GREAT ROOM ARCHWAY
Line7113	Note:
17Jun16 / 30Oct16	

KITCHEN AND BATH CABINETRY


Inv.584	1 - KITCHEN: RELOCATE OVEN TO LEFT OF FRIDGE. WILL BE A DOUBLE WALL OVEN. Please see floor plan for location. Cooktop to remain.
Line10185	Note:
17Jun16 / 30Oct16	

MISC.


Inv.584	1 - Purchaser has attended a Structural appointment at the Decor Centre & has DECLINED any additional upgrades and accepts and acknowledges that there will be no further structural changes/additions/deletions to be made upon signing on June 17, 2016.
Line7115	Note:
17Jun16 / 30Oct16	
Inv.584	1 - Purchasers are aware & accepts that ANY changes made to upgrades after signing this Purchasers Extra Form are subject to a minimum administration fee of \$500. PLUS a 10% holdback fee.
Line7116	Note:
17Jun16 / 30Oct16	
Inv.584	1 - BONUS PACKAGE: \$7500.00 (INCLUDING TAXES) WORTH OF UPGRADES FROM GOLD PARK HOMES DÉCOR CENTRE IS BEING APPLIED TOWARD THE STRUCTURAL APPOINTMENT. PURCHASER HAS A REMAINING AMOUNT OF \$00 (INCLUDING TAXES) TO BE USED TOWARD THE COLOUR APPOINTMENT.
Line7117	Note:
17Jun16 / 30Oct16	
Inv.584	1 - BALANCE AFTER CREDIT: \$ 10,630.85 DEPOSIT PAID BY MASTER CARD: \$ 10,630.85
Line8857	Note:
17Jun16 / 30Oct16	

PLUMBING

Inv.584	1 - KITCHEN: ROUGH - IN - WATERLINE FOR FRIDGE
Line8851	Note:
17Jun16 / 30Oct16	
Inv.584	1 - BEDROOM 2: SHOWER IN LIEU OF TUB- FRAMED SHOWER ENCLOSURE WITH POTLIGHT
Line12209	Note:
17Jun16 / 30Oct16	

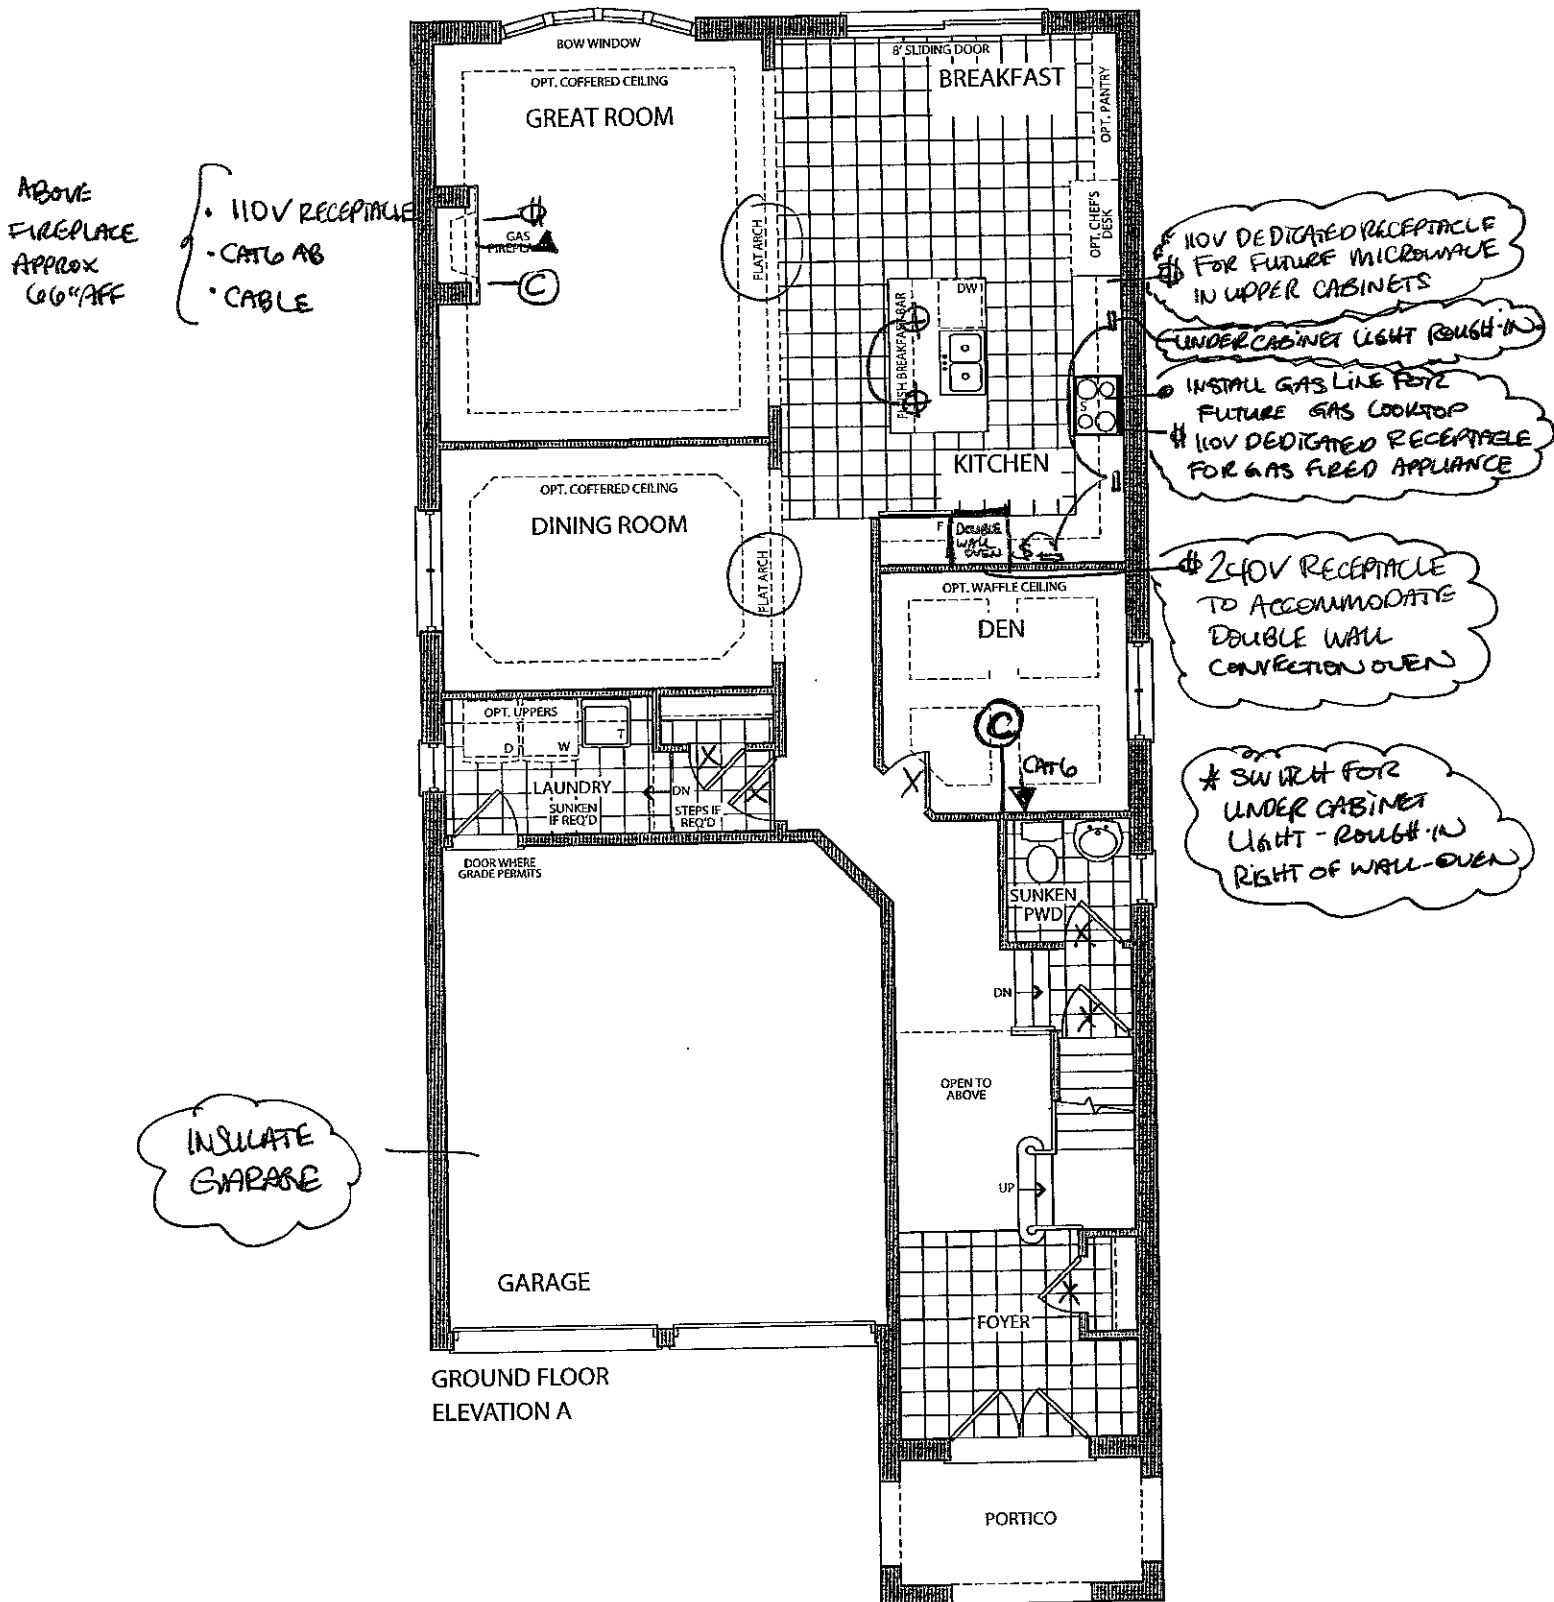


X EXTEND ARCADEWAYS + DOORWAYS TO 96"


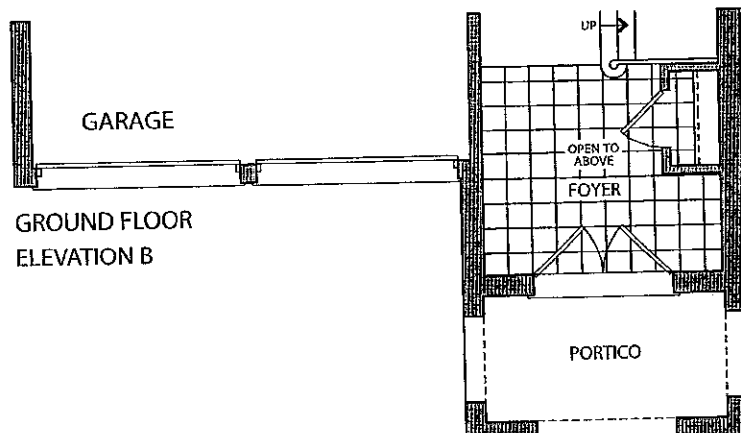


LOT 10
LN VN

July 26, 2016

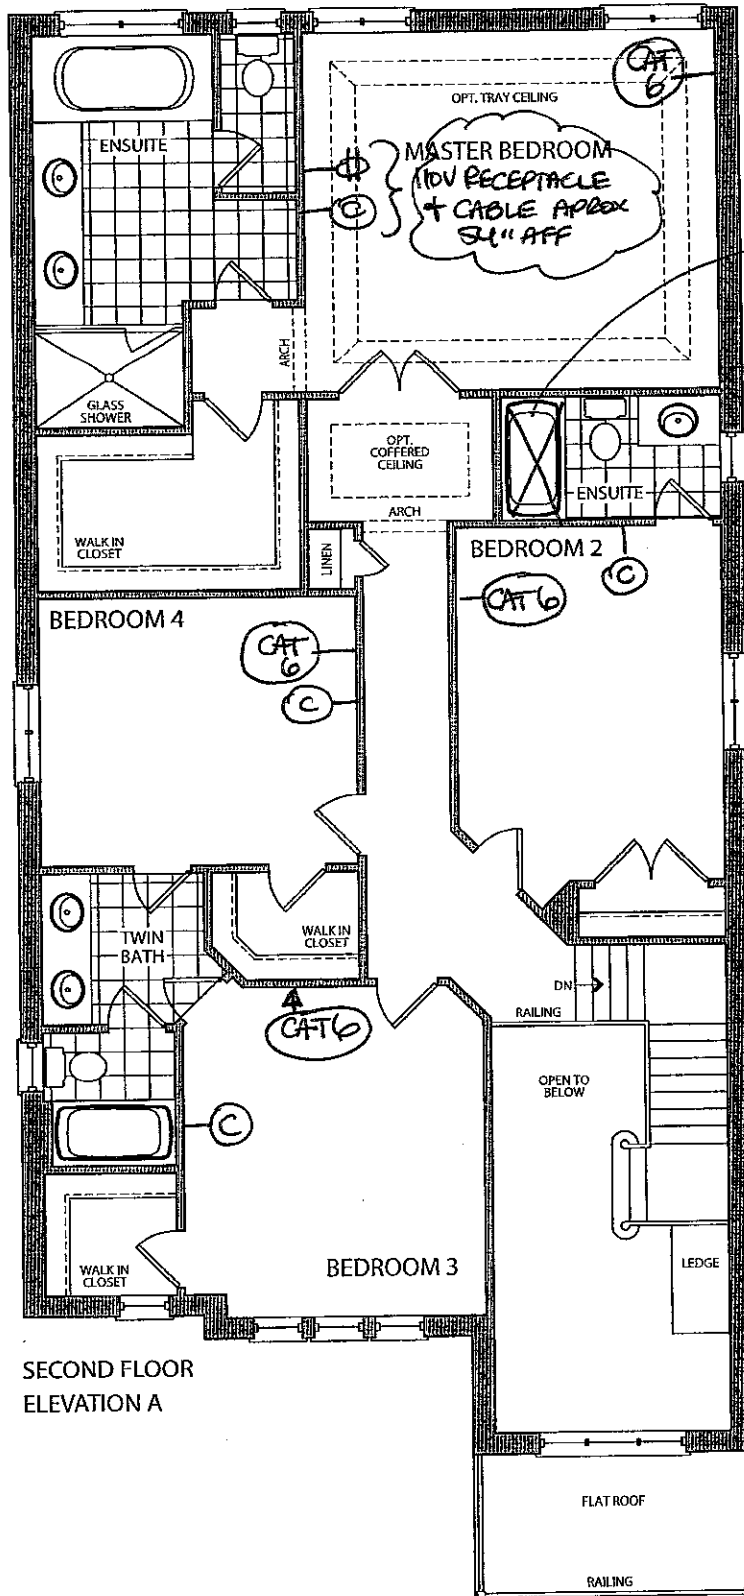

SECOND FLOOR
ELEVATION A

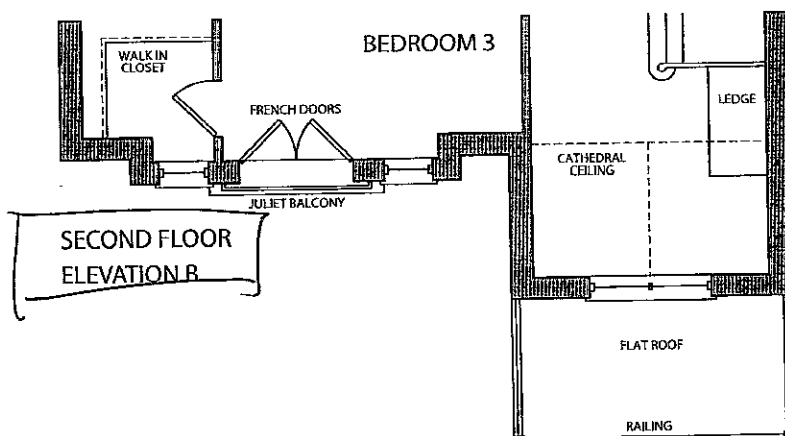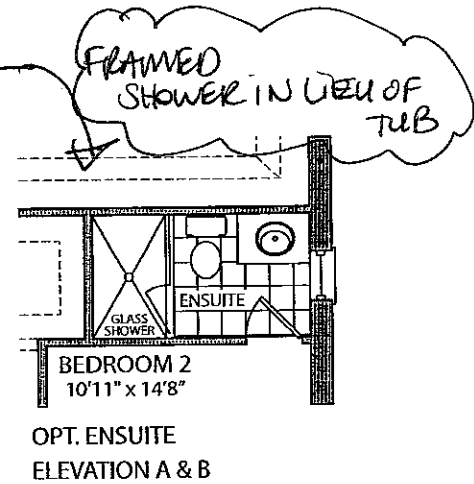

SECOND FLOOR
ELEVATION B

LOT 10
LN VN


July 26, 2016



the Wyndham

Elevation A • 2,951 sq.ft.

Elevation B • 2,954 sq.ft.

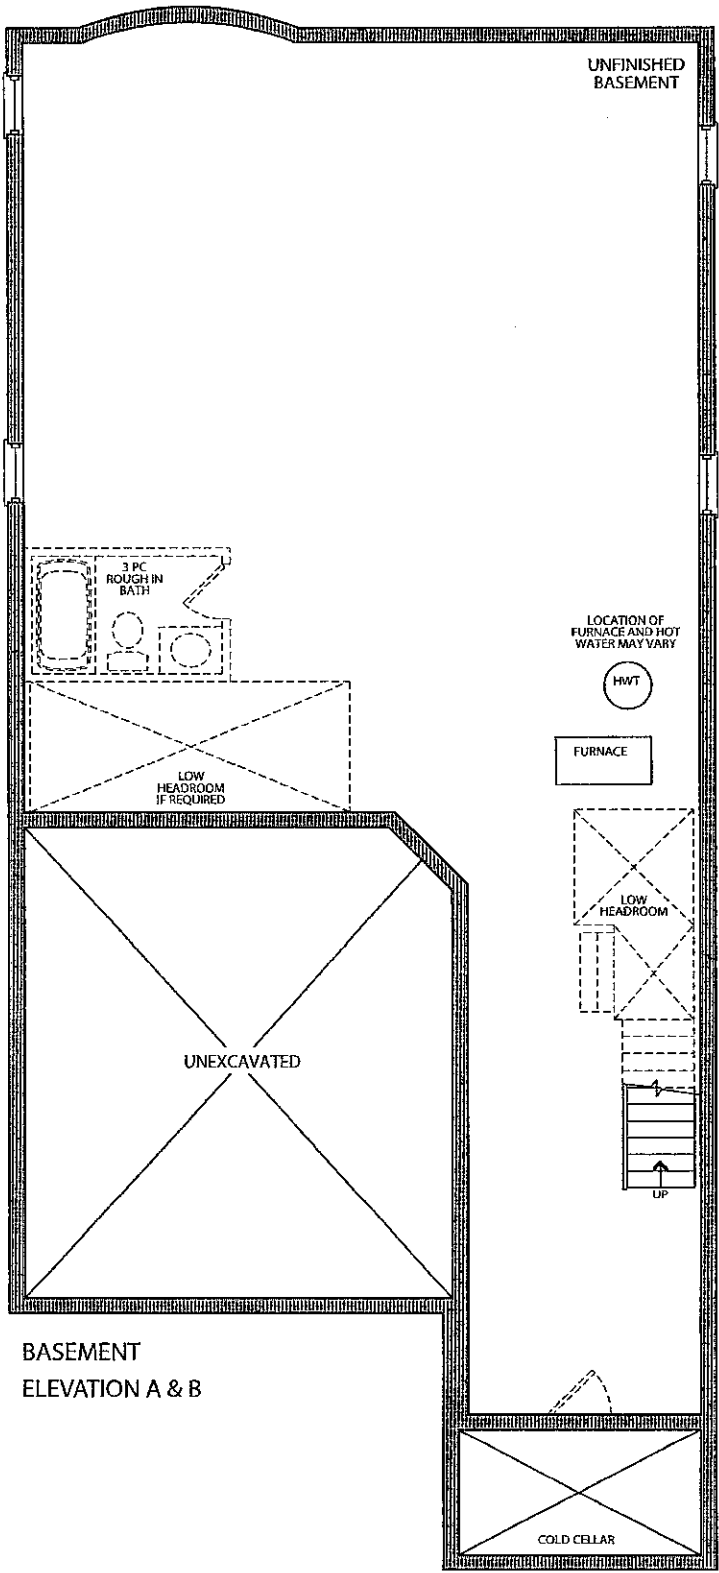

Lot 10
LN VN
July 26, 2016

Prices, figures, illustrations, sizes, features and finishes are subject to change without notice. E.&O.E. Areas and dimensions are approximate and actual usable floor space may vary from the stated area. Layout may be reverse of the unit purchased. E. & O.E.





Stacey Carlete
Project Coordinator



Claude Azzopardi
Contracts Manager



Nancy Martini
Corporate Controller



38.1 The Hampton			
Elevation	Circle One	A	2339.9 Square Feet
		B	2327.8 Square Feet
Taller Ceilings	Circle All that Apply	GFTC	9' Ceilings Ground Floor
		MFTC	10' Ceilings Main Floor
		SFTC	9' Ceilings Second Floor
Optional Layouts	Circle All that Apply		

38.2 The Kingston			
Elevation	Circle One	A	2445.9 Square Feet
		B	2445.9 Square Feet
Taller Ceilings	Circle All that Apply	GFTC	9' Ceilings Ground Floor
		MFTC	10' Ceilings Main Floor
		SFTC	9' Ceilings Second Floor
Optional Layouts	Circle All that Apply	SFA1	SECOND FLOOR Shower in Lieu of Tub (Bedroom 2)

38.3 The Birkdale			
Elevation	Circle One	A	2574.1 Square Feet
		B	2575.5 Square Feet
Taller Ceilings	Circle All that Apply	GFTC	9' Ceilings Ground Floor
		MFTC	10' Ceilings Main Floor
		SFTC	9' Ceilings Second Floor
Optional Layouts	Circle All that Apply	SFA1	SECOND FLOOR Shower in Lieu of Tub (Bedroom 2)

38.4 The Bridgeport			
Elevation	Circle One	A	2723.2 Square Feet
		B	2762.0 Square Feet
Taller Ceilings	Circle All that Apply	GFTC	9' Ceilings Ground Floor
		MFTC	10' Ceilings Main Floor
		SFTC	9' Ceilings Second Floor
Optional Layouts	Circle All that Apply	SFA3	SECOND FLOOR Shower in Lieu of Tub (Twin Bath)

38.5 The Rosemont			
Elevation	Circle One	A	2804.9 Square Feet
		B	2804.5 Square Feet
Taller Ceilings	Circle All that Apply	GFTC	9' Ceilings Ground Floor
		MFTC	10' Ceilings Main Floor
		SFTC	9' Ceilings Second Floor
Optional Layouts	Circle All that Apply	SFA1	SECOND FLOOR Shower in Lieu of Tub (Bedroom 2)
		SFA3	SECOND FLOOR Shower in Lieu of Tub (Twin Bath)
		SFA5	SECOND FLOOR Additional Bedroom

38.6 The Wyndham			
Elevation	Circle One	A	2893.5 Square Feet
		B	2896.0 Square Feet
Taller Ceilings	Circle All that Apply	GFTC	9' Ceilings Ground Floor
		MFTC	10' Ceilings Main Floor
		SFTC	9' Ceilings Second Floor
Optional Layouts	Circle All that Apply	SFA1	SECOND FLOOR Shower in Lieu of Tub (Bedroom 2)
		SFA3	SECOND FLOOR Shower in Lieu of Tub (Twin Bath)
		SFA5	SECOND FLOOR Additional Bedroom

LOT 10³
LN VN

July 26, 2016