

Kleinburg Glen - 11 - 1 - 38-5 Elev.B ROSEMONT
CENTRAL VAC AND WIRING

Inv.667	2 - LAUNDRY & MASTER BEDROOM: ROUGH - IN FOR EXTRA SECURITY KEY PAD
Line8695	Note:
15Jul16 / 30Sep16	
Inv.667	1 - DEN: LOCATE STANDARD RG6 CABLE TO DEN, CENTER ON WALL BEHIND POWDER ROOM BESIDE STANDARD 110V RECEPTACLE. PLEASE SEE FLOORPLAN FOR LOCATION.
Line8696	Note:
15Jul16 / 30Sep16	
Inv.667	1 - CONDUIT PIPE - FROM ATTIC TO ELECTRICAL PANEL - PLEASE RUN A STRAIGHT LINE FROM ATTIC TO ELECTRICAL PANEL
Line8699	Note:
15Jul16 / 30Sep16	

DRYWALL

Inv.667	1 - SMOOTH CEILINGS - (2 - Story Design) SECOND FLOOR
Line8708	Note:
15Jul16 / 30Sep16	

ELECTRICAL

Inv.667	1 - KITCHEN: 110V WALL RECEPTACLE ON DEDICATED CIRCUIT - GAS FIRED APPLIANCE - FOR AUX. EQUIPMENT - NOT A STOVE PLUG
Line8663	Note:
15Jul16 / 30Sep16	
Inv.667	1 - KITCHEN: RELOCATE KITCHEN LIGHT CENTERED OVER BREAKFAST BAR
Line8682	Note:
15Jul16 / 30Sep16	
Inv.667	1 - BREAKFAST AREA: PLEASE LOCATE LIGHT CENTERED IN BREAKFAST AREA. PLEASE SEE FLOORPLAN FOR LOCATION
Line8683	Note:
15Jul16 / 30Sep16	
Inv.667	1 - KITCHEN: 240V RECEPTACLE ON DEDICATED CIRCUIT FOR DOUBLE WALL OVEN. PLEASE SEE FLOORPLAN FOR LOCATION
Line8686	Note:
15Jul16 / 30Sep16	
Inv.667	2 - KITCHEN: 110V WALL RECEPTACLE ON NORMAL CIRCUIT - x 2 CENTERED IN PANTY. PANTRY TO BE LEFT OPEN IN CENTER WITH COUNTERTOP. RECEPTACLES TO BE INSTALLED AT APPROX 46" AFF.
Line8692	Note:
15Jul16 / 30Sep16	
Inv.667	1 - GREAT ROOM: RELOCATE RECEPTACLE TO CENTER OF EXTERIOR WALL AT STANDARD HEIGHT. PLEASE SEE FLOORPLAN FOR LOCATION
Line8693	Note:
15Jul16 / 30Sep16	
Inv.667	1 - DINING ROOM: PLEASE CENTER CEILING LIGHT
Line8694	Note:
15Jul16 / 30Sep16	
Inv.667	1 - 200 AMP ELECTRICAL SERVICE
Line8700	Note:
15Jul16 / 30Sep16	

EXTERIOR COLOURS

Kleinburg Glen - 11 - 1 - 38-5 Elev.B ROSEMONT

Inv.667	1 - EXTERIOR COLOUR PACKAGE 7
Line12167	Note:
15Jul16 / 30Sep16	

FRAMING

Inv.667	1 - STANDARD DOOR EXTENDED HEIGHT 96 INCH (PRICE PER DOOR) - GROUND FLOOR 2 STOREY MODELS
Line12168	Note:
15Jul16 / 30Sep16	

Inv.667	1 - MAIN FLOOR: EXTENDED HEIGHT ARCHWAY (PRICE PER DOORWAY) - INCLUDE FRAMING NOTE
Line12169	Note:
15Jul16 / 30Sep16	

GLASS AND MIRROR

Inv.667	1 - MASTER ENSUITE: CONVERT FRAMED SHOWER TO 10MM FRAMLESS SHOWER ENCLOSURE WITH DOOR AND 10MM SIDE PANEL
Line8705	Note:
15Jul16 / 30Sep16	

HVAC

Inv.667	1 - KITCHEN: GAS LINE ROUGH - GROUND FLOOR. PLEASE SEE FLOORPLAN FOR LOCATION
Line8664	Note:
15Jul16 / 30Sep16	

Inv.667	1 - KITCHEN: UPGRADE VENTING FOR STOVE TO 8 INCH PIPE EXTERIOR WALL
Line8681	Note:
15Jul16 / 30Sep16	

INTERIOR TRIM AND DOORS

Inv.667	4 - MAIN FLOOR: EXTENDED HEIGHT ARCHWAY (PRICE PER DOORWAY) - INCLUDE FRAMING NOTE
Line8703	Note:
15Jul16 / 30Sep16	

Inv.667	8 - STANDARD DOOR EXTENDED HEIGHT 96 INCH (PRICE PER DOOR) - GROUND FLOOR 2 STOREY MODELS
Line8704	Note:
15Jul16 / 30Sep16	

MISC.

Inv.667	1 - Purchaser has attended a Structural appointment at the Decor Centre & has DECLINED any additional upgrades and accepts and acknowledges that there will be no further structural changes/additions/deletions to be made upon signing on August 9, 2016.
Line8709	Note:
15Jul16 / 30Sep16	

Inv.667	1 - Purchasers are aware & accepts that ANY changes made to upgrades after signing this Purchasers Extra Form are subject to a minimum administration fee of \$500. PLUS a 10% holdback fee.
Line8710	Note:
15Jul16 / 30Sep16	

Kleinburg Glen - 11 - 1 - 38-5 Elev.B ROSEMONT

Inv.667	1 - BONUS PACKAGE: \$4,500.00 (INCLUDING TAXES) WORTH OF UPGRADES FROM GOLD PARK HOMES DÉCOR CENTRE IS BEING APPLIED TOWARD THE STRUCTURAL APPOINTMENT. PURCHASER HAS A REMAINING AMOUNT OF \$3000.00 (INCLUDING TAXES) TO BE USED TOWARD THE COLOUR APPOINTMENT.
Line8711	Note:
15Jul16 / 30Sep16	
Inv.667	1 - Balance after \$4,500.00 credit \$13,037.60
	50% Paid by cheque \$6,518.80
	50% Applied to Mortgage \$6,518.80
Line8712	Note:
15Jul16 / 30Sep16	

PLUMBING


Inv.667	1 - KITCHEN ROUGH - IN - WATERLINE FOR FRIDGE. PLEASE SEE FLOORPLAN FOR LOCATION
Line8691	Note:
15Jul16 / 30Sep16	
Inv.667	1 - GARAGE: PLEASE RELOCATION HOSE BIB IN GARAGE TO FRONT RIGHT SIDE. SEE FLOORPLAN FOR LOCATION
Line8698	Note:
15Jul16 / 30Sep16	
Inv.667	1 - REAR OF HOUSE: HOSE BIB - STANDARD TO UPGRADED WITH HOT AND COLD WATER VALVE
Line8702	Note:
15Jul16 / 30Sep16	
Inv.667	1 - MASTER ENSUITE SHOWER: ROUGH - IN FOR RAINSHOWER HEAD - SHOWER HEAD NOT INCLUDED AND MUST BE PURCHASED
Line8706	Note:
15Jul16 / 30Sep16	
Inv.667	1 - BASEMENT: ADD BACKFLOW PREVENTER
Line10151	Note:
15Jul16 / 30Sep16	

WINDOWS - BASEMENT

Inv.667	2 - BASEMENT: EXTRA TO BE REFUNDED DUE TO LOB CONDITION
Line9956	Note:
15Jul16 / 30Sep16	
Inv.667	2 - BASEMENT WINDOWS - EXTRA TO BE REFUNDED DUE TO LOB CONDITION
Line9955	Note:
15Jul16 / 30Sep16	


Elevation A • 2,861 sq.ft.

Elevation B • 2,861 sq.ft.

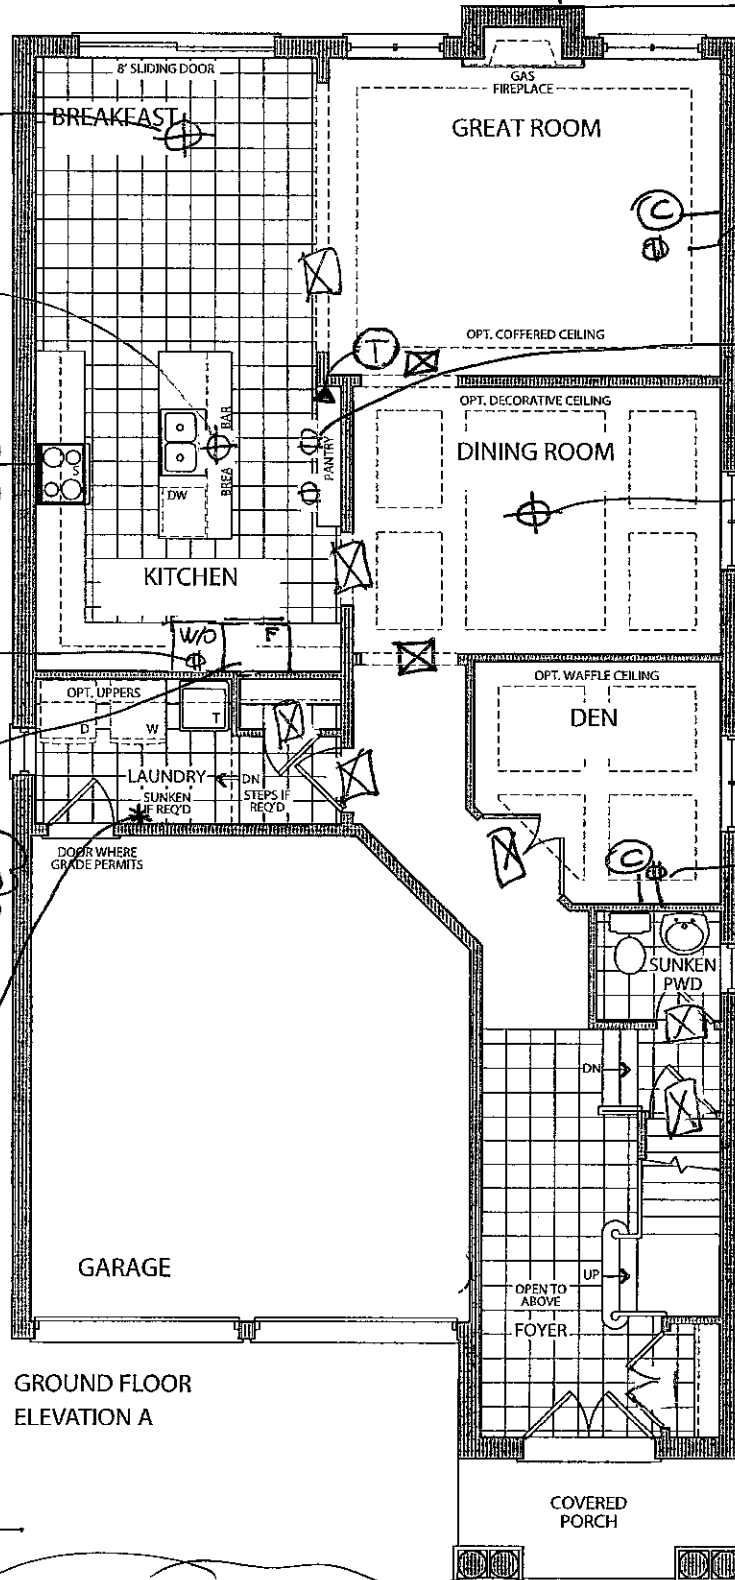

GROUND FLOOR
ELEVATION A

GROUND FLOOR
ELEVATION B



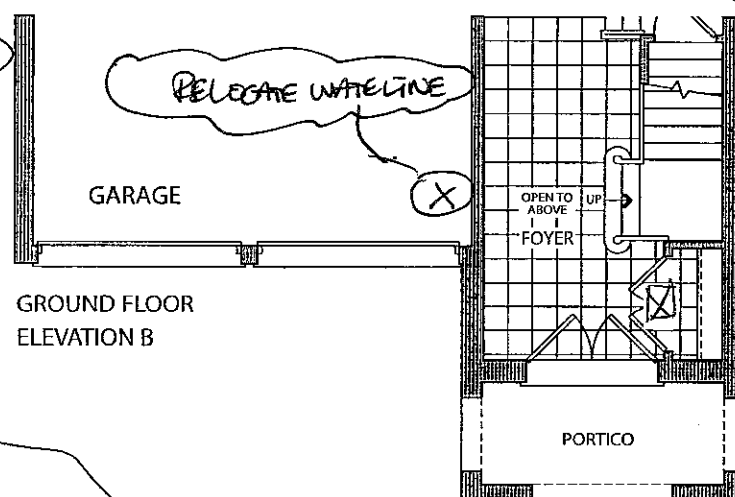


LOT 11

AUG. 10. 2016

Elevation A • 2,861 sq.ft.

Elevation B • 2,861 sq.ft.

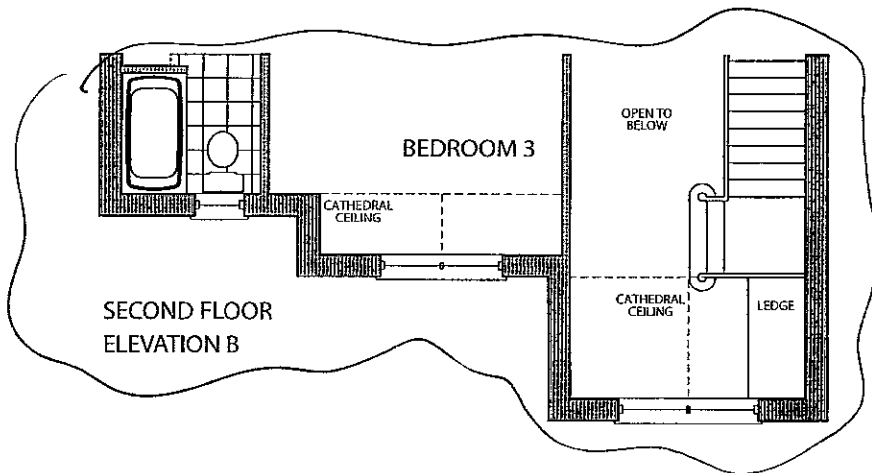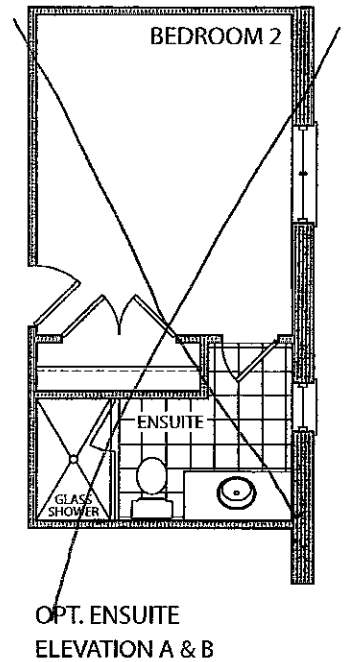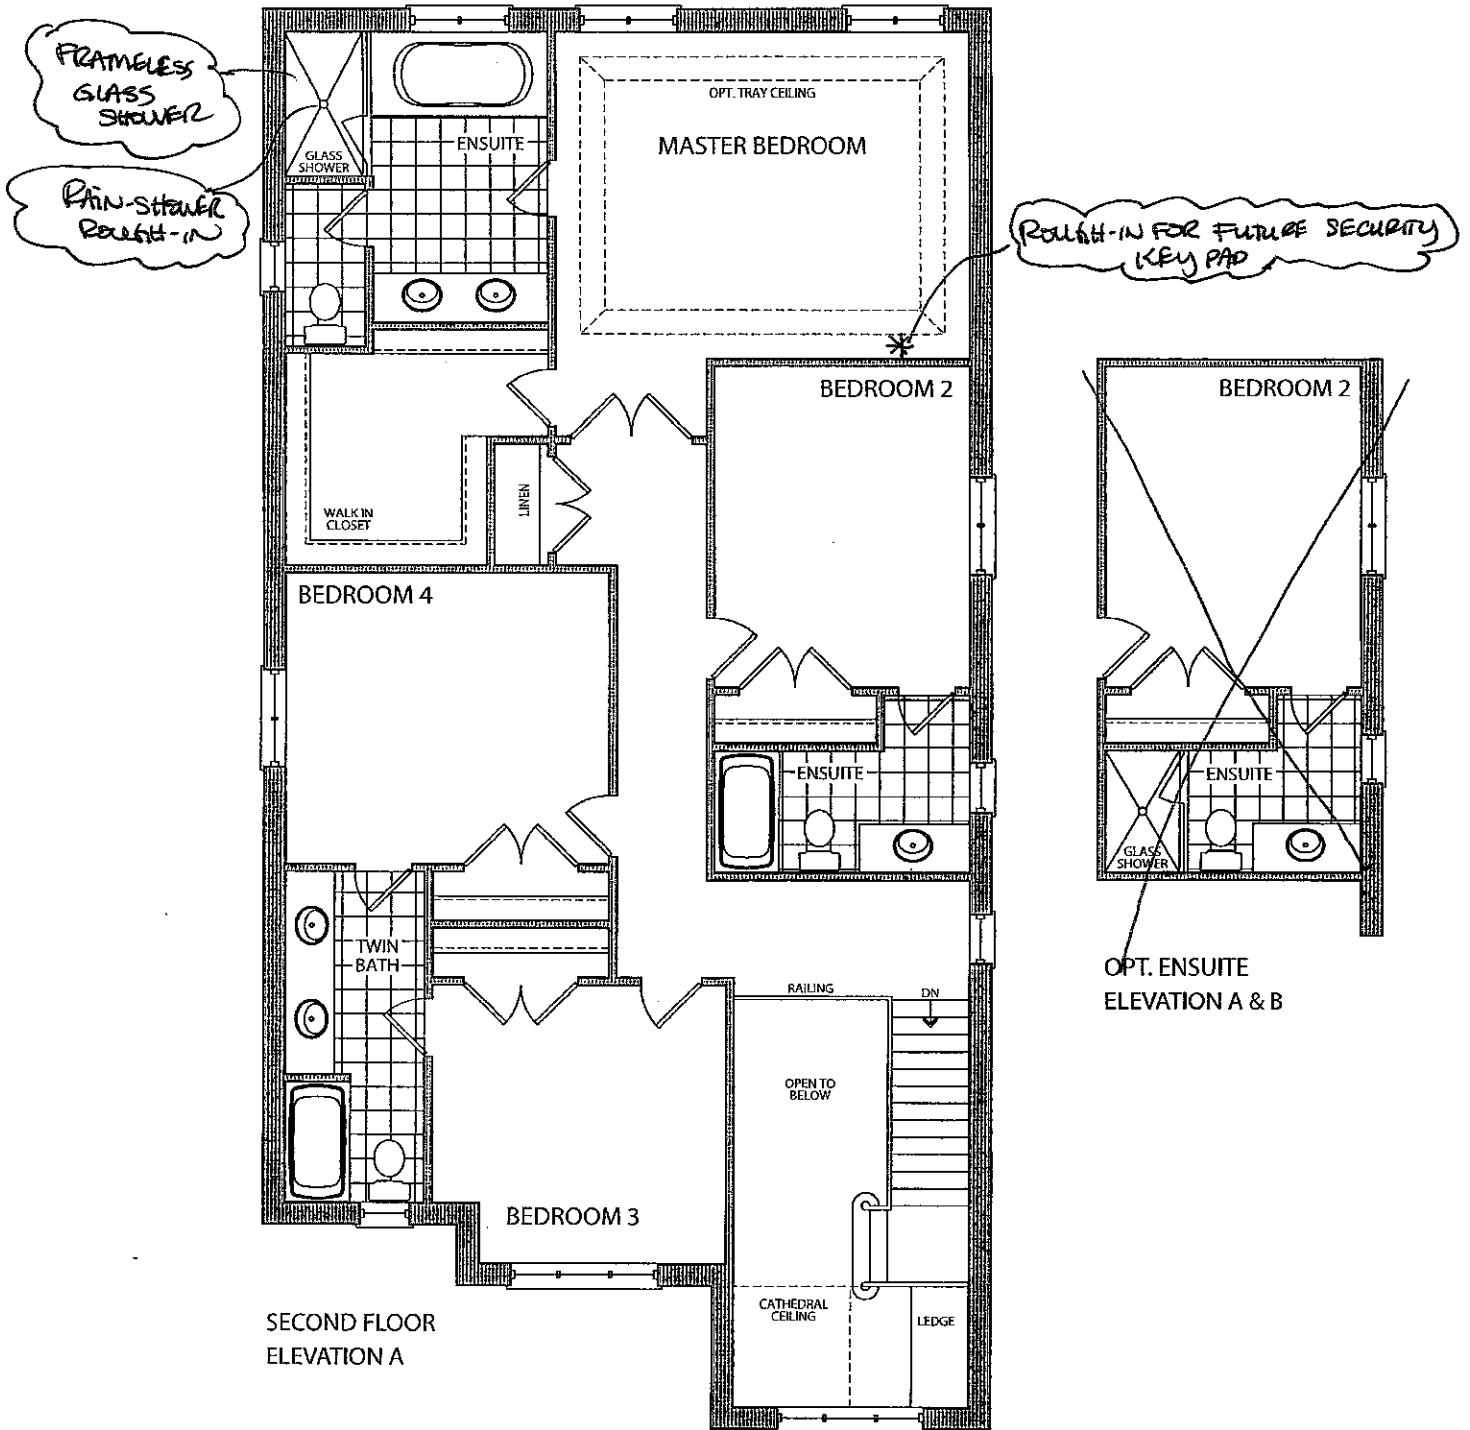

LOT 11

[Signature]

AUG. 10. 2016

SMOOTH CEILINGS



Stacey Carlete
Project Coordinator



Claude Azzopardi
Contracts Manager



Nancy Martini
Corporate Controller



38.1 The Hampton			
Elevation	Circle One	A	2339.9 Square Feet
		B	2327.8 Square Feet
Taller Ceilings	Circle All that Apply	GFTC	9' Ceilings Ground Floor
		MFTC	10' Ceilings Main Floor
		SFTC	9' Ceilings Second Floor
Optional Layouts	Circle All that Apply		

38.2 The Kingston			
Elevation	Circle One	A	2445.9 Square Feet
		B	2445.9 Square Feet
Taller Ceilings	Circle All that Apply	GFTC	9' Ceilings Ground Floor
		MFTC	10' Ceilings Main Floor
		SFTC	9' Ceilings Second Floor
Optional Layouts	Circle All that Apply	SFA1	SECOND FLOOR Shower in Lieu of Tub (Bedroom 2)

38.3 The Birkdale			
Elevation	Circle One	A	2574.1 Square Feet
		B	2575.5 Square Feet
Taller Ceilings	Circle All that Apply	GFTC	9' Ceilings Ground Floor
		MFTC	10' Ceilings Main Floor
		SFTC	9' Ceilings Second Floor
Optional Layouts	Circle All that Apply	SFA1	SECOND FLOOR Shower in Lieu of Tub (Bedroom 2)

38.4 The Bridgeport			
Elevation	Circle One	A	2723.2 Square Feet
		B	2762.0 Square Feet
Taller Ceilings	Circle All that Apply	GFTC	9' Ceilings Ground Floor
		MFTC	10' Ceilings Main Floor
		SFTC	9' Ceilings Second Floor
Optional Layouts	Circle All that Apply	SFA3	SECOND FLOOR Shower in Lieu of Tub (Twin Bath)


38.5 The Rosemont			
Elevation	Circle One	A	2804.9 Square Feet
		B	2804.5 Square Feet
Taller Ceilings	Circle All that Apply	GFTC	9' Ceilings Ground Floor
		MFTC	10' Ceilings Main Floor
		SFTC	9' Ceilings Second Floor
Optional Layouts	Circle All that Apply	SFA1	SECOND FLOOR Shower in Lieu of Tub (Bedroom 2)
		SFA3	SECOND FLOOR Shower in Lieu of Tub (Twin Bath)
		SFA5	SECOND FLOOR Additional Bedroom

38.6 The Wyndham			
Elevation	Circle One	A	2893.5 Square Feet
		B	2896.0 Square Feet
Taller Ceilings	Circle All that Apply	GFTC	9' Ceilings Ground Floor
		MFTC	10' Ceilings Main Floor
		SFTC	9' Ceilings Second Floor
Optional Layouts	Circle All that Apply	SFA1	SECOND FLOOR Shower in Lieu of Tub (Bedroom 2)
		SFA3	SECOND FLOOR Shower in Lieu of Tub (Twin Bath)
		SFA5	SECOND FLOOR Additional Bedroom

LOT 11

AUG. 10, 2016

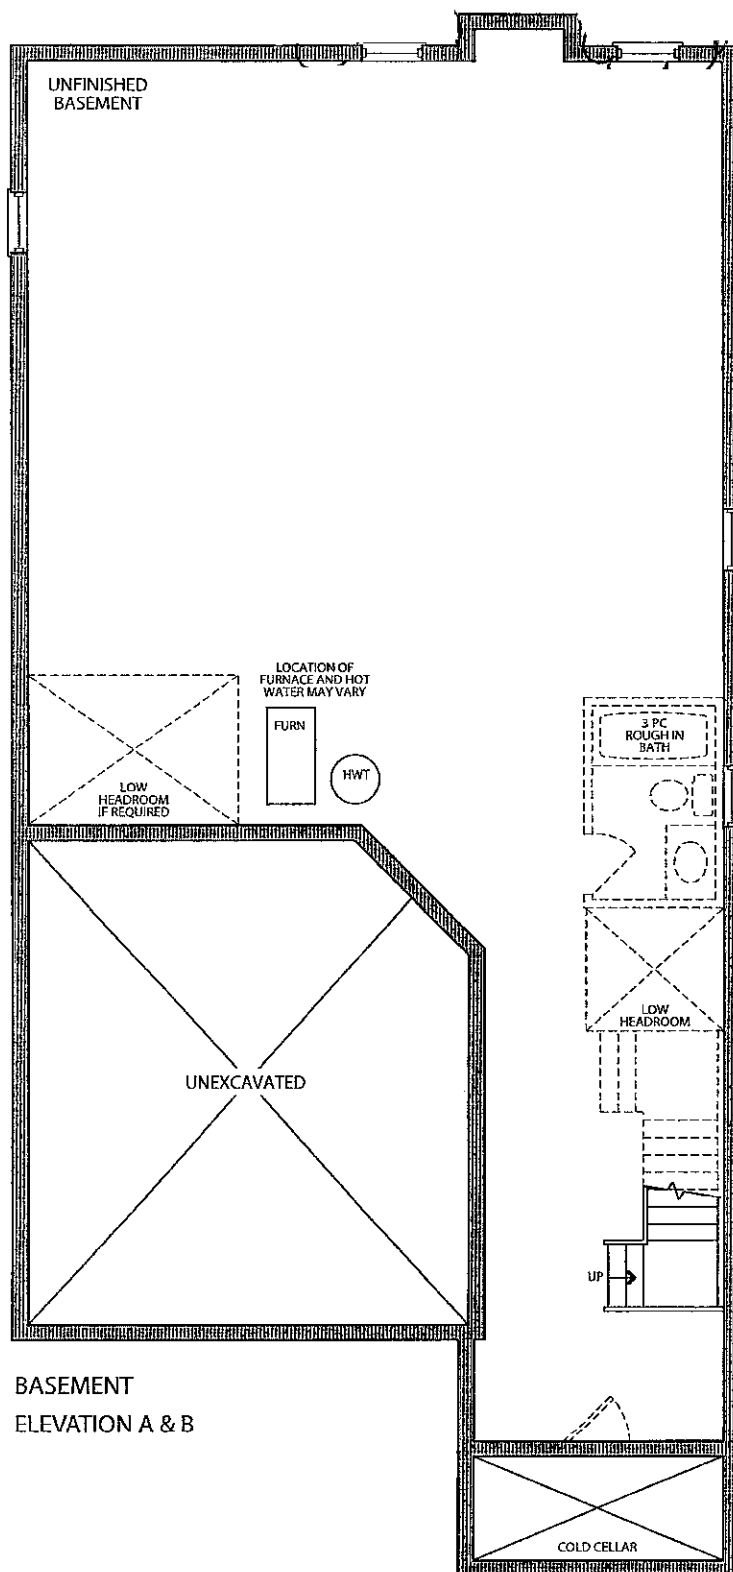

BASEMENT
ELEVATION A & B

Basement

LOB
condition



Lot 11

[Signature]

Aug. 10. 2016