

**Kleinburg Glen - 11 - 1 - 38-5 Elev.B ROSEMONT**  
**CENTRAL VAC AND WIRING**

Inv.667	2 - LAUNDRY & MASTER BEDROOM: ROUGH - IN FOR EXTRA SECURITY KEY PAD
Line8695	Note:
15Jul16 / 30Sep16	
Inv.667	1 - DEN: LOCATE STANDARD RG6 CABLE TO DEN, CENTER ON WALL BEHIND POWDER ROOM BESIDE STANDARD 110V RECEPTACLE. PLEASE SEE FLOORPLAN FOR LOCATION.
Line8696	Note:
15Jul16 / 30Sep16	
Inv.667	1 - CONDUIT PIPE - FROM ATTIC TO ELECTRICAL PANEL - PLEASE RUN A STRAIGHT LINE FROM ATTIC TO ELECTRICAL PANEL
Line8699	Note:
15Jul16 / 30Sep16	

**CERAMIC**

Inv.975	1 - FOYER / POWDER ROOM / LAUNDRY / KITCHEN TILE FLOOR: UPG 4
Line13912	Note: Lower Landing STD HARDWOOD. Please see Floorplan for detail
15Nov16 / 2Dec16	
Inv.975	1 - MASTER ENSUITE - Floor, Tub Face, Tub Deck: UPG 4 Floor Tile
Line13926	Note:
15Nov16 / 2Dec16	
Inv.975	1 - MASTER ENSUITE Shower Walls & Tub Splash: UPG 4 Wall Mosaic
Line13927	Note:
15Nov16 / 2Dec16	
Inv.975	2 - MASTER ENSUITE Shower Floor & Ceiling: UPG 4 Wall Mosaic
Line13928	Note:
15Nov16 / 2Dec16	

**DRYWALL**

Inv.667	1 - SMOOTH CEILINGS - (2 - Story Design) SECOND FLOOR
Line8708	Note:
15Jul16 / 30Sep16	

**ELECTRICAL**

Inv.667	1 - KITCHEN: 110V WALL RECEPTACLE ON DEDICATED CIRCUIT - GAS FIRED APPLIANCE - FOR AUX. EQUIPMENT - NOT A STOVE PLUG
Line8663	Note:
15Jul16 / 30Sep16	
Inv.667	1 - KITCHEN: RELOCATE KITCHEN LIGHT CENTERED OVER BREAKFAST BAR
Line8682	Note:
15Jul16 / 30Sep16	
Inv.667	1 - BREAKFAST AREA: PLEASE LOCATE LIGHT CENTERED IN BREAKFAST AREA. PLEASE SEE FLOORPLAN FOR LOCATION
Line8683	Note:
15Jul16 / 30Sep16	
Inv.667	1 - KITCHEN: 240V RECEPTACLE ON DEDICATED CIRCUIT FOR DOUBLE WALL OVEN. PLEASE SEE FLOORPLAN FOR LOCATION
Line8686	Note:
15Jul16 / 30Sep16	

**Kleinburg Glen - 11 - 1 - 38-5 Elev.B ROSEMONT**

Inv.667	2 - KITCHEN: 110V WALL RECEPTACLE ON NORMAL CIRCUIT - x 2 CENTERED IN PANTY. PANTRY TO BE LEFT OPEN IN CENTER WITH COUNTERTOP. RECEPTACLES TO BE INSTALLED AT APPROX 46" AFF.
Line8692	Note:
15Jul16 / 30Sep16	
Inv.667	1 - GREAT ROOM: RELOCATE RECEPTACLE TO CENTER OF EXTERIOR WALL AT STANDARD HEIGHT. PLEASE SEE FLOORPLAN FOR LOCATION
Line8693	Note:
15Jul16 / 30Sep16	
Inv.667	1 - DINING ROOM: PLEASE CENTER CEILING LIGHT
Line8694	Note:
15Jul16 / 30Sep16	
Inv.667	1 - 200 AMP ELECTRICAL SERVICE
Line8700	Note:
15Jul16 / 30Sep16	

**EXTERIOR COLOURS**

Inv.667	1 - EXTERIOR COLOUR PACKAGE 7
Line12167	Note:
15Jul16 / 30Sep16	

**FRAMING**

Inv.667	1 - STANDARD DOOR EXTENDED HEIGHT 96 INCH (PRICE PER DOOR) - GROUND FLOOR 2 STOREY MODELS
Line12168	Note:
15Jul16 / 30Sep16	
Inv.667	1 - MAIN FLOOR: EXTENDED HEIGHT ARCHWAY (PRICE PER DOORWAY) - INCLUDE FRAMING NOTE
Line12169	Note:
15Jul16 / 30Sep16	

**GLASS AND MIRROR**

Inv.667	1 - MASTER ENSUITE: CONVERT FRAMED SHOWER TO 10MM FRAMLESS SHOWER ENCLOSURE WITH DOOR AND 10MM SIDE PANEL
Line8705	Note:
15Jul16 / 30Sep16	

**HVAC**

Inv.667	1 - KITCHEN: GAS LINE ROUGH - GROUND FLOOR. PLEASE SEE FLOORPLAN FOR LOCATION
Line8664	Note:
15Jul16 / 30Sep16	
Inv.667	1 - KITCHEN: UPGRADE VENTING FOR STOVE TO 8 INCH PIPE EXTERIOR WALL
Line8681	Note:
15Jul16 / 30Sep16	

**INTERIOR TRIM AND DOORS**

Inv.667	4 - MAIN FLOOR: EXTENDED HEIGHT ARCHWAY (PRICE PER DOORWAY) - INCLUDE FRAMING NOTE
Line8703	Note:
15Jul16 / 30Sep16	

Kleinburg Glen - 11 - 1 - 38-5 Elev.B ROSEMONT

Inv.667	8 - STANDARD DOOR EXTENDED HEIGHT 96 INCH (PRICE PER DOOR) - GROUND FLOOR 2 STOREY MODELS
Line8704	Note:
15Jul16 / 30Sep16	

KITCHEN AND BATH CABINETRY

Inv.975	1 - Purchaser accepts Standard Kitchen Layout. Made custom modifications at structurals - please keep as originally ordered. Purchaser to customize at own expense and warranty after closing.
Line13913	Note:
15Nov16 / 2Dec16	

MISC.

Inv.667	1 - Purchaser has attended a Structural appointment at the Decor Centre & has DECLINED any additional upgrades and accepts and acknowledges that there will be no further structural changes/additions/deletions to be made upon signing on August 9, 2016.
Line8709	Note:
15Jul16 / 30Sep16	

Inv.667	1 - Purchasers are aware & accepts that ANY changes made to upgrades after signing this Purchasers Extra Form are subject to a minimum administration fee of \$500. PLUS a 10% holdback fee.
Line8710	Note:
15Jul16 / 30Sep16	

Inv.667	1 - BONUS PACKAGE: \$4,500.00 (INCLUDING TAXES) WORTH OF UPGRADES FROM GOLD PARK HOMES DÉCOR CENTRE IS BEING APPLIED TOWARD THE STRUCTURAL APPOINTMENT. PURCHASER HAS A REMAINING AMOUNT OF \$3000.00 (INCLUDING TAXES) TO BE USED TOWARD THE COLOUR APPOINTMENT.
Line8711	Note:
15Jul16 / 30Sep16	

Inv.667	1 - Balance after \$4,500.00 credit \$13,037.60 50% Paid by cheque \$6,518.80 50% Applied to Mortgage \$6,518.80
Line8712	Note:
15Jul16 / 30Sep16	

Inv.975	1 - Purchaser Accepts Standard Appliance Openings: Fridge - 37-1/2"W x 73-1/2" High Approx. Range - 30-1/2"D x 31-1/2"W Approx. Dishwasher - 24" W Approx
Line13939	Note:
15Nov16 / 2Dec16	

Inv.975	1 - Purchaser has attended a Decor appointment at the Decor Centre & has DECLINED any additional upgrades and accepts and acknowledges that there will be no further structural changes/additions/deletions to be made upon signing.
Line13940	Note:
15Nov16 / 2Dec16	

Inv.975	1 - BONUS PACKAGE REMAINING FROM STRUCTURAL APPOINTMENT: \$3,000.00 (INCLUDING TAXES) WORTH OF UPGRADES FROM GOLD PARK HOMES DÉCOR CENTRE IS BEING APPLIED TOWARD THE DECOR APPOINTMENT.
Line13950	Note: PURCHASER HAS A REMAINING AMOUNT OF \$00 (INCLUDING TAXES)
15Nov16 / 2Dec16	

Inv.975	1 - Credit From Structural: PE: 877
Line13962	Note:
15Nov16 / 2Dec16	

**Kleinburg Glen - 11 - 1 - 38-5 Elev.B ROSEMONT**

Inv.975	1 - TOTAL \$16,153.35 (\$3,000) Credit Remaining from Structural
	Total After Credit: \$13,153.35 50% On Mortgage: \$6,576.68 50% Paid By Credit Card: \$6,576.68
Line13963	Note:
15Nov16 / 2Dec16	

**PLUMBING**

Inv.667	1 - KITCHEN ROUGH - IN - WATERLINE FOR FRIDGE. PLEASE SEE FLOORPLAN FOR LOCATION
Line8691	Note:
15Jul16 / 30Sep16	
Inv.667	1 - GARAGE: PLEASE RELOCATION HOSE BIB IN GARAGE TO FRONT RIGHT SIDE. SEE FLOORPLAN FOR LOCATION
Line8698	Note:
15Jul16 / 30Sep16	
Inv.667	1 - REAR OF HOUSE: HOSE BIB - STANDARD TO UPGRADED WITH HOT AND COLD WATER VALVE
Line8702	Note:
15Jul16 / 30Sep16	
Inv.667	1 - MASTER ENSUITE SHOWER: ROUGH - IN FOR RAINSHOWER HEAD - SHOWER HEAD NOT INCLUDED AND MUST BE PURCHASED
Line8706	Note:
15Jul16 / 30Sep16	
Inv.667	1 - BASEMENT: ADD BACKFLOW PREVENTER
Line10151	Note:
15Jul16 / 30Sep16	
Inv.975	1 - MASTER ENSUITE: UPG Rain Shower Head 8" RainCan Head 8" RP70172
Line13954	Note: See Spec Sheet Attached
15Nov16 / 2Dec16	
Inv.975	1 - MASTER ENSUITE: UPG 6" Ceiling Mount Arm RP61058
Line13958	Note: See Spec Sheet Attached
15Nov16 / 2Dec16	
Inv.975	1 - MASTER ENSUITE: Shower Diverter R11000 + Trim T1900
Line13959	Note: See Spec Sheet attached
15Nov16 / 2Dec16	

**STAIRS AND RAILINGS**

Inv.975	1 - STAIRS: UPG to Euroline R-6 Black with V-Groove Handrail
Line13961	Note:
15Nov16 / 2Dec16	

**WINDOWS - BASEMENT**

Inv.667	2 - BASEMENT: EXTRA TO BE REFUNDED DUE TO LOB CONDITION
Line9956	Note:
15Jul16 / 30Sep16	

Kleinburg Glen - 11 - 1 - 38-5 Elev.B ROSEMONT

Inv.667	2 - BASEMENT WINDOWS - EXTRA TO BE REFUNDED DUE TO LOB CONDITION
Line9955	Note:
15Jul16 / 30Sep16	

Scheduled Closing Date: September-19-16

Purchasers: Daniele Circosta &amp; Emily Cuzzolino

Property: 11

Telephone Res. / Bus: (416) 300-7005

Project: Burkshire Holdings Inc.

Decor Advisor: Laura Lofaro

Model and Elevation: 38-5 Elev.B ROSEMONT

Layout Changes: ☐ Yes ☐ NoSketch Attached: ☐ Yes ☐ NoExterior Colour Scheme: 

## 1. Cabinetry

	Style and Colour	Counter	Hardware
Kitchen / Breakfast	Venice PVC ChocMaple	Grigio Sardo Granite	CS1-24
Laundry Room	N/A		
Powder Room	N/A		
Master Ensuite Bathroom	Toscana PVC ChocMapl	Wilsonart Bronzite 4971K-52	CS1-25
Second Ensuite Bathroom (If Applicable)	Varese PVC ChocMapl	Wilsonart Bronzite 4971K-52	CS1-25
Ensuite 3/4	Varese PVC ChocMapl	Wilsonart Bronzite 4971K-52	CS1-25
Dishwasher Cabinet			

## Comment

Purchaser accepts Standard Kitchen Layout. Made custom modifications at structurals - please keep as originally ordered. Purchaser to customize at own expense and warranty after closing.

## 2. Floor Tile

	Selection	Grout	Threshold
Entrance Vestibule	*17.7x17.7 Must Dove Grey Polished		
Main Hall	N/A		
Kitchen / Breakfast	*17.7x17.7 Must Dove Grey Polished		
Laundry Room	*17.7x17.7 Must Dove Grey Polished		
Powder Room	*17.7x17.7 Must Dove Grey Polished		
Master Ensuite Bathroom	*17.7x17.7 Must Dove Grey Polished		
Second Ensuite Bathroom (If Applicable)	13x13 Serpentine Beyaz White		
Lower Landing (If Applicable)	*See Hardwood		
Ensuite 3/4	13x13 Serpentine Beyaz White		

## Comment

Master Ensuite Floor, Tub Face, Tub Deck - \*17.7x17.7 Must Dove Grey Polished  
Master Ensuite Shower Floor and Ceiling - Marble Mosaic Hexagon Honed Bianco Wood 1.2" Hexagon

## 3. Wall Tile

	Selection	Listello/Inserts	Describe
		<input type="radio"/> Yes <input type="radio"/> No	
Master Ensuite Bathroom			
Tub Deck	*See Floor Tile	<input type="radio"/> Yes <input checked="" type="radio"/> No	
Shower Stall	*MarbleMos.Hex.Honed.BiancoWd	<input type="radio"/> Yes <input checked="" type="radio"/> No	
Bathroom Walls		<input type="radio"/> Yes <input checked="" type="radio"/> No	
Second Ensuite Bathroom (If Applicable)	8x10 Serpentine Beyaz White	<input type="radio"/> Yes <input checked="" type="radio"/> No	
Ensuite 3/4	8x10 Serpentine Beyaz White	<input type="radio"/> Yes <input checked="" type="radio"/> No	

Kitchen Backsplash ☐ Yes ☒ NoBacksplash Behind Fridge 

## Comment

Master Ensuite TUB SPLASH: \*Marble Mosaic Hexagon Honed Bianco Wood 1.2" Hexagon

Purchasers: Daniele Circosta & Emily Cuzzolino

Property: 11

Telephone Res. / Bus: (416) 300-7005

Project: Burkshire Holdings Inc.

Decor Advisor: Laura Lofaro

Model and Elevation: 38-5 Elev.B ROSEMONT

#### 4. Plumbing Fixtures

Master Ensuite Bathroom  Second Ensuite  Powder Room   
Other Room - Specify  Other Washroom

##### Comment

STD Throughout  
UPG Master Ensuite RAIN SHOWER and Diverter

#### 5. Hardwood Flooring

	Type and Stain		Type and Stain
Main Hall	<input type="text"/> Std Natural Oak	Upper Landing	<input type="text"/> Std Natural Oak
Kitchen / Breakfast	<input type="text"/> N/A	Upper Hall	<input type="text"/> N/A
Living Room	<input type="text"/> N/A	Master Bedroom	<input type="text"/> N/A
Dining Room	<input type="text"/> Std Natural Oak	Bedroom #2	<input type="text"/> N/A
Family Room	<input type="text"/> N/A	Bedroom #3	<input type="text"/> N/A
Den/Library	<input type="text"/> Std Natural Oak	Bedroom #4	<input type="text"/> N/A
Entrance Vestibule	<input type="text"/> N/A	Bedroom #5	<input type="text"/> N/A
Lower Landing (If Applicable)	<input type="text"/> Std Natural Oak	Other Room - Specify Great Room	<input type="text"/> Std Natural Oak

##### Comment

#### 6. Carpeting

	Upgrade	Description
Main Hall	<input type="checkbox"/>	<input type="text"/> N/A
Living Room	<input type="checkbox"/>	<input type="text"/> N/A
Dining Room	<input type="checkbox"/>	<input type="text"/> N/A
Family Room	<input type="checkbox"/>	<input type="text"/> N/A
Den/Library	<input type="checkbox"/>	<input type="text"/> N/A
Upper Hall	<input type="checkbox"/>	<input type="text"/> T15
Master Bedroom	<input type="checkbox"/>	<input type="text"/> T15
Bedroom #2	<input type="checkbox"/>	<input type="text"/> T15
Bedroom #3	<input type="checkbox"/>	<input type="text"/> T15
Bedroom #4	<input type="checkbox"/>	<input type="text"/> T15
Bedroom #5	<input type="checkbox"/>	<input type="text"/> N/A
<input type="text"/>	<input type="checkbox"/>	<input type="text"/>
Upper Landing (If Applicable)	<input type="checkbox"/>	<input type="text"/> N/A
Lower Landing (If Applicable)	<input type="checkbox"/>	<input type="text"/> N/A

	Type	Area
Upgrade Underpad	<input type="text"/> N/A	<input type="text"/> N/A
	Capped	Runner - *Upgrade
Carpet on Stairs	<input type="text"/> N/A	<input type="text"/> N/A

##### Comment

Scheduled Closing Date: September-19-16

Purchasers: Daniele Circosta &amp; Emily Cuzzolino

Property: 11

Telephone Res. / Bus: (416) 300-7005

Project: Burkshire Holdings Inc.

Decor Advisor: Laura Lofaro

Model and Elevation: 38-5 Elev.B ROSEMONT

## 7. Fireplace

	Living Room			Family Room			Other Room - Specify			Great Room
	Purchased	As Per Plan	N/A	Purchased	As Per Plan	N/A	Purchased	As Per Plan	N/A	
Fireplace Type	<input type="radio"/>	<input type="radio"/>	<input type="radio"/>	<input type="radio"/>	<input type="radio"/>	<input type="radio"/>	<input type="radio"/>	<input checked="" type="radio"/>	<input type="radio"/>	STD
Mantle Type										
Colour / Stain										
Surround										STD Cast Stone
Hearth										DECLINED
Comment										

## 8. Trim Carpentry

Interior Doors	STD	Front Door Glass Inserts	STD	Door Handles	STD
Interior Trim	STD				
Comment					

## 9. Plaster Mouldings and Medallions

Entrance Vestibule	N/A		Kitchen/Breakfast	N/A	
Main Hall	N/A		Den/Library	N/A	
Living Room	N/A		Lower Landing	N/A	
Dining Room	N/A		Other Room - Specify	N/A	
Family Room	N/A				
Comment					

## 10. Railings and Spindles

Railing Package	* Eronline R-6 Square Posts in lieu of Std Round with V-Groove handrail		
Railing Colour	STD Natural Oak	Spindle Colour	Black Iron
Stringer / Riser	STD Natural Oak	Treads	STD Natural Oak
Comment		Oak Stairs	<input checked="" type="radio"/> Yes <input type="radio"/> No

## 11. Wall Paint

Main & Upper Hall		Master Bedroom	
Living Room		Bedroom #2	
Dining Room		Bedroom #3	
Kitchen / Breakfast		Bedroom #4	
Family Room		Bedroom #5	
Powder Room		Master Ensuite	
Laundry Room			
Den/Library		Second Ensuite	
Trim Paint			
Comment	Smooth Ceilings First Floor		

Warm Grey Throughout





Scheduled Closing Date: September-19-16

Purchasers: Daniele Circosta & Emily Cuzzolino

Property: 11

Telephone Res. / Bus: (416) 300-7005

Project: Burkshire Holdings Inc.

Decor Advisor: Laura Lofaro

Model and Elevation: 38-5 Elev.B ROSEMONT

## 12. Electrical

Plugs and Switches ☒ White ☐ Ivory

Hood Fan ☐ White ☐ Ivory

Appliances

Built in Cooktop

Built in Oven

Gas Stove

Microwave

Comment

Purchaser accepts Standard Kitchen Layout. Made custom modifications at structurals - please keep as originally ordered. Purchaser to customize at own expense and warranty after closing.

Above Kitchen Cabinet Light ☐ Yes ☐ No

Below Kitchen Cabinet Light ☐ Yes ☐ No

☒ Yes ☐ No

☒ Yes ☐ No

☒ Yes ☐ No

☒ Yes ☐ No

## 13. Heating and Air Conditioning

Air Conditioning

Gas Provisions Dryer


Comment

Gas Provisions Stove

Gas Provisions Barbecue

## 14. Additional Comments

## 15. Disclaimers and Notes

- 1) Colours of all materials are as close as possible to builder's selection, but not necessarily identical due to variances in manufacturing.
- 2) Any extras listed above are null and void unless accompanied by a separate invoice/amendment. Said invoice must be paid in full.
- 3) The Purchaser acknowledges that after Interior Colour Selection form is signed and dated, no further changes will be permitted other than re-selection due to unavailability.  Purchaser's Initials
- 4) The Purchaser acknowledges reading and accepting the "Gold Park Homes Decor Centre Disclaimers" form. This document contains other miscellaneous disclaimers.

This Interior Colour Selection is final and approved by:

Signature: 


Date: Nov. 15, 2016

Signature: 

Date: Nov 15/16

Elevation A • 2,861 sq.ft.

Elevation B • 2,861 sq.ft.

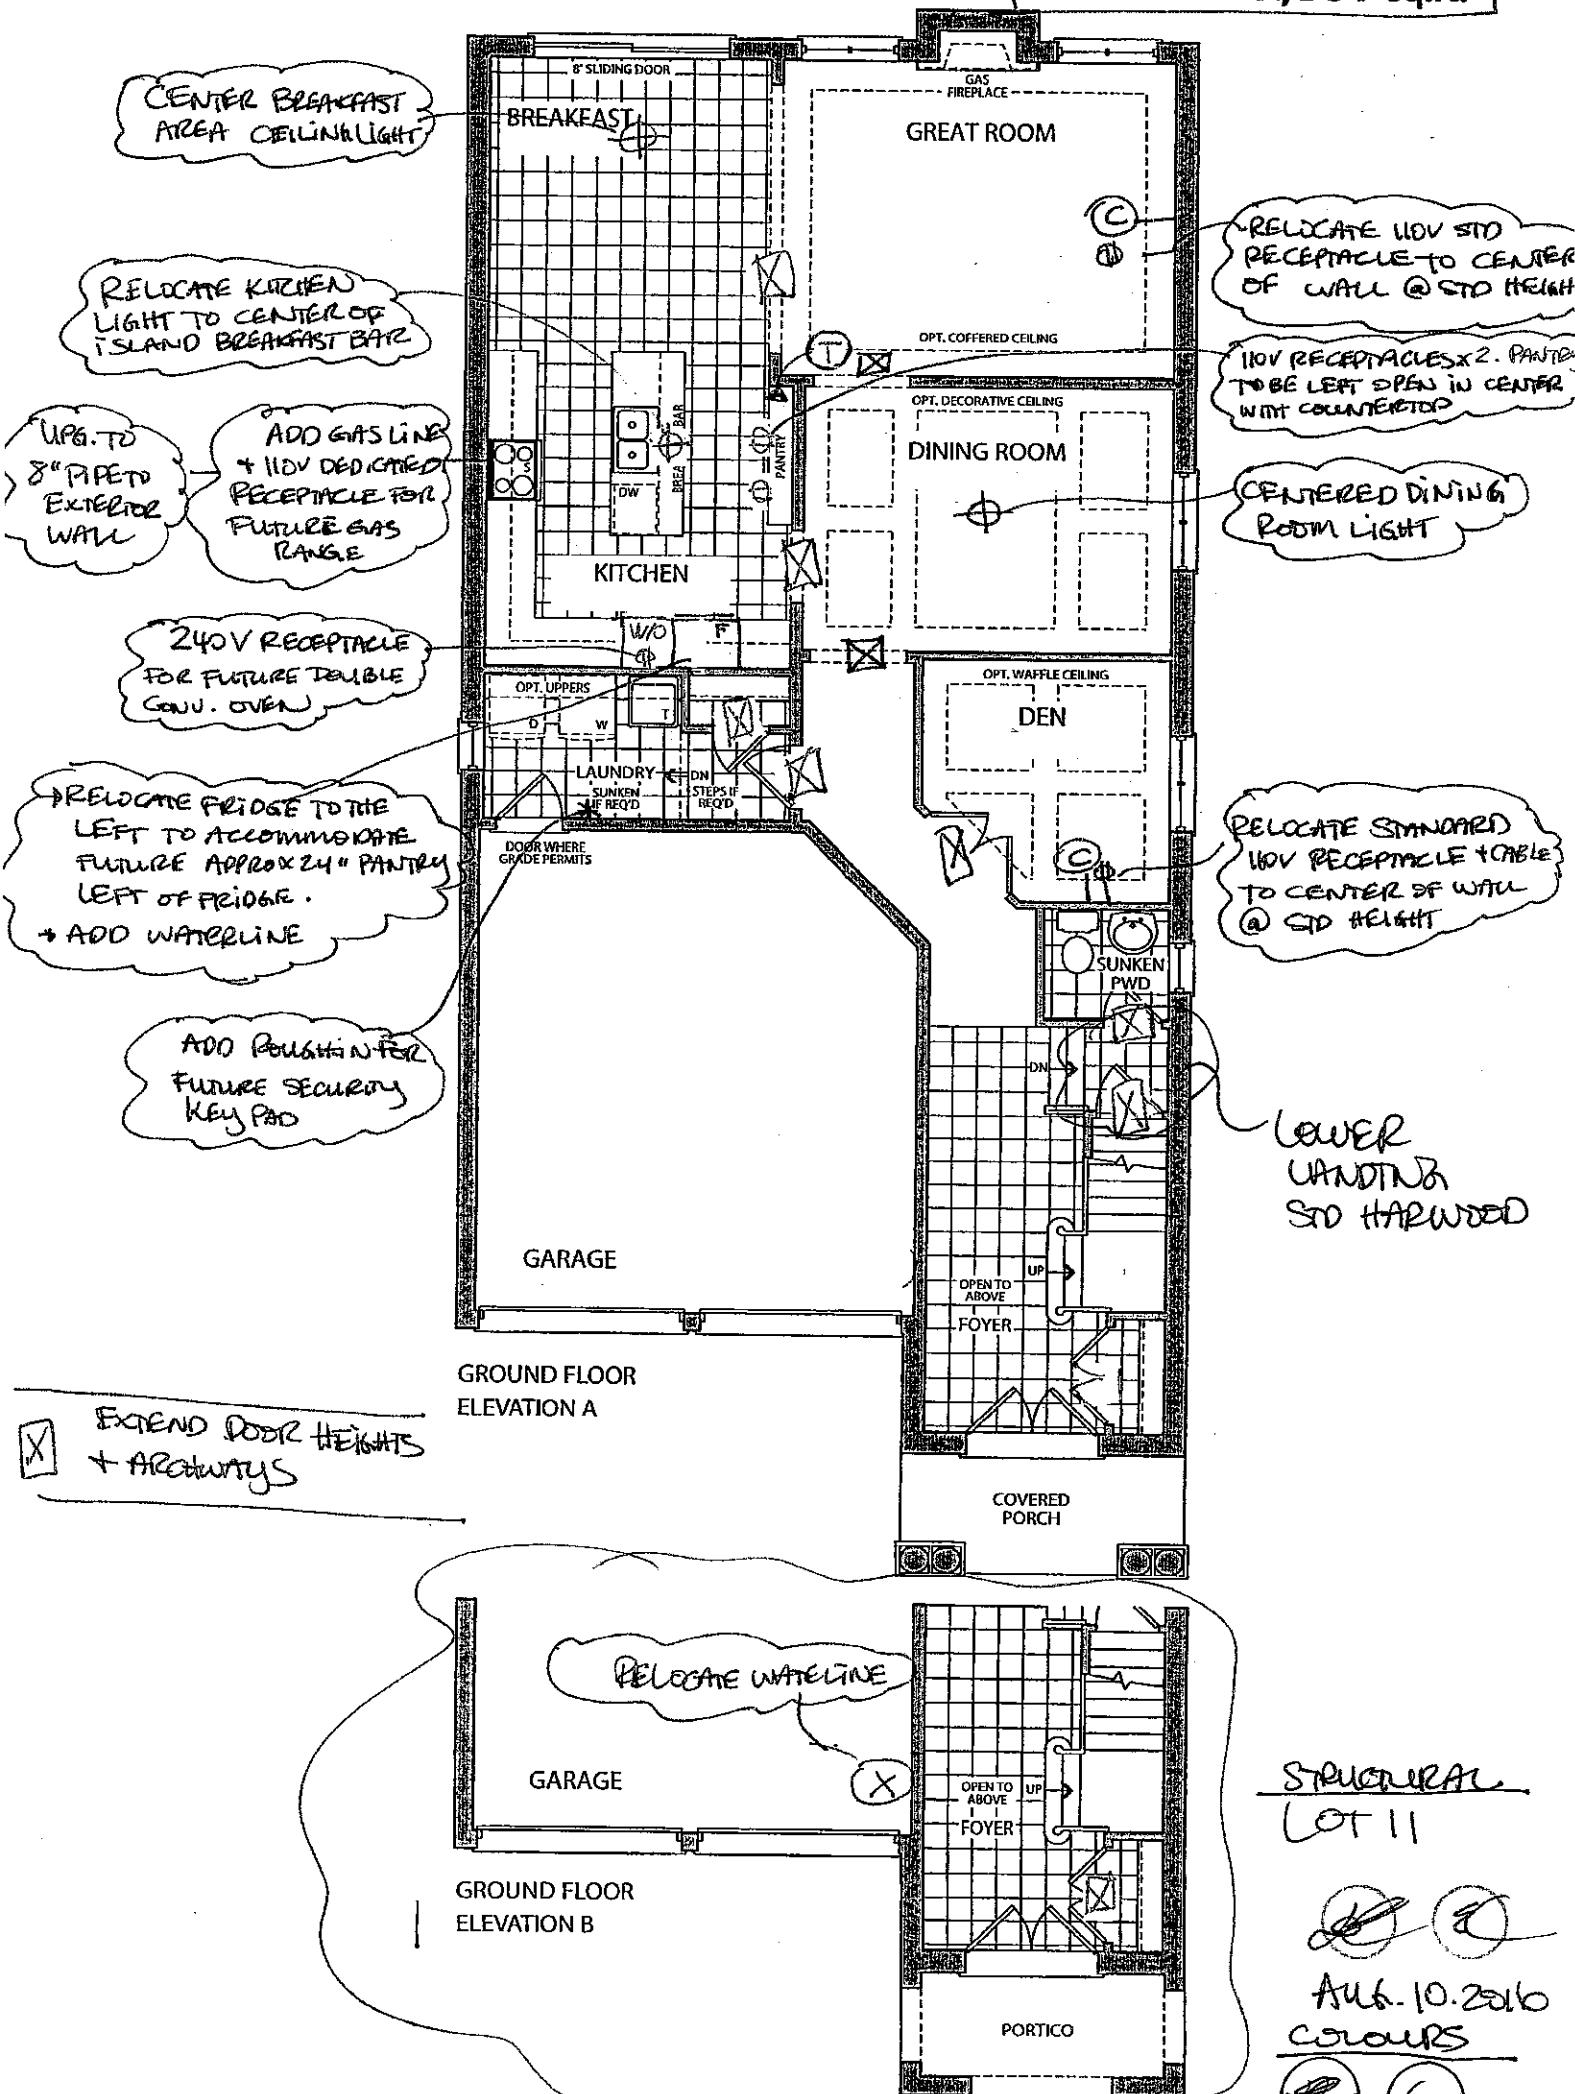

STRUCTURAL  
LOT 11



AUG. 10. 2016  
COLOURS

GOLDPARK  
HOMES

NOV. 15. 2016

Elevation A • 2,861 sq.ft.

Elevation B • 2,861 sq.ft.

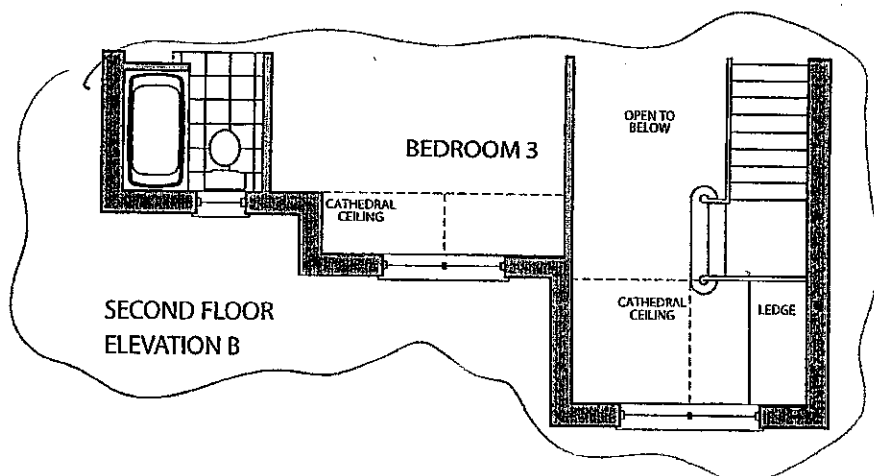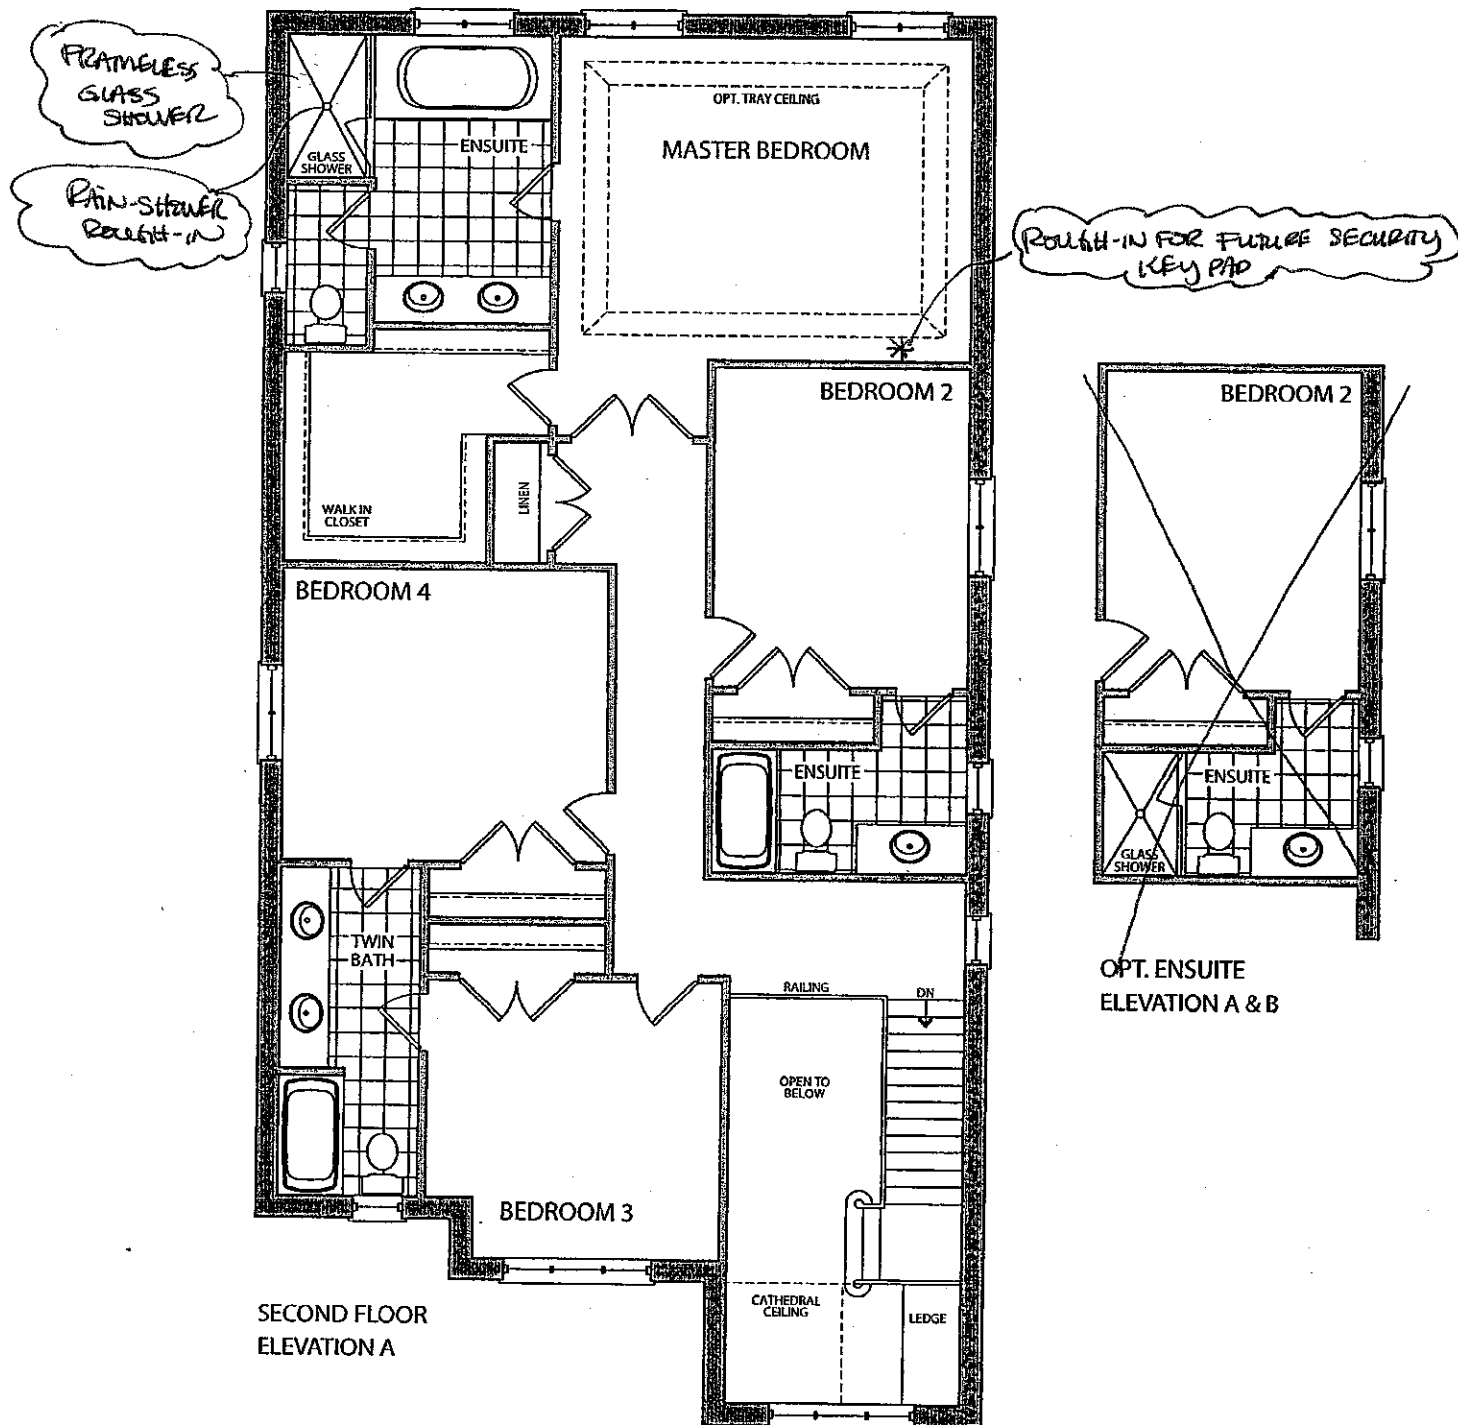

SMOOTH CEILINGS


STRUCTURALS  
LOT 11

Aug. 10. 2016

CONCRETE

Nov. 15. 2016

GOLDPARK

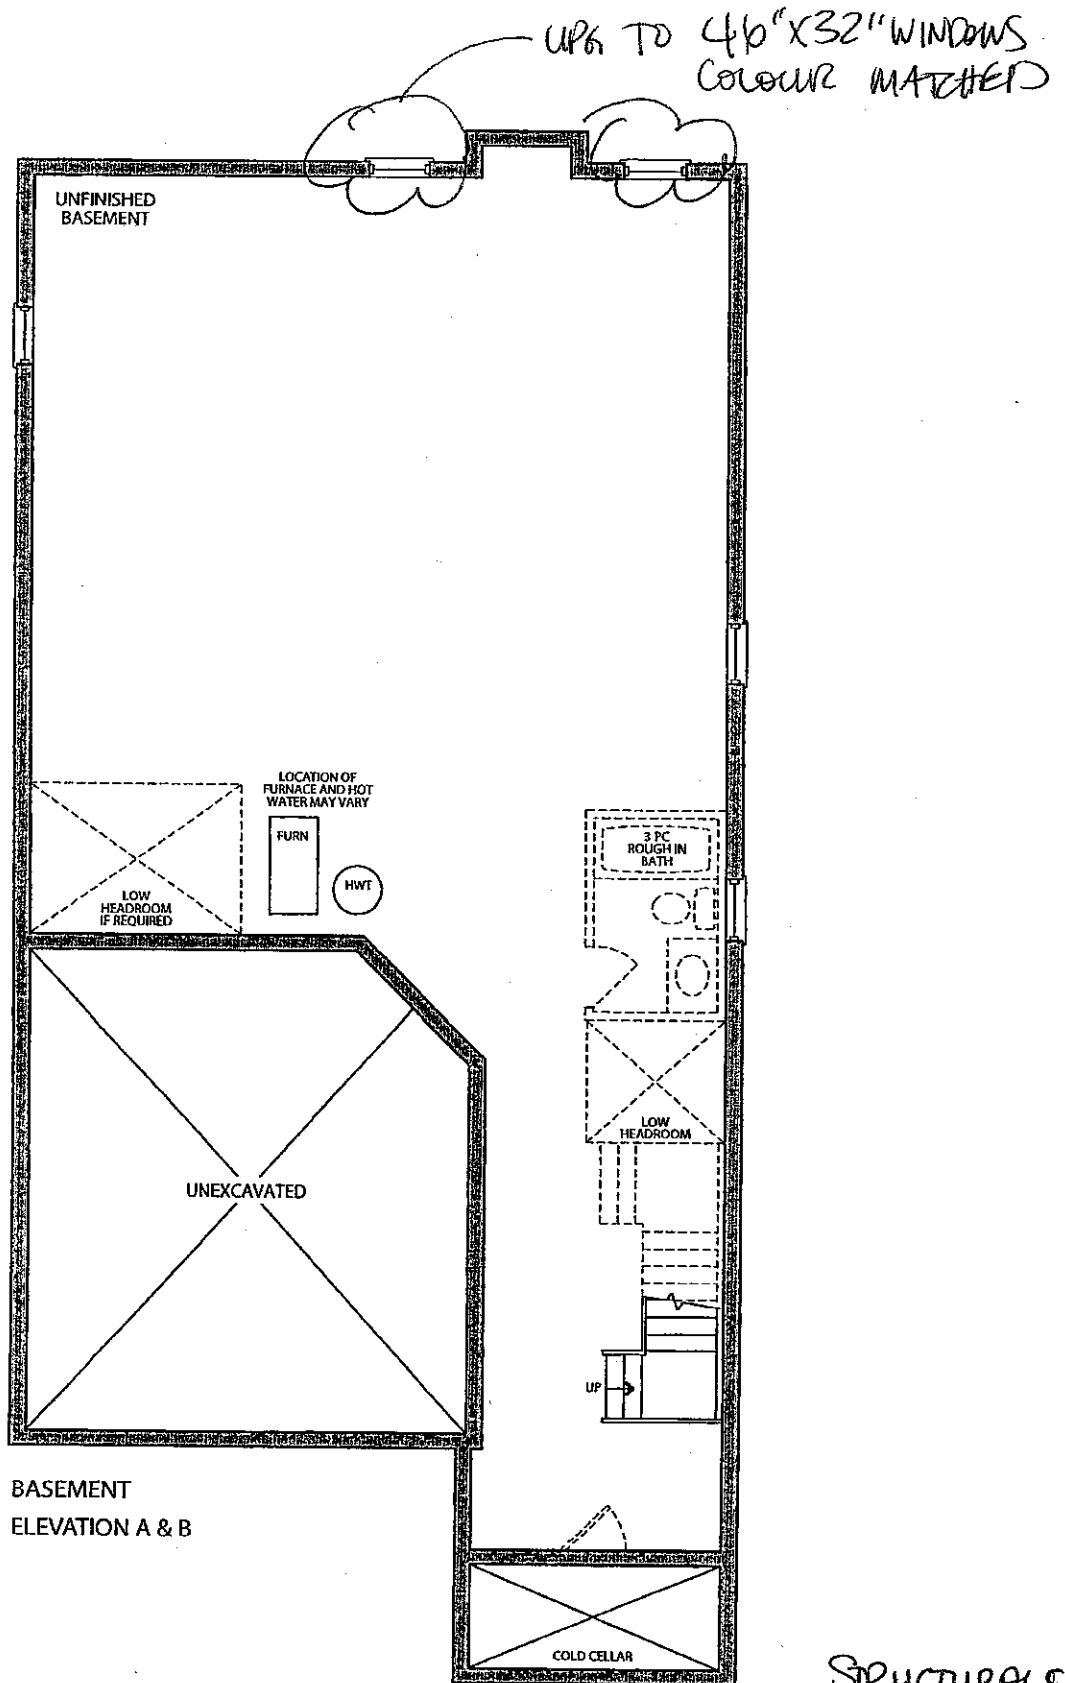

BASEMENT  
ELEVATION A & B

STRUCTURE

LOT 11

*[Signature]*

AUG. 10. 2016

COLOURS

*[Signature]*

**GOLDPARK**  
HOMES

NOV. 15. 2016

# CORTINA

KITCHENS INC.

70 Regina Road Woodbridge ON L4L 8L6  
905-264-6464

## INFORMATION - PVC DOORS

Builder GOLDPARK HOMES Project KLEINBURG GLEN Lot # 11

All cabinets with PVC (Thermofoil) Doors come with melamine gables, panels and kick. The doors, crown moulding and light valance are PVC wrapped. Open shelves incorporated in design will only be available with melamine interiors. There will be variations in colour shades between the PVC parts (doors, crown and Light valance) and the melamine parts (open shelves, Gables, Panels and Kick) due to the difference in material.



Furring Panel with crown moulding to the ceiling is not available on all PVC door styles due to subtle variations in colour shades between the PVC parts (moulding) and the melamine parts (furring panel) due to the difference in material. Grain directions in wood grain pattern melamine, vary between the furring panel, crown moulding (horizontal) and the PVC doors (vertical).

Thank you for your understanding.

---

I am well informed of this information, and agree to the purchase of the above.

Purchaser:

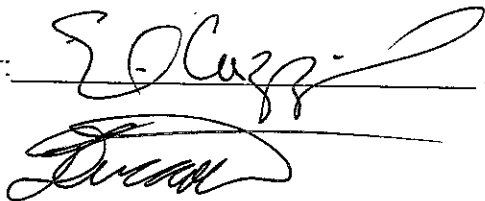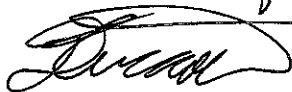Date:

NOV 15/16

Nov. 15, 2016


STANDARD HARDWARE



CSI-6



CSI-10

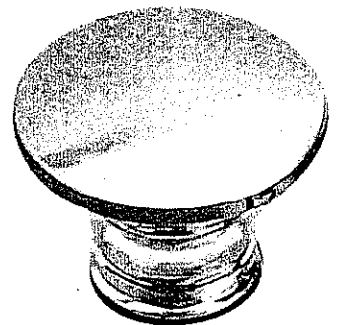


CSI-14




CSI-16




CSI-18

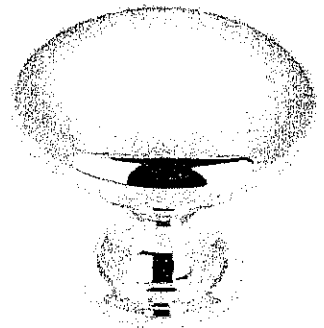


CSI-19

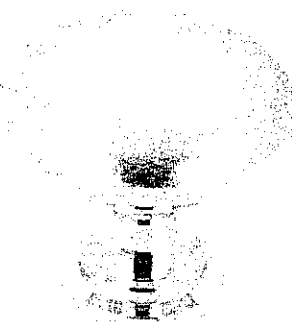


CSI-20

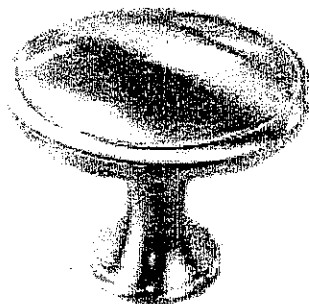


CSI-21

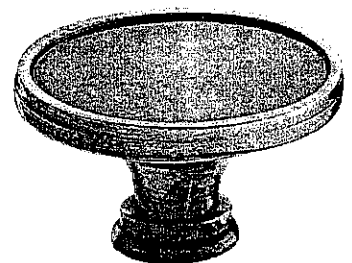

CSI-22

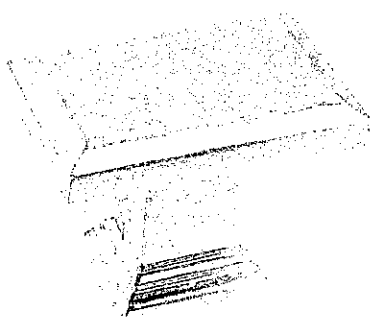


CSI-23

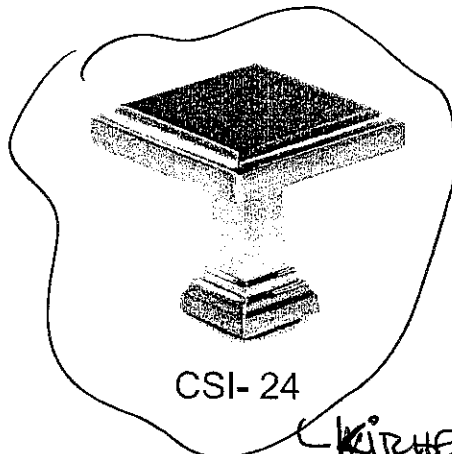

CSI-24

KITCHEN

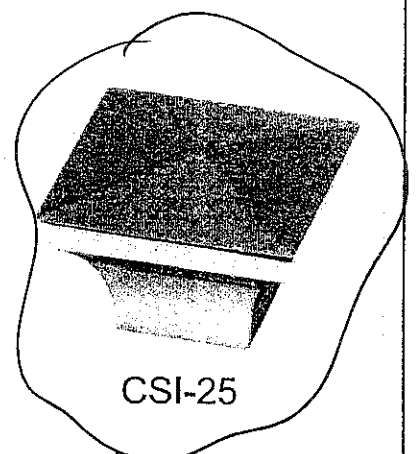

CSI-25

\*NOTES:

- IMAGES ARE FOR QUICK REFERENCE PURPOSES ONLY
- ACTUAL SIZES AND FINISHES AS PER HARDWARE
- SAMPLE BOARD PROVIDED TO DECOR CENTRE

KLEINBURG  
GLEN  
LOT 11

RE  
G

NOV. 15. 2016

MASTER ENSUITE  
ENSUITE 2  
ENSUITE 3/4

# CORTINA


70 Regina Road, Woodbridge, Ontario L4L 8L6  
Tel: 905-264-6464 Fax: 905-284-0864  
www.CortinaKitchens.com

## QUOTATION

Date: 28/06/16

Trade Name: Gold Park Homes	Site location:	Model: 38-5
Address:	Project: Kleinburg Glen	Phase:

This layout has been explained to the purchaser by Cortina Kitchens Inc. and is understood by the purchaser.

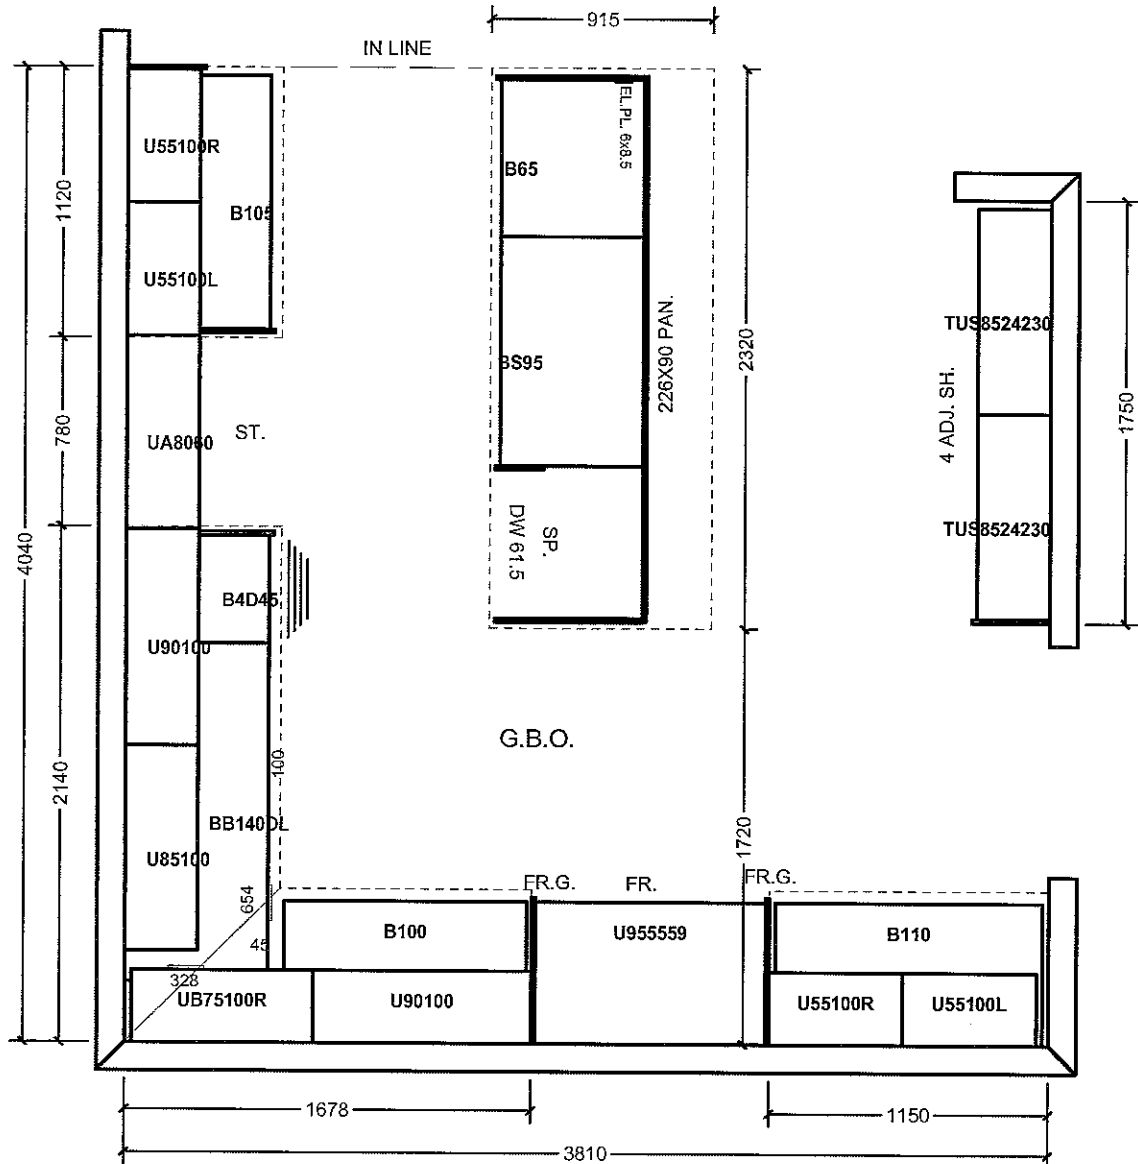

All prices subject to confirmation from head office.  
This quotation is subject to the terms & conditions set out

All agreements are contingent upon strikes, accidents, and delays beyond our control.  
Please provide our installer with template for sinkholes or \$150.00 will be charged for callback.

ACCEPTED DATE: NOV. 15, 2016

*[Signature]*


LOT 11

*[Signature]*


Item A. Wood grain and colour are characteristics of the product. We cannot guarantee that such grain and colour will always match.  
Item B. Cortina Kitchens Inc. reserves the right to alter dimensions and make technical changes without notice.

Trade Name: Gold Park Homes	Site location:	Model: 38-5
Address:	Project: Kleinburg Glen	Phase:

This layout has been explained to the purchaser by Cortina Kitchens Inc. and is understood by the purchaser.

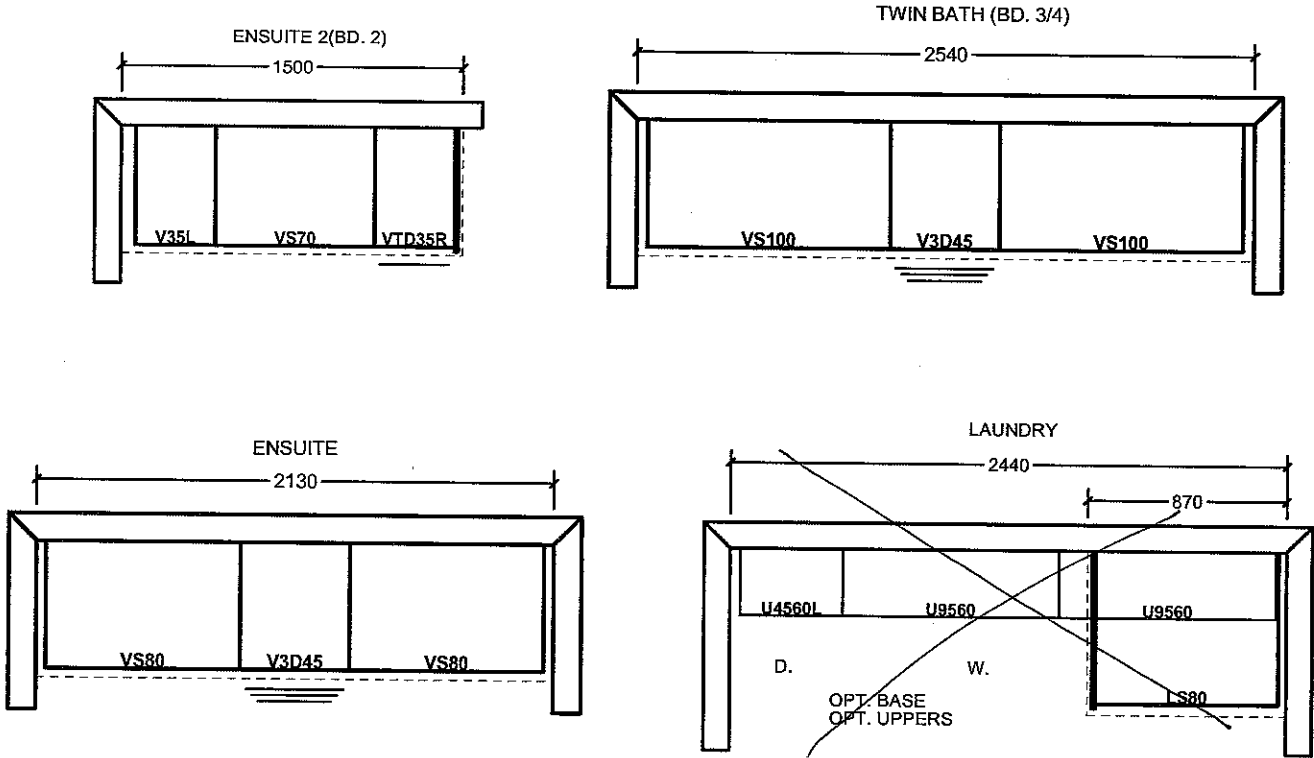

OPT. SECOND FLOOR

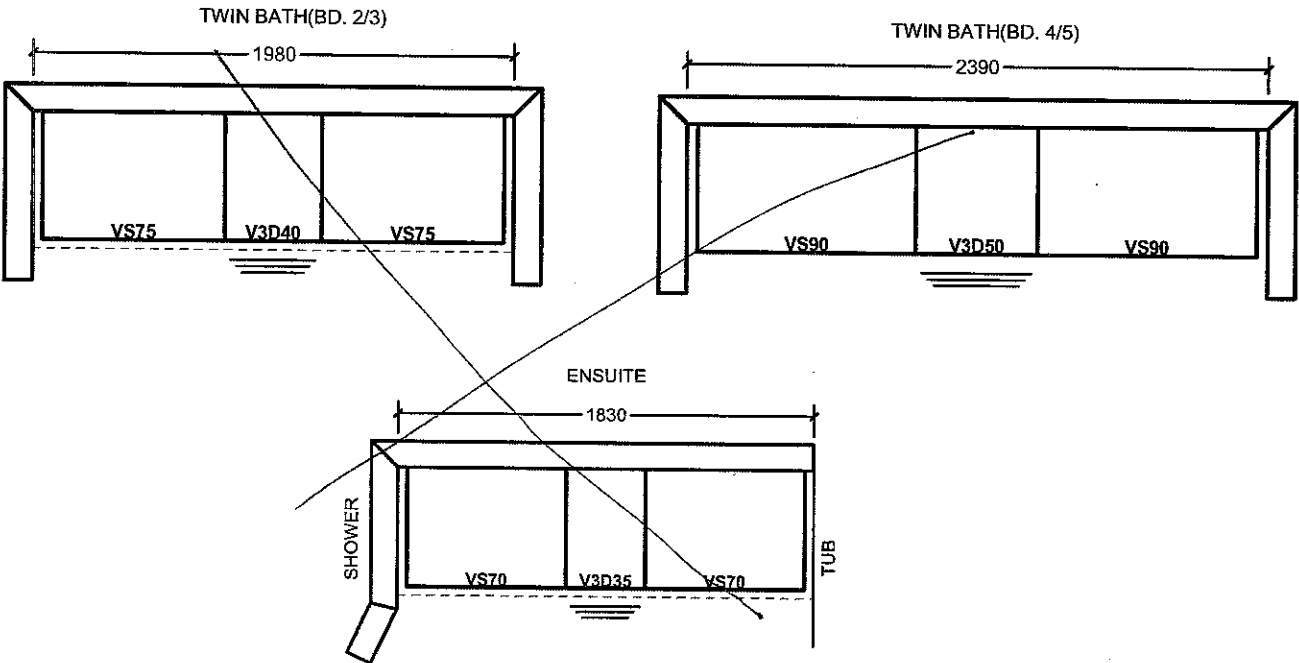

All prices subject to confirmation from head office.  
This quotation is subject to the terms & conditions set out

All agreements are contingent upon strikes, accidents, and delays beyond our control.  
Please provide our installer with template for sinkholes or \$150.00 will be charged for callback.

ACCEPTED DATE: Nov. 15, 2016


x [Signature]

Lot 11

x [Signature]

Item A. Wood grain and colour are characteristics of the product. We cannot guarantee that such grain and colour will always match.  
Item B. Cortina Kitchens Inc. reserves the right to alter dimensions and make technical changes without notice.



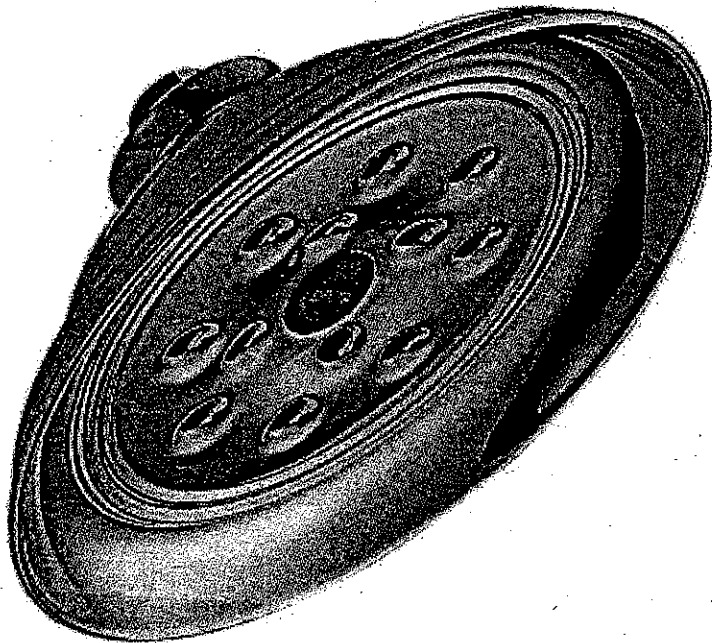


RainCan Head 8" - RP70172

Shower Head  
8" wide

\$ 175.00

+ 6" ceiling mount arm  
\$ 90.00

6" Ceiling mount arm - RP61058

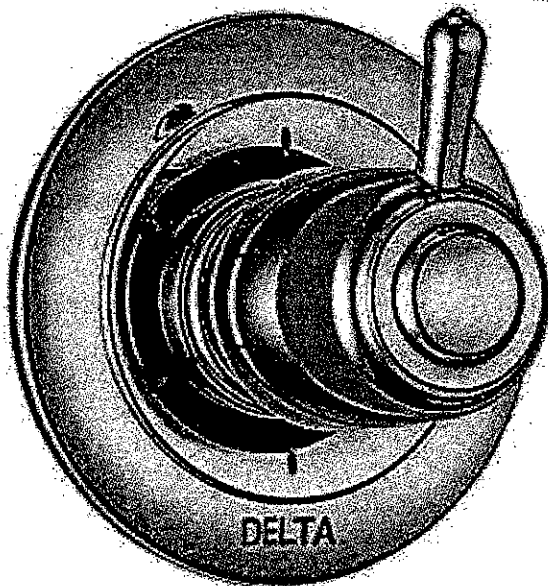

Diverter Rough In - R110000  
Diverter Trim - T11900

diverter arm  
Rough-in & trim

\$ 350.00

1

---

MASTER ENSUITE SHOWER.

---

KLEINBURG GLEN

Lot 11



Nov. 15. 2016.