

Kleinburg Glen - 12 - 1 - 38-2 Elev.A KINGSTON
CENTRAL VAC AND WIRING

Inv.619	1 - MAIN HALL: ROUGH - IN FOR EXTRA SECURITY KEY PAD at garage to house entrance
Line7753	Note:
30Jun16 / 28Sep16	
Inv.619	3 - GREAT ROOM & MASTER BEDROOM & BEDROOM 3: ROUGH - IN FIBER OPTIC CABLE - HOME RUN TO ELECTRICAL PANEL - See plan for location
Line7752	Note:
30Jun16 / 28Sep16	

DRYWALL

Inv.619	1 - SMOOTH CEILINGS - (2 - Story Design) MAIN FLOOR
Line7757	Note:
30Jun16 / 28Sep16	

ELECTRICAL

Inv.619	1 - KITCHEN: RELOCATE STANDARD FIXTURE to above island, see plan for location.
Line7755	Note:
30Jun16 / 28Sep16	
Inv.619	1 - KITCHEN: ROUGH - IN CEILING OUTLET ON SAME SWITCH - DOES NOT INCLUDE FIXTURE - Locate above island, use same switch as standard ceiling light.
Line7756	Note:
30Jun16 / 28Sep16	

EXTERIOR COLOURS

Inv.619	1 - EXTERIOR COLOUR PACKAGE 12
Line12093	Note:
30Jun16 / 28Sep16	

HVAC

Inv.619	1 - KITCHEN: GAS LINE ROUGH - GROUND FLOOR for future gas stove
Line7754	Note:
30Jun16 / 28Sep16	

MISC.

Inv.619	1 - Purchaser has attended a Structural appointment at the Decor Centre & has DECLINED any additional upgrades and accepts and acknowledges that there will be no further structural changes/additions/deletions to be made upon signing on June 30, 2016.
Line7760	Note:
30Jun16 / 28Sep16	
Inv.619	1 - Purchasers are aware & accepts that ANY changes made to upgrades after signing this Purchasers Extra Form are subject to a minimum administration fee of \$500. PLUS a 10% holdback fee.
Line7761	Note:
30Jun16 / 28Sep16	
Inv.619	1 - BONUS PACKAGE: \$7,500.00 (INCLUDING TAXES) WORTH OF UPGRADES FROM GOLD PARK HOMES DÉCOR CENTRE IS BEING APPLIED TOWARD THE STRUCTURAL APPOINTMENT. PURCHASER HAS A REMAINING AMOUNT OF \$00 (INCLUDING TAXES) TO BE USED TOWARD THE COLOUR APPOINTMENT.
Line7762	Note:
30Jun16 / 28Sep16	

PLUMBING

Kleinburg Glen - 12 - 1 - 38-2 Elev.A KINGSTON

Inv.619	1 - GARAGE: HOSE BIB - STANDARD TO UPGRADED WITH HOT AND COLD WATER VALVE
Line7759	Note:
30Jun16 / 28Sep16	

WINDOWS - BASEMENT


Inv.619	4 - BASEMENT WINDOWS - UPGRADE 2 BASEMENT WINDOWS TO 30 INCH X 24 INCH - MAY REQUIRE INSTALLATION OF WINDOW WELL
Line7758	Note: LOB condition rear windows standard larger. See CR on PE 872-1
30Jun16 / 28Sep16	

Lot 12


JUNE 30 2016

MSR


GAS.

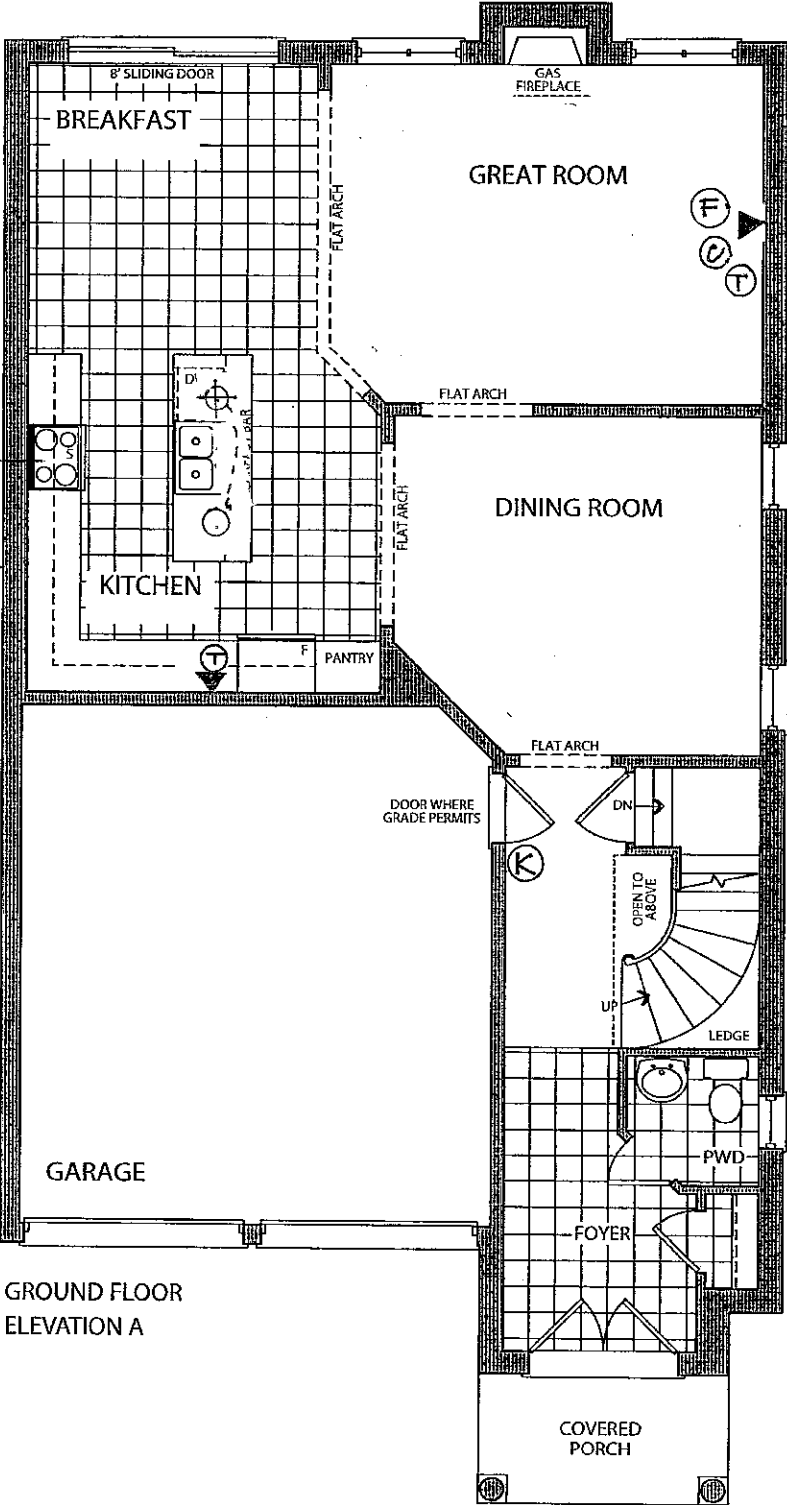


GROUND FLOOR
ELEVATION A

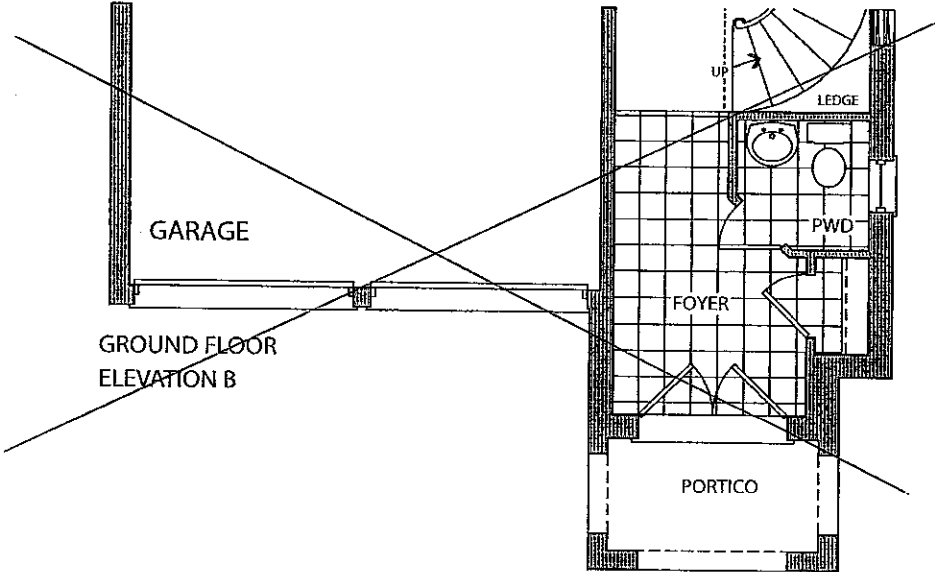

GROUND FLOOR
ELEVATION B

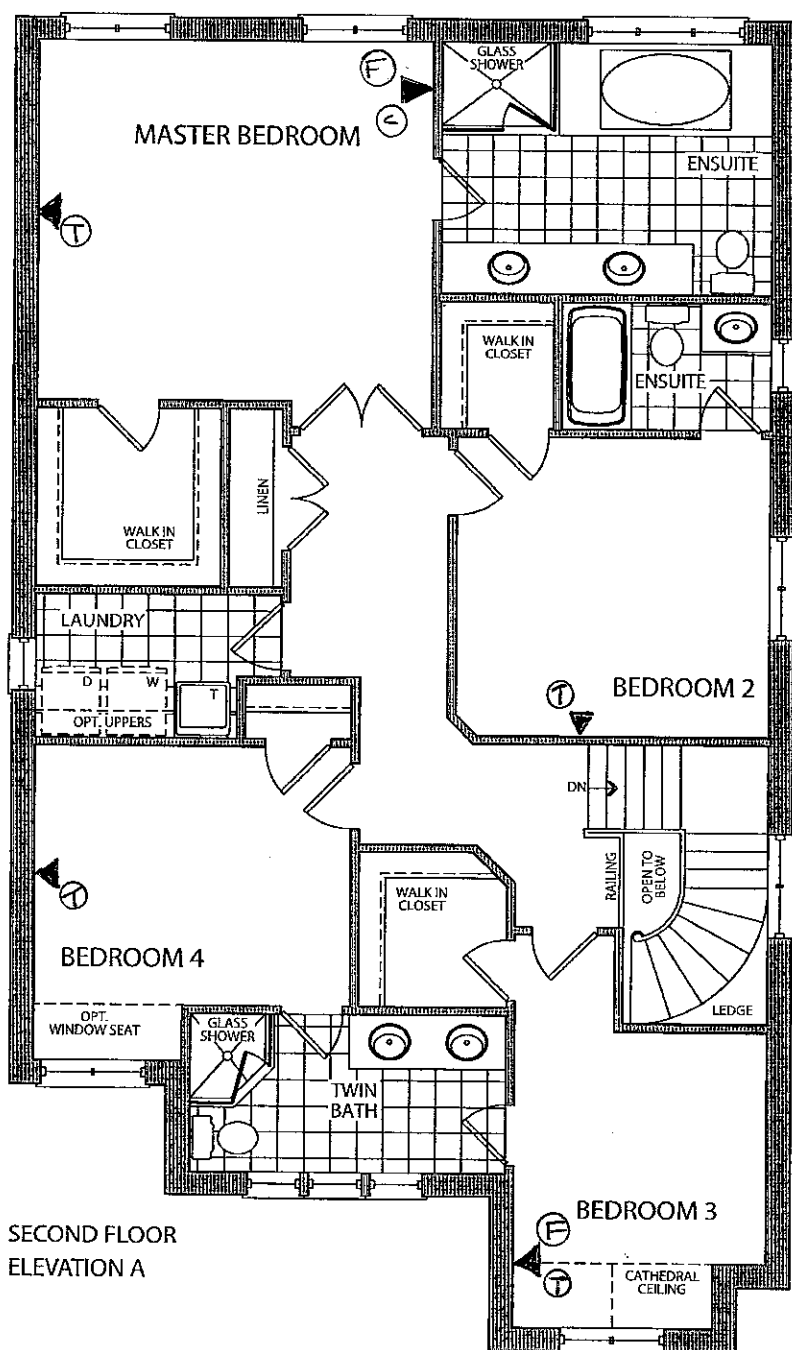

SECOND FLOOR
ELEVATION A

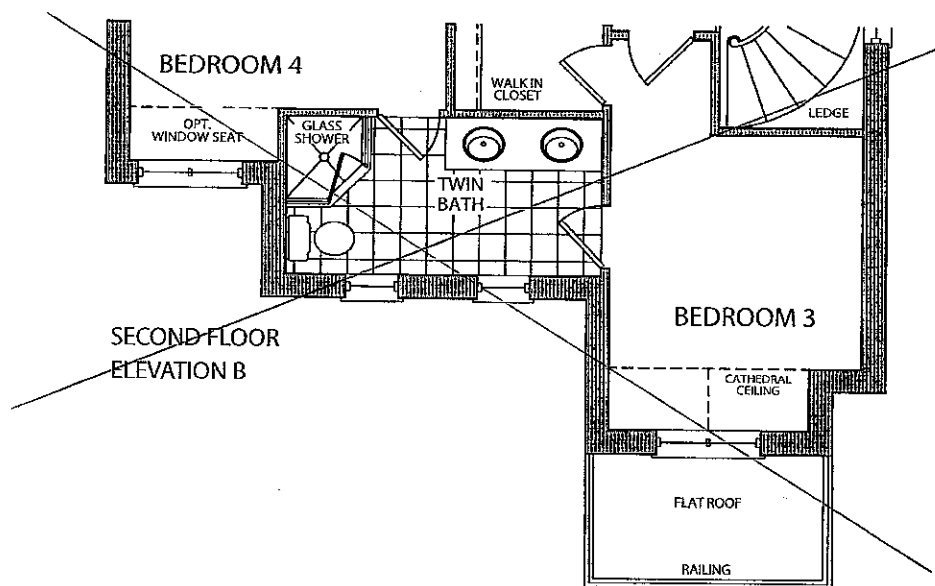


SECOND FLOOR
ELEVATION B

Lot 12

JUNE 30 2016

MSR

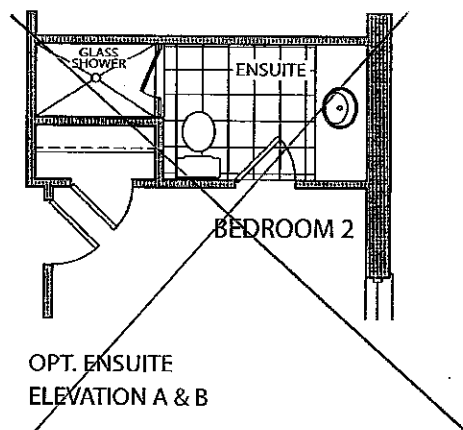

OPT. ENSUITE
ELEVATION A & B

LEGEND.

○ MOVE STD LIGHT

⊕ R/In ceiling cap.

Ⓚ R/In KEY PAD

ⓕ FIBRE OPTIC


▲ Ⓣ PHONE

▲ ⓐ CABLE

LOT 12

JUNE 3 2016

MSF

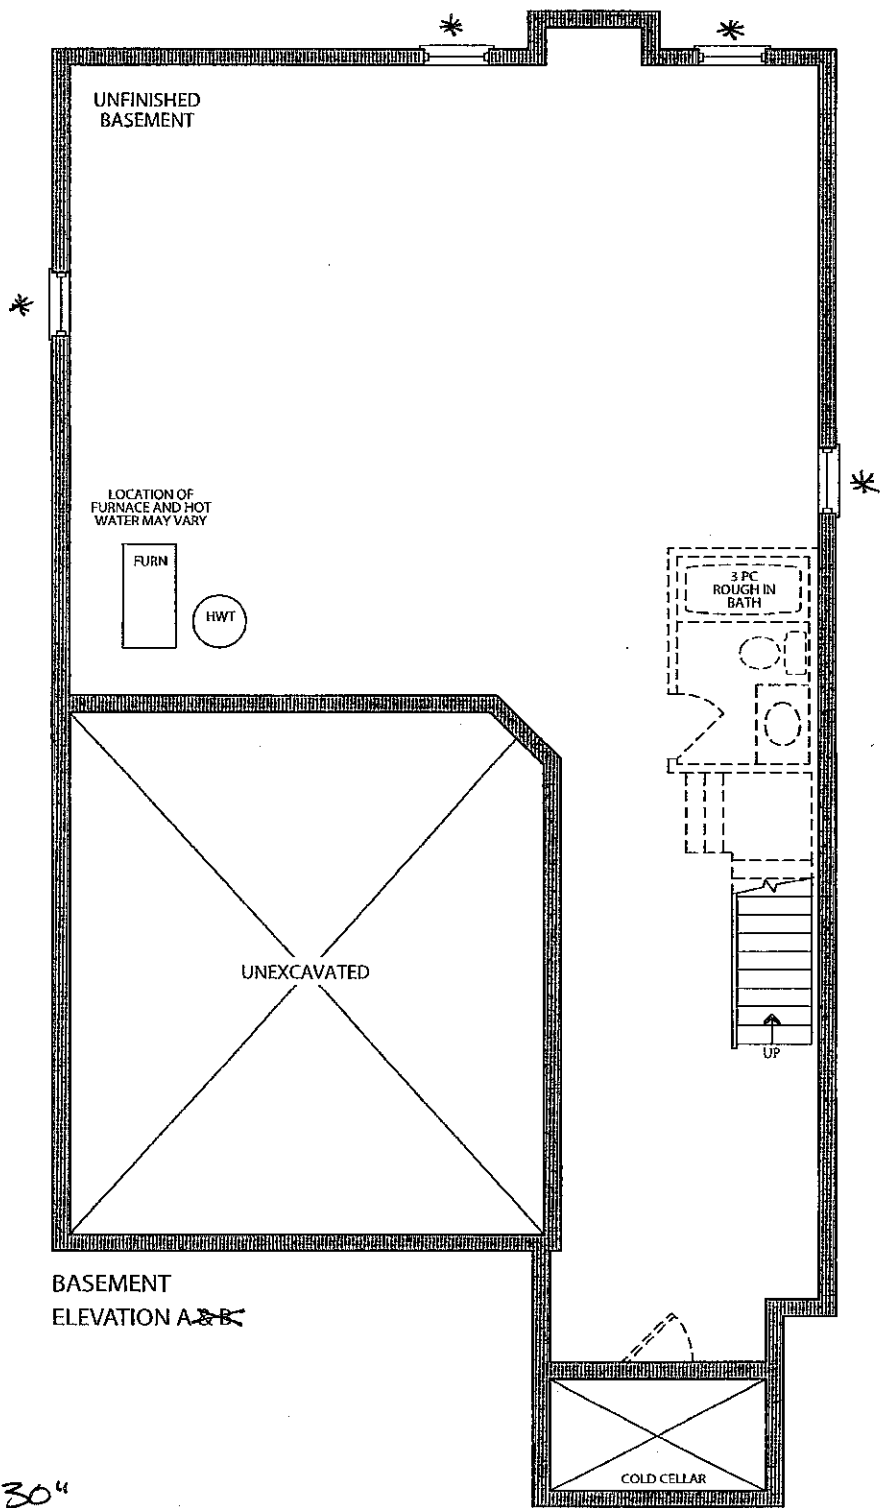

* 24 x 30"
WINDOW.



Stacey Carlete
Project Coordinator



Claude Azzopardi
Contracts Manager



Nancy Martini
Corporate Controller



38.1 The Hampton			
Elevation	Circle One	A	2339.9 Square Feet
		B	2327.8 Square Feet
Taller Ceilings	Circle All that Apply	GFTC	9' Ceilings Ground Floor
		MFTC	10' Ceilings Main Floor
		SFTC	9' Ceilings Second Floor
Optional Layouts	Circle All that Apply		

38.2 The Kingston			
Elevation	Circle One	A	2445.5 Square Feet
		B	2445.9 Square Feet
Taller Ceilings	Circle All that Apply	GFTC	9' Ceilings Ground Floor
		MFTC	10' Ceilings Main Floor
		SFTC	9' Ceilings Second Floor
Optional Layouts	Circle All that Apply	SFA1	SECOND FLOOR Shower in Lieu of Tub (Bedroom 2)

38.3 The Birkdale			
Elevation	Circle One	A	2574.1 Square Feet
		B	2575.5 Square Feet
Taller Ceilings	Circle All that Apply	GFTC	9' Ceilings Ground Floor
		MFTC	10' Ceilings Main Floor
		SFTC	9' Ceilings Second Floor
Optional Layouts	Circle All that Apply	SFA1	SECOND FLOOR Shower in Lieu of Tub (Bedroom 2)

38.4 The Bridgeport			
Elevation	Circle One	A	2723.2 Square Feet
		B	2762.0 Square Feet
Taller Ceilings	Circle All that Apply	GFTC	9' Ceilings Ground Floor
		MFTC	10' Ceilings Main Floor
		SFTC	9' Ceilings Second Floor
Optional Layouts	Circle All that Apply	SFA3	SECOND FLOOR Shower in Lieu of Tub (Twin Bath)

38.5 The Rosemont			
Elevation	Circle One	A	2804.9 Square Feet
		B	2804.5 Square Feet
Taller Ceilings	Circle All that Apply	GFTC	9' Ceilings Ground Floor
		MFTC	10' Ceilings Main Floor
		SFTC	9' Ceilings Second Floor
Optional Layouts	Circle All that Apply	SFA1	SECOND FLOOR Shower in Lieu of Tub (Bedroom 2)
		SFA3	SECOND FLOOR Shower in Lieu of Tub (Twin Bath)
		SFA5	SECOND FLOOR Additional Bedroom

38.6 The Wyndham			
Elevation	Circle One	A	2893.5 Square Feet
		B	2896.0 Square Feet
Taller Ceilings	Circle All that Apply	GFTC	9' Ceilings Ground Floor
		MFTC	10' Ceilings Main Floor
		SFTC	9' Ceilings Second Floor
Optional Layouts	Circle All that Apply	SFA1	SECOND FLOOR Shower in Lieu of Tub (Bedroom 2)
		SFA3	SECOND FLOOR Shower in Lieu of Tub (Twin Bath)
		SFA5	SECOND FLOOR Additional Bedroom

Lot 12
JUNE 30 2016.
MSR