

Kleinburg Glen - 15 - 1 - 42-4 Elev.B NATIONAL OPT- SFA5

CENTRAL VAC AND WIRING

Inv.511	1 - LAUNDRY ROOM Install and additional ROUGH - IN FOR EXTRA SECURITY KEY PAD (see sketch)
Line6513	Note:
20May16 / 3Nov16	
Inv.511	1 - GREAT ROOM - Install a CONDUIT PIPE - FOR TELEVISION - MUST SPECIFY LOCATION AND TERMINATION POINT from Great Room to basement for future TV above fireplace, approx. 60" A.F.F., see plan for location
Line6514	Note:
20May16 / 3Nov16	
Inv.511	1 - DEN - Install an additional cable rough-in in Den, see sketch
Line6529	Note:
20May16 / 3Nov16	

DRYWALL

Inv.511	1 - SMOOTH CEILINGS - (2 - Story Design) SECOND FLOOR
Line6516	Note:
20May16 / 3Nov16	

ELECTRICAL

Inv.511	1 - 1 - GREAT ROOM - Install a 110V WALL RECEPTACLE ON NORMAL CIRCUIT - MUST SPECIFY LOCATION above fireplace for future TV, approx. 60" A.F.F., see plan for location
Line6523	Note:
20May16 / 3Nov16	

EXTERIOR COLOURS

Inv.941	1 - EXTERIOR COLOUR PACKAGE 4
Line13380	Note:
3Nov16 / 3Nov16	

FRAMING

Inv.511	1 - OPTIONAL SECOND FLOOR 5TH BEDROOM
Line13375	Note:
20May16 / 3Nov16	

GARAGE DOORS

Inv.511	1 - GARAGE DOOR OPENER - WITH 1 REMOTE - PRICE IS PER DOOR
Line6538	Note:
20May16 / 3Nov16	
Inv.511	1 - EXTRA REMOTE CONTROL FOR GARAGE DOOR
Line6539	Note:
20May16 / 3Nov16	

GLASS AND MIRROR

Inv.511	1 - MASTER ENSUITE - CONVERT FRAMED SHOWER TO 10MM FRAMLESS SHOWER ENCLOSURE WITH DOOR AND 10MM SIDE PANEL
Line6517	Note:
20May16 / 3Nov16	

HVAC

Kleinburg Glen - 15 - 1 - 42-4 Elev.B NATIONAL OPT- SFA5

Inv.511	1 - HUMIDIFIER: WB3 - 17 (UP TO 3,000 SQ.FT.)
Line6518	Note:
20May16 / 3Nov16	

MISC.

Inv.511	1 - Purchasers are aware & accepts that ANY changes made to upgrades after signing this Purchasers Extra Form are subject to a minimum administration fee of \$500. PLUS a 10% holdback fee.
Line6543	Note:
20May16 / 3Nov16	

Inv.511	1 - STRUCTURAL DISCLAIMER: Purchaser has attended a Structural appointment at the Decor Centre & has DECLINED any additional upgrades and accepts and acknowledges that there will be no further structural changes/additions/deletions to be made upon
Line6542	Note:
20May16 / 3Nov16	


Inv.511	1 - BONUS PACKAGE: \$10,000.00 (INCLUDING TAXES) WORTH OF UPGRADES FROM GOLD PARK HOMES DÉCOR CENTRE IS BEING APPLIED TOWARD THE STRUCTURAL APPOINTMENT. PURCHASER HAS A REMAINING AMOUNT OF \$00 (INCLUDING TAXES) TO BE USED TOWARD THE COLOUR APPOINTMENT.
Line6544	Note:
20May16 / 3Nov16	

PLUMBING

Inv.511	1 - KITCHEN - Install a ROUGH - IN - WATERLINE FOR FRIDGE
Line6525	Note:
20May16 / 3Nov16	

WINDOWS - BASEMENT

Inv.511	5 - BASEMENT WINDOWS - UPGRADE EXISTING BASEMENT WINDOW TO 30 INCH X 24 INCH - MAY REQUIRE INSTALLATION OF WINDOW WELL
Line6520	Note:
20May16 / 3Nov16	

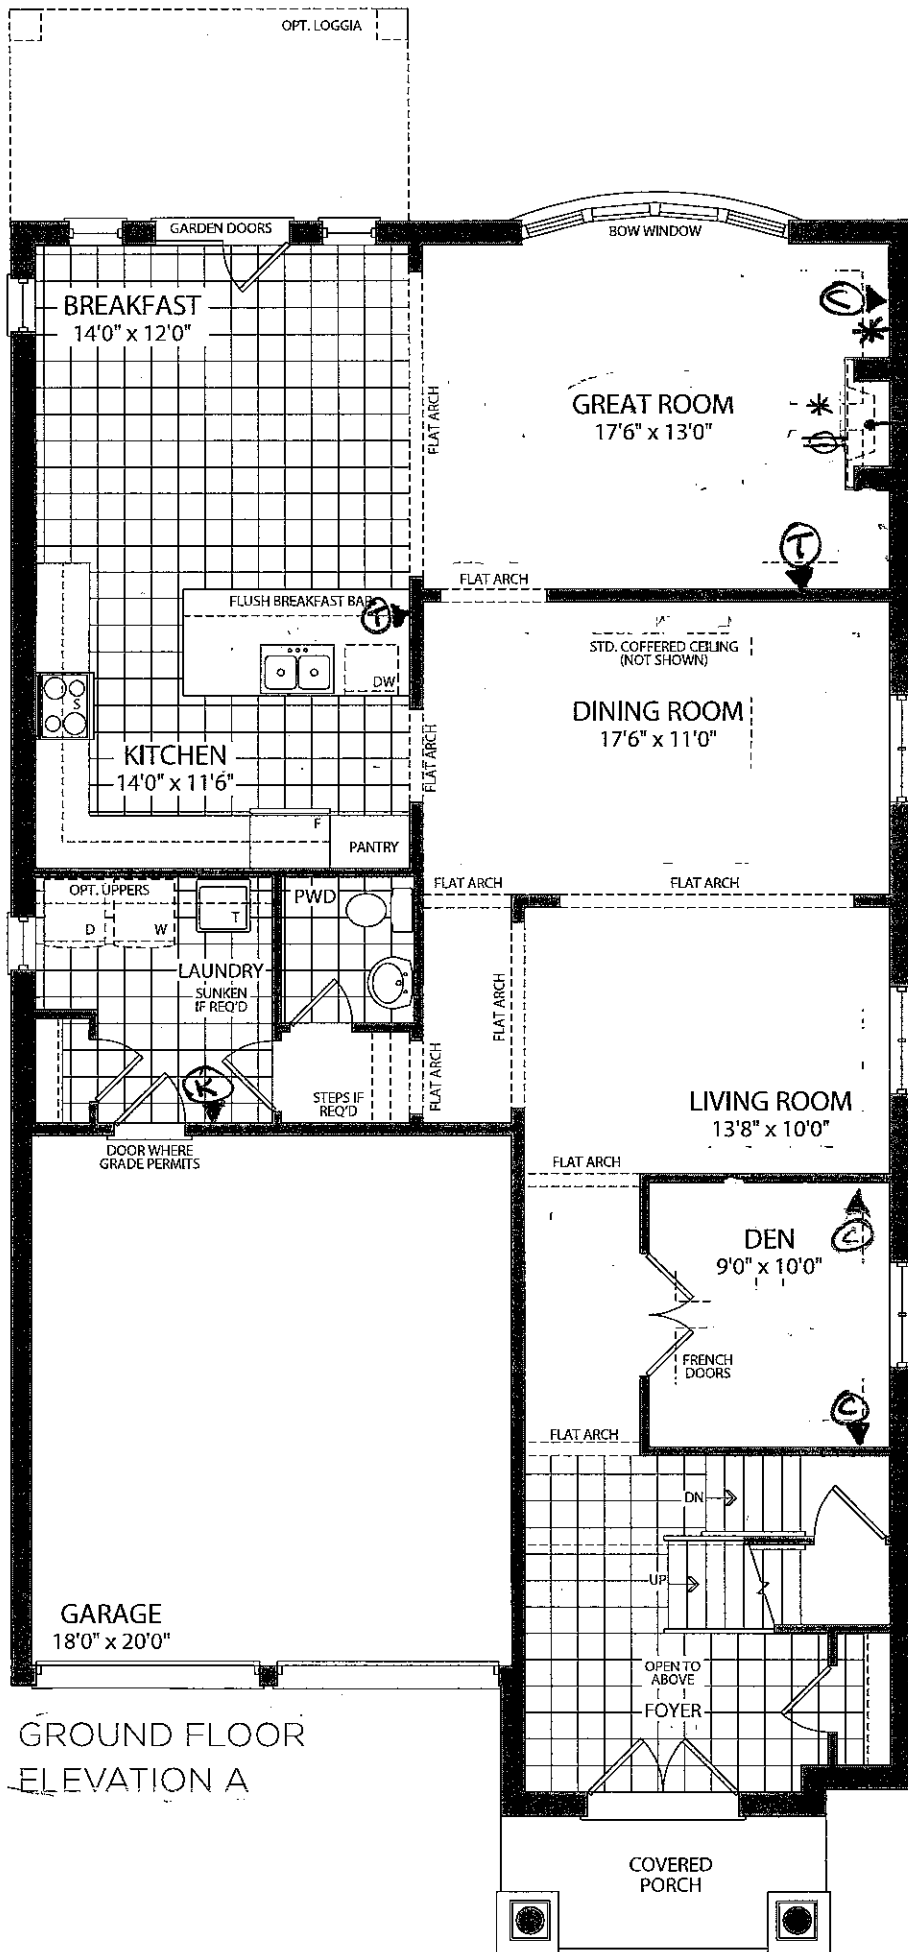


2" conduit +
ELECT.
60" AFF (approx)

LEGEND

- * - 2" CONDUIT
- ⌚ - ELECT. OUTLET
- ▲ (C) - CABLE
- ⌚ (K) - KEYPAD

GROUND FLOOR
ELEVATION A

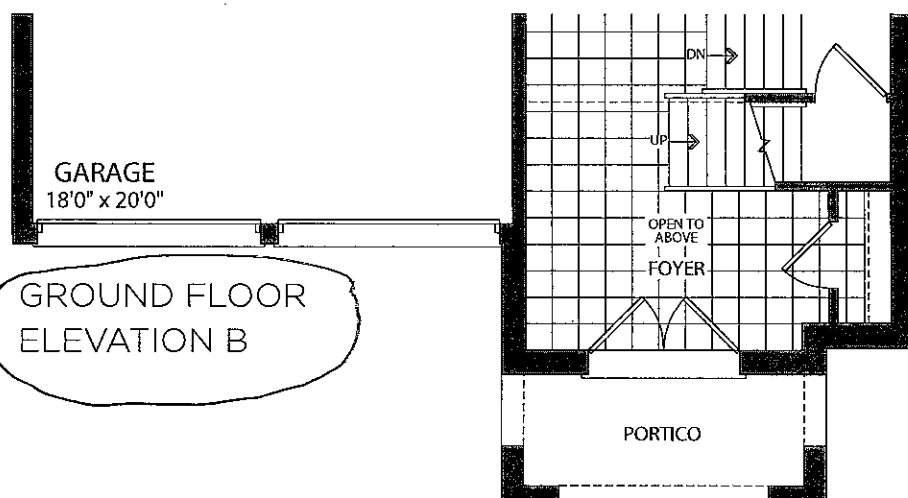

GROUND FLOOR
ELEVATION B


LOT 15



JUNE 6 2016


Lot 15

*Smooth ceilings

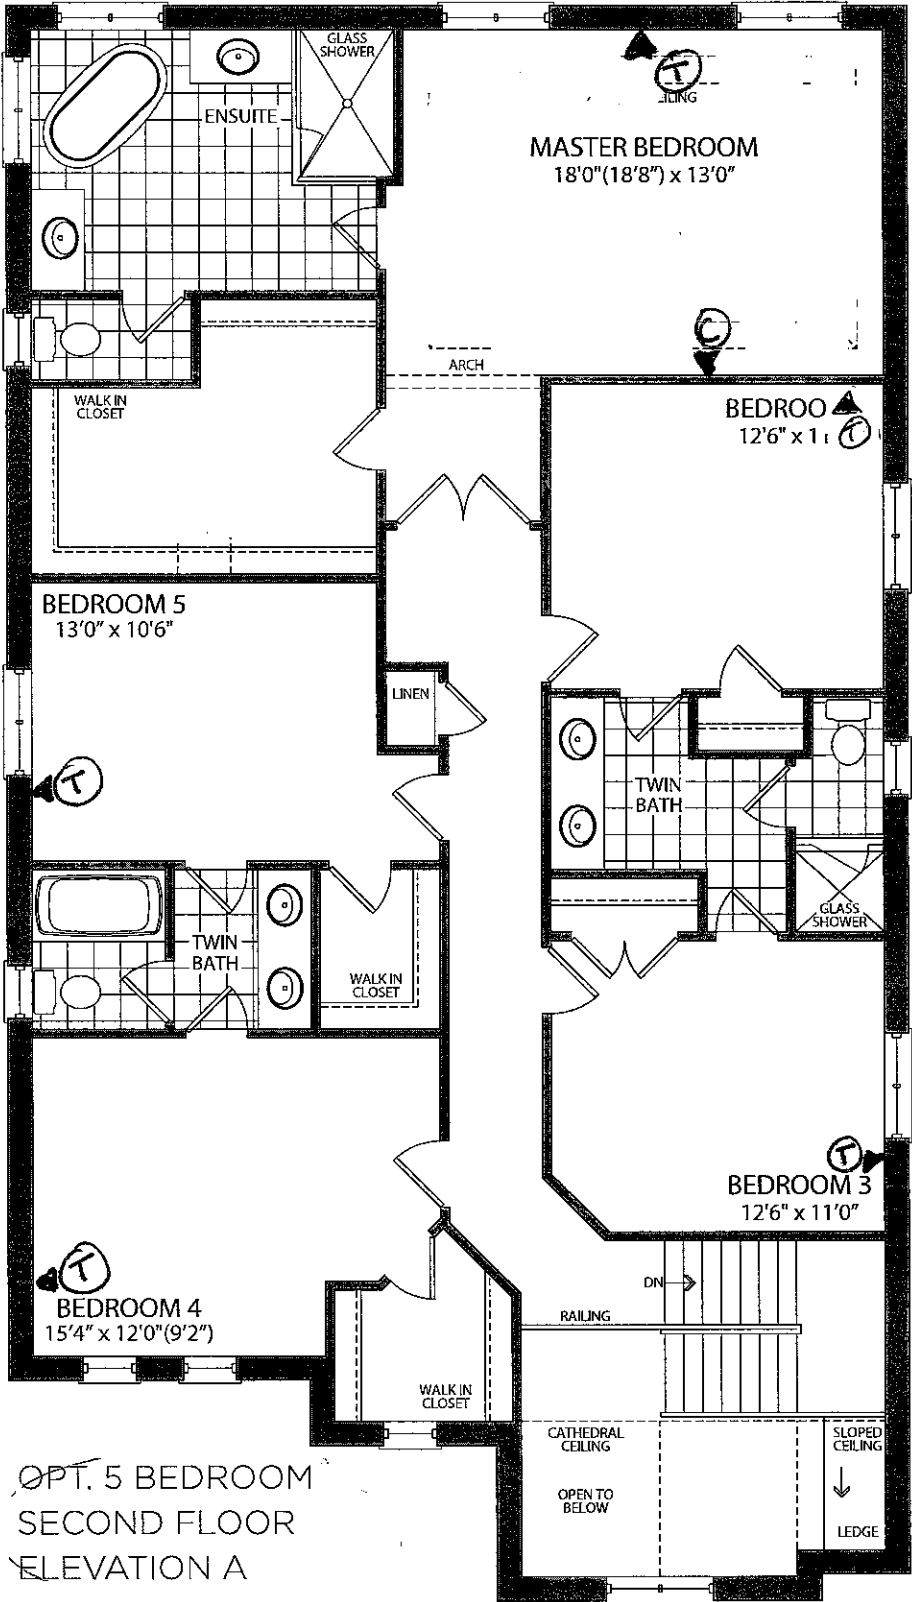

OPT. 5 BEDROOM
SECOND FLOOR
ELEVATION A

LOT 15
③
JUNE 6 2016.

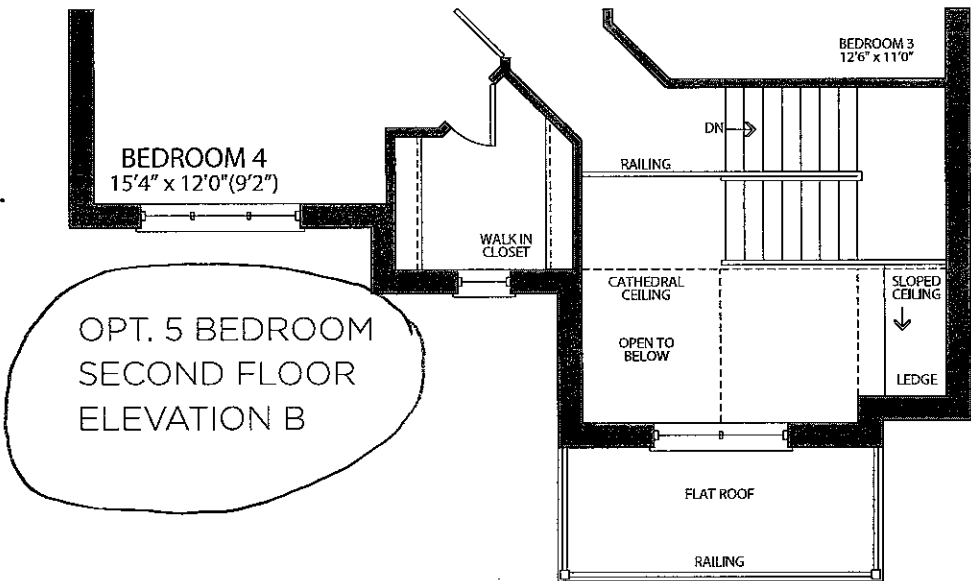

OPT. 5 BEDROOM
SECOND FLOOR
ELEVATION B

Lot 15



LOT 15
(B) JUNE 6 2016.



Lot 15



Stacey Carlete
Project Coordinator



Claude Azzopardi
Contracts Manager



Nancy Martini
Corporate Controller



42.1 The Royalton			
Elevation	Circle One	A	2956.7 Square Feet
		B	2983.1 Square Feet
Taller Ceilings	Circle All that Apply	GFTC	9' Ceilings Ground Floor
		MFTC	10' Ceilings Main Floor
		SFTC	9' Ceilings Second Floor
Optional Layouts	Circle All that Apply	SFA5	SECOND FLOOR Additional Bedroom

42.2 The Hazelton			
Elevation	Circle One	A	3083.8 Square Feet
		B	3083.8 Square Feet
Taller Ceilings	Circle All that Apply	GFTC	9' Ceilings Ground Floor
		MFTC	10' Ceilings Main Floor
		SFTC	9' Ceilings Second Floor
Optional Layouts	Circle All that Apply	SFA5	SECOND FLOOR Additional Bedroom

42.3 The Carlton			
Elevation	Circle One	A	3287.8 Square Feet
		B	3295.5 Square Feet
Taller Ceilings	Circle All that Apply	GFTC	9' Ceilings Ground Floor
		MFTC	10' Ceilings Main Floor
		SFTC	9' Ceilings Second Floor
Optional Layouts	Circle All that Apply	SFA5	SECOND FLOOR Additional Bedroom

42.4 The National			
Elevation	Circle One	A	3371.7 Square Feet
		B	3371.7 Square Feet
Taller Ceilings	Circle All that Apply	GFTC	9' Ceilings Ground Floor
		MFTC	10' Ceilings Main Floor
		SFTC	9' Ceilings Second Floor
Optional Layouts	Circle All that Apply	SFA5	SECOND FLOOR Additional Bedroom

42.5 The Madison			
Elevation	Circle One	A	3550.9 Square Feet
		B	3551.9 Square Feet
Taller Ceilings	Circle All that Apply	GFTC	9' Ceilings Ground Floor
		MFTC	10' Ceilings Main Floor
		SFTC	9' Ceilings Second Floor
Optional Layouts	Circle All that Apply	GFA1	GROUND FLOOR Alternative Layout Kitchen/Family Room
		SFA5	SECOND FLOOR Additional Bedroom

B JUNE 6 2016.