

Kleinburg Glen - 17 - 1 - 42-1 Elev.B ROYALTON
CENTRAL VAC AND WIRING

Inv.623	2 - MUD ROOM & MASTER BEDROOM: ROUGH - IN FOR EXTRA SECURITY KEY PAD
Line7873	Note: Please see floor plan for location
5Jul16 / 17Aug16	
Inv.623	1 - CONDUIT PIPE - FROM ATTIC TO ELECTRICAL PANEL - Please install a straight run from Electrical Panel to Attic.
Line7875	Note:
5Jul16 / 17Aug16	
Inv.623	1 - DEN: RELOCATE UPGRADED CAT 6 WIRING FROM KITCHEN TO DEN. Please see floor plan for location.
Line7883	Note:
5Jul16 / 17Aug16	
Inv.623	1 - GREAT ROOM - CONDUIT PIPE - FOR TELEVISION ABOVE FIREPLACE Please see floor plan for location and termination point.
Line7876	Note:
5Jul16 / 17Aug16	
Inv.623	6 - CAT 6 WIRING - UPGRADE ALL CAT 5 OUTLET TO CAT 6. DEN/GREAT ROOM / ALL BEDROOMS
Line7886	Note:
5Jul16 / 17Aug16	

DRYWALL

Inv.623	1 - GARAGE / DRYWALL: COMPLETE EXTERIOR WALL INSULATION
Line7885	Note:
5Jul16 / 17Aug16	
Inv.623	1 - 2ND FLOOR: SMOOTH CEILINGS - (2 - Story Design)
Line7882	Note:
5Jul16 / 17Aug16	

ELECTRICAL

Inv.623	1 - GREAT ROOM: 110V WALL RECEPTACLE ON NORMAL CIRCUIT - ABOVE FIREPLACE TO ACCOMMODATE FOR FUTURE TELEVISION
Line7877	Note:
5Jul16 / 17Aug16	
Inv.623	1 - KITCHEN: ADDITIONAL STANDARD FIXTURE WITH SWITCH - OVER ISLAND. Please see floor plan for location
Line7887	Note:
5Jul16 / 17Aug16	
Inv.623	1 - KITCHEN: ADD 110V WALL RECEPTACLE ON DEDICATED CIRCUIT - FOR FUTURE MICROWAVE - OVER THE RANGE. Please see floor plan for location
Line7888	Note:
5Jul16 / 17Aug16	

EXTERIOR COLOURS

Inv.623	1 - EXTERIOR COLOUR PACKAGE 6
Line10230	Note:
5Jul16 / 17Aug16	

FRAMING

Kleinburg Glen - 17 - 1 - 42-1 Elev.B ROYALTON

Inv.623	1 - MAIN FLOOR CEILING 10FT
Line7881	Note:
5Jul16 / 17Aug16	

MISC.

Inv.623	1 - Purchaser has attended a Structural appointment at the Decor Centre & has DECLINED any additional upgrades and accepts and acknowledges that there will be no further structural changes/additions/deletions to be made upon signing on July 5, 2016.
Line7889	Note:
5Jul16 / 17Aug16	

Inv.623	1 - BONUS PACKAGE: \$10,000.00 (INCLUDING TAXES) WORTH OF UPGRADES FROM GOLD PARK HOMES DÉCOR CENTRE IS NOT BEING APPLIED TOWARD THE STRUCTURAL APPOINTMENT.
Line7891	Note: PURCHASER HAS A REMAINING AMOUNT OF \$10,000.00 (INCLUDING TAXES) TO BE USED TOWARD THE COLOUR APPOINTMENT
5Jul16 / 17Aug16	

Inv.623	1 - Purchasers are aware & accepts that ANY changes made to upgrades after signing this Purchasers Extra Form are subject to a minimum administration fee of \$500. PLUS a 10% holdback fee.
Line7890	Note:
5Jul16 / 17Aug16	

Inv.623	1 - Paid in full by cheque.
Line7892	Note:
5Jul16 / 17Aug16	



Stacey Carlete
Project Coordinator



Claude Azzopardi
Contracts Manager



Nancy Martini
Corporate Controller



42.1 The Royalton			
Elevation	Circle One	A	2956.7 Square Feet
		B	2983.1 Square Feet
Taller Ceilings	Circle All that Apply	GFTC	9' Ceilings Ground Floor
		MFTC	10' Ceilings Main Floor
		SFTC	9' Ceilings Second Floor
Optional Layouts	Circle All that Apply	SFA5	SECOND FLOOR Additional Bedroom

42.2 The Hazelton			
Elevation	Circle One	A	3083.8 Square Feet
		B	3083.8 Square Feet
Taller Ceilings	Circle All that Apply	GFTC	9' Ceilings Ground Floor
		MFTC	10' Ceilings Main Floor
		SFTC	9' Ceilings Second Floor
Optional Layouts	Circle All that Apply	SFA5	SECOND FLOOR Additional Bedroom

42.3 The Carlton			
Elevation	Circle One	A	3287.8 Square Feet
		B	3295.5 Square Feet
Taller Ceilings	Circle All that Apply	GFTC	9' Ceilings Ground Floor
		MFTC	10' Ceilings Main Floor
		SFTC	9' Ceilings Second Floor
Optional Layouts	Circle All that Apply	SFA5	SECOND FLOOR Additional Bedroom


42.4 The National			
Elevation	Circle One	A	3371.7 Square Feet
		B	3371.7 Square Feet
Taller Ceilings	Circle All that Apply	GFTC	9' Ceilings Ground Floor
		MFTC	10' Ceilings Main Floor
		SFTC	9' Ceilings Second Floor
Optional Layouts	Circle All that Apply	SFA5	SECOND FLOOR Additional Bedroom

42.5 The Madison			
Elevation	Circle One	A	3550.9 Square Feet
		B	3551.9 Square Feet
Taller Ceilings	Circle All that Apply	GFTC	9' Ceilings Ground Floor
		MFTC	10' Ceilings Main Floor
		SFTC	9' Ceilings Second Floor
Optional Layouts	Circle All that Apply	GFA1	GROUND FLOOR Alternative Layout Kitchen/Family Room
		SFA5	SECOND FLOOR Additional Bedroom


LOT 17



July 5, 2016

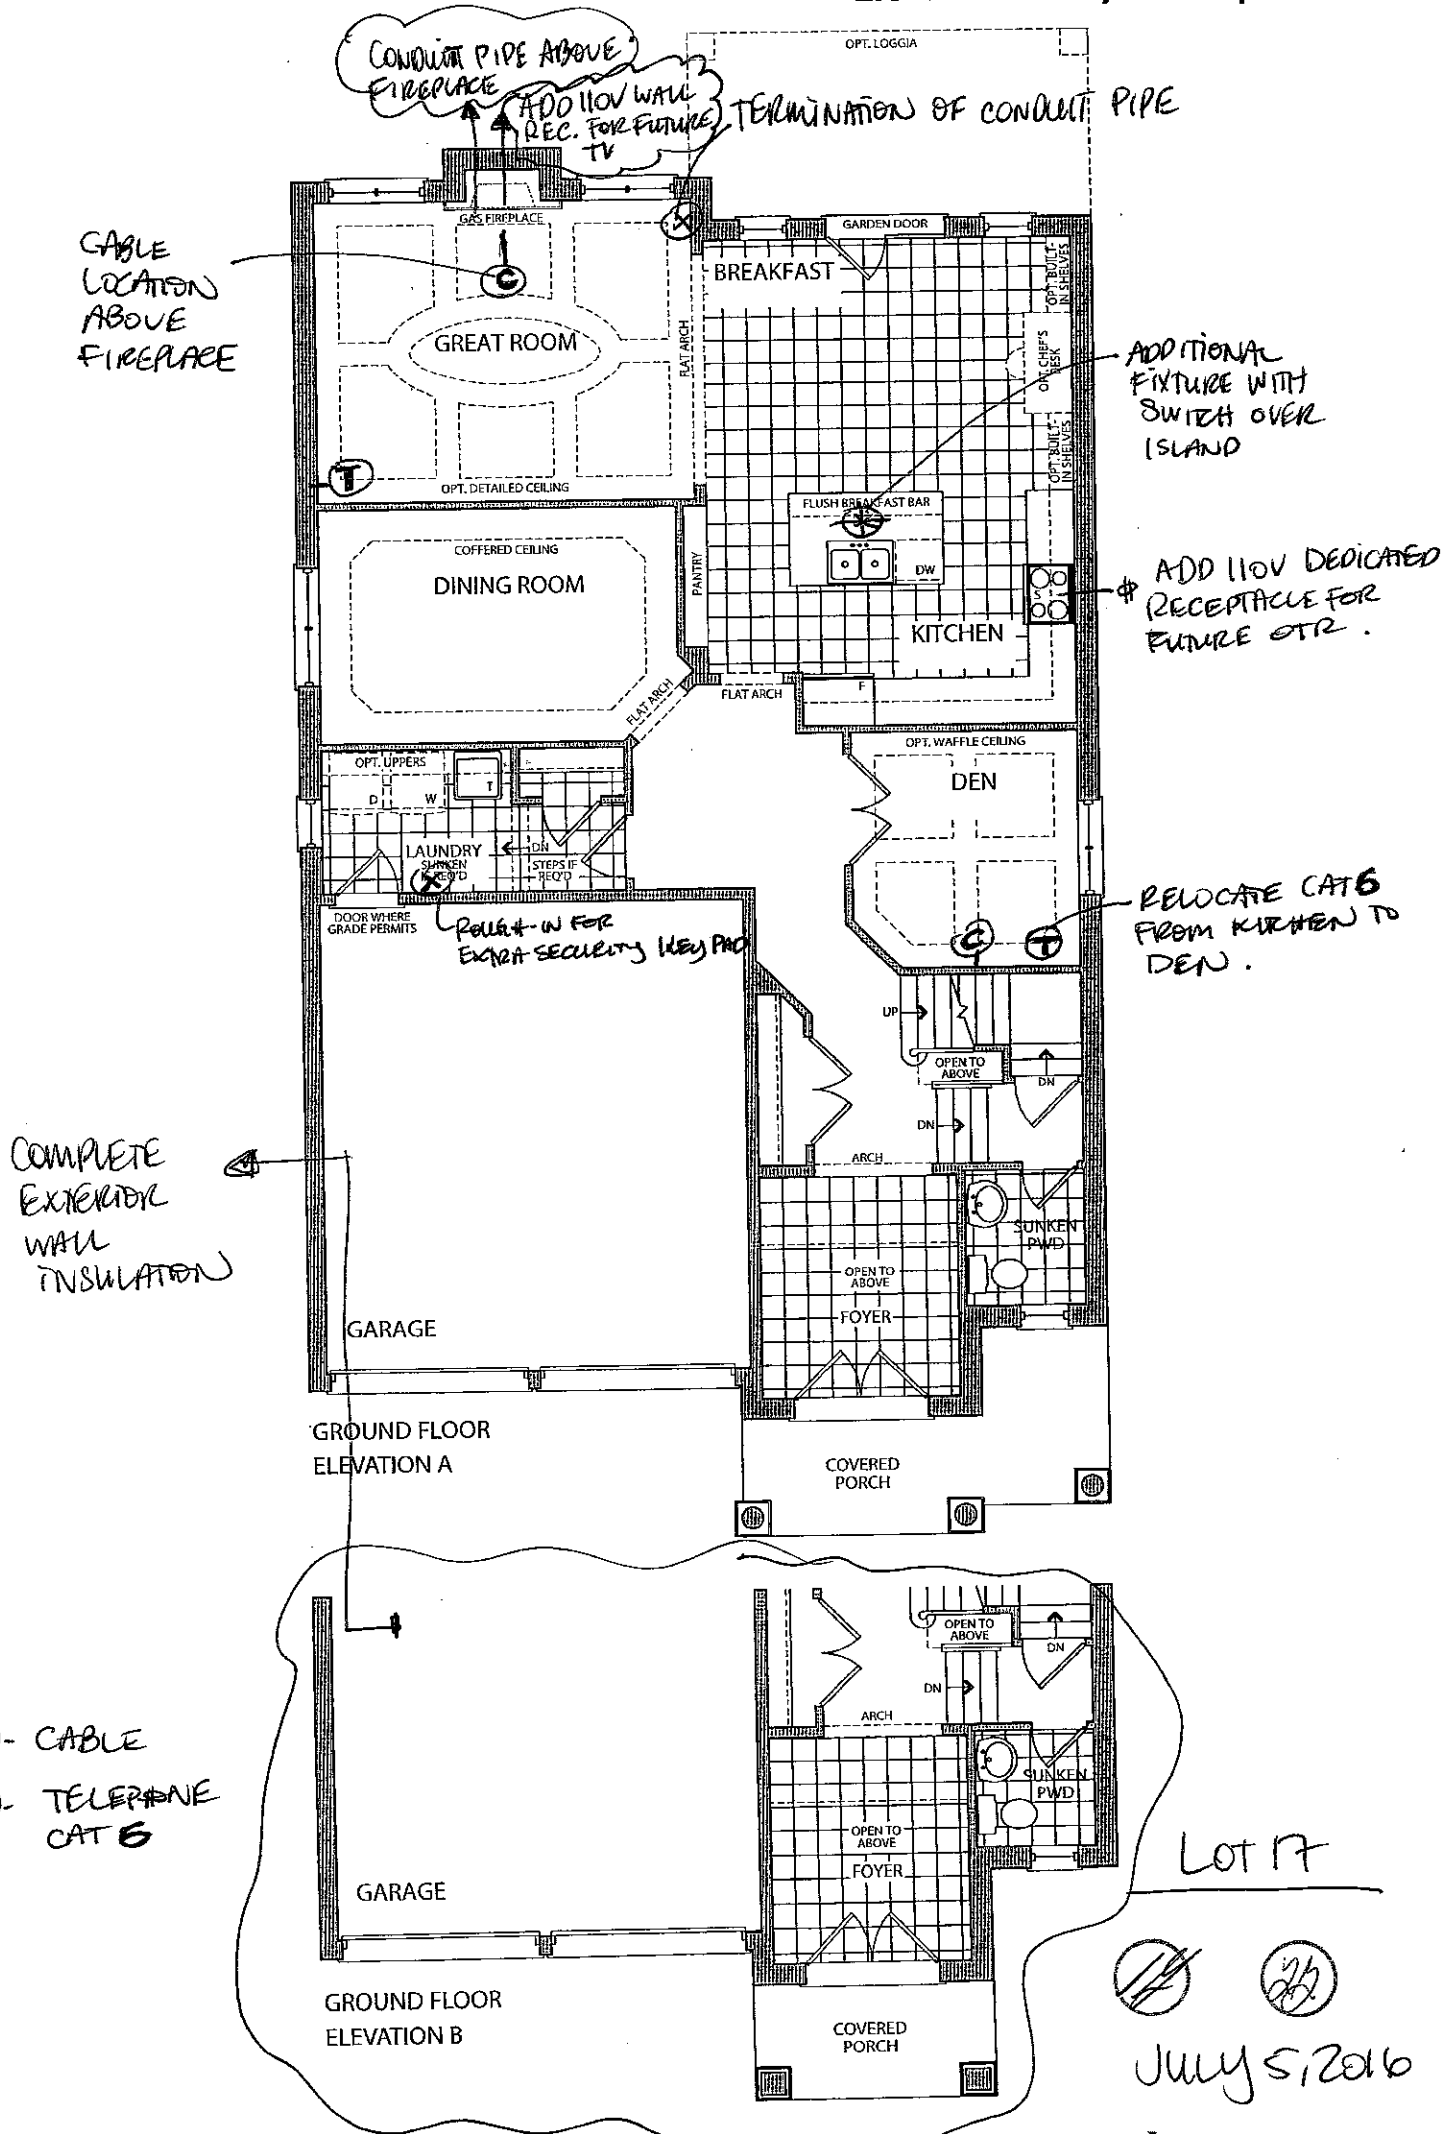


Roll-in for
extra
security
(key) pad

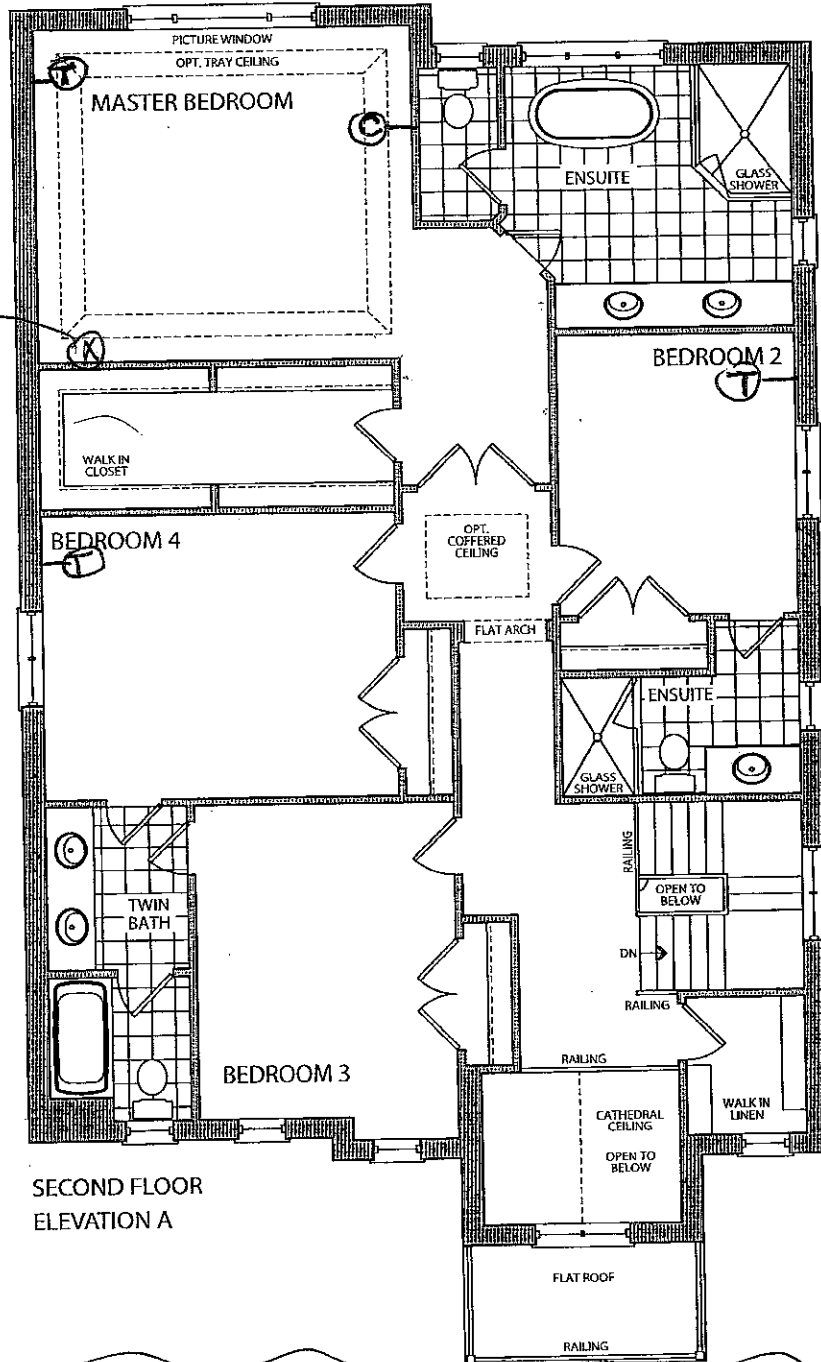

SECOND FLOOR
ELEVATION A

* Smooth
Ceilings


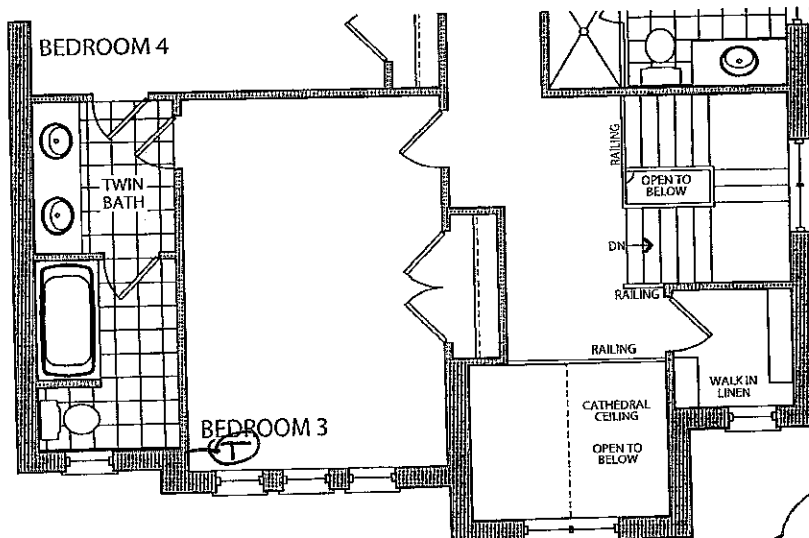


SECOND FLOOR
ELEVATION B

Lot 17

~~17~~ ~~22~~

JULY 5, 2016

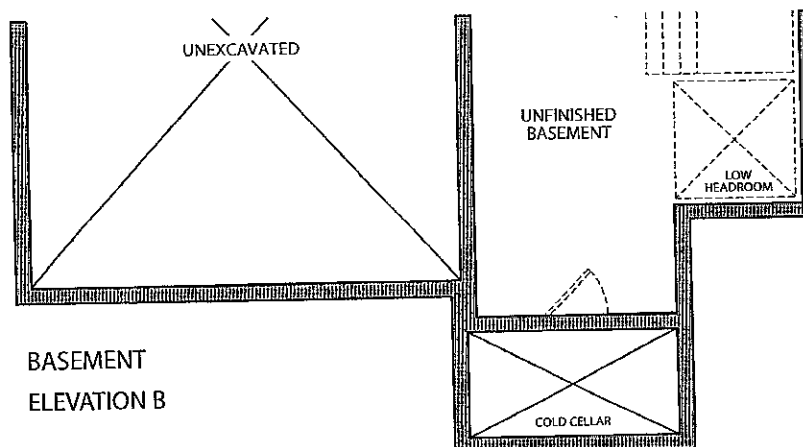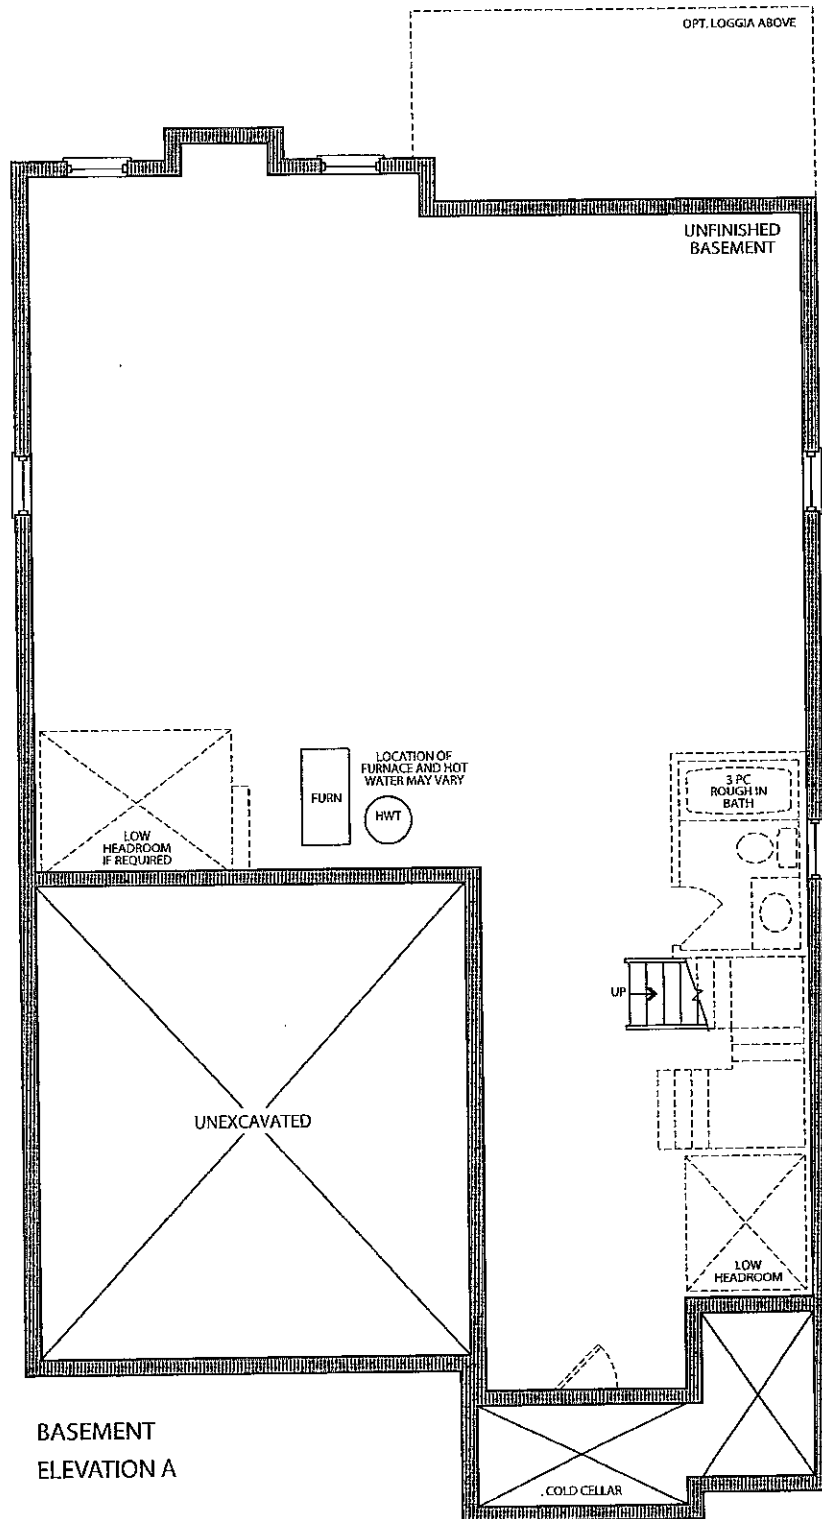

Lot 17

[Signature]

July 5, 2016