

Kleinburg Glen - 19R - 1 - 25-2 Elev.A HUDSON OPT- GFA1
CENTRAL VAC AND WIRING

Inv.545	1 - FAMILY ROOM -CONDUIT PIPE - FOR TELEVISION - from Family Room to basement for future TV above fireplace, approx. 60" A.F.F.- terminating right of fireplace at cable location, see plan for location
Line6613	Note:
7Jun16 / 16Aug16	
Inv.545	1 - FAMILY ROOM - Install 1 ROUGH - IN FIBER OPTIC CABLE - HOME RUN TO ELECTRICAL PANEL - Beside fireplace, see plan for location
Line6808	Note:
7Jun16 / 16Aug16	

ELECTRICAL

Inv.545	1 - FAMILY ROOM - Install a 110V WALL RECEPTACLE ON NORMAL CIRCUIT - above fireplace for future TV, approx. 60" A.F.F., see plan for location
Line6614	Note:
7Jun16 / 16Aug16	
Inv.545	1 - KITCHEN - In addition to builder's standard ceiling light, install 3 capped ROUGH - IN CEILING OUTLETS & 1 SWITCH (WITH COVER PLATES) - DOES NOT INCLUDE FIXTURE - To be centered above island. All 3 rough-ins to be on one switch. (See sketch for location
Line6615	Note:
7Jun16 / 16Aug16	

EXTERIOR COLOURS

Inv.753	1 - EXTERIOR COLOUR PACKAGE 2
Line10179	Note:
16Aug16 / 16Aug16	

GARAGE DOORS

Inv.545	1 - GARAGE DOOR OPENER - WITH 1 REMOTE - PRICE IS PER DOOR
Line6623	Note:
7Jun16 / 16Aug16	
Inv.545	1 - DIGITAL ENTRY KEYPAD
Line6624	Note:
7Jun16 / 16Aug16	

HVAC

Inv.545	1 - HUMIDIFIER: WB3 - 12 (UP TO 2,000 SQ.FT.)
Line6627	Note:
7Jun16 / 16Aug16	

MISC.

Inv.545	1 - BONUS PACKAGE: \$5,000.00 (INCLUDING TAXES) WORTH OF UPGRADES FROM GOLD PARK HOMES DÉCOR CENTRE IS BEING APPLIED TOWARD THE STRUCTURAL APPOINTMENT. PURCHASER HAS A REMAINING AMOUNT OF \$00 (INCLUDING TAXES) TO BE USED TOWARD THE COLOUR APPOINTMENT.
Line9808	Note:
7Jun16 / 16Aug16	
Inv.545	1 - Purchaser has attended a Structural appointment at the Decor Centre & has DECLINED any additional upgrades and accepts and acknowledges that there will be no further structural changes/additions/deletions to be made upon signing on June 10, 2016.
Line9806	Note:
7Jun16 / 16Aug16	



CONSTRUCTION SUMMARY

Kleinburg Glen - 19R - 1 - 25-2 Elev.A HUDSON OPT- GFA1




Inv.545	1 - Purchasers are aware & accepts that ANY changes made to upgrades after signing this Purchasers Extra Form are subject to a minimum administration fee of \$500. PLUS a 10% holdback fee.
Line9807	Note:
7Jun16 / 16Aug16	

PLUMBING

Inv.545	1 - KITCHEN -Add ROUGH - IN - WATERLINE FOR FRIDGE
Line6628	Note:
7Jun16 / 16Aug16	

WINDOWS AND DOORS



Inv.545	1 - FAMILY ROOM: GARDEN DOORS IN LIEU OF PATIO SLIDERS - 6FT X 80 INCH WITH CLEAR GLASS
Line9804	Note:
7Jun16 / 16Aug16	
Inv.545	1 - FAMILY ROOM: SIDELITES - 1 PAIR - 12 INCH x 80 INCH HEIGHT - MUST ADD WITH 6 FOOT DOORS IN LIEU OF 8 FOOT SLIDERS
Line9805	Note:
7Jun16 / 16Aug16	

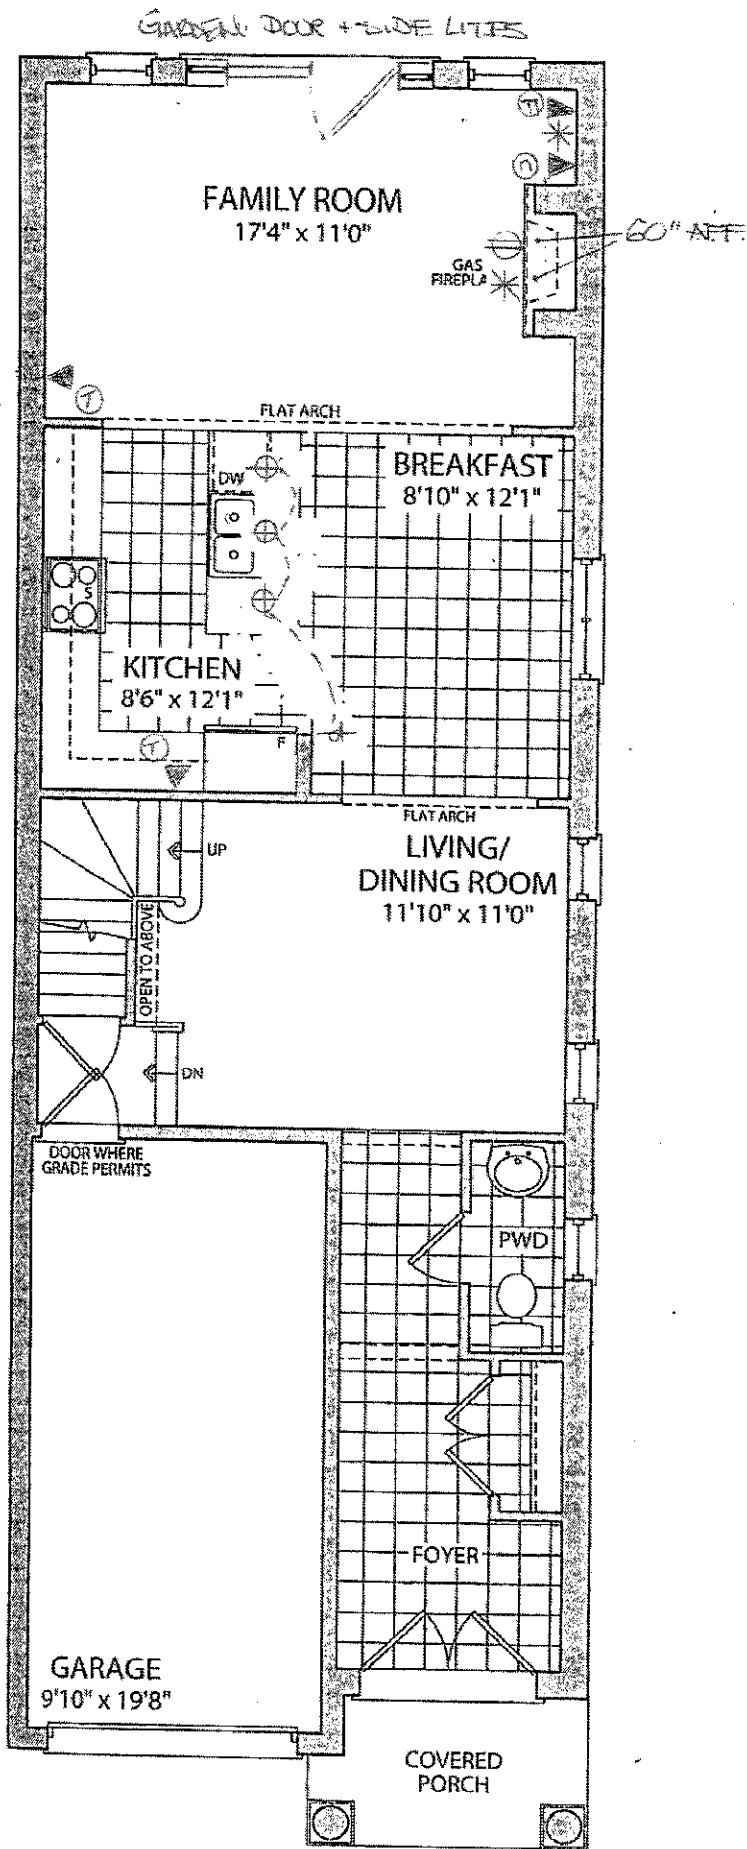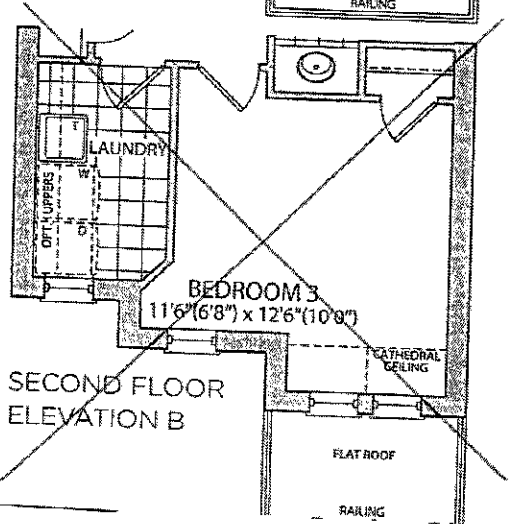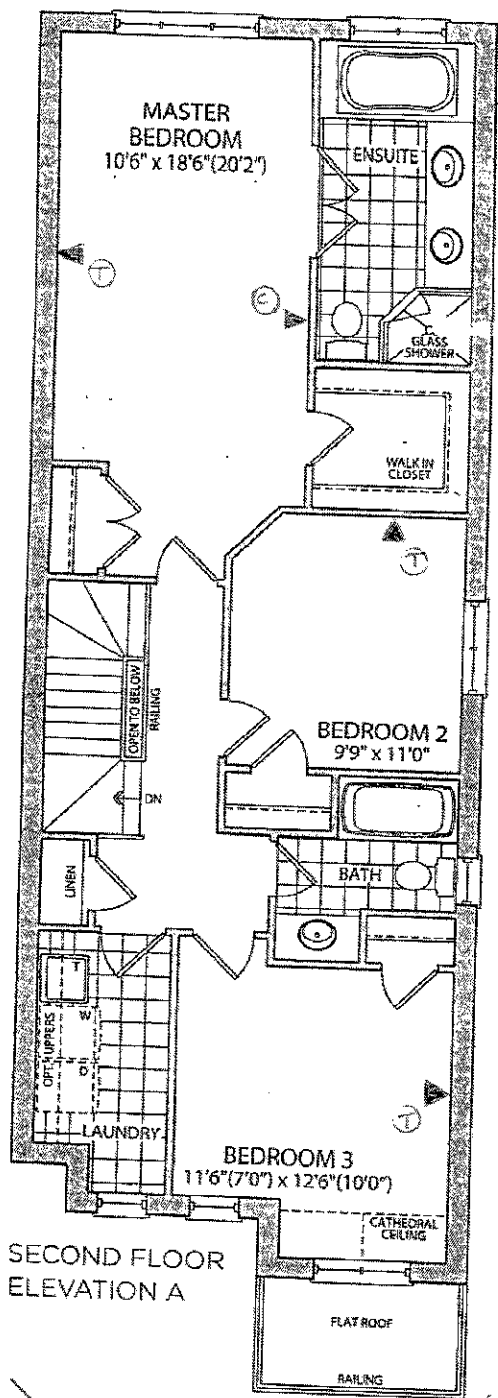


LEGEND

- * 2" CONDUIT
- ▲① PHONE
- ▲② CABLE
- ▲③ FIBER OPTIC
- ⓪ ELECTRICAL OUTLET
- ⊕ ROUGH-IN CAPPED CEILING OUTLET
- \$ SINGLE POLE SWITCH

LOT 19-R
AUG 4 2016
HUDSON A

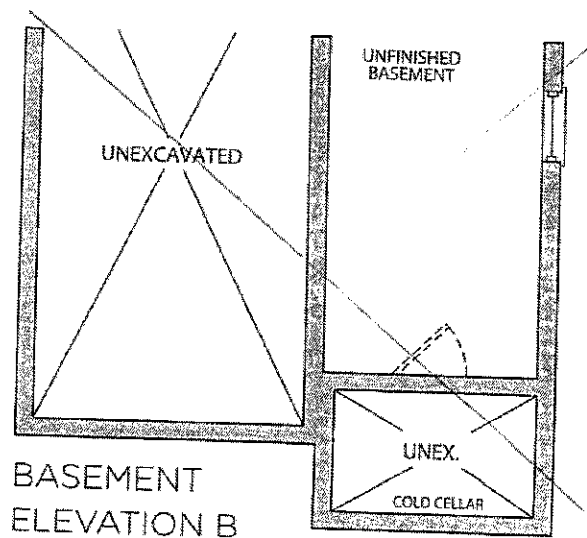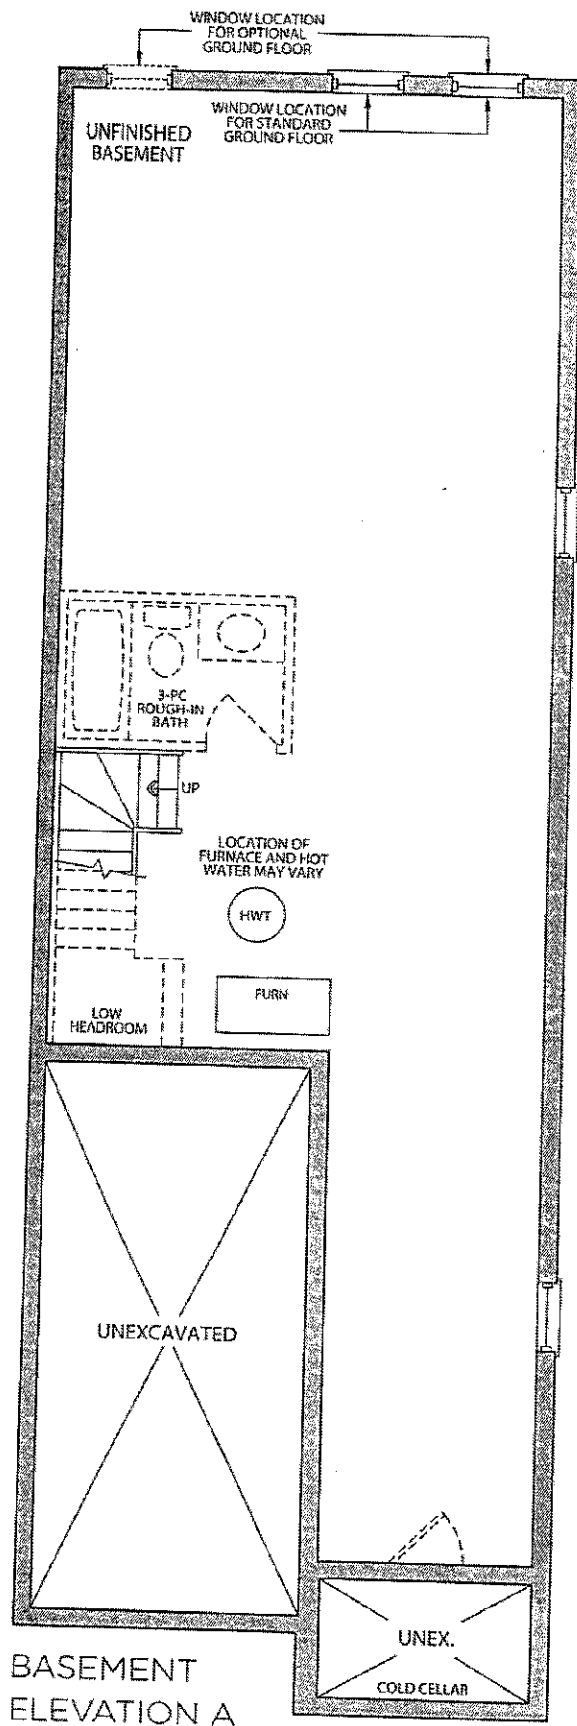

Lot 19-R
 AUG 4 2016
 HUDSON A

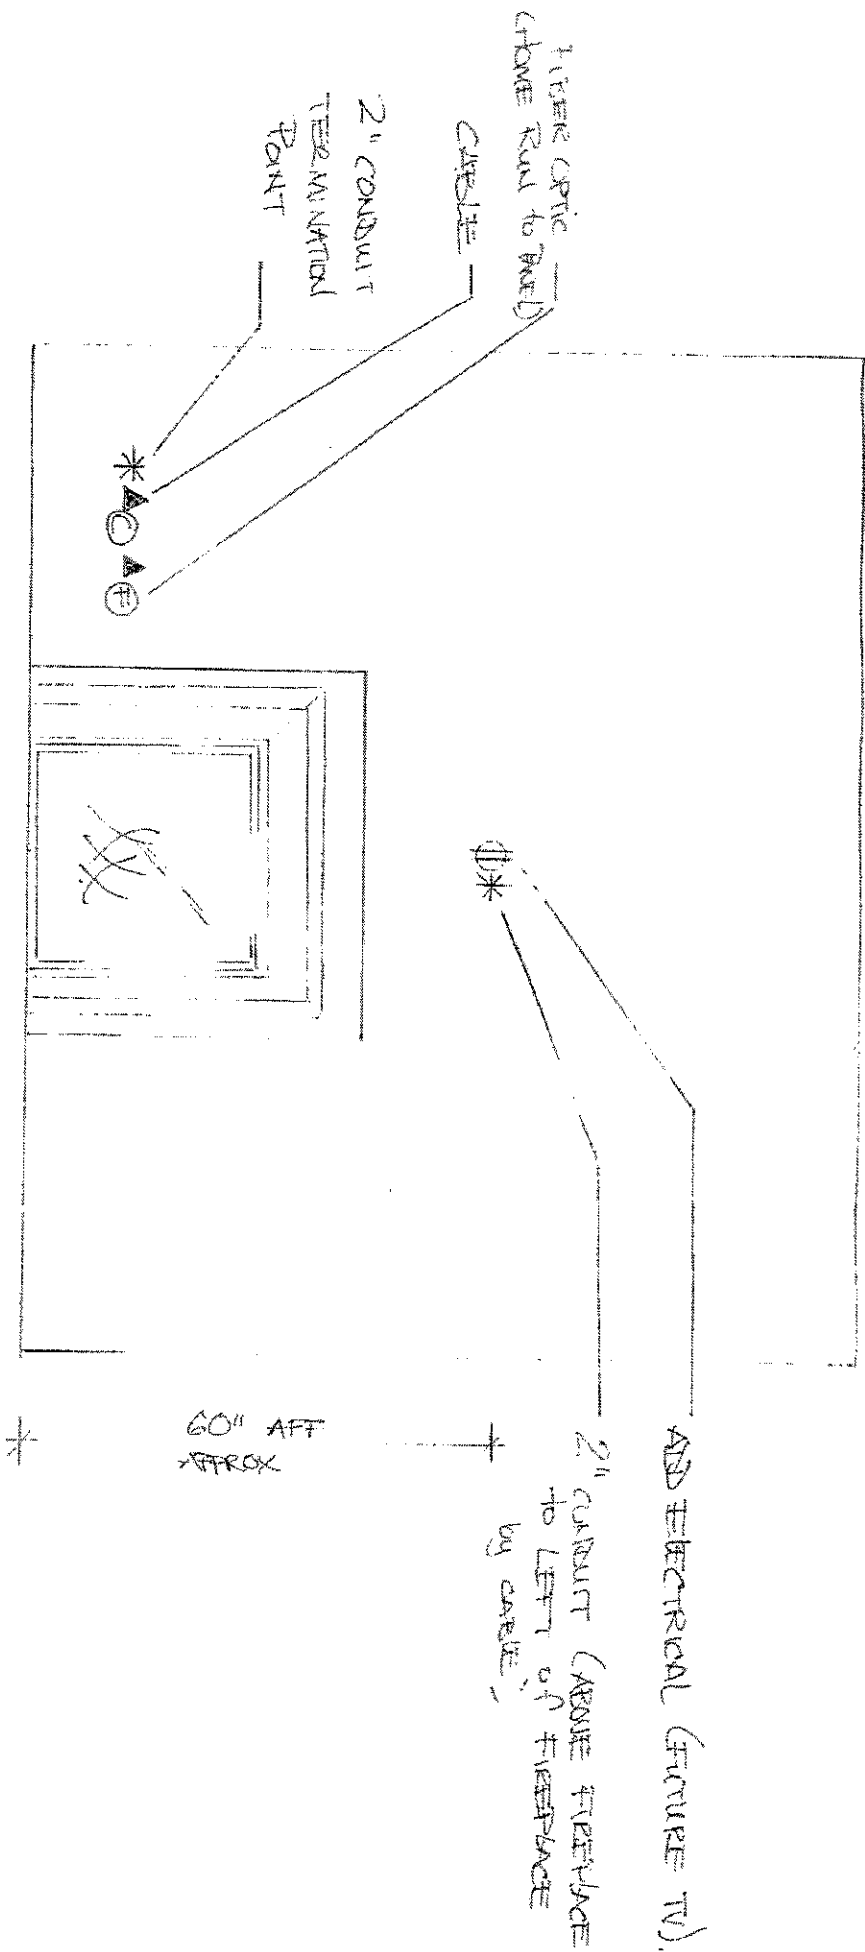

TRAVEL ROOM

LOT 15K

Aug 4 2016



Stacey Carlete
Project Coordinator



Claude Azzopardi
Contracts Manager



Nancy Martini
Corporate Controller



25.1 The Riverstone			
Elevation	Circle One	A	1812.7 Square Feet
		B	1812.7 Square Feet
Taller Ceilings	Circle All that Apply	GFTC	9' Ceilings Ground Floor
		MFTC	10' Ceilings Main Floor
		SFTC	9' Ceilings Second Floor
Optional Layouts	Circle All that Apply	GFA1	GROUND FLOOR Alternative Layout Kitchen/Family Room

25.2 The Hudson			
Elevation	Circle One	A	1860.8 Square Feet
		B	1858.6 Square Feet
Taller Ceilings	Circle All that Apply	GFTC	9' Ceilings Ground Floor
		MFTC	10' Ceilings Main Floor
		SFTC	9' Ceilings Second Floor
Optional Layouts	Circle All that Apply	GFA1	GROUND FLOOR Alternative Layout Kitchen/Family Room

25.3 The Oakmount			
Elevation	Circle One	A	2013.0 Square Feet
		B	2013.0 Square Feet
Taller Ceilings	Circle All that Apply	GFTC	9' Ceilings Ground Floor
		MFTC	10' Ceilings Main Floor
		SFTC	9' Ceilings Second Floor
Optional Layouts	Circle All that Apply	GFA1	GROUND FLOOR Alternative Layout Kitchen/Family Room
		SFA4	SECOND FLOOR Alternative Layout Laundry Room
		SFA5	SECOND FLOOR Additional Bedroom

25.4 The Stanford			
Elevation	Circle One	A	2665.6 Square Feet
		B	2665.6 Square Feet
Taller Ceilings	Circle All that Apply	GFTC	9' Ceilings Ground Floor
		MFTC	10' Ceilings Main Floor
		SFTC	9' Ceilings Second Floor
Optional Layouts	Circle All that Apply	GFA2	GROUND FLOOR Optional Piece Bathroom
		MFA1	MAIN FLOOR Alternative Layout Kitchen/Family Room
		SFA2	SECOND FLOOR Shower in Lieu of Tub (Master Ens.)
		SFA5	SECOND FLOOR Additional Bedroom

25.5 The Regency			
Elevation	Circle One	A	2924.0 Square Feet
		B	2924.0 Square Feet
Taller Ceilings	Circle All that Apply	GFTC	9' Ceilings Ground Floor
		MFTC	10' Ceilings Main Floor
		SFTC	9' Ceilings Second Floor
Optional Layouts	Circle All that Apply	GFA2	GROUND FLOOR Optional Piece Bathroom
		MFA1	MAIN FLOOR Alternative Layout Kitchen/Family Room
		SFA2	SECOND FLOOR Shower in Lieu of Tub (Master Ens.)
		SFA5	SECOND FLOOR Additional Bedroom

25.6 The Lincoln			
Elevation	Circle One	A	3021.0 Square Feet
		B	3014.0 Square Feet
Taller Ceilings	Circle All that Apply	GFTC	9' Ceilings Ground Floor
		MFTC	10' Ceilings Main Floor
		SFTC	9' Ceilings Second Floor
Optional Layouts	Circle All that Apply	GFA2	GROUND FLOOR Optional Piece Bathroom
		MFA1	MAIN FLOOR Alternative Layout Kitchen/Family Room

25.7 The Carnegie			
Elevation	Circle One	A	3150.8 Square Feet
		B	3150.8 Square Feet
Taller Ceilings	Circle All that Apply	GFTC	9' Ceilings Ground Floor
		MFTC	10' Ceilings Main Floor
		SFTC	9' Ceilings Second Floor
Optional Layouts	Circle All that Apply	GFA2	GROUND FLOOR Optional Piece Bathroom
		MFA1	MAIN FLOOR Alternative Layout Kitchen/Family Room
		SFA1	SECOND FLOOR Shower in Lieu of Tub (Bedroom 2)

25.8 The Biltmore			
Elevation	Circle One	A	1980.8 Square Feet
		B	1989.3 Square Feet
Taller Ceilings	Circle All that Apply	GFTC	9' Ceilings Ground Floor
		MFTC	10' Ceilings Main Floor
		SFTC	9' Ceilings Second Floor
Optional Layouts	Circle All that Apply		

Elevation	Circle One		
Taller Ceilings	Circle All that Apply		
Optional Layouts	Circle All that Apply		

Elevation	Circle One		
Taller Ceilings	Circle All that Apply		
Optional Layouts	Circle All that Apply		



LOT 14R
AUG. 4. 2016