

Kleinburg Glen - 21R - 1 - 25-2 Elev.B HUDSON
CENTRAL VAC AND WIRING

Inv.616	1 - MASTER BEDROOM: ROUGH - IN FOR EXTRA SECURITY KEY PAD
Line7684	Note: Left of entry door. Please see floorplan for location.
29Jun16 / 17Aug16	

ELECTRICAL

Inv.616	3 - KITCHEN: POT LIGHT: 4 INCH HALOGEN POT LIGHT - 440 WH - PRICED PER LIGHT - 10 OR MORE
Line7675	Note: Please see floor plan for location
29Jun16 / 17Aug16	

Inv.616	5 - KITCHEN CABINET VALANCE LIGHTS (UNDER CABINETS) - EACH PUCK LIGHT - DOES NOT INCLUDE (AND REQUIRES) KITCHEN UPGRADE PRICING
Line7681	Note:
29Jun16 / 17Aug16	

Inv.616	1 - KITCHEN POT LIGHTS: ON A SEPARATE SWITCH
Line7676	Note:
29Jun16 / 17Aug16	

Inv.616	1 - KITCHEN: RELOCATE STANDARD KITCHEN CEILING LIGHT TO OVER ISLAND IN LINE WITH ADDITIONAL CEILING OUTLET.
Line7678	Note: Both Over island ceiling caps to be on same switch
29Jun16 / 17Aug16	

Inv.616	1 - KITCHEN: ROUGH - ADD CEILING OUTLET & SWITCH (WITH COVER PLATE) - DOES NOT INCLUDE FIXTURE.
Line7679	Note: Please see floor plan for location
29Jun16 / 17Aug16	

Inv.616	1 - KITCHEN: Please install standard island plug facing dishwasher. Please see floorplan for location
Line7680	Note:
29Jun16 / 17Aug16	

Inv.616	1 - KITCHEN: UNDERCABINET PUCK LIGHTS ON A SEPARATE SWITCH.
Line7682	Note: Switch to be on backsplash, left of fridge. Please see floor plan for switch location
29Jun16 / 17Aug16	

Inv.616	1 - KITCHEN: BREAKFAST CEILING LIGHT ON A SEPARATE SWITCH
Line7683	Note:
29Jun16 / 17Aug16	

Inv.616	6 - FAMILY ROOM: POT LIGHT: 4 INCH HALOGEN POT LIGHT - 440 WH - PRICED PER LIGHT - 10 OR MORE
Line7685	Note: Please see floorplan for location.
29Jun16 / 17Aug16	

Inv.616	6 - LIVING ROOM / DINING ROOM: POT LIGHT: 4 INCH HALOGEN POT LIGHT - 440 WH - PRICED PER LIGHT - 10 OR MORE
Line7686	Note: Please see floorplan for location
29Jun16 / 17Aug16	

Inv.616	1 - POWDER ROOM: POT LIGHT: 4 INCH HALOGEN POT LIGHT - 440 WH
Line7687	Note: On same switch as vanity light
29Jun16 / 17Aug16	

Inv.616	3 - HALLWAY: POT LIGHT: 4 INCH HALOGEN POT LIGHT - 440 WH - PRICED PER LIGHT - 10 OR MORE
Line7688	Note: Please see floorplan for location
29Jun16 / 17Aug16	

Kleinburg Glen - 21R - 1 - 25-2 Elev.B HUDSON


Inv.616	1 - FAMILY ROOM: ALL 6 POTLIGHTS ON THE SAME SWITCH
Line7689	Note:
29Jun16 / 17Aug16	
Inv.616	1 - LIVING ROOM / DINING ROOM: ALL 6 POTLIGHTS ON THE SAME SWITCH
Line7690	Note:
29Jun16 / 17Aug16	
Inv.616	1 - LIVING / DINING ROOM: PLEASE CENTRE CEILING FIXTURE
Line7691	Note:
29Jun16 / 17Aug16	
Inv.616	1 - HALLWAY: 3 POTLIGHTS ON SAME SWITCH
Line7692	Note: Please see floorplan for location
29Jun16 / 17Aug16	

EXTERIOR COLOURS

Inv.616	1 - EXTERIOR COLOUR PACKAGE 10
Line10248	Note:
29Jun16 / 17Aug16	

MISC.

Inv.616	1 - Purchaser has attended a Structural appointment at the Decor Centre & has DECLINED any additional upgrades and accepts and acknowledges that there will be no further structural changes/additions/deletions to be made upon signing on June 29, 2016.
Line7693	Note:
29Jun16 / 17Aug16	
Inv.616	1 - Purchasers are aware & accepts that ANY changes made to upgrades after signing this Purchasers Extra Form are subject to a minimum administration fee of \$500. PLUS a 10% holdback fee.
Line7694	Note:
29Jun16 / 17Aug16	
Inv.616	1 - BONUS PACKAGE: \$5000.00 (INCLUDING TAXES) WORTH OF UPGRADES FROM GOLD PARK HOMES DÉCOR CENTRE IS BEING APPLIED TOWARD THE STRUCTURAL APPOINTMENT. PURCHASER HAS A REMAINING AMOUNT OF \$00 (INCLUDING TAXES) TO BE USED TOWARD THE COLOUR APPOINTMENT.
Line7695	Note:
29Jun16 / 17Aug16	
Inv.616	1 - CHEQUE PAID \$2480.60
Line7696	Note:
29Jun16 / 17Aug16	

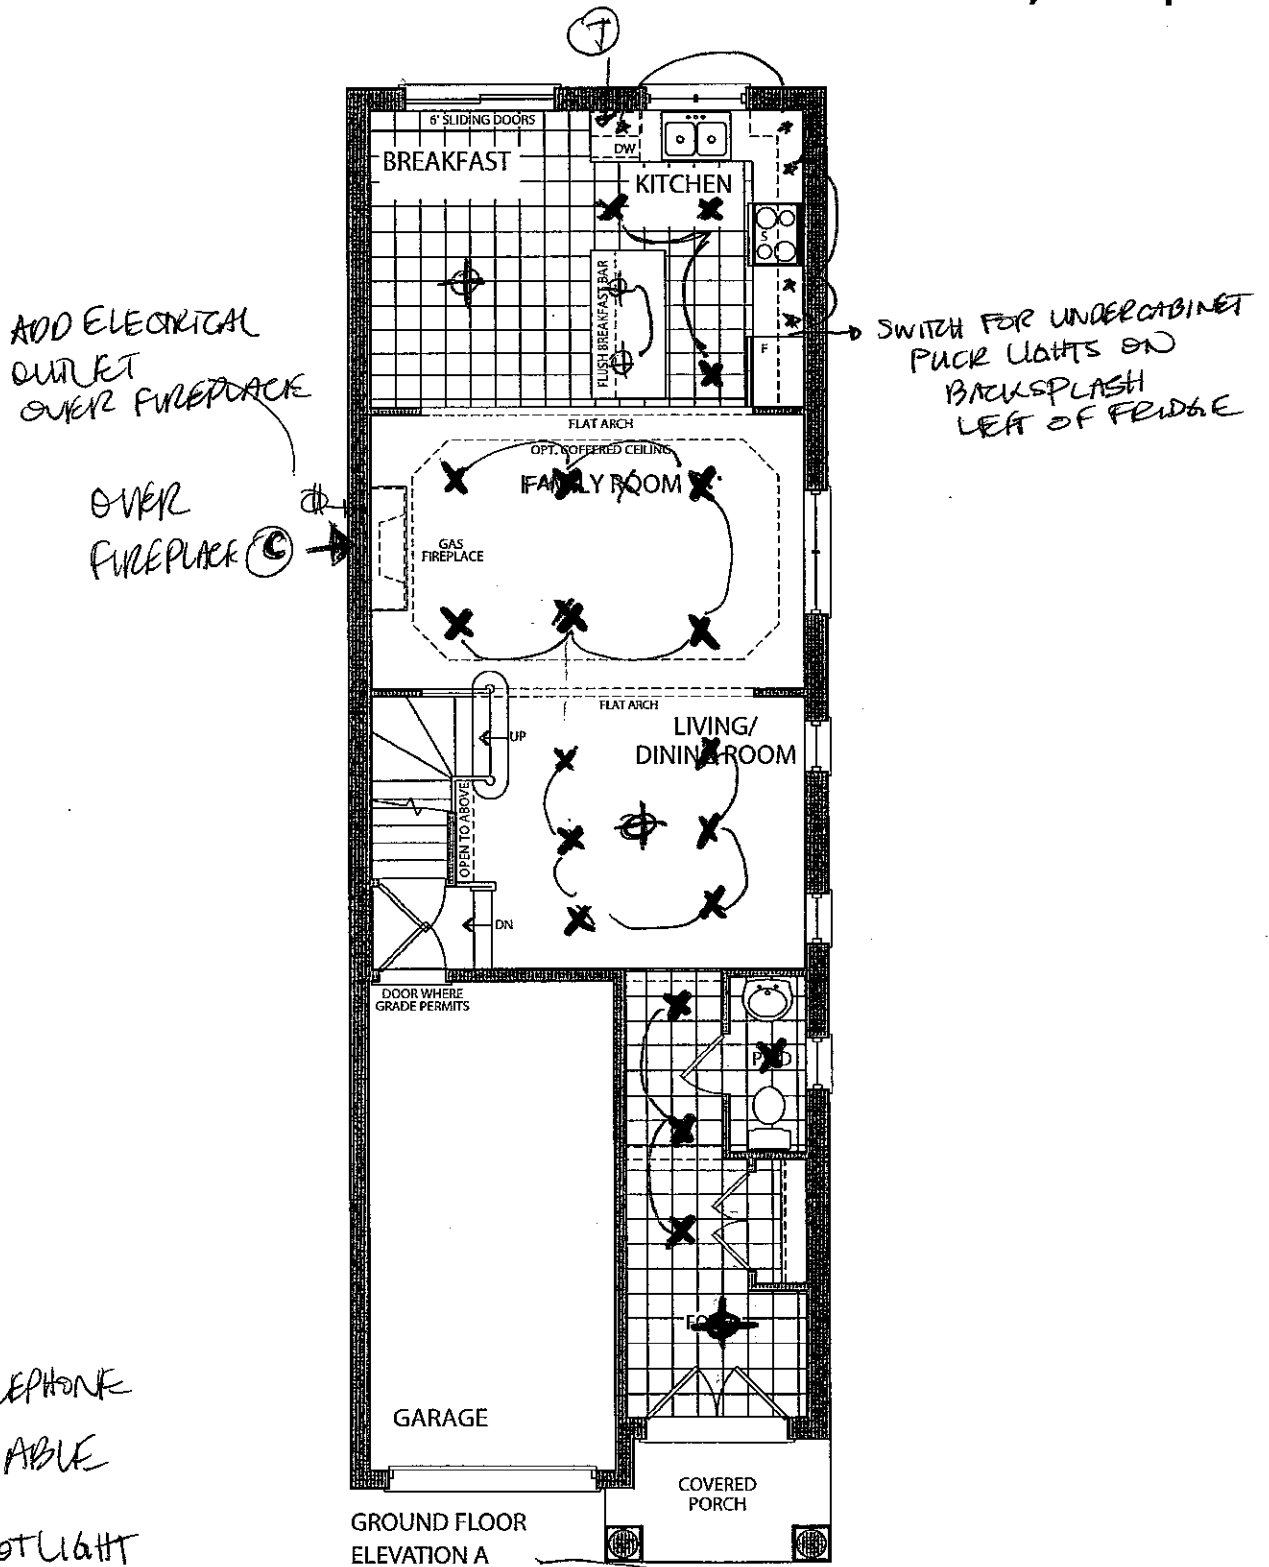


① - TELEPHONE

Ⓢ - CABLE

X - POTLIGHT



⊕ - CEILING FAN

* - PUCK LIGHTS (UNDER CABINET)


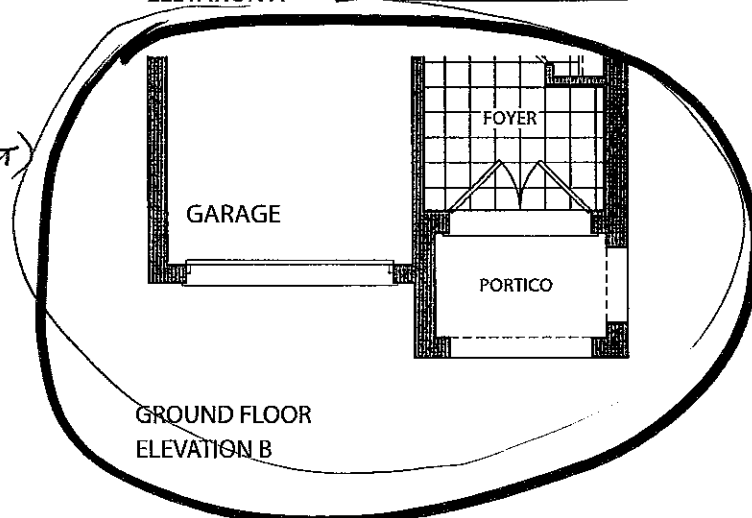


Lot 21R

X
X
JUNE 29, 2016

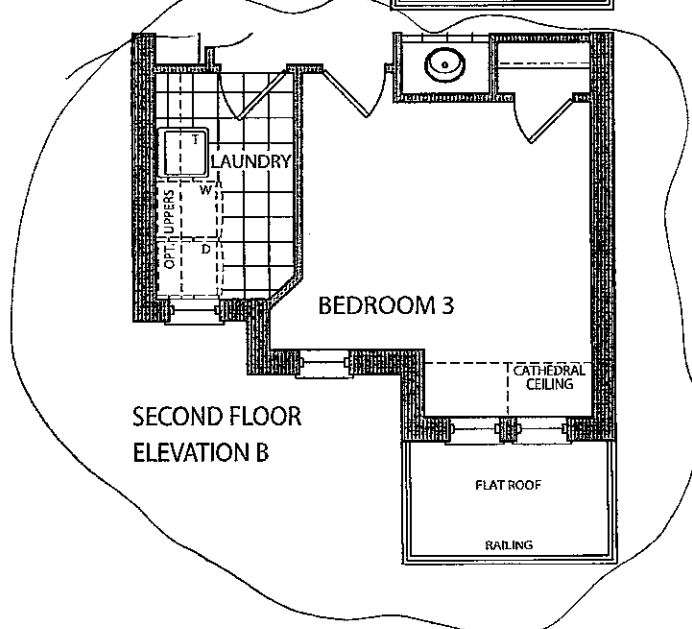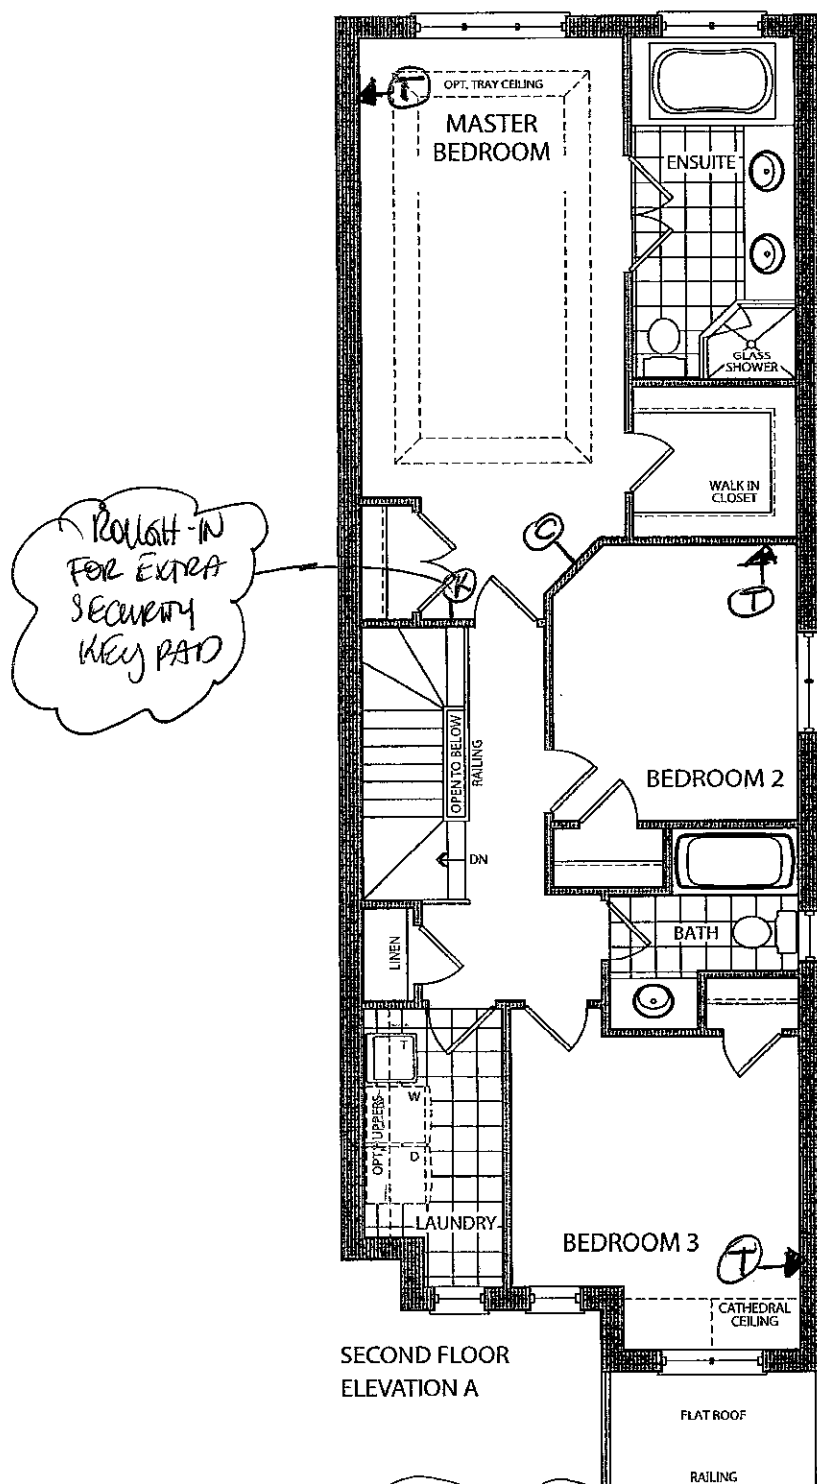

LOT 212
X
X
JUNE 29, 2016

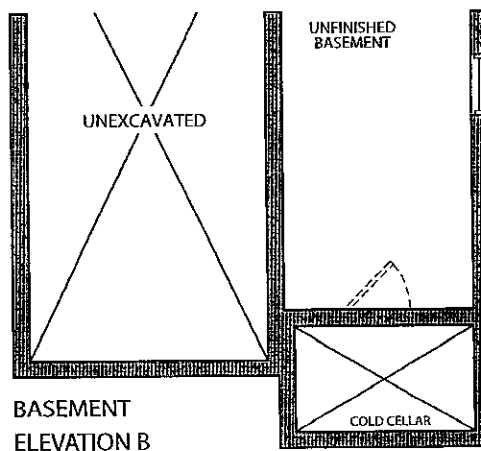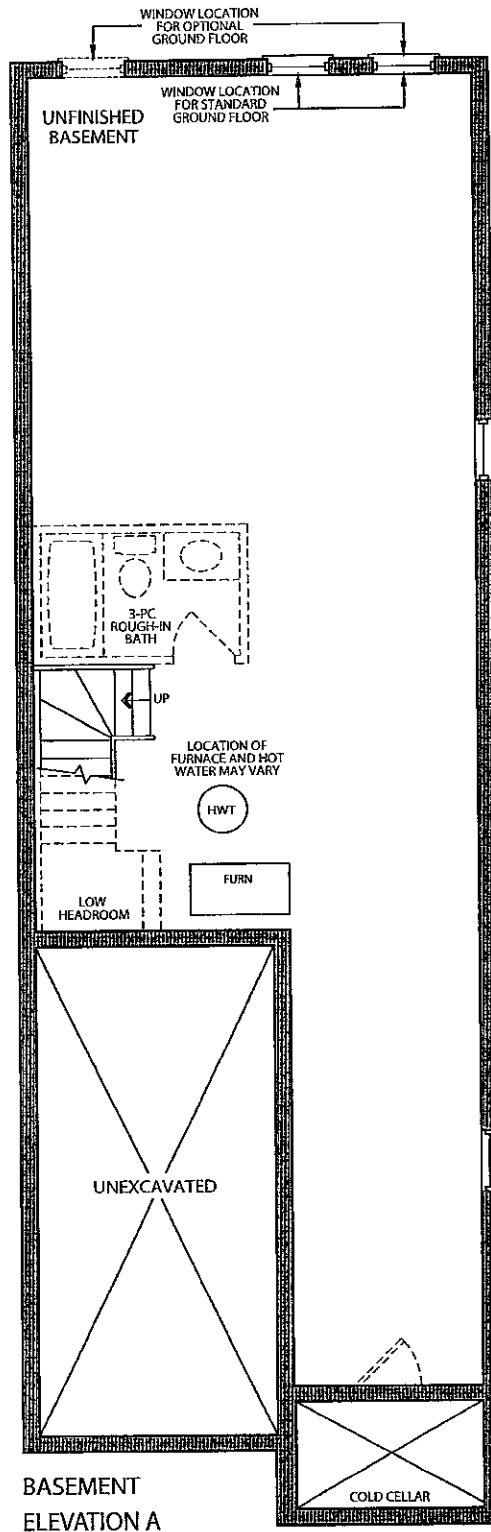

LOT 21R

X Payroll
X JUNE 29, 2016



Stacey Carlete
Project Coordinator



Claude Azzopardi
Contracts Manager



Nancy Martini
Corporate Controller



25.1 The Riverstone			
Elevation	Circle One	A	1812.7 Square Feet
		B	1812.7 Square Feet
Taller Ceilings	Circle All that Apply	GFTC	9' Ceilings Ground Floor
		MFTC	10' Ceilings Main Floor
		SFTC	9' Ceilings Second Floor
Optional Layouts	Circle All that Apply	GFA1	GROUND FLOOR Alternative Layout Kitchen/Family Room

25.2 The Hudson			
Elevation	Circle One	A	1860.8 Square Feet
		B	1860.8 Square Feet
Taller Ceilings	Circle All that Apply	GFTC	9' Ceilings Ground Floor
		MFTC	10' Ceilings Main Floor
		SFTC	9' Ceilings Second Floor
Optional Layouts	Circle All that Apply	GFA1	GROUND FLOOR Alternative Layout Kitchen/Family Room

25.3 The Oakmount			
Elevation	Circle One	A	2013.0 Square Feet
		B	2013.0 Square Feet
Taller Ceilings	Circle All that Apply	GFTC	9' Ceilings Ground Floor
		MFTC	10' Ceilings Main Floor
		SFTC	9' Ceilings Second Floor
Optional Layouts	Circle All that Apply	GFA1	GROUND FLOOR Alternative Layout Kitchen/Family Room
		SFA4	SECOND FLOOR Alternative Layout Laundry Room
		SFA5	SECOND FLOOR Additional Bedroom

25.4 The Stanford			
Elevation	Circle One	A	2665.6 Square Feet
		B	2665.6 Square Feet
Taller Ceilings	Circle All that Apply	GFTC	9' Ceilings Ground Floor
		MFTC	10' Ceilings Main Floor
		SFTC	9' Ceilings Second Floor
Optional Layouts	Circle All that Apply	GFA2	GROUND FLOOR Optional Piece Bathroom
		MFA1	MAIN FLOOR Alternative Layout Kitchen/Family Room
		SFA2	SECOND FLOOR Shower in Lieu of Tub (Master Ens.)
		SFA5	SECOND FLOOR Additional Bedroom

25.5 The Regency			
Elevation	Circle One	A	2924.0 Square Feet
		B	2924.0 Square Feet
Taller Ceilings	Circle All that Apply	GFTC	9' Ceilings Ground Floor
		MFTC	10' Ceilings Main Floor
		SFTC	9' Ceilings Second Floor
Optional Layouts	Circle All that Apply	GFA2	GROUND FLOOR Optional Piece Bathroom
		MFA1	MAIN FLOOR Alternative Layout Kitchen/Family Room
		SFA2	SECOND FLOOR Shower in Lieu of Tub (Master Ens.)
		SFA5	SECOND FLOOR Additional Bedroom

25.6 The Lincoln			
Elevation	Circle One	A	3021.0 Square Feet
		B	3014.0 Square Feet
Taller Ceilings	Circle All that Apply	GFTC	9' Ceilings Ground Floor
		MFTC	10' Ceilings Main Floor
		SFTC	9' Ceilings Second Floor
Optional Layouts	Circle All that Apply	GFA2	GROUND FLOOR Optional Piece Bathroom
		MFA1	MAIN FLOOR Alternative Layout Kitchen/Family Room

25.7 The Carnegie			
Elevation	Circle One	A	3150.8 Square Feet
		B	3150.8 Square Feet
Taller Ceilings	Circle All that Apply	GFTC	9' Ceilings Ground Floor
		MFTC	10' Ceilings Main Floor
		SFTC	9' Ceilings Second Floor
Optional Layouts	Circle All that Apply	GFA2	GROUND FLOOR Optional Piece Bathroom
		MFA1	MAIN FLOOR Alternative Layout Kitchen/Family Room
		SFA1	SECOND FLOOR Shower in Lieu of Tub (Bedroom 2)

25.8 The Biltmore			
Elevation	Circle One	A	1980.8 Square Feet
		B	1989.3 Square Feet
Taller Ceilings	Circle All that Apply	GFTC	9' Ceilings Ground Floor
		MFTC	10' Ceilings Main Floor
		SFTC	9' Ceilings Second Floor
Optional Layouts	Circle All that Apply		

Elevation	Circle One		
Taller Ceilings	Circle All that Apply		
Optional Layouts	Circle All that Apply		

Elevation	Circle One		
Taller Ceilings	Circle All that Apply		
Optional Layouts	Circle All that Apply		

X

X

JUNE 29, 2016