

Kleinburg Glen - 22R - 1 - 25-3 Elev.B OAKMOUNT

ELECTRICAL

Inv.615	1 - FAMILY ROOM: 110V WALL RECEPTACLE ON NORMAL CIRCUIT - LOCATED ABOVE FIREPLACE, BESIDE STD CABLE LOCATION.
Line7648	Note: Please see floor plan for location
29Jun16 / 17Aug16	

EXTERIOR COLOURS

Inv.762	1 - EXTERIOR COLOUR PACKAGE 3
Line10260	Note:
17Aug16 / 17Aug16	

FRAMING

Inv.615	1 - MAIN FLOOR CEILING 10FT
Line7646	Note:
29Jun16 / 17Aug16	
Inv.615	1 - SECOND FLOOR: RELOCATE MASTER BEDROOM AND WALK IN CLOSET DOORS, DELETE CLOSET IN BEDROOM 2, RELOCATE LAUNDRY TO BASEMENT - CONVERT LAUNDRY TO DOUBLE DOOR CLOSET FOR BEDROOM 2. PLEASE SEE FLOORPLAN FOR DETAILS.
Line7647	Note:
29Jun16 / 17Aug16	

HVAC

Inv.615	1 - BEDROOM 2: ADD RG6 CABLE. PLEASE SEE FLOOR PLAN FOR LOCATION
Line7649	Note: Please see floor plan for location
29Jun16 / 17Aug16	
Inv.615	1 - BASEMENT - LAUNDRY: RELOCATE LAUNDRY TO BASEMENT. PLEASE SEE FLOOR PLAN FOR LOCATION
Line10259	Note:
29Jun16 / 17Aug16	

MISC.

Inv.615	1 - Purchaser has attended a Structural appointment at the Decor Centre & has DECLINED any additional upgrades and accepts and acknowledges that there will be no further structural changes/additions/deletions to be made upon signing on July 19, 2016
Line7651	Note:
29Jun16 / 17Aug16	
Inv.615	1 - Purchasers are aware & accepts that ANY changes made to upgrades after signing this Purchasers Extra Form are subject to a minimum administration fee of \$500. PLUS a 10% holdback fee.
Line7652	Note:
29Jun16 / 17Aug16	
Inv.615	1 - BONUS PACKAGE: \$5000.00 (INCLUDING TAXES) WORTH OF UPGRADES FROM GOLD PARK HOMES DÉCOR CENTRE IS BEING APPLIED TOWARD THE STRUCTURAL APPOINTMENT. PURCHASER HAS A REMAINING AMOUNT OF \$00 (INCLUDING TAXES) TO BE USED TOWARD THE COLOUR APPOINTMENT.
Line7653	Note:
29Jun16 / 17Aug16	
Inv.615	1 - BALANCE AFTER CREDIT: \$23,803.70 50% DEPOSIT PAID BY CHEQUE: \$11,901.85 50% BALANCE ON CLOSING: \$11,901.85
Line8862	Note:
29Jun16 / 17Aug16	

PLUMBING


Kleinburg Glen - 22R - 1 - 25-3 Elev.B OAKMOUNT

Inv.615	1 - BASEMENT - LAUNDRY: RELOCATE LAUNDRY TO BASEMENT. PLEASE SEE FLOOR PLAN FOR LOCATION
Line7642	Note:
29Jun16 / 17Aug16	
Inv.615	1 - MASTER ENSUITE: RELOCATE TOILET TO WINDOW SIDE - IN LINE WITH VANITY. PLEASE SEE FLOORPLAN FOR LOCATION
Line7650	Note:
29Jun16 / 17Aug16	

WINDOWS - BASEMENT


Inv.615	2 - BASEMENT WINDOWS - UPGRADE EXISTING BASEMENT WINDOW TO 46 INCH X 32 INCH - MAY REQUIRE INSTALLATION OF WINDOW WELL
Line7643	Note: Please see floor plan for location
29Jun16 / 17Aug16	
Inv.615	1 - BASEMENT WINDOWS - UPGRADE EXISTING BASEMENT WINDOW TO 53 INCH X 16 INCH - MAY REQUIRE INSTALLATION OF WINDOW WELL
Line7644	Note: Please see floor plan for location
29Jun16 / 17Aug16	
Inv.615	3 - COLOUR MATCH 3 UPGRADED WINDOWS TO OTHER WINDOWS
Line7645	Note:
29Jun16 / 17Aug16	

Elevation A • 2,053 sq.ft.
Elevation B • 2,053 sq.ft.

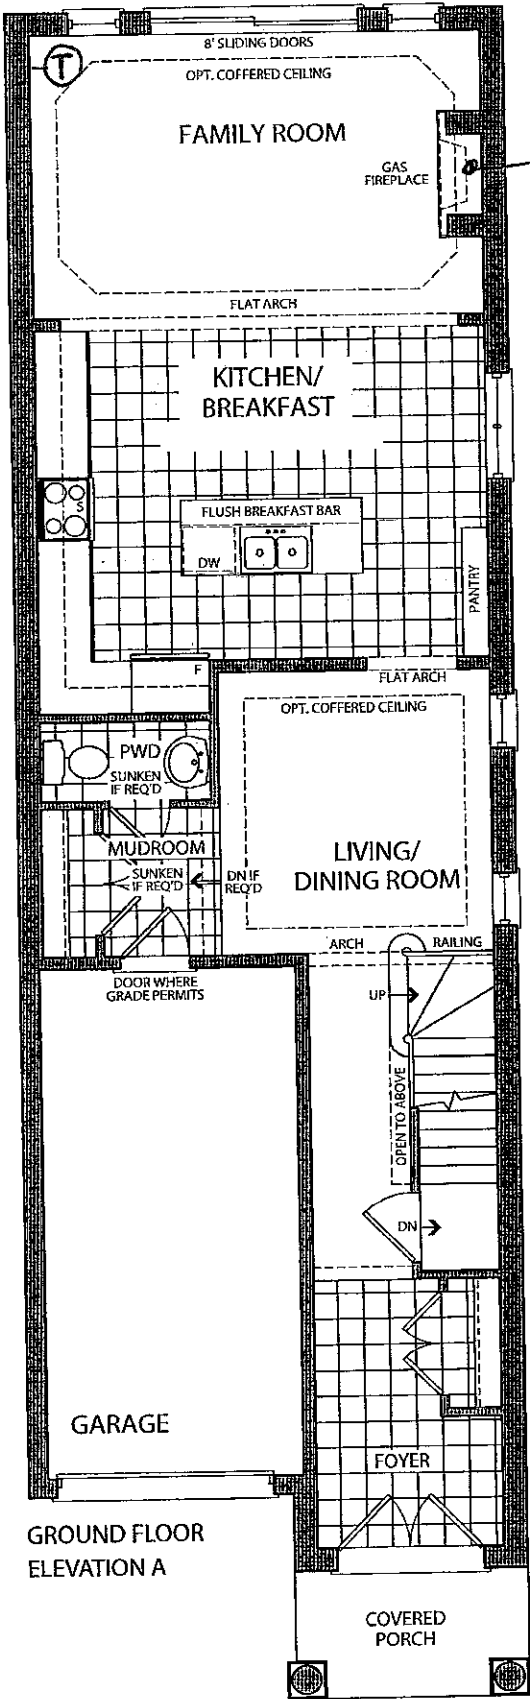

Ⓢ CABLE ABOVE FIREPLACE
Ⓢ 110V PLUG ABOVE FIREPLACE
APPROX 66" AFF

GROUND FLOOR
ELEVATION A

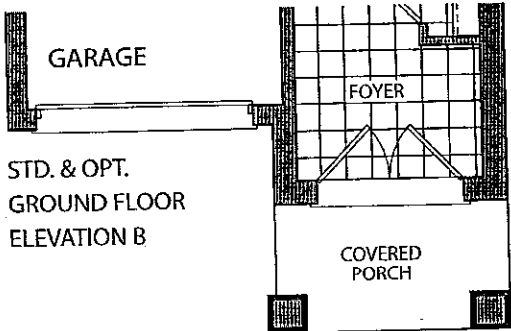


STD. & OPT.
GROUND FLOOR
ELEVATION B


- Ⓢ TELEPHONE
- Ⓢ CABLE
- Ⓢ - 110V RECEPTACLE

LOT 22R
R.T.
JULY 19, 2016

Elevation A • 2,053 sq.ft.

Elevation B • 2,053 sq.ft.

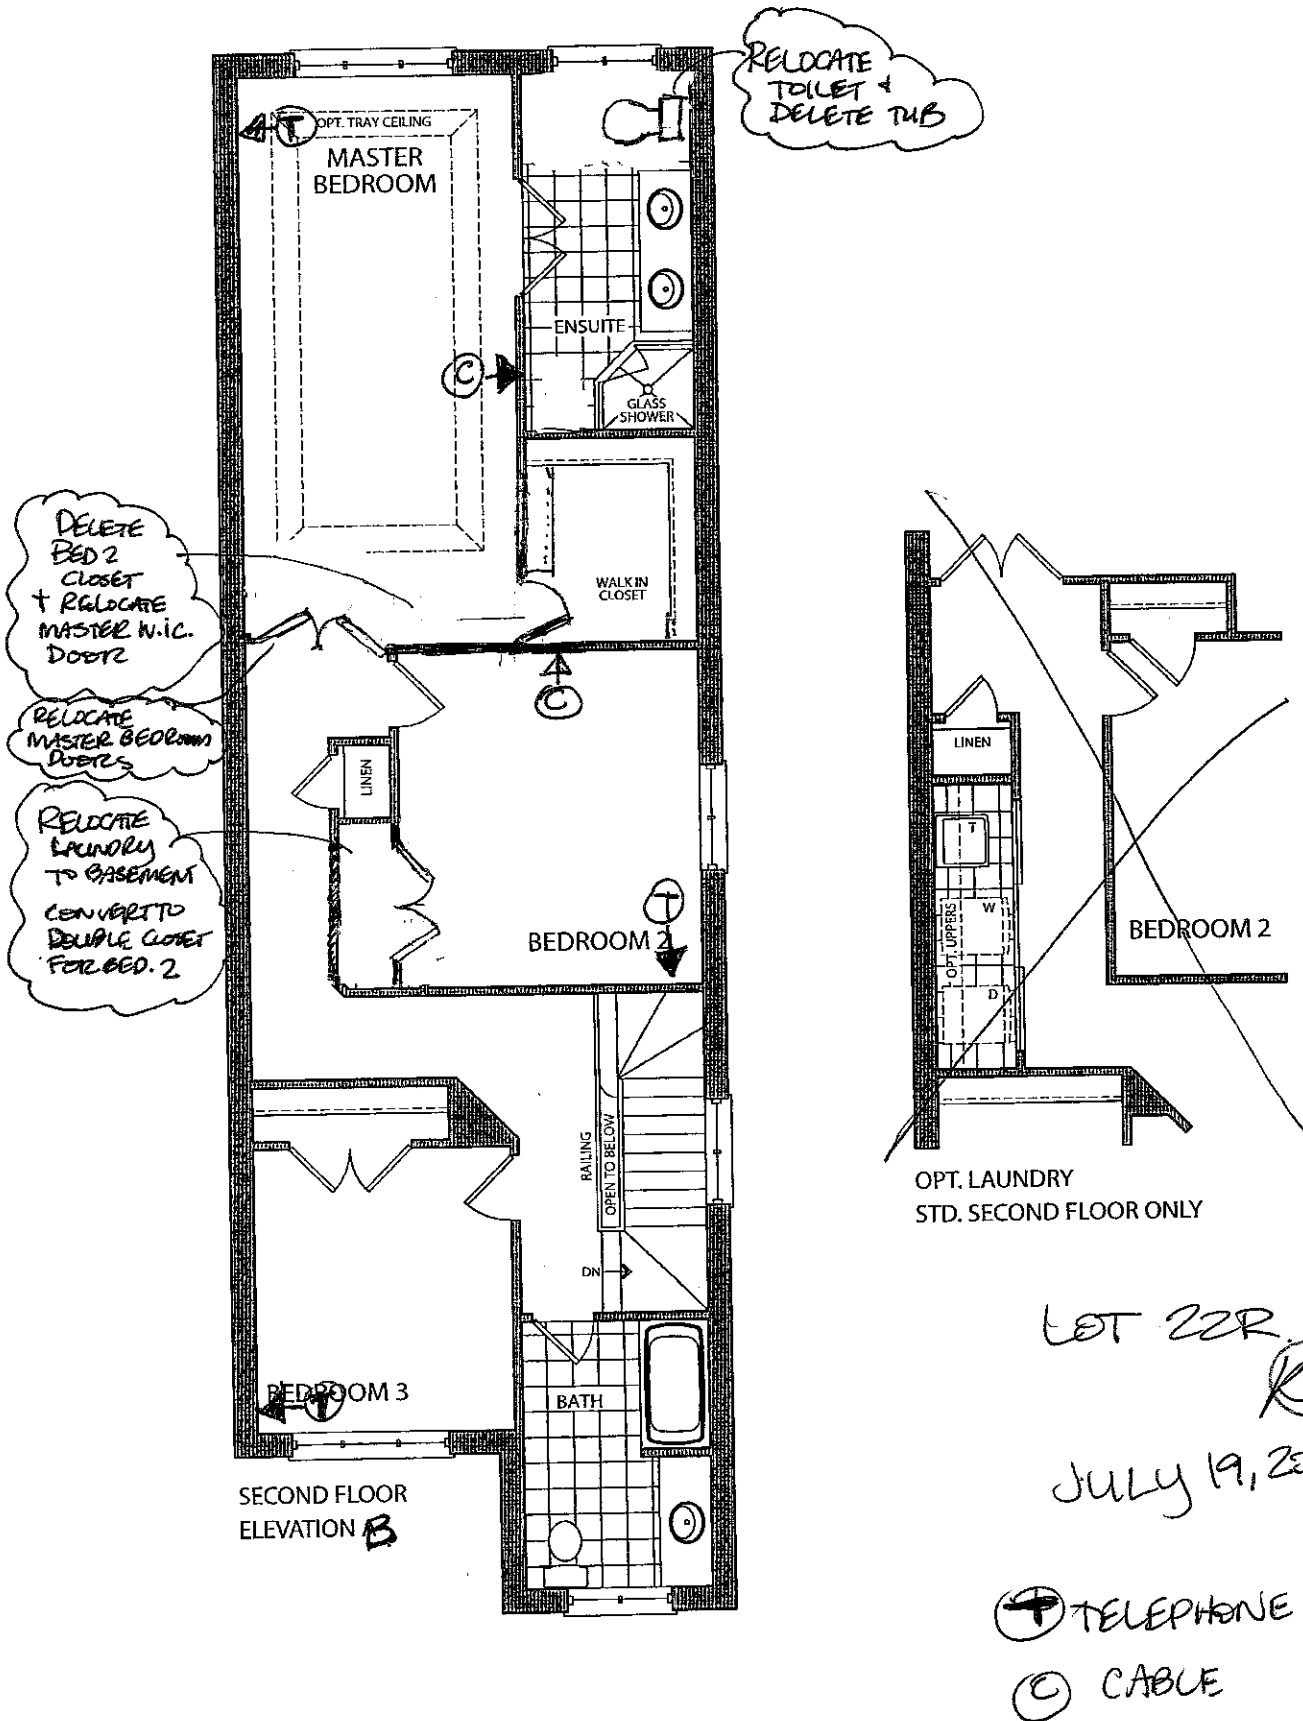

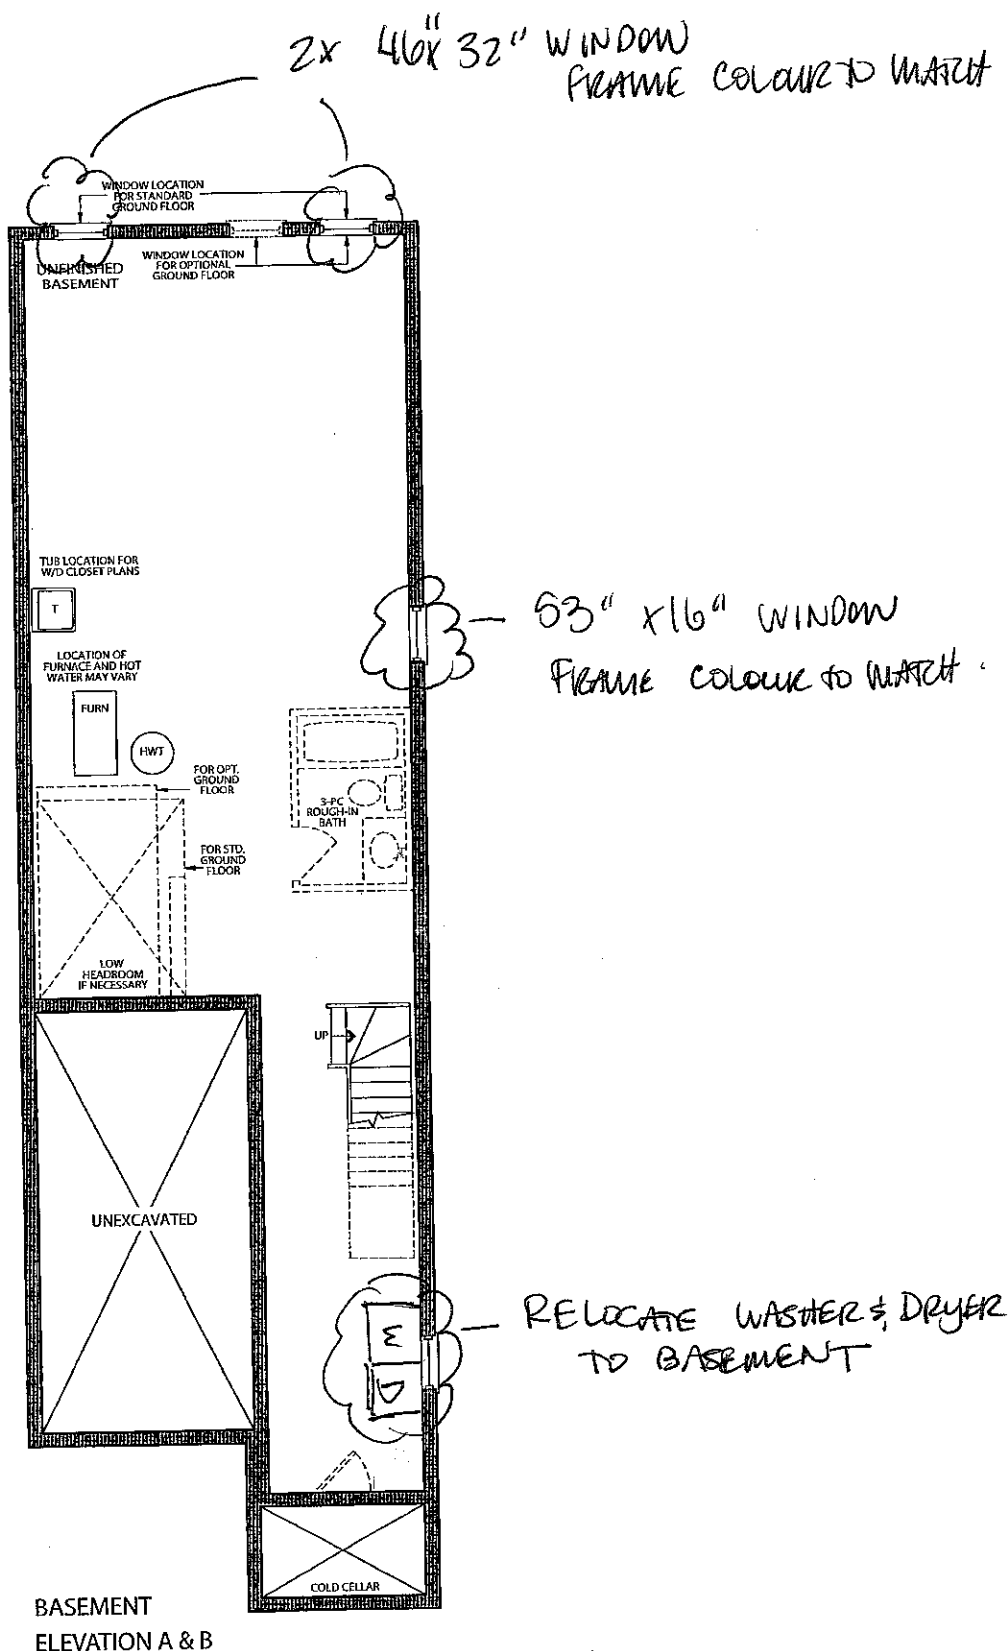

LOT 22R
R.T.
July 19, 2016



Stacey Carlete
Project Coordinator



Claude Azzopardi
Contracts Manager



Nancy Martini
Corporate Controller



25.1 The Riverstone			
Elevation	Circle One	A	1812.7 Square Feet
		B	1812.7 Square Feet
Taller Ceilings	Circle All that Apply	GFTC	9' Ceilings Ground Floor
		MFTC	10' Ceilings Main Floor
		SFTC	9' Ceilings Second Floor
Optional Layouts	Circle All that Apply	GFA1	GROUND FLOOR Alternative Layout Kitchen/Family Room

25.2 The Hudson			
Elevation	Circle One	A	1860.8 Square Feet
		B	1858.6 Square Feet
Taller Ceilings	Circle All that Apply	GFTC	9' Ceilings Ground Floor
		MFTC	10' Ceilings Main Floor
		SFTC	9' Ceilings Second Floor
Optional Layouts	Circle All that Apply	GFA1	GROUND FLOOR Alternative Layout Kitchen/Family Room

25.3 The Oakmount			
Elevation	Circle One	A	2013.0 Square Feet
		B	2013.0 Square Feet
Taller Ceilings	Circle All that Apply	GFTC	9' Ceilings Ground Floor
		MFTC	10' Ceilings Main Floor
		SFTC	9' Ceilings Second Floor
Optional Layouts	Circle All that Apply	GFA1	GROUND FLOOR Alternative Layout Kitchen/Family Room
		SFA4	SECOND FLOOR Alternative Layout Laundry Room
		SFA5	SECOND FLOOR Additional Bedroom

25.4 The Stanford			
Elevation	Circle One	A	2665.6 Square Feet
		B	2665.6 Square Feet
Taller Ceilings	Circle All that Apply	GFTC	9' Ceilings Ground Floor
		MFTC	10' Ceilings Main Floor
		SFTC	9' Ceilings Second Floor
Optional Layouts	Circle All that Apply	GFA2	GROUND FLOOR Optional Piece Bathroom
		MFA1	MAIN FLOOR Alternative Layout Kitchen/Family Room
		SFA2	SECOND FLOOR Shower in Lieu of Tub (Master Ens.)
		SFA5	SECOND FLOOR Additional Bedroom

25.5 The Regency			
Elevation	Circle One	A	2924.0 Square Feet
		B	2924.0 Square Feet
Taller Ceilings	Circle All that Apply	GFTC	9' Ceilings Ground Floor
		MFTC	10' Ceilings Main Floor
		SFTC	9' Ceilings Second Floor
Optional Layouts	Circle All that Apply	GFA2	GROUND FLOOR Optional Piece Bathroom
		MFA1	MAIN FLOOR Alternative Layout Kitchen/Family Room
		SFA2	SECOND FLOOR Shower in Lieu of Tub (Master Ens.)
		SFA5	SECOND FLOOR Additional Bedroom

25.6 The Lincoln			
Elevation	Circle One	A	3021.0 Square Feet
		B	3014.0 Square Feet
Taller Ceilings	Circle All that Apply	GFTC	9' Ceilings Ground Floor
		MFTC	10' Ceilings Main Floor
		SFTC	9' Ceilings Second Floor
Optional Layouts	Circle All that Apply	GFA2	GROUND FLOOR Optional Piece Bathroom
		MFA1	MAIN FLOOR Alternative Layout Kitchen/Family Room

25.7 The Carnegie			
Elevation	Circle One	A	3150.8 Square Feet
		B	3150.8 Square Feet
Taller Ceilings	Circle All that Apply	GFTC	9' Ceilings Ground Floor
		MFTC	10' Ceilings Main Floor
		SFTC	9' Ceilings Second Floor
Optional Layouts	Circle All that Apply	GFA2	GROUND FLOOR Optional Piece Bathroom
		MFA1	MAIN FLOOR Alternative Layout Kitchen/Family Room
		SFA1	SECOND FLOOR Shower in Lieu of Tub (Bedroom 2)

25.8 The Biltmore			
Elevation	Circle One	A	1980.8 Square Feet
		B	1989.3 Square Feet
Taller Ceilings	Circle All that Apply	GFTC	9' Ceilings Ground Floor
		MFTC	10' Ceilings Main Floor
		SFTC	9' Ceilings Second Floor
Optional Layouts	Circle All that Apply		

Elevation	Circle One		
Taller Ceilings	Circle All that Apply		
Optional Layouts	Circle All that Apply		

Elevation	Circle One		
Taller Ceilings	Circle All that Apply		
Optional Layouts	Circle All that Apply		

LOT 22R
R.T.
JULY 19, 2016