

**Kleinburg Glen - 24R - 1 - 25-3 Elev.B OAKMOUNT OPT- GFA1 AND SFA4
CENTRAL VAC AND WIRING**

Inv.620	1 - GARAGE ENTRANCE: ROUGH - IN FOR EXTRA SECURITY KEY PAD
Line7763	Note:
4Jul16 / 17Aug16	
Inv.620	1 - KITCHEN: CAT 5 WIRING - ADD EXTRA OUTLET Locate above dishwasher in backsplash. See plan for location.
Line8168	Note:
4Jul16 / 17Aug16	

DRYWALL

Inv.620	1 - SMOOTH CEILINGS - (2 - Story Design) 2ND FLOOR
Line7784	Note:
4Jul16 / 17Aug16	

ELECTRICAL

Inv.620	1 - KITCHEN: RELOCATE STANDARD FIXTURE to above island, see plan for location.
Line7765	Note:
4Jul16 / 17Aug16	
Inv.620	1 - KITCHEN: POT LIGHT: 4 INCH HALOGEN POT LIGHT - 440 WH - PRICED PER LIGHT - 10 OR MORE - 6 potlights including 1 switch. See plan for location.
Line7767	Note:
4Jul16 / 17Aug16	
Inv.620	1 - KITCHEN: POT LIGHT: 4 INCH HALOGEN POT LIGHT - 440 WH - PRICED PER LIGHT - 10 OR MORE - Install 1 potlight above sink, complete with its own switch. See plan for location.
Line7768	Note:
4Jul16 / 17Aug16	
Inv.620	4 - BREAKFAST: POT LIGHT: 4 INCH HALOGEN POT LIGHT - 440 WH - PRICED PER LIGHT - 10 OR MORE - Install 4 potlights in breakfast room.
Line7769	Note:
4Jul16 / 17Aug16	
Inv.620	1 - BREAKFAST: ADD A 3 - WAY SWITCH (2 SWITCHES) - for potlights, see plan for location.
Line7770	Note:
4Jul16 / 17Aug16	
Inv.620	1 - KITCHEN CABINET STRIP VALANCE LIGHTS (UNDER CABINETS) - ROUGH - IN - DOES NOT INCLUDE (AND REQUIRES) KITCHEN UPGRADE PRICING
Line7771	Note:
4Jul16 / 17Aug16	
Inv.620	1 - GREAT ROOM: Install a 110V WALL RECEPTACLE ON NORMAL CIRCUIT - Locate approx. 66" A.F.F. above fireplace.
Line7772	Note:
4Jul16 / 17Aug16	
Inv.620	4 - GREAT ROOM: POT LIGHT: 4 INCH HALOGEN POT LIGHT - 440 WH - PRICED PER LIGHT - 10 OR MORE - Install 4 potlights complete with single pole switch. See plan for location. (interior of room)
Line7773	Note:
4Jul16 / 17Aug16	
Inv.620	1 - GREAT ROOM: POT LIGHT: 4 INCH HALOGEN POT LIGHT - 440 WH - PRICED PER LIGHT - 10 OR MORE - Install 6 potlights complete with 3-way switch. See plan for location. (exterior of room)
Line7774	Note:
4Jul16 / 17Aug16	

Kleinburg Glen - 24R - 1 - 25-3 Elev.B OAKMOUNT OPT- GFA1 AND SFA4

Inv.620	4 - FOYER: POT LIGHT: 4 INCH HALOGEN POT LIGHT - 440 WH - PRICED PER LIGHT - 10 OR MORE *DELETE STANDARD CEILING FIXTURE, INSTALL 4POTLIGHTS USING STANDARD SWITCH for foyer potlights + hall potlights See plan for location.
Line7779	Note:
4Jul16 / 17Aug16	
Inv.620	3 - MAIN HALL: POT LIGHT: 4 INCH HALOGEN POT LIGHT - 440 WH - PRICED PER LIGHT - 10 OR MORE *DELETE STANDARD CEILING LIGHT, INSTALL 3 POTLIGHTS USING STANDARD SWITCH* See plan for location.
Line7780	Note:
4Jul16 / 17Aug16	
Inv.620	1 - FRONT EXTERIOR: *IF POSSIBLE* MOVE STANDARD COACH LIGHT TO CENTERED *ABOVE* GARAGE DOOR
Line8169	Note:
4Jul16 / 17Aug16	
Inv.620	1 - KITCHEN: RELOCATE STANDARD FIXTURE from main hall TO above island, see plan (use standard switch) - 2 lights on 1 switch
Line8165	Note:
4Jul16 / 17Aug16	

EXTERIOR COLOURS

Inv.620	1 - EXTERIOR COLOUR PACKAGE 3
Line10264	Note:
4Jul16 / 17Aug16	

FRAMING

Inv.620	1 - MASTER ENSUITE: SHOWER STALL SHAMPOO SHELF
Line7786	Note:
4Jul16 / 17Aug16	
Inv.620	9 - FRAME MAIN FLOOR DOORS & ARCHWAYS AT 96 INCH - ADDED WITH THE ADDITION OF TALLER INTERIOR DOORS (4 archways + 5 doorways)
Line7791	Note:
4Jul16 / 17Aug16	

GARAGE DOORS

Inv.620	1 - GARAGE DOOR OPENER - WITH 1 REMOTE - PRICE IS PER DOOR
Line7787	Note:
4Jul16 / 17Aug16	

GLASS AND MIRROR

Inv.620	1 - MASTER ENSUITE: CONVERT FRAMED SHOWER TO 10MM FRAMLESS SHOWER ENCLOSURE WITH DOOR AND 10MM SIDE PANEL (note revised ensuite layout)
Line7785	Note:
4Jul16 / 17Aug16	

INTERIOR TRIM AND DOORS

Inv.620	4 - MAIN FLOOR: EXTENDED HEIGHT ARCHWAY (PRICE PER DOORWAY) - 8' ARCHWAY
Line7792	Note:
4Jul16 / 17Aug16	
Inv.620	5 - STANDARD DOOR EXTENDED HEIGHT 96 INCH (PRICE PER DOOR) MAIN FLOOR - INCLUDE FRAMING
Line7793	Note:
4Jul16 / 17Aug16	

**Kleinburg Glen - 24R - 1 - 25-3 Elev.B OAKMOUNT OPT- GFA1 AND SFA4
MISC.**

Inv.620	1 - Purchaser has attended a Structural appointment at the Decor Centre & has DECLINED any additional upgrades and accepts and acknowledges that there will be no further structural changes/additions/deletions to be made upon signing on July 11, 2016.
Line8181	Note:
4Jul16 / 17Aug16	
Inv.620	1 - BONUS PACKAGE: \$5,000.00 (INCLUDING TAXES) WORTH OF UPGRADES FROM GOLD PARK HOMES DÉCOR CENTRE IS BEING APPLIED TOWARD THE STRUCTURAL APPOINTMENT. PURCHASER HAS A REMAINING AMOUNT OF \$00 (INCLUDING TAXES) TO BE USED TOWARD THE COLOUR APPOINTMENT.
Line8183	Note:
4Jul16 / 17Aug16	
Inv.620	1 - Purchasers are aware & accepts that ANY changes made to upgrades after signing this Purchasers Extra Form are subject to a minimum administration fee of \$500. PLUS a 10% holdback fee.
Line8182	Note:
4Jul16 / 17Aug16	
Inv.620	1 - *DELETE* ALL MIRRORS AND ACCESSORIES
Line8170	Note:
4Jul16 / 17Aug16	

PLUMBING

Inv.620	1 - 2ND FLOOR LAUNDRY: prep for future stackable washer/dryer.
Line8179	Note:
4Jul16 / 17Aug16	
Inv.620	1 - MASTER ENSUITE: INSTALL STANDARD SHOWER ARM/HEAD AT APPROX. 6'-6" A.F.F.
Line8145	Note:
4Jul16 / 17Aug16	
Inv.620	1 - 2ND FLOOR LAUNDRY: ROTATE STACKABLE WASHER/DRYER so they are accessible from *INSIDE* laundry room. See plan for location.
Line8180	Note:
4Jul16 / 17Aug16	



Stacey Carlete
Project Coordinator



Claude Azzopardi
Contracts Manager



Nancy Martini
Corporate Controller



25.1 The Riverstone			
Elevation	Circle One	A	1812.7 Square Feet
		B	1812.7 Square Feet
Taller Ceilings	Circle All that Apply	GFTC	9' Ceilings Ground Floor
		MFTC	10' Ceilings Main Floor
		SFTC	9' Ceilings Second Floor
Optional Layouts	Circle All that Apply	GFA1	GROUND FLOOR Alternative Layout Kitchen/Family Room

25.2 The Hudson			
Elevation	Circle One	A	1860.8 Square Feet
		B	1858.6 Square Feet
Taller Ceilings	Circle All that Apply	GFTC	9' Ceilings Ground Floor
		MFTC	10' Ceilings Main Floor
		SFTC	9' Ceilings Second Floor
Optional Layouts	Circle All that Apply	GFA1	GROUND FLOOR Alternative Layout Kitchen/Family Room

25.3 The Oakmount			
Elevation	Circle One	A	2013.0 Square Feet
		B	2013.0 Square Feet
Taller Ceilings	Circle All that Apply	GFTC	9' Ceilings Ground Floor
		MFTC	10' Ceilings Main Floor
		SFTC	9' Ceilings Second Floor
Optional Layouts	Circle All that Apply	GFA1	GROUND FLOOR Alternative Layout Kitchen/Family Room
		SFA4	SECOND FLOOR Alternative Layout Laundry Room
		SFA5	SECOND FLOOR Additional Bedroom

25.4 The Stanford			
Elevation	Circle One	A	2665.6 Square Feet
		B	2665.6 Square Feet
Taller Ceilings	Circle All that Apply	GFTC	9' Ceilings Ground Floor
		MFTC	10' Ceilings Main Floor
		SFTC	9' Ceilings Second Floor
Optional Layouts	Circle All that Apply	GFA2	GROUND FLOOR Optional 3-Piece Bathroom
		MFA1	MAIN FLOOR Alternative Layout Kitchen/Family Room
		SFA2	SECOND FLOOR Shower in Lieu of Tub (Master Ens.)
		SFA5	SECOND FLOOR Additional Bedroom

25.5 The Regency			
Elevation	Circle One	A	2924.0 Square Feet
		B	2924.0 Square Feet
Taller Ceilings	Circle All that Apply	GFTC	9' Ceilings Ground Floor
		MFTC	10' Ceilings Main Floor
		SFTC	9' Ceilings Second Floor
Optional Layouts	Circle All that Apply	GFA2	GROUND FLOOR Optional 3-Piece Bathroom
		MFA1	MAIN FLOOR Alternative Layout Kitchen/Family Room
		SFA2	SECOND FLOOR Shower in Lieu of Tub (Master Ens.)
		SFA5	SECOND FLOOR Additional Bedroom

25.6 The Lincoln			
Elevation	Circle One	A	3021.0 Square Feet
		B	3014.0 Square Feet
Taller Ceilings	Circle All that Apply	GFTC	9' Ceilings Ground Floor
		MFTC	10' Ceilings Main Floor
		SFTC	9' Ceilings Second Floor
Optional Layouts	Circle All that Apply	GFA2	GROUND FLOOR Optional 3-Piece Bathroom
		MFA1	MAIN FLOOR Alternative Layout Kitchen/Family Room

25.7 The Carnegie			
Elevation	Circle One	A	3150.8 Square Feet
		B	3150.8 Square Feet
Taller Ceilings	Circle All that Apply	GFTC	9' Ceilings Ground Floor
		MFTC	10' Ceilings Main Floor
		SFTC	9' Ceilings Second Floor
Optional Layouts	Circle All that Apply	GFA2	GROUND FLOOR Optional 3-Piece Bathroom
		MFA1	MAIN FLOOR Alternative Layout Kitchen/Family Room
		SFA1	SECOND FLOOR Shower in Lieu of Tub (Bedroom 2)

25.8 The Biltmore			
Elevation	Circle One	A	1980.8 Square Feet
		B	1989.3 Square Feet
Taller Ceilings	Circle All that Apply	GFTC	9' Ceilings Ground Floor
		MFTC	10' Ceilings Main Floor
		SFTC	9' Ceilings Second Floor
Optional Layouts	Circle All that Apply		

Elevation	Circle One		
Taller Ceilings	Circle All that Apply		
Optional Layouts	Circle All that Apply		

Elevation	Circle One		
Taller Ceilings	Circle All that Apply		
Optional Layouts	Circle All that Apply		

July 11 2016
LOT 24R


—Elevation A • ~~2,053~~ sq.ft.

✓Elevation B • 2,053 sq.ft.

LOT 2AR

JUNE 11 2016

(Signature)

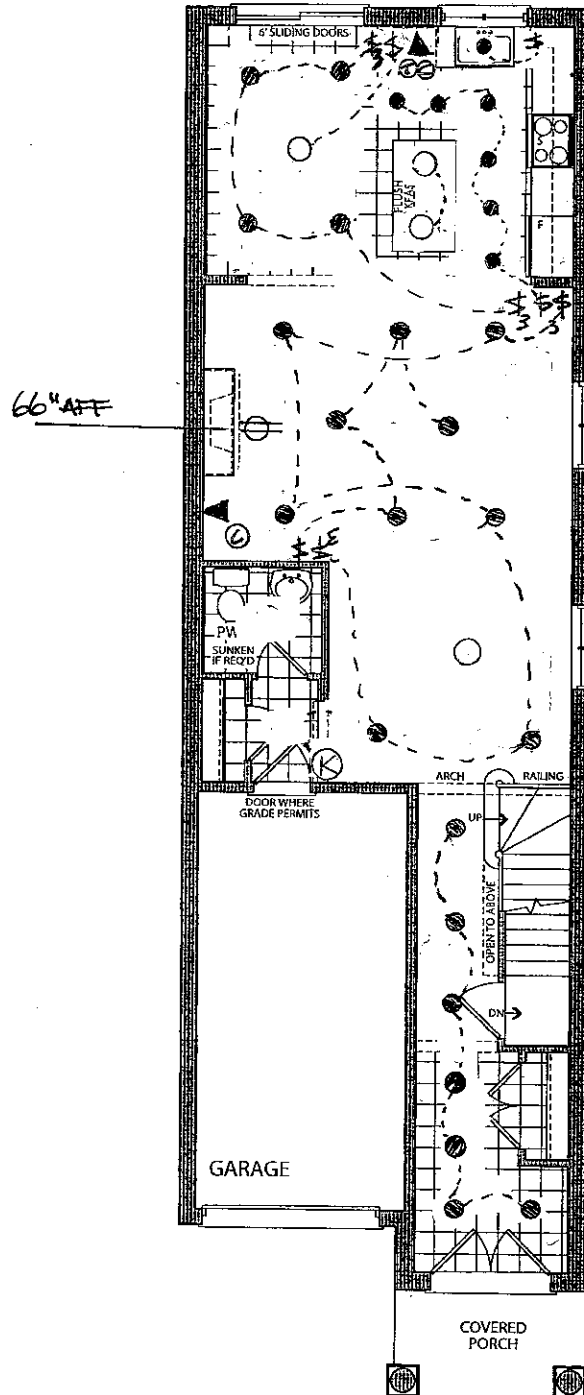

OPT. GROUND FLOOR
ELEVATION A

LEGEND

- P/LIGHT
- STD CEILING LIGHT
- Ⓚ KEY PAD R/W
- \$ SINGLE POLE SWITCH
- \$₃ 3-WAY SWITCH
- ▲[Ⓚ] PHONE
- ▲[Ⓚ] CABLE
- Ⓚ ELECT. OUTLET



Elevation A • 2,053 sq.ft.

Elevation B • 2,053 sq.ft.

LOT 24-R

July 11 2016




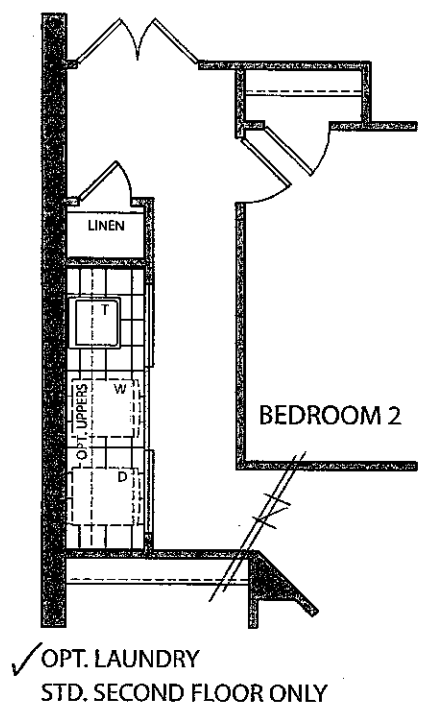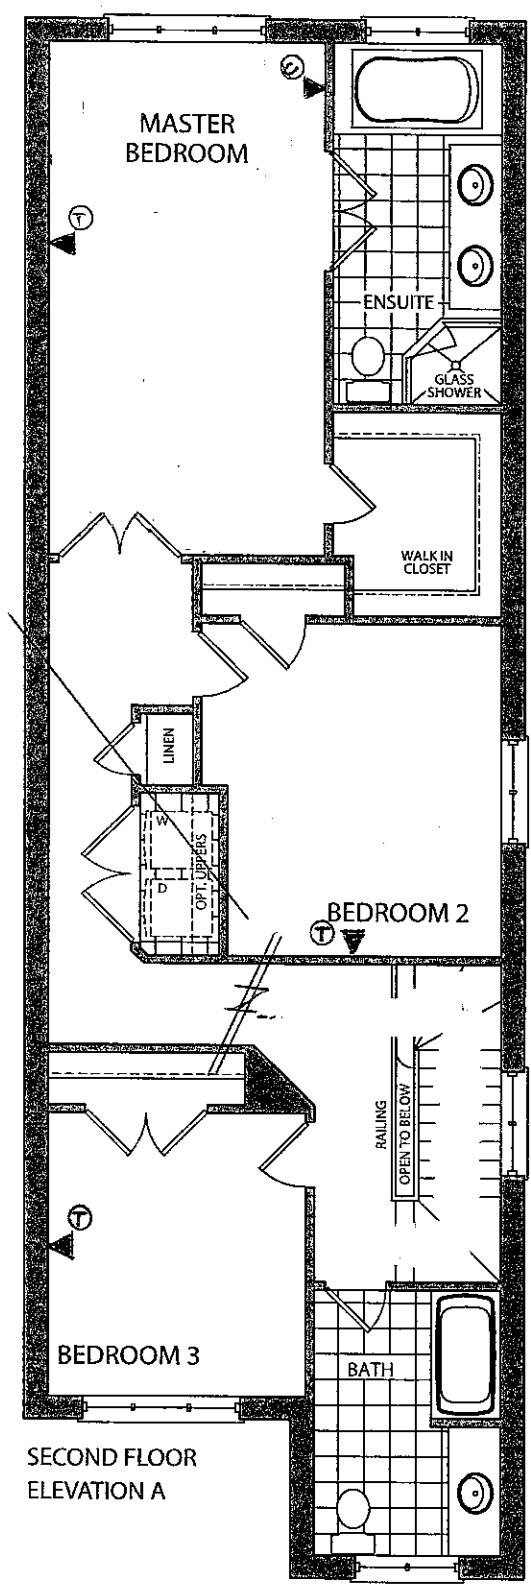

Lot 24R

July 11 2016



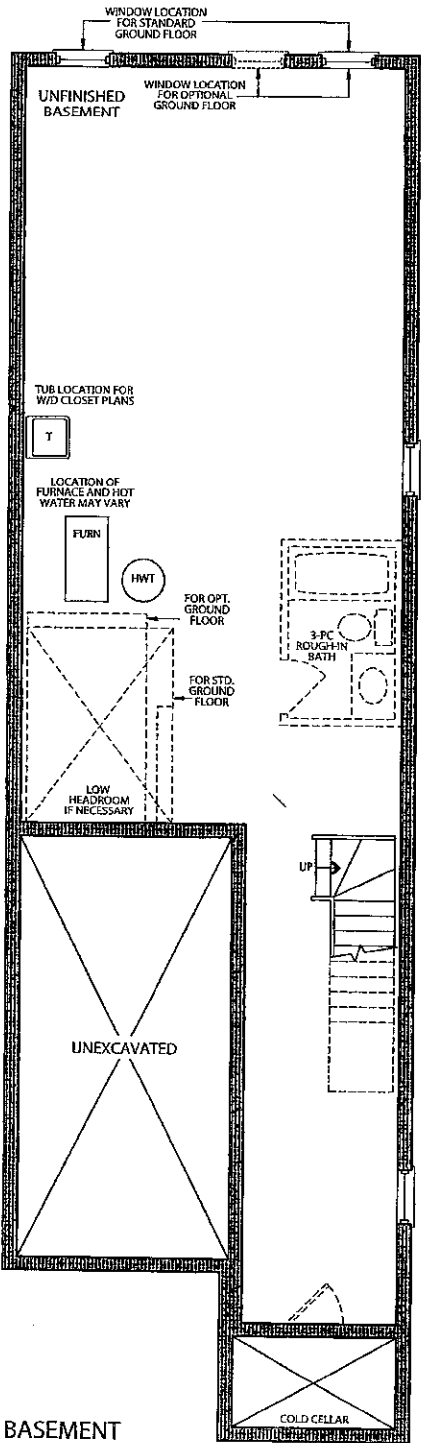

BASEMENT
 ELEVATION A & B