

Kleinburg Glen - 26L - 1 - 25-3 Elev.A OAKMOUNT OPT- GFA1 AND SFA5  
CENTRAL VAC AND WIRING

Inv.662	1 - GREAT ROOM: CONDUIT PIPE - FOR TELEVISION - LOCATED ABOVE FIREPLACE APPROX 66" AFF. TERMINATING LEFT OF FIREPLACE. PLEASE SEE FLOORPLAN FOR DETAIL
Line8517	Note:
14Jul16 / 17Aug16	

ELECTRICAL

Inv.662	1 - GREAT ROOM: 110V WALL RECEPTACLE ON NORMAL CIRCUIT - LOCATED ABOVE FIREPLACE APPROX 66" AFF. NEXT TO CONDUIT PIPE & CABLE. PLEASE SEE FLOORPLAN FOR DETAIL
Line8518	Note:
14Jul16 / 17Aug16	

Inv.662	4 - KITCHEN: POT LIGHT: 4 INCH HALOGEN POT LIGHT - 440 WH - X 4. PLEASE SEE FLOORPLAN FOR LOCATIONS
Line8519	Note:
14Jul16 / 17Aug16	

Inv.662	1 - KITCHEN POTLIGHTS: ON A SEPARATE SWITCH
Line8520	Note:
14Jul16 / 17Aug16	

Inv.662	1 - KITCHEN: RELOCATE STANDARD KITCHEN CEILING LIGHT TO OVER ISLAND. LEFT SIDE. PLEASE SEE FLOORPLAN FOR LOCATION
Line8521	Note:
14Jul16 / 17Aug16	

Inv.662	1 - KITCHEN: ROUGH - IN CEILING OUTLET (WITH COVER PLATE) - DOES NOT INCLUDE FIXTURE - RIGHT SIDE OVER ISLAND. BOTH CEILING ISLAND LIGHTS TO BE ON THE SAME STANDARD SWITCH. PLEASE SEE FLOORPLAN FOR LOCATION.
Line8522	Note:
14Jul16 / 17Aug16	

Inv.662	1 - KITCHEN CABINET STRIP VALANCE LIGHTS (UNDER CABINETS) - ROUGH - IN - DOES NOT INCLUDE (AND REQUIRES) KITCHEN UPGRADE PRICING. ABOVE DISHWASHER, LEFT & RIGHT OF OVEN.
Line8523	Note: PLEASE RELOCATE UNDERCABINET LIGHT SWITCH ABOVE DISHWASHER, LEFT OF SINK. SEE FLOORPLAN FOR LOCATION
14Jul16 / 17Aug16	

Inv.662	8 - GREAT ROOM: POT LIGHT: 4 INCH HALOGEN POT LIGHT - 440 WH - x8. 4 x IN ZONE 1, 4 x IN ZONE 2. BOTH ON SEPARATE SWITCHES. PLEASE SEE FLOORPLAN FOR LOCATIONS.
Line8526	Note:
14Jul16 / 17Aug16	

Inv.662	2 - GREAT ROOM: ZONE 1 & ZONE 2 POTLIGHTS ON TWO SEPARATE SWITCHES
Line8527	Note:
14Jul16 / 17Aug16	

EXTERIOR COLOURS

Inv.662	1 - EXTERIOR COLOUR PACKAGE 3
Line10267	Note:
14Jul16 / 17Aug16	

FRAMING

Inv.662	1 - MASTER ENSUITE: DELETE TUB TO ACCOMMODATE RELOCATED TOILET AND ADD FULL WIDTH FRAMELESS SHOWER. PLEASE SEE FLOORPLAN FOR LOCATIONS.
Line10266	Note:
14Jul16 / 17Aug16	

Kleinburg Glen - 26L - 1 - 25-3 Elev.A OAKMOUNT OPT- GFA1 AND SFA5

HVAC

Inv.662	1 - KITCHEN: PLEASE LOCATED STANDARD HOOD VENT PIPE CENTERED OVER OVEN OPENING TO ACCOMMODATE CHIMNEY STYLE HOOD.
Line8530	Note:
14Jul16 / 17Aug16	

INTERIOR TRIM AND DOORS


Inv.662	2 - MAIN FLOOR: EXTENDED HEIGHT ARCHWAY (PRICE PER DOORWAY)
Line9245	Note:
14Jul16 / 17Aug16	
Inv.662	5 - STANDARD DOOR EXTENDED HEIGHT 96 INCH (PRICE PER DOOR) - GROUND FLOOR 2 STOREY MODELS
Line9246	Note:
14Jul16 / 17Aug16	

MISC.

Inv.662	1 - Purchaser has attended a Structural appointment at the Decor Centre & has DECLINED any additional upgrades and accepts and acknowledges that there will be no further structural changes/additions/deletions to be made upon signing on July 14, 2016.
Line8612	Note:
14Jul16 / 17Aug16	
Inv.662	1 - Purchasers are aware & accepts that ANY changes made to upgrades after signing this Purchasers Extra Form are subject to a minimum administration fee of \$500. PLUS a 10% holdback fee.
Line8613	Note:
14Jul16 / 17Aug16	
Inv.662	1 - BONUS PACKAGE: \$5,000.00 (INCLUDING TAXES) WORTH OF UPGRADES FROM GOLD PARK HOMES DÉCOR CENTRE IS BEING APPLIED TOWARD THE STRUCTURAL APPOINTMENT. PURCHASER HAS A REMAINING AMOUNT OF \$00 (INCLUDING TAXES) TO BE USED TOWARD THE COLOUR APPOINTMENT.
Line8614	Note:
14Jul16 / 17Aug16	
Inv.662	1 - Balance paid by VISA \$7,266.15
Line8616	Note:
14Jul16 / 17Aug16	

PLUMBING

Inv.662	1 - MASTER ENSUITE: DELETE TUB TO ACCOMMODATE RELOCATED TOILET AND ADD FULL WIDTH FRAMELESS SHOWER. PLEASE SEE FLOORPLAN FOR LOCATIONS.
Line9237	Note:
14Jul16 / 17Aug16	
Inv.662	1 - MASTER ENSUITE: RELOCATE TOILET. PLEASE SEE FLOORPLAN FOR LOCATION
Line9236	Note:
14Jul16 / 17Aug16	

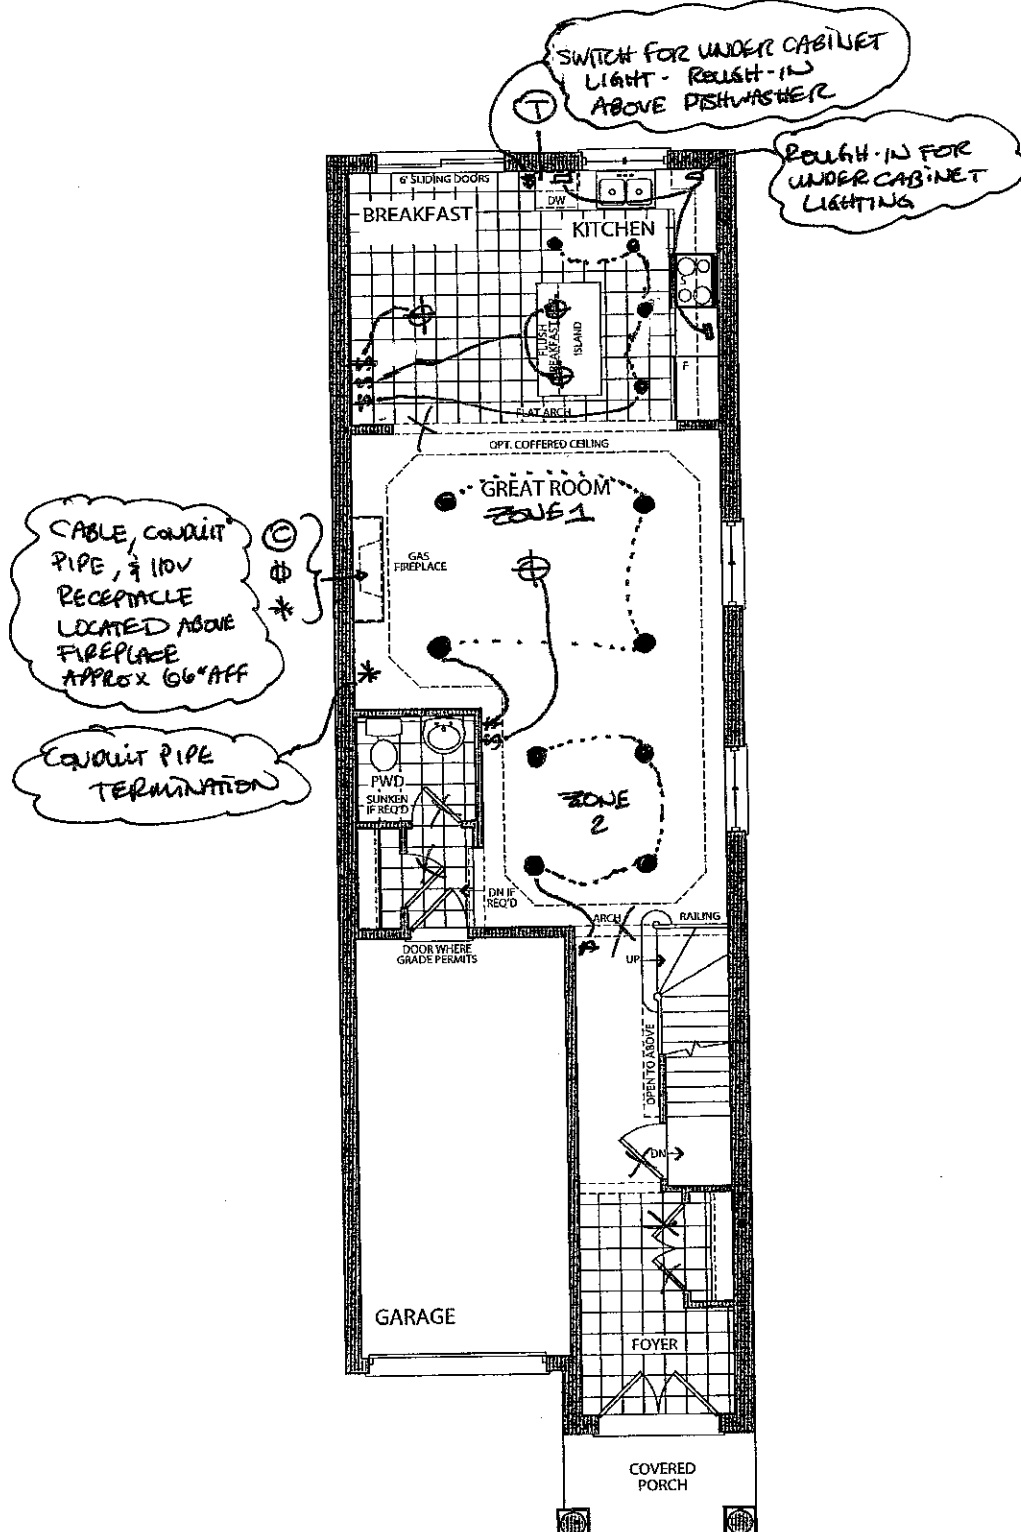

OPT. GROUND FLOOR

ELEVATION A

- LEGEND
- Ⓣ - TELEPHONE
  - Ⓢ - CABLE
  - Ⓢ - 110V RECEPTACLE
  - - FOTLIGHT
  - ≡ - UNDERCABINET LIGHTING ROUGH IN.

LOT 26L

JULY 26, 2016

CN D.A

X - EXTENDED DOOR + ARCHWAY HEIGHTS

Prices, figures, illustrations, sizes, features and finishes are subject to change without notice. E.&O.E. Areas and dimensions are approximate and actual usable floor space may vary from the stated area. Layout may be reverse of the unit purchased. E. & O.E.


✓ Elevation A • 2,053 sq.ft.

~~Elevation B • 2,053 sq.ft.~~


LOT 262

DATE: July 26, 2016

CN D.A

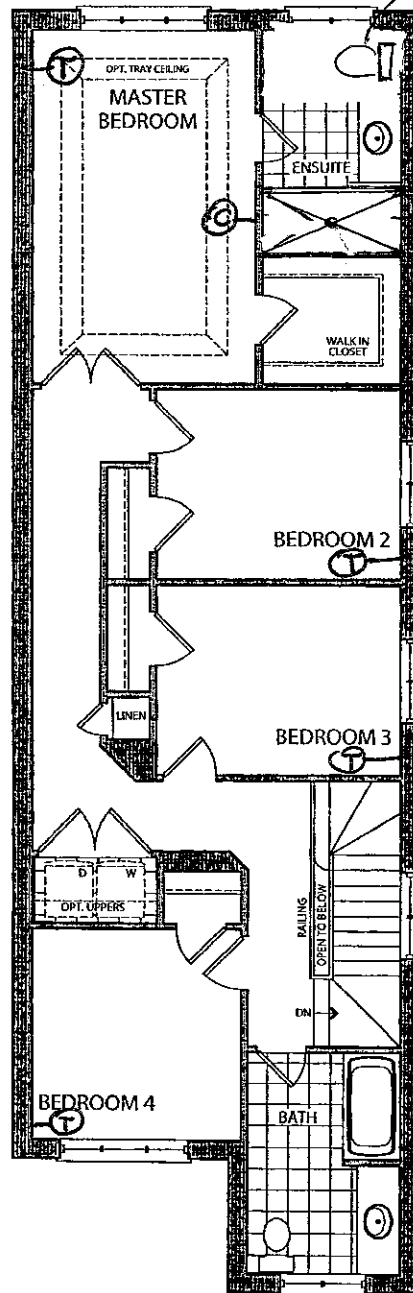

OPT. SECOND FLOOR  
ELEVATION A

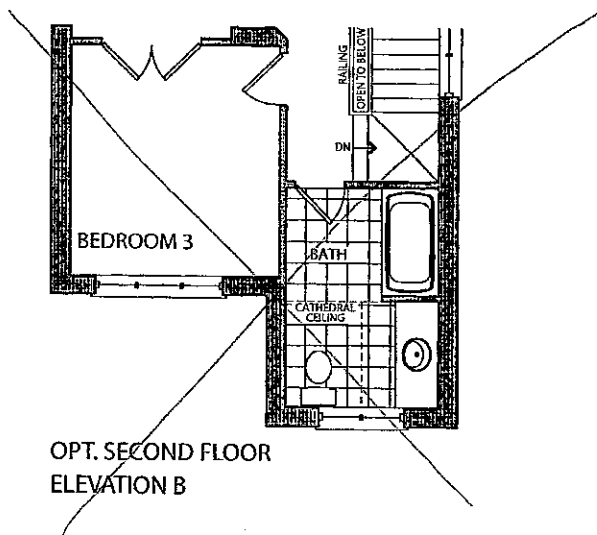


OPT. SECOND FLOOR  
ELEVATION B

LOT 26L

DATE July 26, 2016

(CN) (D.A)

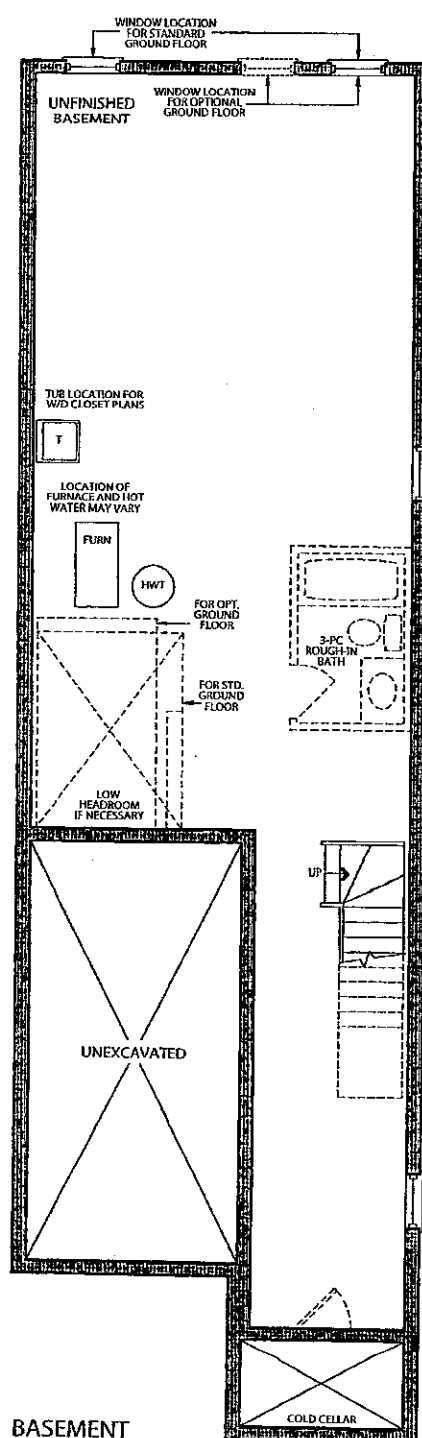



Stacey Carlete  
Project Coordinator



Claude Azzopardi  
Contracts Manager



Nancy Martini  
Corporate Controller



25.1 The Riverstone			
Elevation	Circle One	A	1812.7 Square Feet
		B	1812.7 Square Feet
Taller Ceilings	Circle All that Apply	GFTC	9' Ceilings Ground Floor
		MFTC	10' Ceilings Main Floor
		SFTC	9' Ceilings Second Floor
Optional Layouts	Circle All that Apply	GFA1	GROUND FLOOR Alternative Layout Kitchen/Family Room

25.2 The Hudson			
Elevation	Circle One	A	1860.8 Square Feet
		B	1858.6 Square Feet
Taller Ceilings	Circle All that Apply	GFTC	9' Ceilings Ground Floor
		MFTC	10' Ceilings Main Floor
		SFTC	9' Ceilings Second Floor
Optional Layouts	Circle All that Apply	GFA1	GROUND FLOOR Alternative Layout Kitchen/Family Room

25.3 The Oakmount			
Elevation	Circle One	<u>A</u>	2013.0 Square Feet
		B	2013.0 Square Feet
Taller Ceilings	Circle All that Apply	<u>GFTC</u>	9' Ceilings Ground Floor
		MFTC	10' Ceilings Main Floor
		SFTC	9' Ceilings Second Floor
Optional Layouts	Circle All that Apply	<u>GFA1</u>	GROUND FLOOR Alternative Layout Kitchen/Family Room
		SFA4	SECOND FLOOR Alternative Layout Laundry Room
		<u>SFA5</u>	SECOND FLOOR Additional Bedroom

25.4 The Stanford			
Elevation	Circle One	A	2665.6 Square Feet
		B	2665.6 Square Feet
Taller Ceilings	Circle All that Apply	GFTC	9' Ceilings Ground Floor
		MFTC	10' Ceilings Main Floor
		SFTC	9' Ceilings Second Floor
Optional Layouts	Circle All that Apply	GFA2	GROUND FLOOR Optional Piece Bathroom
		MFA1	MAIN FLOOR Alternative Layout Kitchen/Family Room
		SFA2	SECOND FLOOR Shower in Lieu of Tub (Master Ens.)
		SFA5	SECOND FLOOR Additional Bedroom

25.5 The Regency			
Elevation	Circle One	A	2924.0 Square Feet
		B	2924.0 Square Feet
Taller Ceilings	Circle All that Apply	GFTC	9' Ceilings Ground Floor
		MFTC	10' Ceilings Main Floor
		SFTC	9' Ceilings Second Floor
Optional Layouts	Circle All that Apply	GFA2	GROUND FLOOR Optional Piece Bathroom
		MFA1	MAIN FLOOR Alternative Layout Kitchen/Family Room
		SFA2	SECOND FLOOR Shower in Lieu of Tub (Master Ens.)
		SFA5	SECOND FLOOR Additional Bedroom

25.6 The Lincoln			
Elevation	Circle One	A	3021.0 Square Feet
		B	3014.0 Square Feet
Taller Ceilings	Circle All that Apply	GFTC	9' Ceilings Ground Floor
		MFTC	10' Ceilings Main Floor
		SFTC	9' Ceilings Second Floor
Optional Layouts	Circle All that Apply	GFA2	GROUND FLOOR Optional Piece Bathroom
		MFA1	MAIN FLOOR Alternative Layout Kitchen/Family Room

25.7 The Carnegie			
Elevation	Circle One	A	3150.8 Square Feet
		B	3150.8 Square Feet
Taller Ceilings	Circle All that Apply	GFTC	9' Ceilings Ground Floor
		MFTC	10' Ceilings Main Floor
		SFTC	9' Ceilings Second Floor
Optional Layouts	Circle All that Apply	GFA2	GROUND FLOOR Optional Piece Bathroom
		MFA1	MAIN FLOOR Alternative Layout Kitchen/Family Room
		SFA1	SECOND FLOOR Shower in Lieu of Tub (Bedroom 2)

25.8 The Biltmore			
Elevation	Circle One	A	1980.8 Square Feet
		B	1989.3 Square Feet
Taller Ceilings	Circle All that Apply	GFTC	9' Ceilings Ground Floor
		MFTC	10' Ceilings Main Floor
		SFTC	9' Ceilings Second Floor
Optional Layouts	Circle All that Apply		

Elevation	Circle One		
Taller Ceilings	Circle All that Apply		
Optional Layouts	Circle All that Apply		

Elevation	Circle One		
Taller Ceilings	Circle All that Apply		
Optional Layouts	Circle All that Apply		

CW  
D.A

DATE July 26, 2016

LOT 26L