

Kleinburg Glen - 29R - 1 - 25-1 Elev.B RIVERSTONE OPT- GFA1
CENTRAL VAC AND WIRING

Inv.730	1 - FAMILY ROOM: CONDUIT PIPE - FOR TELEVISION - Locate above fireplace approx. 60" A.F.F. See plan for location. Terminating right of fireplace by cable outlet.
Line9868	Note:
9Aug16 / 11Oct16	

ELECTRICAL

Inv.730	1 - FAMILY ROOM: 110V WALL RECEPTACLE ON NORMAL CIRCUIT - Locate approx. 60" A.F.F. above fireplace. See plan for location.
Line9869	Note:
9Aug16 / 11Oct16	

Inv.730	1 - KITCHEN: RELOCATE STANDARD FIXTURE - Move to above island. See plan for location.
Line9884	Note:
9Aug16 / 11Oct16	

Inv.730	1 - KITCHEN: ROUGH - IN CEILING OUTLET ON SAME SWITCH - DOES NOT INCLUDE FIXTURE - Locate above island, using same switch as standard. See plan for location.
Line9885	Note:
9Aug16 / 11Oct16	

Inv.730	1 - KITCHEN: 110V WALL RECEPTACLE ON DEDICATED CIRCUIT - Locate above stove for future OTR Microwave
Line9887	Note:
9Aug16 / 11Oct16	

Inv.730	4 - KITCHEN: POT LIGHT: 4 INCH HALOGEN POT LIGHT - 440 WH - PRICED PER LIGHT - 10 OR MORE. See plan for location.
Line9888	Note:
9Aug16 / 11Oct16	

Inv.730	1 - KITCHEN: Single pole switch for potlights.
Line9890	Note:
9Aug16 / 11Oct16	

Inv.730	4 - FAMILY ROOM: POT LIGHT: 4 INCH HALOGEN POT LIGHT - 440 WH - PRICED PER LIGHT - 10 OR MORE - Add 4 potlights in corners of room, see plan for location.
Line9891	Note:
9Aug16 / 11Oct16	

Inv.730	1 - FAMILY ROOM: Single pole switch for potlights.
Line9892	Note:
9Aug16 / 11Oct16	

Inv.730	4 - MAIN HALL: POT LIGHT: 4 INCH HALOGEN POT LIGHT - 440 WH - PRICED PER LIGHT - 10 OR MORE - *DELETE* builders standard light, install 4 potlights using standard switches. See plan for location.
Line9893	Note:
9Aug16 / 11Oct16	

EXTERIOR COLOURS

Inv.730	1 - EXTERIOR COLOUR PACKAGE 2
Line12529	Note:
9Aug16 / 11Oct16	

FRAMING

Kleinburg Glen - 29R - 1 - 25-1 Elev.B RIVERSTONE OPT- GFA1

Inv.730	8 - FRAME MAIN FLOOR DOORS & ARCHES AT 96 INCH - ADDED WITH THE ADDITION OF TALLER INTERIOR DOORS
Line9912	Note:
9Aug16 / 11Oct16	
Inv.730	1 - OPTIONAL GROUND FLOOR PLAN
Line12530	Note:
9Aug16 / 11Oct16	

INTERIOR TRIM AND DOORS


Inv.730	2 - MAIN FLOOR: EXTENDED HEIGHT ARCHWAY (PRICE PER DOORWAY) - 96"
Line9913	Note:
9Aug16 / 11Oct16	
Inv.730	6 - MAIN FLOOR: STANDARD DOOR EXTENDED HEIGHT 96 INCH (PRICE PER DOOR) MAIN FLOOR 3 STOREY MODELS - INCLUDE FRAMING NOTE
Line9914	Note:
9Aug16 / 11Oct16	



MISC.

Inv.730	1 - Purchasers are aware & accepts that ANY changes made to upgrades after signing this Purchasers Extra Form are subject to a minimum administration fee of \$500. PLUS a 10% holdback fee.
Line9918	Note:
9Aug16 / 11Oct16	
Inv.730	1 - Purchaser has attended a Structural appointment at the Decor Centre & has DECLINED any additional upgrades and accepts and acknowledges that there will be no further structural changes/additions/deletions to be made upon signing on August 9, 2016.
Line9917	Note:
9Aug16 / 11Oct16	
Inv.730	1 - BONUS PACKAGE: \$5,000.00 (INCLUDING TAXES) WORTH OF UPGRADES FROM GOLD PARK HOMES DÉCOR CENTRE IS BEING APPLIED TOWARD THE STRUCTURAL APPOINTMENT. PURCHASER HAS A REMAINING AMOUNT OF \$00 (INCLUDING TAXES) TO BE USED TOWARD THE COLOUR APPOINTMENT.
Line9919	Note:
9Aug16 / 11Oct16	

PLUMBING

Inv.730	1 - KITCHEN: ROUGH - IN - WATERLINE FOR FRIDGE
Line9903	Note:
9Aug16 / 11Oct16	

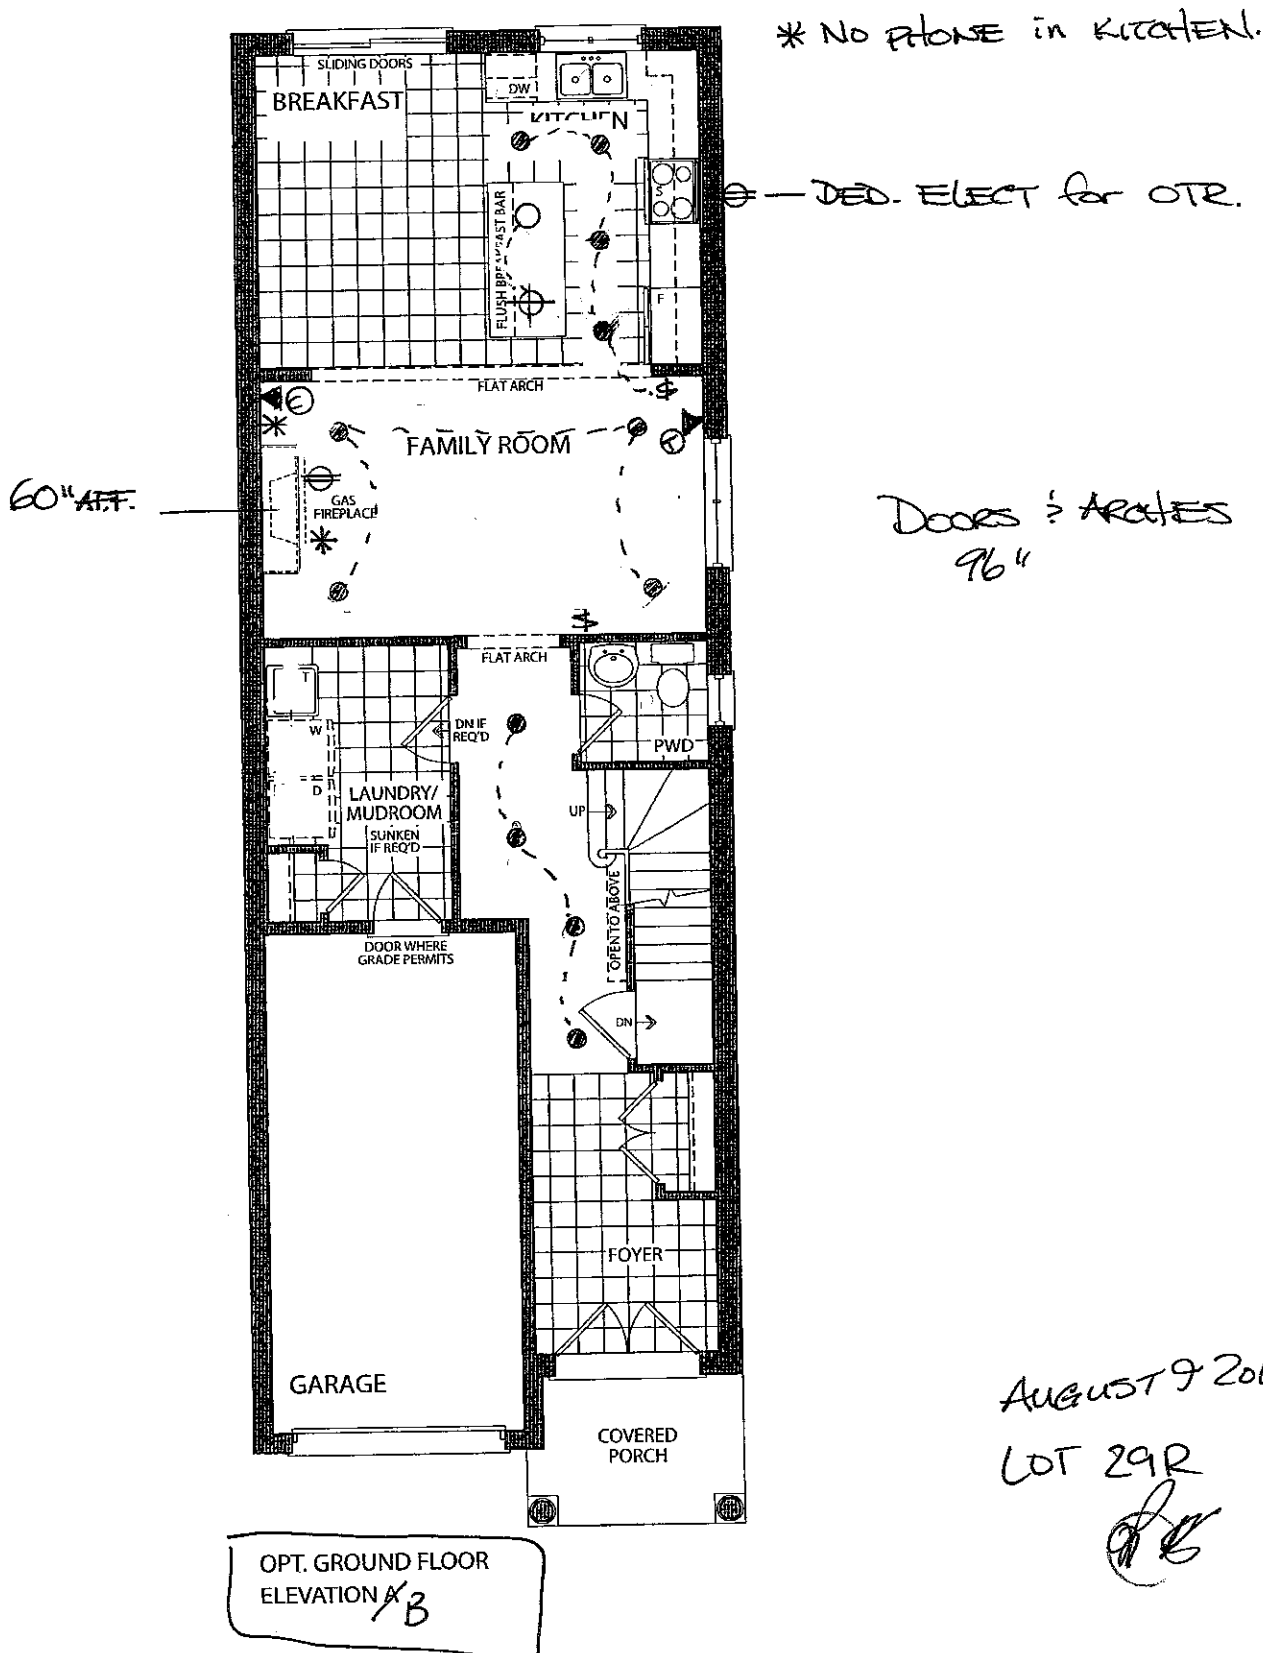

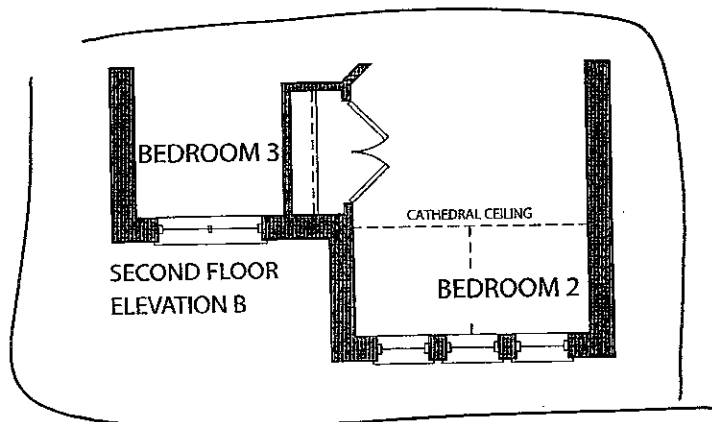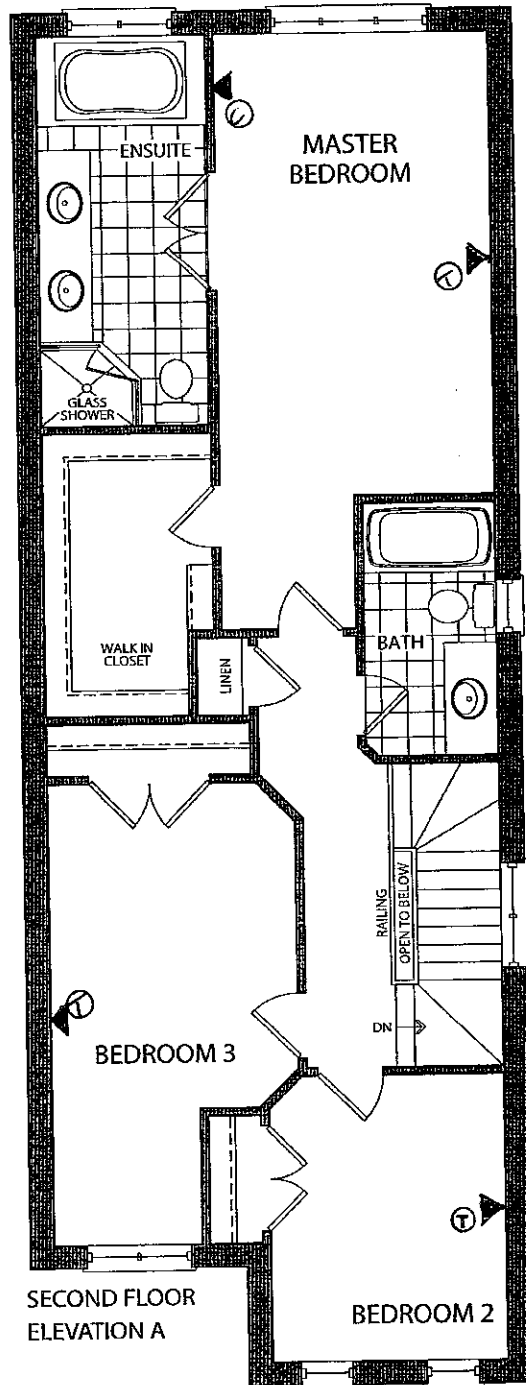



August 9 2016

LOT 29.R

[Signature]

Elevation A • 1,849 sq.ft.

Elevation B • 1,849 sq.ft.

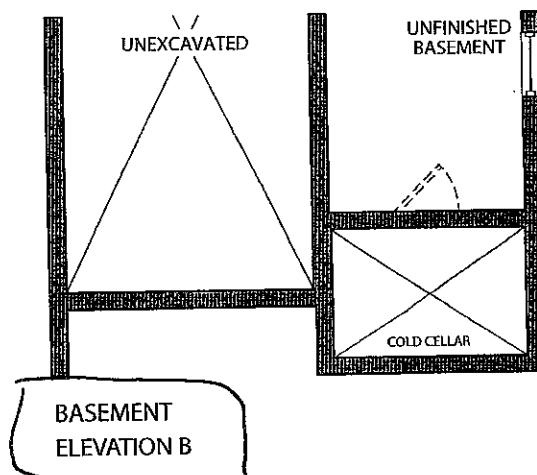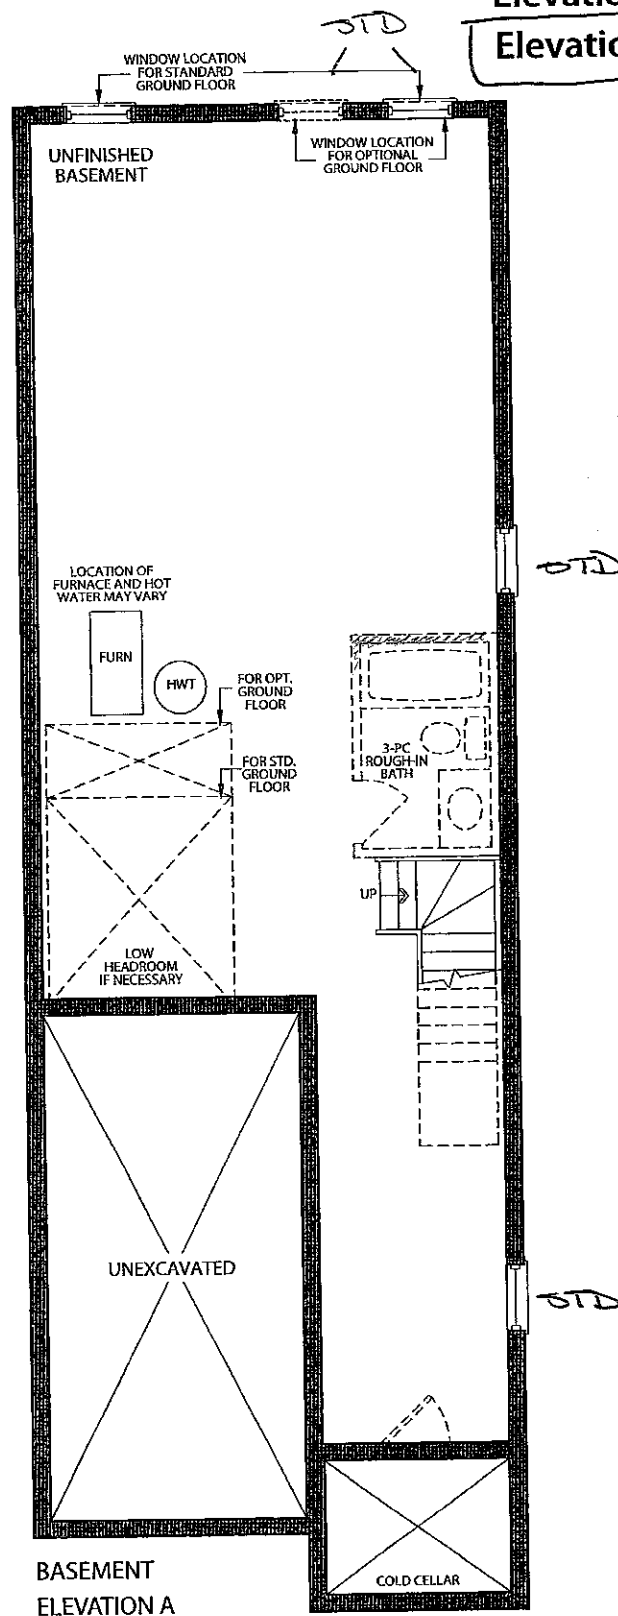

AUGUST 9 2016

LOT 29R

[Signature]



Stacey Carlete
Project Coordinator



Claude Azzopardi
Contracts Manager



Nancy Martini
Corporate Controller



25.1 The Riverstone			
Elevation	Circle One	A	1812.7 Square Feet
		B	1812.7 Square Feet
Taller Ceilings	Circle All that Apply	GFTC	9' Ceilings Ground Floor
		MFTC	10' Ceilings Main Floor
		SFTC	9' Ceilings Second Floor
Optional Layouts	Circle All that Apply	GFA1	GROUND FLOOR Alternative Layout Kitchen/Family Room

25.2 The Hudson			
Elevation	Circle One	A	1860.8 Square Feet
		B	1858.6 Square Feet
Taller Ceilings	Circle All that Apply	GFTC	9' Ceilings Ground Floor
		MFTC	10' Ceilings Main Floor
		SFTC	9' Ceilings Second Floor
Optional Layouts	Circle All that Apply	GFA1	GROUND FLOOR Alternative Layout Kitchen/Family Room

25.3 The Oakmount			
Elevation	Circle One	A	2013.0 Square Feet
		B	2013.0 Square Feet
Taller Ceilings	Circle All that Apply	GFTC	9' Ceilings Ground Floor
		MFTC	10' Ceilings Main Floor
		SFTC	9' Ceilings Second Floor
Optional Layouts	Circle All that Apply	GFA1	GROUND FLOOR Alternative Layout Kitchen/Family Room
		SFA4	SECOND FLOOR Alternative Layout Laundry Room
		SFA5	SECOND FLOOR Additional Bedroom

25.4 The Stanford			
Elevation	Circle One	A	2665.6 Square Feet
		B	2665.6 Square Feet
Taller Ceilings	Circle All that Apply	GFTC	9' Ceilings Ground Floor
		MFTC	10' Ceilings Main Floor
		SFTC	9' Ceilings Second Floor
Optional Layouts	Circle All that Apply	GFA2	GROUND FLOOR Optional Piece Bathroom
		MFA1	MAIN FLOOR Alternative Layout Kitchen/Family Room
		SFA2	SECOND FLOOR Shower in Lieu of Tub (Master Ens.)
		SFA5	SECOND FLOOR Additional Bedroom

25.5 The Regency			
Elevation	Circle One	A	2924.0 Square Feet
		B	2924.0 Square Feet
Taller Ceilings	Circle All that Apply	GFTC	9' Ceilings Ground Floor
		MFTC	10' Ceilings Main Floor
		SFTC	9' Ceilings Second Floor
Optional Layouts	Circle All that Apply	GFA2	GROUND FLOOR Optional Piece Bathroom
		MFA1	MAIN FLOOR Alternative Layout Kitchen/Family Room
		SFA2	SECOND FLOOR Shower in Lieu of Tub (Master Ens.)
		SFA5	SECOND FLOOR Additional Bedroom

25.6 The Lincoln			
Elevation	Circle One	A	3021.0 Square Feet
		B	3014.0 Square Feet
Taller Ceilings	Circle All that Apply	GFTC	9' Ceilings Ground Floor
		MFTC	10' Ceilings Main Floor
		SFTC	9' Ceilings Second Floor
Optional Layouts	Circle All that Apply	GFA2	GROUND FLOOR Optional Piece Bathroom
		MFA1	MAIN FLOOR Alternative Layout Kitchen/Family Room

25.7 The Carnegie			
Elevation	Circle One	A	3150.8 Square Feet
		B	3150.8 Square Feet
Taller Ceilings	Circle All that Apply	GFTC	9' Ceilings Ground Floor
		MFTC	10' Ceilings Main Floor
		SFTC	9' Ceilings Second Floor
Optional Layouts	Circle All that Apply	GFA2	GROUND FLOOR Optional Piece Bathroom
		MFA1	MAIN FLOOR Alternative Layout Kitchen/Family Room
		SFA1	SECOND FLOOR Shower in Lieu of Tub (Bedroom 2)

25.8 The Biltmore			
Elevation	Circle One	A	1980.8 Square Feet
		B	1989.3 Square Feet
Taller Ceilings	Circle All that Apply	GFTC	9' Ceilings Ground Floor
		MFTC	10' Ceilings Main Floor
		SFTC	9' Ceilings Second Floor
Optional Layouts	Circle All that Apply		

Elevation	Circle One		
Taller Ceilings	Circle All that Apply		
Optional Layouts	Circle All that Apply		

Elevation	Circle One		
Taller Ceilings	Circle All that Apply		
Optional Layouts	Circle All that Apply		

LOT 29R