

CONSTRUCTION SUMMARY

30R - 1 - 25-2 Elev.A HUDSON

CENTRAL VAC AND WIRING

Inv.778	1 - FAMILY ROOM: CONDUIT PIPE - FOR TELEVISION - ABOVE FIREPLACE APPROX 66" AFF. NEXT TO STANDARD CABLE LOCATION. TERMINATING LEFT OF FIREPLACE AT STANDARD HEIGHT. PLEASE SEE FLOORPLAN FOR LOCATION.
Line10422	Note:
23Aug16 / 17Oct16	

ELECTRICAL

Inv.778	1 - FAMILY ROOM: 110V WALL RECEPTACLE ON NORMAL CIRCUIT - ABOVE FIREPLACE APPROX 66" AFF. NEXT TO STANDARD CABLE LOCATION. PLEASE SEE FLOORPLAN FOR LOCATION
Line10423	Note:
23Aug16 / 17Oct16	

Inv.778	1 - KITCHEN: 110V WALL RECEPTACLE ON DEDICATED CIRCUIT - GAS FIRED APPLIANCE - FOR AUX. EQUIPMENT - NOT A STOVE PLUG. TO ACCOMMODATE FUTURE GAS RANGE
Line10425	Note:
23Aug16 / 17Oct16	

Inv.778	1 - KITCHEN CABINET STRIP VALANCE LIGHTS (UNDER CABINETS) - ROUGH - IN - DOES NOT INCLUDE (AND REQUIRES) KITCHEN UPGRADE PRICING
Line10433	Note:
23Aug16 / 17Oct16	

EXTERIOR COLOURS

Inv.778	1 - EXTERIOR COLOUR PACKAGE 7
Line12760	Note:
23Aug16 / 17Oct16	

FRAMING

Inv.778	1 - EXTENDED HEIGHT ARCHWAY (PRICE PER DOORWAY) - INCLUDE FRAMING NOTE
Line12405	Note:
23Aug16 / 17Oct16	

Inv.778	1 - STANDARD DOOR EXTENDED HEIGHT 96 INCH (PRICE PER DOOR) - GROUND FLOOR 2 STOREY MODELS
Line12406	Note:
23Aug16 / 17Oct16	

GLASS AND MIRROR

Inv.778	1 - MASTER ENSUITE: CONVERT FRAMED SHOWER TO 10MM FRAMLESS SHOWER ENCLOSURE WITH DOOR AND 10MM SIDE PANEL
Line10444	Note:
23Aug16 / 17Oct16	

HVAC

Inv.778	1 - KITCHEN: GAS LINE ROUGH - GROUND FLOOR FOR FUTURE GAS RANGE
Line10426	Note:
23Aug16 / 17Oct16	

INTERIOR TRIM AND DOORS

CONSTRUCTION SUMMARY

30R - 1 - 25-2 Elev.A HUDSON

Inv.778	2 - EXTENDED HEIGHT ARCHWAY (PRICE PER DOORWAY) - INCLUDE FRAMING NOTE
Line10437	Note:
23Aug16 / 17Oct16	
Inv.778	4 - STANDARD DOOR EXTENDED HEIGHT 96 INCH (PRICE PER DOOR) - GROUND FLOOR 2 STOREY MODELS
Line10438	Note:
23Aug16 / 17Oct16	

MISC.

Inv.778	1 - Purchaser has attended a Structural appointment at the Decor Centre & has DECLINED any additional upgrades and accepts and acknowledges that there will be no further structural changes/additions/deletions to be made upon signing on August 23, 2016.
Line10457	Note:
23Aug16 / 17Oct16	
Inv.778	1 - Purchasers are aware & accepts that ANY changes made to upgrades after signing this Purchasers Extra Form are subject to a minimum administration fee of \$500. PLUS a 10% holdback fee.
Line10458	Note:
23Aug16 / 17Oct16	
Inv.778	1 - BONUS PACKAGE: \$5,000.00 (INCLUDING TAXES) WORTH OF UPGRADES FROM GOLD PARK HOMES DÉCOR CENTRE IS BEING APPLIED TOWARD THE STRUCTURAL APPOINTMENT. PURCHASER HAS A REMAINING AMOUNT OF \$00 (INCLUDING TAXES) TO BE USED TOWARD THE COLOUR APPOINTMENT.
Line10459	Note:
23Aug16 / 17Oct16	
Inv.778	1 - BALANCE AFTER CREDIT: \$2802.65 PAID BY CREDIT CARD
Line10460	Note:
23Aug16 / 17Oct16	

PLUMBING


Inv.778	1 - KITCHEN: ROUGH - IN - WATERLINE FOR FRIDGE
Line10428	Note:
23Aug16 / 17Oct16	

WINDOWS - BASEMENT

Inv.778	4 - BASEMENT WINDOWS - UPGRADE EXISTING BASEMENT WINDOW TO 30 INCH X 24 INCH - MAY REQUIRE INSTALLATION OF WINDOW WELL. PLEASE SEE FLOORPLAN FOR LOCATIONS.
Line10448	Note:
23Aug16 / 17Oct16	
Inv.778	2 - BASEMENT: COLOURMATCH UPGRADED REAR WINDOWS ONLY. PLEASE SEE FLOORPLAN FOR LOCATION
Line10449	Note:
23Aug16 / 17Oct16	


Elevation A • 1,898 sq.ft.

Elevation B • 1,898 sq.ft.

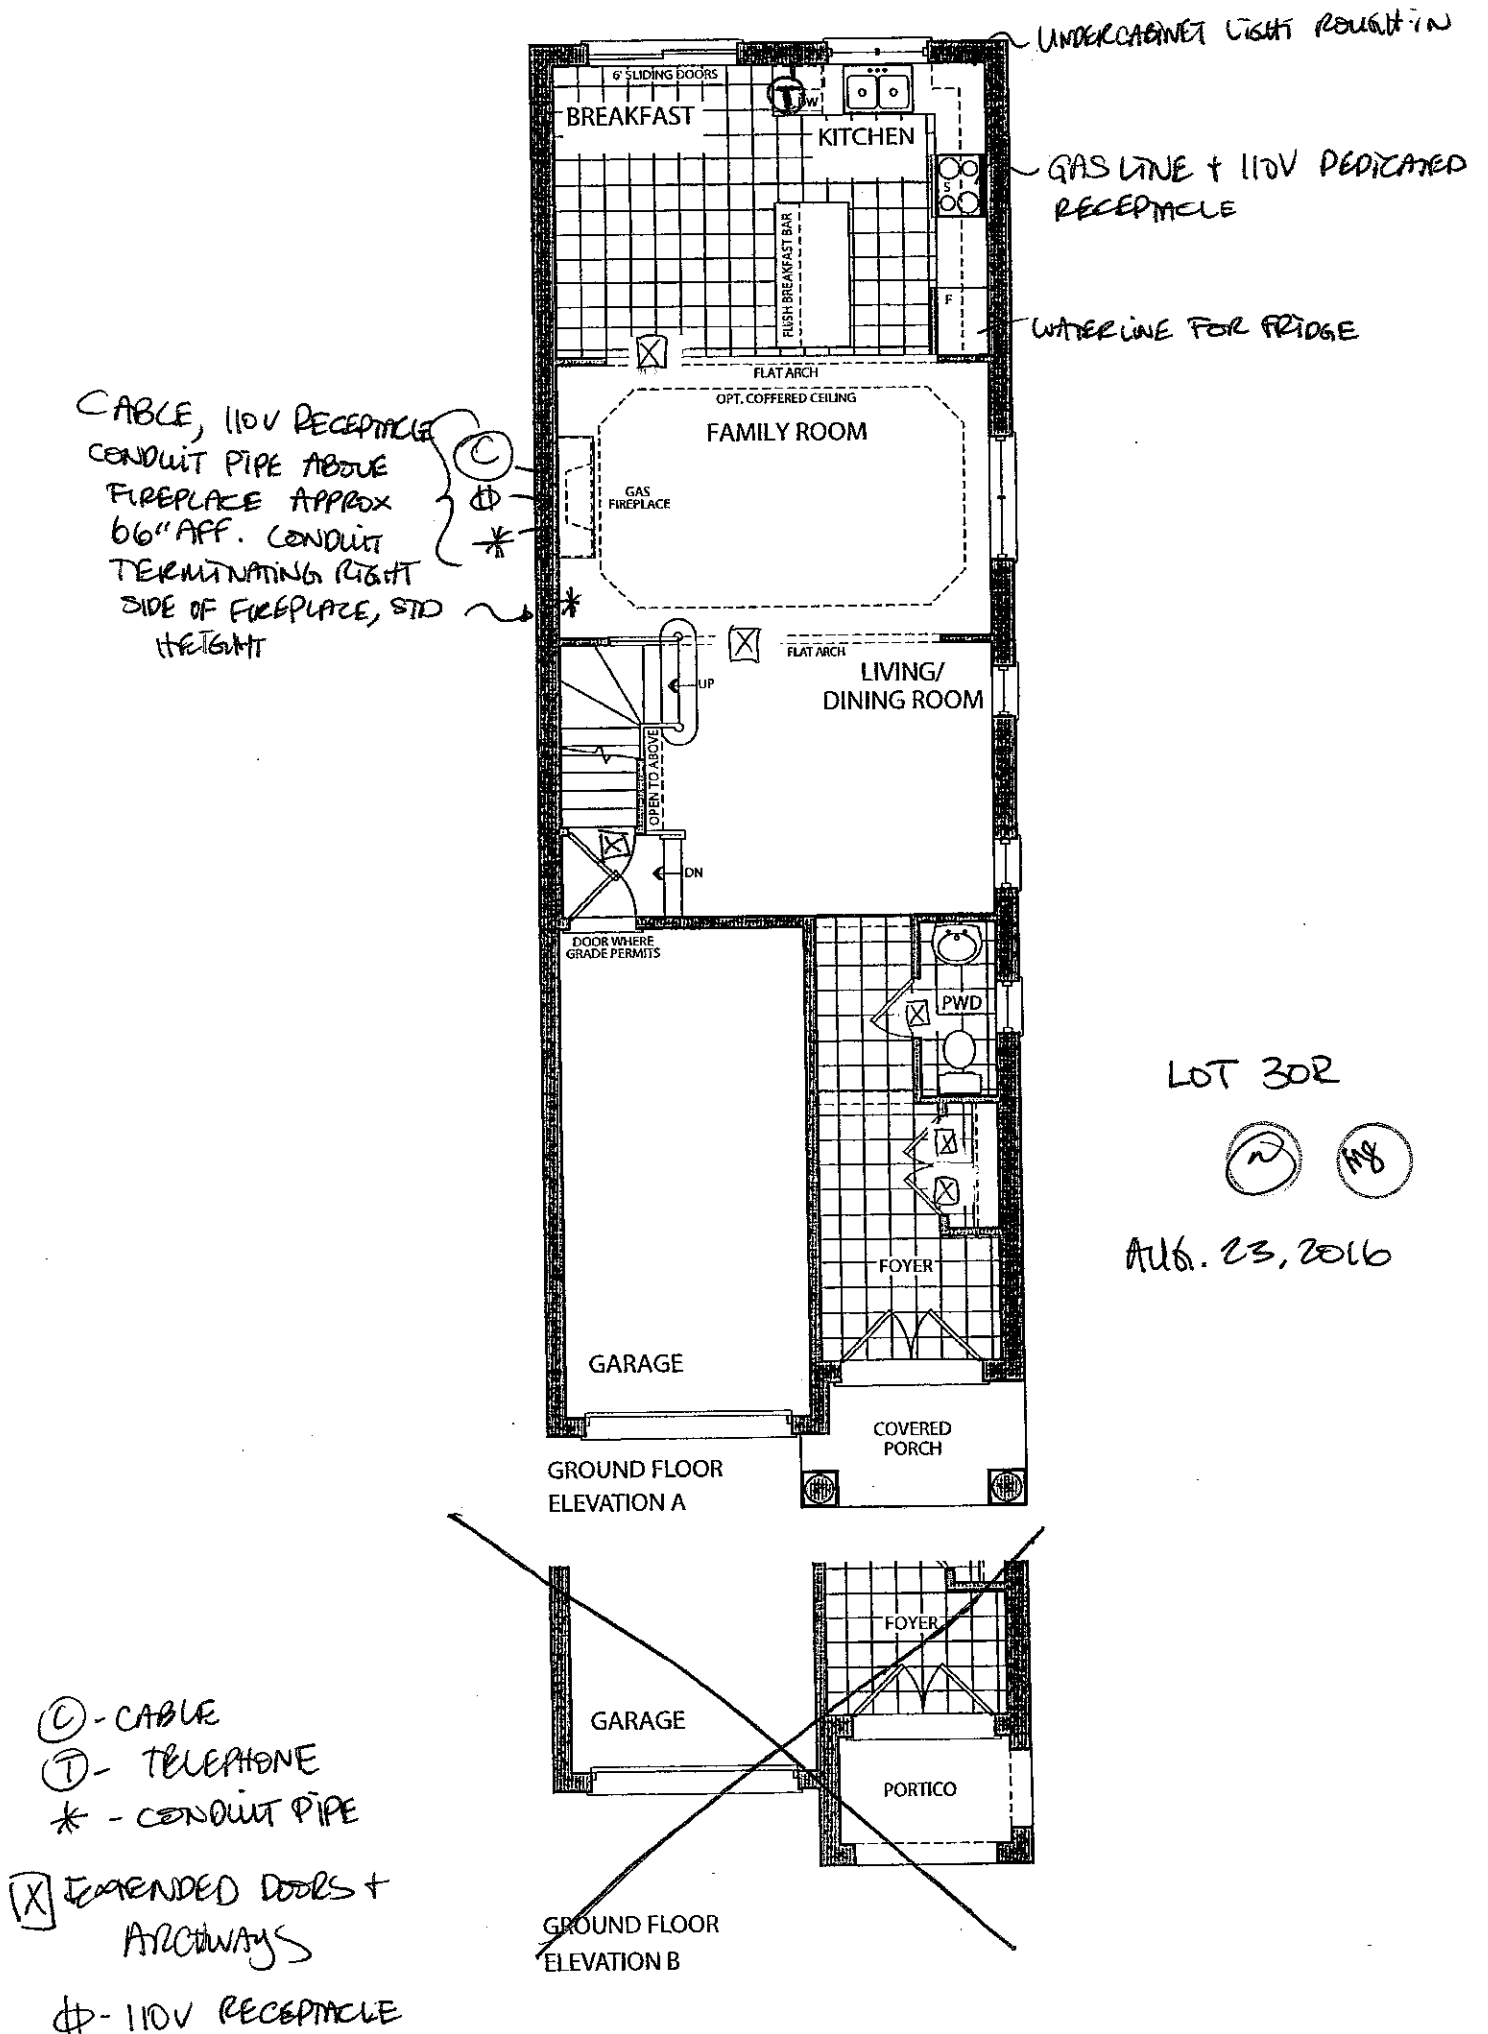

Elevation A • 1,898 sq.ft.

Elevation B • 1,898 sq.ft.

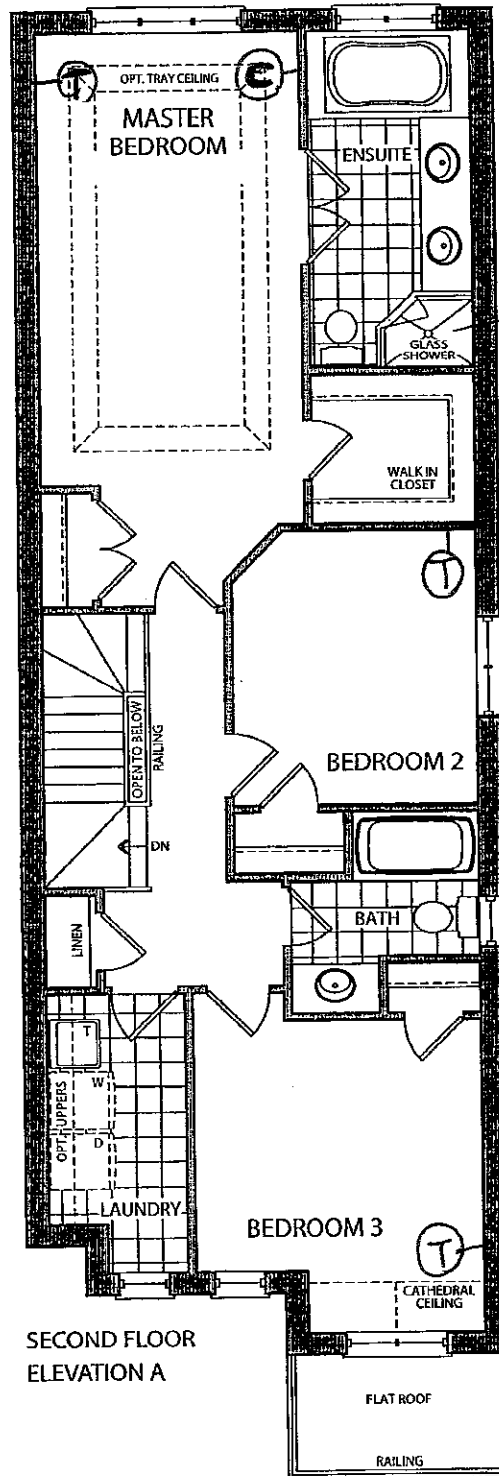


SECOND FLOOR
ELEVATION A

LOT 30R




AUG. 23, 2016

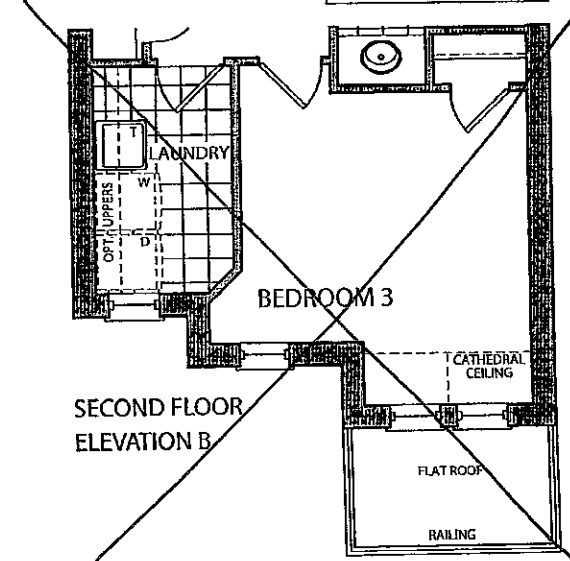

SECOND FLOOR
ELEVATION B

Elevation A • 1,898 sq.ft.


Elevation B • 1,898 sq.ft.

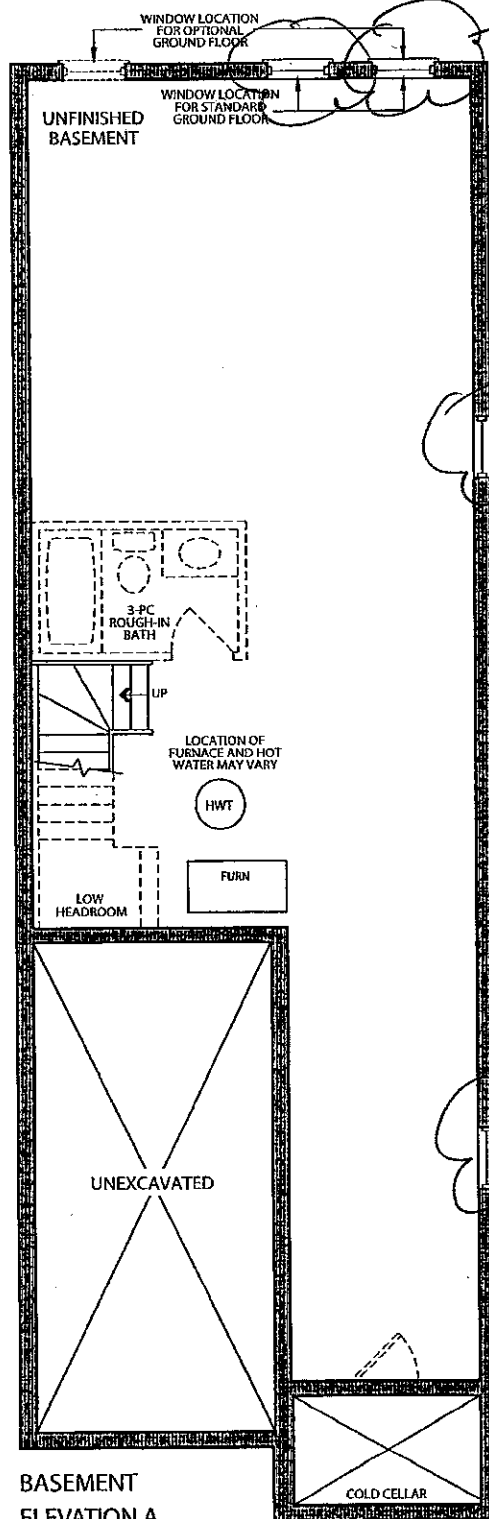

UPG WINDOWS
TO 30"x24"
COLOUR MATCHED


UPG WINDOWS
TO 30"x24"
WHITE FRAME

LOT 30R

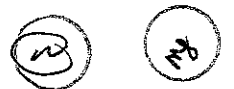

AUG. 23. 2016

BASEMENT
ELEVATION A

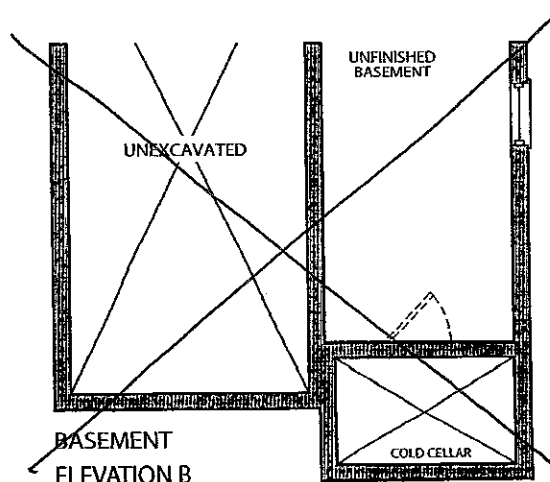

BASEMENT
ELEVATION B



Stacey Carlete
Project Coordinator



Claude Azzopardi
Contracts Manager



Nancy Martini
Corporate Controller



25.1 The Riverstone			
Elevation	Circle One	A	1812.7 Square Feet
		B	1812.7 Square Feet
Taller Ceilings	Circle All that Apply	GFTC	9' Ceilings Ground Floor
		MFTC	10' Ceilings Main Floor
		SFTC	9' Ceilings Second Floor
Optional Layouts	Circle All that Apply	GFA1	GROUND FLOOR Alternative Layout Kitchen/Family Room

25.2 The Hudson			
Elevation	Circle One	A	1860.8 Square Feet
		B	1858.6 Square Feet
Taller Ceilings	Circle All that Apply	GFTC	9' Ceilings Ground Floor
		MFTC	10' Ceilings Main Floor
		SFTC	9' Ceilings Second Floor
Optional Layouts	Circle All that Apply	GFA1	GROUND FLOOR Alternative Layout Kitchen/Family Room

25.3 The Oakmount			
Elevation	Circle One	A	2013.0 Square Feet
		B	2013.0 Square Feet
Taller Ceilings	Circle All that Apply	GFTC	9' Ceilings Ground Floor
		MFTC	10' Ceilings Main Floor
		SFTC	9' Ceilings Second Floor
Optional Layouts	Circle All that Apply	GFA1	GROUND FLOOR Alternative Layout Kitchen/Family Room
		SFA4	SECOND FLOOR Alternative Layout Laundry Room
		SFA5	SECOND FLOOR Additional Bedroom

25.4 The Stanford			
Elevation	Circle One	A	2665.6 Square Feet
		B	2665.6 Square Feet
Taller Ceilings	Circle All that Apply	GFTC	9' Ceilings Ground Floor
		MFTC	10' Ceilings Main Floor
		SFTC	9' Ceilings Second Floor
Optional Layouts	Circle All that Apply	GFA2	GROUND FLOOR Optional Piece Bathroom
		MFA1	MAIN FLOOR Alternative Layout Kitchen/Family Room
		SFA2	SECOND FLOOR Shower in Lieu of Tub (Master Ens.)
		SFA5	SECOND FLOOR Additional Bedroom

25.5 The Regency			
Elevation	Circle One	A	2924.0 Square Feet
		B	2924.0 Square Feet
Taller Ceilings	Circle All that Apply	GFTC	9' Ceilings Ground Floor
		MFTC	10' Ceilings Main Floor
		SFTC	9' Ceilings Second Floor
Optional Layouts	Circle All that Apply	GFA2	GROUND FLOOR Optional Piece Bathroom
		MFA1	MAIN FLOOR Alternative Layout Kitchen/Family Room
		SFA2	SECOND FLOOR Shower in Lieu of Tub (Master Ens.)
		SFA5	SECOND FLOOR Additional Bedroom

25.6 The Lincoln			
Elevation	Circle One	A	3021.0 Square Feet
		B	3014.0 Square Feet
Taller Ceilings	Circle All that Apply	GFTC	9' Ceilings Ground Floor
		MFTC	10' Ceilings Main Floor
		SFTC	9' Ceilings Second Floor
Optional Layouts	Circle All that Apply	GFA2	GROUND FLOOR Optional Piece Bathroom
		MFA1	MAIN FLOOR Alternative Layout Kitchen/Family Room

25.7 The Carnegie			
Elevation	Circle One	A	3150.8 Square Feet
		B	3150.8 Square Feet
Taller Ceilings	Circle All that Apply	GFTC	9' Ceilings Ground Floor
		MFTC	10' Ceilings Main Floor
		SFTC	9' Ceilings Second Floor
Optional Layouts	Circle All that Apply	GFA2	GROUND FLOOR Optional Piece Bathroom
		MFA1	MAIN FLOOR Alternative Layout Kitchen/Family Room
		SFA1	SECOND FLOOR Shower in Lieu of Tub (Bedroom 2)

25.8 The Biltmore			
Elevation	Circle One	A	1980.8 Square Feet
		B	1989.3 Square Feet
Taller Ceilings	Circle All that Apply	GFTC	9' Ceilings Ground Floor
		MFTC	10' Ceilings Main Floor
		SFTC	9' Ceilings Second Floor
Optional Layouts	Circle All that Apply		

Elevation	Circle One		
Taller Ceilings	Circle All that Apply		
Optional Layouts	Circle All that Apply		

Elevation	Circle One		
Taller Ceilings	Circle All that Apply		
Optional Layouts	Circle All that Apply		

LOT 30R



AUG. 23. 2016