

Kleinburg Glen - 33R - 1 - 25-1 Elev.A RIVERSTONE OPT- GFA1
CENTRAL VAC AND WIRING

Inv.706	1 - FAMILY ROOM: CONDUIT PIPE - FOR TELEVISION - OVER FIREPLACE. APPROX 66" AFF. TERMINATING LEFT OF FIREPLACE - STANDARD HEIGHT. PLEASE SEE FLOORPLAN FOR LOCATION
Line9435	Note:
27Jul16 / 1Nov16	
Inv.706	2 - LAUNDRY & MASTER BEDROOM: ROUGH - IN FOR EXTRA SECURITY KEY PAD. PLEASE SEE FLOORPLAN FOR LOCATIONS
Line9439	Note:
27Jul16 / 1Nov16	
Inv.706	1 - CONDUIT PIPE - FROM ATTIC TO ELECTRICAL PANEL - STRAIGHT RUN FROM ELECTRICAL PANEL TO ATTIC
Line9434	Note:
27Jul16 / 1Nov16	
Inv.706	1 - MAIN FLOOR: CAT 5 WIRING - ADD EXTRA OUTLET LEFT OF FIREPLACE NEXT TO CONDUIT TERMINATION POINT. PLEASE SEE FLOORPLAN FOR LOCATION
Line9449	Note:
27Jul16 / 1Nov16	
Inv.706	1 - FAMILY ROOM: ROUGH - IN FIBER OPTIC CABLE - HOME RUN TO ELECTRICAL PANEL - NEXT TO CONDUIT PIPE TERMINATION POINT. PLEASE SEE FLOORPLAN FOR LOCATION
Line9717	Note:
27Jul16 / 1Nov16	

DRYWALL

Inv.706	1 - SMOOTH CEILINGS - (2 - Story Design) SECOND FLOOR
Line9448	Note:
27Jul16 / 1Nov16	

ELECTRICAL

Inv.706	4 - FAMILY ROOM: 4 X POT LIGHTS: 4 INCH HALOGEN POT LIGHT - 440 WH - PRICED PER LIGHT - ON A SEPARATE SWITCH. PLEASE SEE FLOORPLAN FOR LOCATION
Line9431	Note:
27Jul16 / 1Nov16	
Inv.706	1 - POWDER ROOM: DELETE STANDARD VANITY LIGHT AND ADD STANDARD CEILING FIXTURE CENTERED IN POWDER ROOM ON SAME SWITCH
Line9433	Note:
27Jul16 / 1Nov16	
Inv.706	1 - KITCHEN: 110V WALL RECEPTACLE ON DEDICATED CIRCUIT - GAS FIRED APPLIANCE - FOR AUX. EQUIPMENT - NOT A STOVE PLUG
Line9425	Note:
27Jul16 / 1Nov16	
Inv.706	5 - KITCHEN: POT LIGHT: 4 INCH HALOGEN POT LIGHT - 440 WH - PRICED PER LIGHT. 5 IN KITCHEN 1 OVER SINK WITH A SWITCH, 4 AROUND CABINETS. WITH A SWITCH. PLEASE SEE FLOORPLAN FOR LOCATION
Line9427	Note:
27Jul16 / 1Nov16	
Inv.706	1 - KITCHEN: RELOCATE STANDARD KITCHEN LIGHT OVER ISLAND, RIGHT SIDE.
Line9429	Note:
27Jul16 / 1Nov16	

Kleinburg Glen - 33R - 1 - 25-1 Elev.A RIVERSTONE OPT- GFA1

Inv.706	2 - KITCHEN: 2 SWITCHES (WITH COVER PLATE) - DOES NOT INCLUDE FIXTURE FOR POTLIGHTS. 1 POTLIGHT OVER SINK, SWITCH OVER DISHWASHER, 4 POTLIGHTS AROUND CABINETS, SWITCH ON BREAKFAST WALL GANG. PLEASE SEE FLOORPLAN FOR LOCATION.
Line9428	Note:
27Jul16 / 1Nov16	
Inv.706	1 - KITCHEN: ROUGH - IN CEILING OUTLET ON SAME SWITCH WITH OTHER ISLAND LIGHT - DOES NOT INCLUDE FIXTURE - RIGHT SIDE OF ISLAND. PLEASE SEE FLOORPLAN FOR LOCATION.
Line9430	Note:
27Jul16 / 1Nov16	
Inv.706	1 - FAMILY ROOM: SEPARATE SWITCH (WITH COVER PLATE) - FOR POTLIGHTS - PLEASE SEE FLOORPLAN FOR LOCATION
Line9432	Note:
27Jul16 / 1Nov16	
Inv.706	1 - FAMILY ROOM: 110V WALL RECEPTACLE ON NORMAL CIRCUIT - OVER FIREPLACE FOR FUTURE TV. APPROX 66" AFF. PLEASE SEE FLOORPLAN FOR LOCATION
Line9436	Note:
27Jul16 / 1Nov16	
Inv.706	1 - MASTER ENSUITE: ADDITIONAL POT LIGHT: 6 INCH RECESSED SHOWER POT LIGHT. ONE ON EITHER SIDE OF RAIN SHOWER ROUGH-IN
Line9447	Note:
27Jul16 / 1Nov16	
Inv.706	4 - MAIN FLOOR HALLWAY: DELETE STANDARD HALLWAY LIGHT AND ADD 4 POT LIGHTS 4 INCH HALOGEN POT LIGHT - 440 WH - ON SAME SWITCH PRICED PER LIGHT - Please see floorplan for locations
Line9450	Note:
27Jul16 / 1Nov16	
Inv.706	1 - ADDITIONAL EXTERIOR COACH LIGHT ON SAME SWITCH (BUILDER STANDARD FIXTURE) - ONE ON EITHER SIDE OF GARAGE. Please see floor plan for location
Line9452	Note:
27Jul16 / 1Nov16	
Inv.706	1 - MASTER ENSUITE: DELETE TUB AND ADD FULL WIDTH SHOWER IN LIEU OF TUB – 10MM FRAMELESS GLASS WITH POTLIGHT
Line13288	Note:
27Jul16 / 1Nov16	

EXTERIOR COLOURS

Inv.706	1 - EXTERIOR COLOUR PACKAGE 9
Line13286	Note:
27Jul16 / 1Nov16	

FRAMING

Inv.706	1 - MASTER ENSUITE: DELETE TUB AND INSTALL FULL WIDTH FRAMELESS SHOWER. RELOCATE TOILET AND DELETE ONE DOOR TO ACCOMMODATE NEW VENT LOCATION. **Center vanity and vanity lights in new space.
Line9444	Note:
27Jul16 / 1Nov16	
Inv.706	1 - MAIN FLOOR: EXTENDED HEIGHT ARCHWAY (PRICE PER DOORWAY)
Line12411	Note:
27Jul16 / 1Nov16	

Kleinburg Glen - 33R - 1 - 25-1 Elev.A RIVERSTONE OPT- GFA1

Inv.706	1 - MAIN FLOOR: STANDARD DOOR EXTENDED HEIGHT 96 INCH (PRICE PER DOOR) - GROUND FLOOR 2 STOREY MODELS
Line12412	Note:
27Jul16 / 1Nov16	
Inv.706	1 - OPTIONAL GROUND FLOOR
Line12413	Note:
27Jul16 / 1Nov16	
Inv.935	1 - OPTIONAL GROUND FLOOR
Line13290	Note:
1Nov16 / 1Nov16	

GLASS AND MIRROR

Inv.706	1 - MASTER ENSUITE: DELETE TUB AND ADD FULL WIDTH SHOWER IN LIEU OF TUB – 10MM FRAMELESS GLASS WITH POTLIGHT
Line9443	Note:
27Jul16 / 1Nov16	

HVAC

Inv.706	1 - KITCHEN: UPGRADE VENTING FOR STOVE TO 8 INCH PIPE EXTERIOR WALL CENTERED OVER OVEN TO ACCOMMODATE CHIMNEY STYLE HOOD FAN
Line9423	Note:
27Jul16 / 1Nov16	
Inv.706	1 - KITCHEN: GAS LINE ROUGH - GROUND FLOOR FOR FUTURE GAS RANGE
Line9424	Note:
27Jul16 / 1Nov16	

INTERIOR TRIM AND DOORS

Inv.706	2 - MAIN FLOOR: EXTENDED HEIGHT ARCHWAY (PRICE PER DOORWAY)
Line9437	Note:
27Jul16 / 1Nov16	
Inv.706	6 - MAIN FLOOR: STANDARD DOOR EXTENDED HEIGHT 96 INCH (PRICE PER DOOR) - GROUND FLOOR 2 STOREY MODELS
Line9438	Note:
27Jul16 / 1Nov16	

MISC.

Inv.706	1 - Purchaser has attended a Structural appointment at the Decor Centre & has DECLINED any additional upgrades and accepts and acknowledges that there will be no further structural changes/additions/deletions to be made upon signing on July 27, 2016.
Line9453	Note:
27Jul16 / 1Nov16	
Inv.706	1 - Purchasers are aware & accepts that ANY changes made to upgrades after signing this Purchasers Extra Form are subject to a minimum administration fee of \$500. PLUS a 10% holdback fee.
Line9454	Note:
27Jul16 / 1Nov16	
Inv.706	1 - BONUS PACKAGE: \$5,000.00 (INCLUDING TAXES) WORTH OF UPGRADES FROM GOLD PARK HOMES DÉCOR CENTRE IS BEING APPLIED TOWARD THE STRUCTURAL APPOINTMENT. PURCHASER HAS A REMAINING AMOUNT OF \$00 (INCLUDING TAXES) TO BE USED TOWARD THE COLOUR APPOINTMENT.
Line9455	Note:
27Jul16 / 1Nov16	

Kleinburg Glen - 33R - 1 - 25-1 Elev.A RIVERSTONE OPT- GFA1

Inv.706	1 - BALANCE AFTER CREDIT: \$17,588.70
	50% DEPOSIT PAID BY VISA: \$ 8,794.35
	50% BALANCE ON CLOSING: \$ 8,794.35
Line9456	Note: 50% Deposit x2 Visa Transactions: \$8,768.93 + \$25.42
27Jul16 / 1Nov16	

PLUMBING

Inv.706	1 - MASTER ENSUITE: ROUGH - IN FOR RAINSHOWER HEAD - SHOWER HEAD NOT INCLUDED AND MUST BE PURCHASED
Line9445	Note:
27Jul16 / 1Nov16	

Inv.706	1 - MASTER ENSUITE TRENCH DRAIN APPROX 6 INCH SQUARE - TILED DRAIN - ACO 37239
Line9446	Note:
27Jul16 / 1Nov16	

Inv.706	1 - MASTER ENSUITE: DELETE TUB AND INSTALL FULL WIDTH FRAMELESS SHOWER. RELOCATE TOILET AND DELETE ONE DOOR TO ACCOMMODATE NEW VENT LOCATION. **Center vanity and vanity lights in new space.
Line13289	Note:
27Jul16 / 1Nov16	

WINDOWS - BASEMENT


Inv.706	2 - BASEMENT WINDOWS - UPGRADE EXISTING BASEMENT WINDOW TO 30 INCH X 16 INCH. 2 BACK WINDOWS. PLEASE SEE FLOORPLAN FOR LOCATION
Line9441	Note:
27Jul16 / 1Nov16	

Inv.706	1 - BASEMENT WINDOWS - UPGRADE EXISTING BASEMENT WINDOW TO 53 INCH X 16 INCH - MAY REQUIRE INSTALLATION OF WINDOW WELL. SIDE WINDOW. PLEASE SEE FLOORPLAN FOR LOCATION
Line9440	Note:
27Jul16 / 1Nov16	

Inv.706	3 - BASEMENT WINDOWS: UPGRADED WINDOWS TO BE COLOUR MATCHED
Line9442	Note:
27Jul16 / 1Nov16	

Elevation A • 1,849 sq.ft.

Elevation B • 1,849 sq.ft.

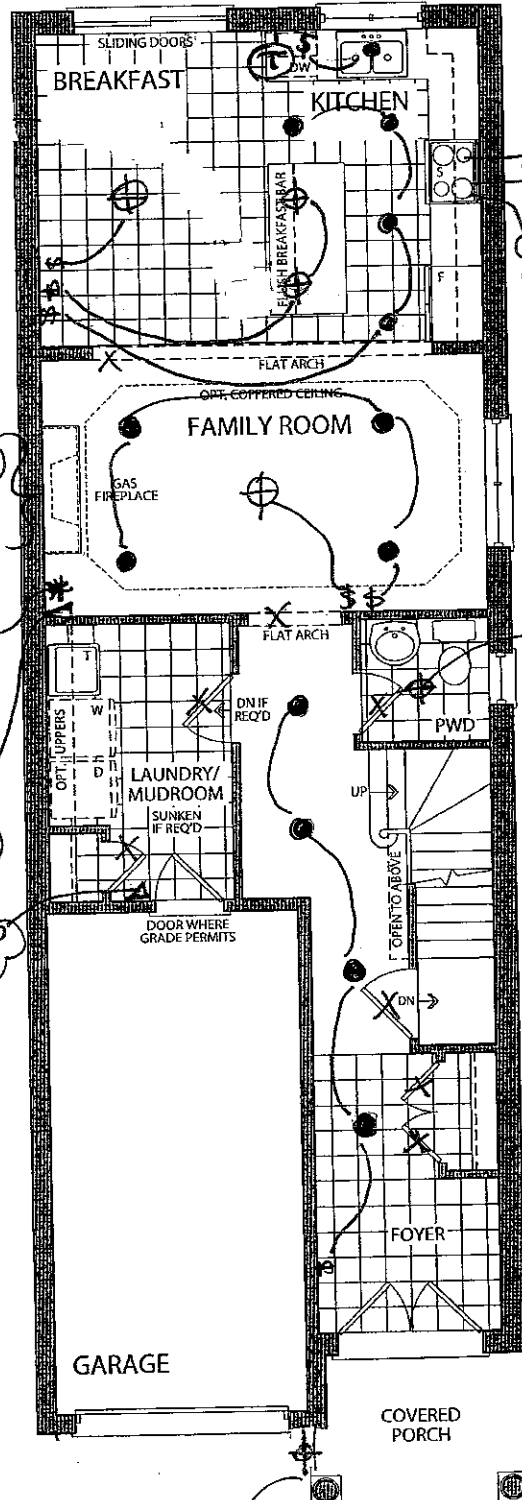

GAS LINE
110V DEDICATED RECEPTACLE FOR GAS APPLIANCE
8\"/>

CABLE, CONDUIT PIPE + 110V RECEPTACLE OVER FIREPLACE APPROX 166\"/>

CONDUIT PIPE TERMINATION STANDARD HEIGHT

ADD GAS OUTLET AT STD HEIGHT LEFT OF FIREPLACE NEXT TO CONDUIT TERMINATION

ADD FIBER OPTIC CABLE NEXT TO CONDUIT TERMINATION

SECURITY KEY AND ROUGH-IN

DELETE STD VANITY LIGHT + ADD CENTERED CEILING FIXTURE

- ⊙ - CABLE
- Ⓣ - TELEPHONE
- ⊕ - CEILING LIGHT
- - POT LIGHT
- * - CONDUIT PIPE

EXTEND ARCHWAYS + DOOR HEIGHTS

OPT. GROUND FLOOR ELEVATION A

ADD 1\"/>

LOT 33R

July 27, 2016

Aug 3 2016

GOLDPARK
HOMES

Elevation A • 1,849 sq.ft.

Elevation B • 1,849 sq.ft.

DELETE TUB +
RELOCATE TOILET

DELETE ONE DOOR
TO ACCOMMODATE NEW
VENT LOCATION


RE-CATER VANITY +
LIGHTS

ADD SQUARE
TILED TRENCH
DRAIN


ADD SHOWER
POT LIGHT. ONE
ENTER SIDE OF
RAIN SHOWER
ROUGH-IN

ADD RAIN
SHOWER ROUGH-IN

SECURITY KEY
PAD ROUGH-IN

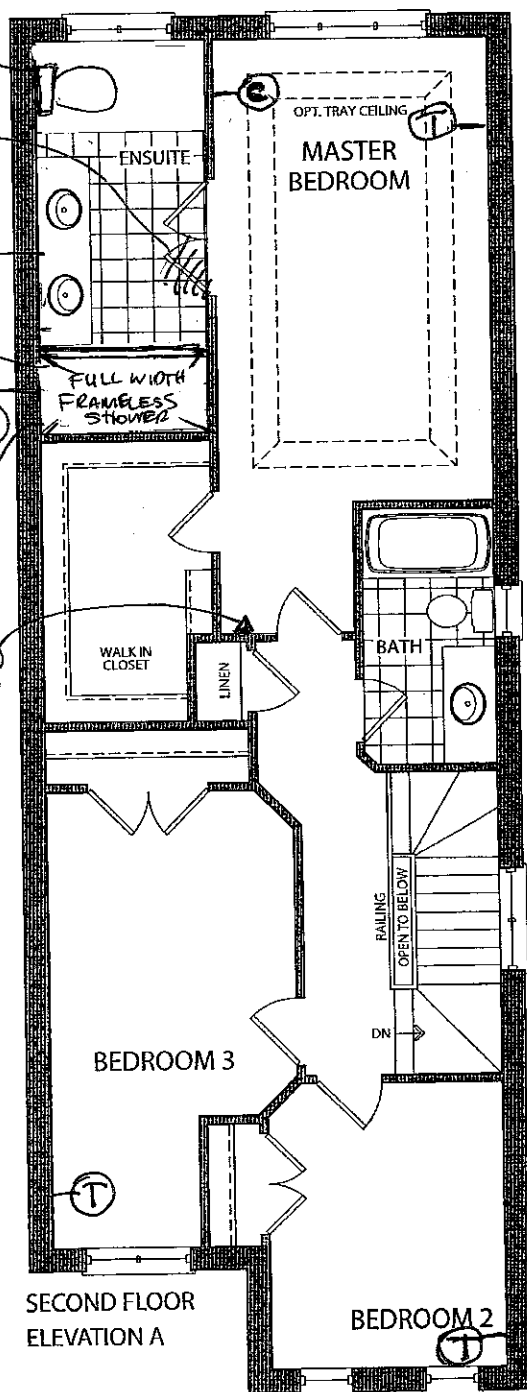

SECOND FLOOR
ELEVATION A

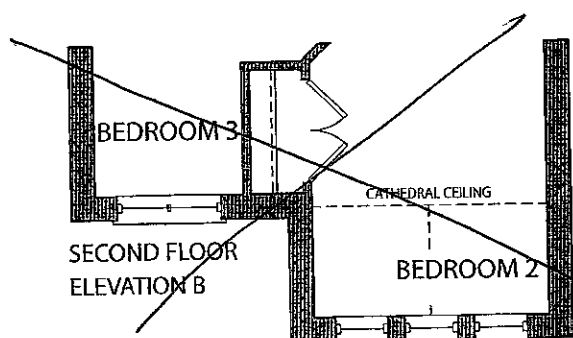

SECOND FLOOR
ELEVATION B

LOT 33R


(Handwritten signature/initials)

July 27, 2016

SMOOTH CEILINGS


Elevation A • 1,849 sq.ft.

Elevation B • 1,849 sq.ft.

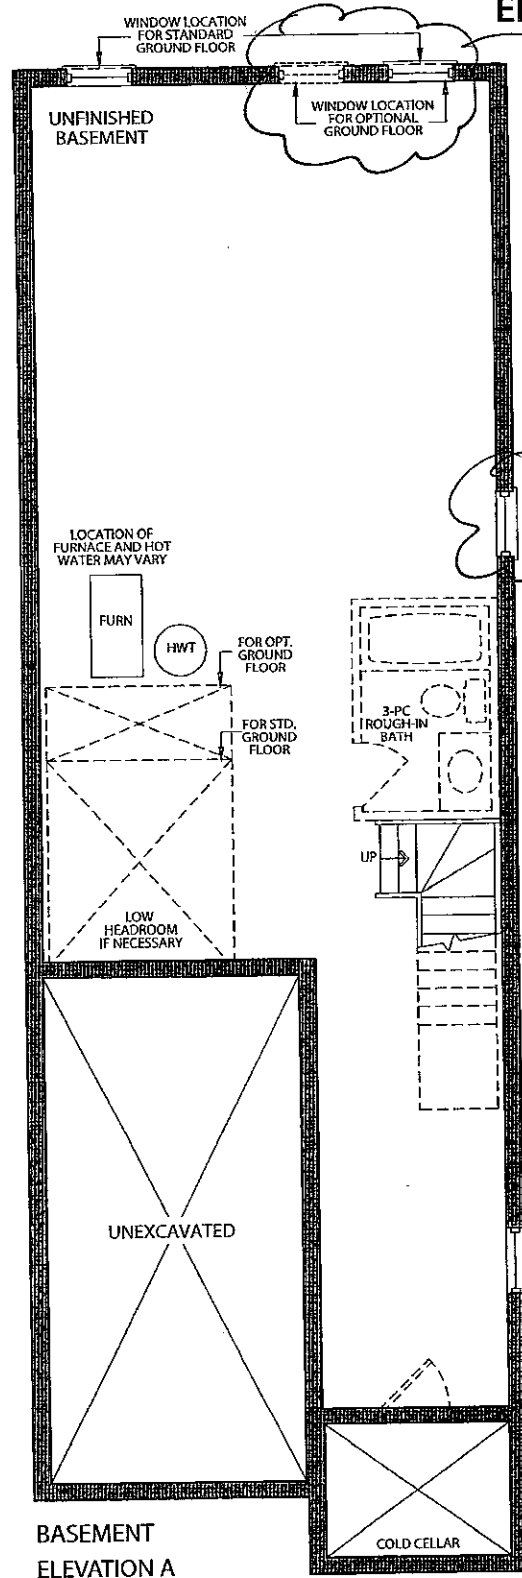

UPGRADE TO 30"x16" COLOUR MATCHED FRAMES

UPGRADE TO 53"x16" COLOUR MATCHED FRAMES

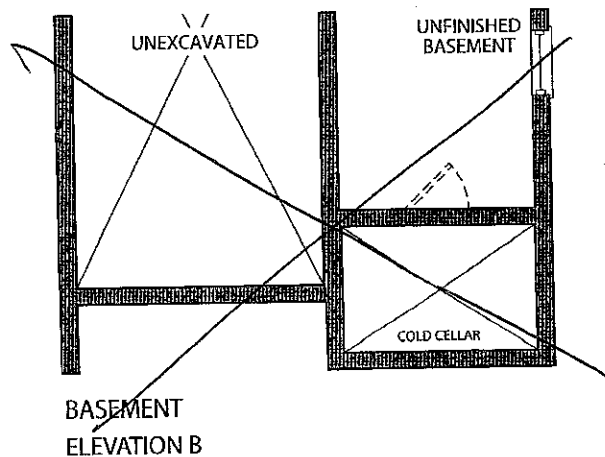

LOT 332

① ②

July 27, 2016



Stacey Carlete
Project Coordinator



Claude Azzopardi
Contracts Manager



Nancy Martini
Corporate Controller



25.1 The Riverstone			
Elevation	Circle One	A	1812.7 Square Feet
		B	1812.7 Square Feet
Taller Ceilings	Circle All that Apply	GFTC	9' Ceilings Ground Floor
		MFTC	10' Ceilings Main Floor
		SFTC	9' Ceilings Second Floor
Optional Layouts	Circle All that Apply	GFA1	GROUND FLOOR Alternative Layout Kitchen/Family Room

25.2 The Hudson			
Elevation	Circle One	A	1860.8 Square Feet
		B	1858.6 Square Feet
Taller Ceilings	Circle All that Apply	GFTC	9' Ceilings Ground Floor
		MFTC	10' Ceilings Main Floor
		SFTC	9' Ceilings Second Floor
Optional Layouts	Circle All that Apply	GFA1	GROUND FLOOR Alternative Layout Kitchen/Family Room

25.3 The Oakmount			
Elevation	Circle One	A	2013.0 Square Feet
		B	2013.0 Square Feet
Taller Ceilings	Circle All that Apply	GFTC	9' Ceilings Ground Floor
		MFTC	10' Ceilings Main Floor
		SFTC	9' Ceilings Second Floor
Optional Layouts	Circle All that Apply	GFA1	GROUND FLOOR Alternative Layout Kitchen/Family Room
		SFA4	SECOND FLOOR Alternative Layout Laundry Room
		SFA5	SECOND FLOOR Additional Bedroom

25.4 The Stanford			
Elevation	Circle One	A	2665.6 Square Feet
		B	2665.6 Square Feet
Taller Ceilings	Circle All that Apply	GFTC	9' Ceilings Ground Floor
		MFTC	10' Ceilings Main Floor
		SFTC	9' Ceilings Second Floor
Optional Layouts	Circle All that Apply	GFA2	GROUND FLOOR Optional Piece Bathroom
		MFA1	MAIN FLOOR Alternative Layout Kitchen/Family Room
		SFA2	SECOND FLOOR Shower in Lieu of Tub (Master Ens.)
		SFA5	SECOND FLOOR Additional Bedroom

25.5 The Regency			
Elevation	Circle One	A	2924.0 Square Feet
		B	2924.0 Square Feet
Taller Ceilings	Circle All that Apply	GFTC	9' Ceilings Ground Floor
		MFTC	10' Ceilings Main Floor
		SFTC	9' Ceilings Second Floor
Optional Layouts	Circle All that Apply	GFA2	GROUND FLOOR Optional Piece Bathroom
		MFA1	MAIN FLOOR Alternative Layout Kitchen/Family Room
		SFA2	SECOND FLOOR Shower in Lieu of Tub (Master Ens.)
		SFA5	SECOND FLOOR Additional Bedroom

25.6 The Lincoln			
Elevation	Circle One	A	3021.0 Square Feet
		B	3014.0 Square Feet
Taller Ceilings	Circle All that Apply	GFTC	9' Ceilings Ground Floor
		MFTC	10' Ceilings Main Floor
		SFTC	9' Ceilings Second Floor
Optional Layouts	Circle All that Apply	GFA2	GROUND FLOOR Optional Piece Bathroom
		MFA1	MAIN FLOOR Alternative Layout Kitchen/Family Room

25.7 The Carnegie			
Elevation	Circle One	A	3150.8 Square Feet
		B	3150.8 Square Feet
Taller Ceilings	Circle All that Apply	GFTC	9' Ceilings Ground Floor
		MFTC	10' Ceilings Main Floor
		SFTC	9' Ceilings Second Floor
Optional Layouts	Circle All that Apply	GFA2	GROUND FLOOR Optional Piece Bathroom
		MFA1	MAIN FLOOR Alternative Layout Kitchen/Family Room
		SFA1	SECOND FLOOR Shower in Lieu of Tub (Bedroom 2)

25.8 The Biltmore			
Elevation	Circle One	A	1980.8 Square Feet
		B	1989.3 Square Feet
Taller Ceilings	Circle All that Apply	GFTC	9' Ceilings Ground Floor
		MFTC	10' Ceilings Main Floor
		SFTC	9' Ceilings Second Floor
Optional Layouts	Circle All that Apply		

Elevation	Circle One		
Taller Ceilings	Circle All that Apply		
Optional Layouts	Circle All that Apply		

Elevation	Circle One		
Taller Ceilings	Circle All that Apply		
Optional Layouts	Circle All that Apply		

LOT 33R

July 27, 2016