



CONSTRUCTION SUMMARY

Kleinburg Glen - 35L - 1 - 25-3 Elev.B OAKMOUNT OPT- SFA4
CENTRAL VAC AND WIRING

Inv.690	1 - MUD ROOM: ROUGH - IN FOR EXTRA SECURITY KEY PAD
Line9152	Note:
25Jul16 / 1Nov16	
Inv.690	1 - FAMILY ROOM: CONDUIT PIPE - FOR TELEVISION - Locate approx. 66" A.F.F. above fireplace, terminating left of fireplace by cable outlet. See plan for location
Line9153	Note:
25Jul16 / 1Nov16	

ELECTRICAL

Inv.690	1 - FAMILY ROOM: 110V WALL RECEPTACLE ON NORMAL CIRCUIT - Locate approx. 66" A.F.F Above fireplace for future TV. See sketch for location.
Line9154	Note:
25Jul16 / 1Nov16	
Inv.690	1 - KITCHEN CABINET STRIP VALANCE LIGHTS (UNDER CABINETS) - ROUGH - IN - DOES NOT INCLUDE (AND REQUIRES) KITCHEN UPGRADE PRICING
Line9155	Note:
25Jul16 / 1Nov16	
Inv.690	1 - KITCHEN: 110V WALL RECEPTACLE ON DEDICATED CIRCUIT - FOR MICROWAVE - MICROWAVE NOT INCLUDED. See plan for location - below counter top
Line9156	Note:
25Jul16 / 1Nov16	
Inv.690	2 - KITCHEN: ROUGH - IN CEILING OUTLET ON SAME SWITCH - DOES NOT INCLUDE FIXTURE - Locate above island, see plan for location (in addition to builder's standard ceiling light)
Line9158	Note:
25Jul16 / 1Nov16	
Inv.690	1 - KITCHEN: Single pole switch for lights above island. See plan for location (note: revised location island)
Line9159	Note:
25Jul16 / 1Nov16	

EXTERIOR COLOURS

Inv.690	1 - EXTERIOR COLOUR PACKAGE 6
Line13260	Note:
25Jul16 / 1Nov16	

FRAMING

Inv.690	1 - MASTER ENSUITE: *REVISE LAYOUT* Delete tub, move toilet, recenter vanity in space & increase shower to full width of bathroom. See plan for location.
Line9160	Note:
25Jul16 / 1Nov16	
Inv.690	1 - MASTER ENSUITE: SHOWER STALL SHAMPOO SHELF
Line9163	Note:
25Jul16 / 1Nov16	
Inv.690	1 - MAN DOOR GARAGE TO HOUSE - OPTIONAL - IF GRADE PERMITS
Line13265	Note:
25Jul16 / 1Nov16	
Inv.771	1 - OPTIONAL SECOND FLOOR LAUNDRY
Line13267	Note:
18Aug16 / 1Nov16	

Kleinburg Glen - 35L - 1 - 25-3 Elev.B OAKMOUNT OPT- SFA4

GARAGE DOORS

Inv.690	1 - GARAGE DOOR OPENER - WITH 1 REMOTE - PRICE IS PER DOOR
Line9164	Note:
25Jul16 / 1Nov16	
Inv.690	1 - EXTRA REMOTE CONTROL FOR GARAGE DOOR
Line9165	Note:
25Jul16 / 1Nov16	
Inv.690	1 - DIGITAL ENTRY KEYPAD
Line9166	Note:
25Jul16 / 1Nov16	

GLASS AND MIRROR

Inv.690	1 - MASTER ENSUITE: CONVERT FRAMED SHOWER TO 10MM FRAMLESS SHOWER ENCLOSURE WITH DOOR AND 10MM SIDE PANEL
Line9161	Note:
25Jul16 / 1Nov16	

HVAC

Inv.771	1 - OPTIONAL SECOND FLOOR LAUNDRY
Line13269	Note:
18Aug16 / 1Nov16	

KITCHEN AND BATH CABINETRY

Inv.690	1 - KITCHEN: Rotate island 90*. See plan for location.
Line12417	Note:
25Jul16 / 1Nov16	
Inv.690	1 - KITCHEN: Rotate island 90*. See plan for location.
Line13261	Note:
25Jul16 / 1Nov16	
Inv.690	1 - MASTER ENSUITE: *REVISE LAYOUT* Delete tub, move toilet, recenter vanity in space & increase shower to full width of bathroom. See plan for location.
Line13262	Note:
25Jul16 / 1Nov16	

MISC.

Inv.690	1 - Purchaser has attended a Structural appointment at the Decor Centre & has DECLINED any additional upgrades and accepts and acknowledges that there will be no further structural changes/additions/deletions to be made upon signing on July 25, 2016.
Line9167	Note:
25Jul16 / 1Nov16	
Inv.690	1 - Purchasers are aware & accepts that ANY changes made to upgrades after signing this Purchasers Extra Form are subject to a minimum administration fee of \$500. PLUS a 10% holdback fee.
Line9168	Note:
25Jul16 / 1Nov16	
Inv.690	1 - BONUS PACKAGE: \$5,000.00 (INCLUDING TAXES) WORTH OF UPGRADES FROM GOLD PARK HOMES DÉCOR CENTRE IS BEING APPLIED TOWARD THE STRUCTURAL APPOINTMENT. PURCHASER HAS A REMAINING AMOUNT OF \$00 (INCLUDING TAXES) TO BE USED TOWARD THE COLOUR APPOINTMENT.
Line9169	Note:
25Jul16 / 1Nov16	



CONSTRUCTION SUMMARY

Kleinburg Glen - 35L - 1 - 25-3 Elev.B OAKMOUNT OPT- SFA4

PLUMBING


Inv.690	1 - KITCHEN: Rotate island 90*. See plan for location.
Line9157	Note:
25Jul16 / 1Nov16	
Inv.690	1 - MASTER ENSUITE: *REVISE LAYOUT* Delete tub, move toilet, recenter vanity in space & increase shower to full width of bathroom. See plan for location.
Line12418	Note:
25Jul16 / 1Nov16	
Inv.690	1 - MASTER ENSUITE: *REVISE LAYOUT* Delete tub, move toilet, recenter vanity in space & increase shower to full width of bathroom. See plan for location.
Line13263	Note:
25Jul16 / 1Nov16	
Inv.771	1 - OPTIONAL SECOND FLOOR LAUNDRY
Line13268	Note:
18Aug16 / 1Nov16	

WINDOWS AND DOORS

Inv.690	1 - MAN DOOR GARAGE TO HOUSE - OPTIONAL - IF GRADE PERMITS
Line13264	Note:
25Jul16 / 1Nov16	

Elevation A • 2,053 sq.ft.


Elevation B • 2,053 sq.ft.

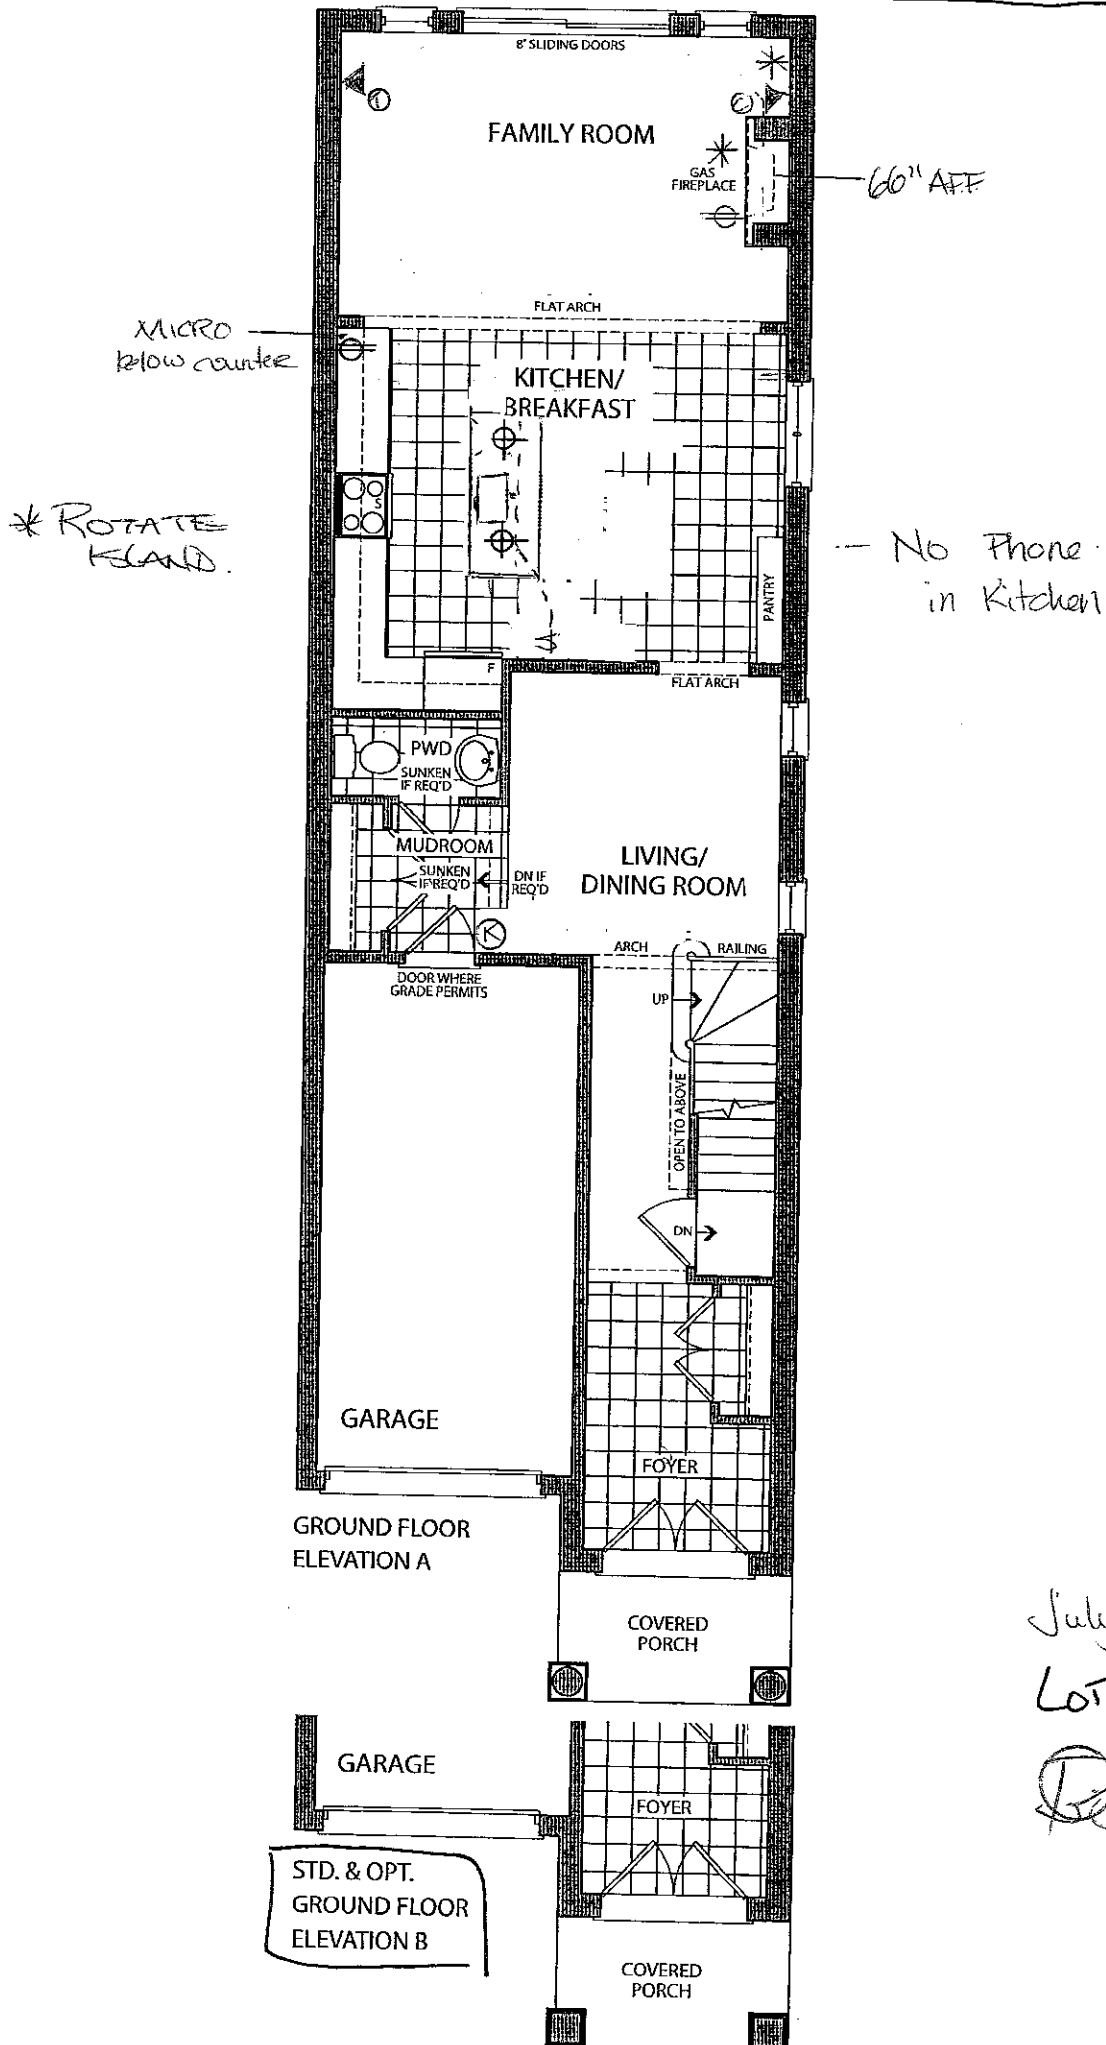


July 25 2016
Lot 35L
[Signature]

Elevation A • 2,053 sq.ft.

Elevation B • 2,053 sq.ft.

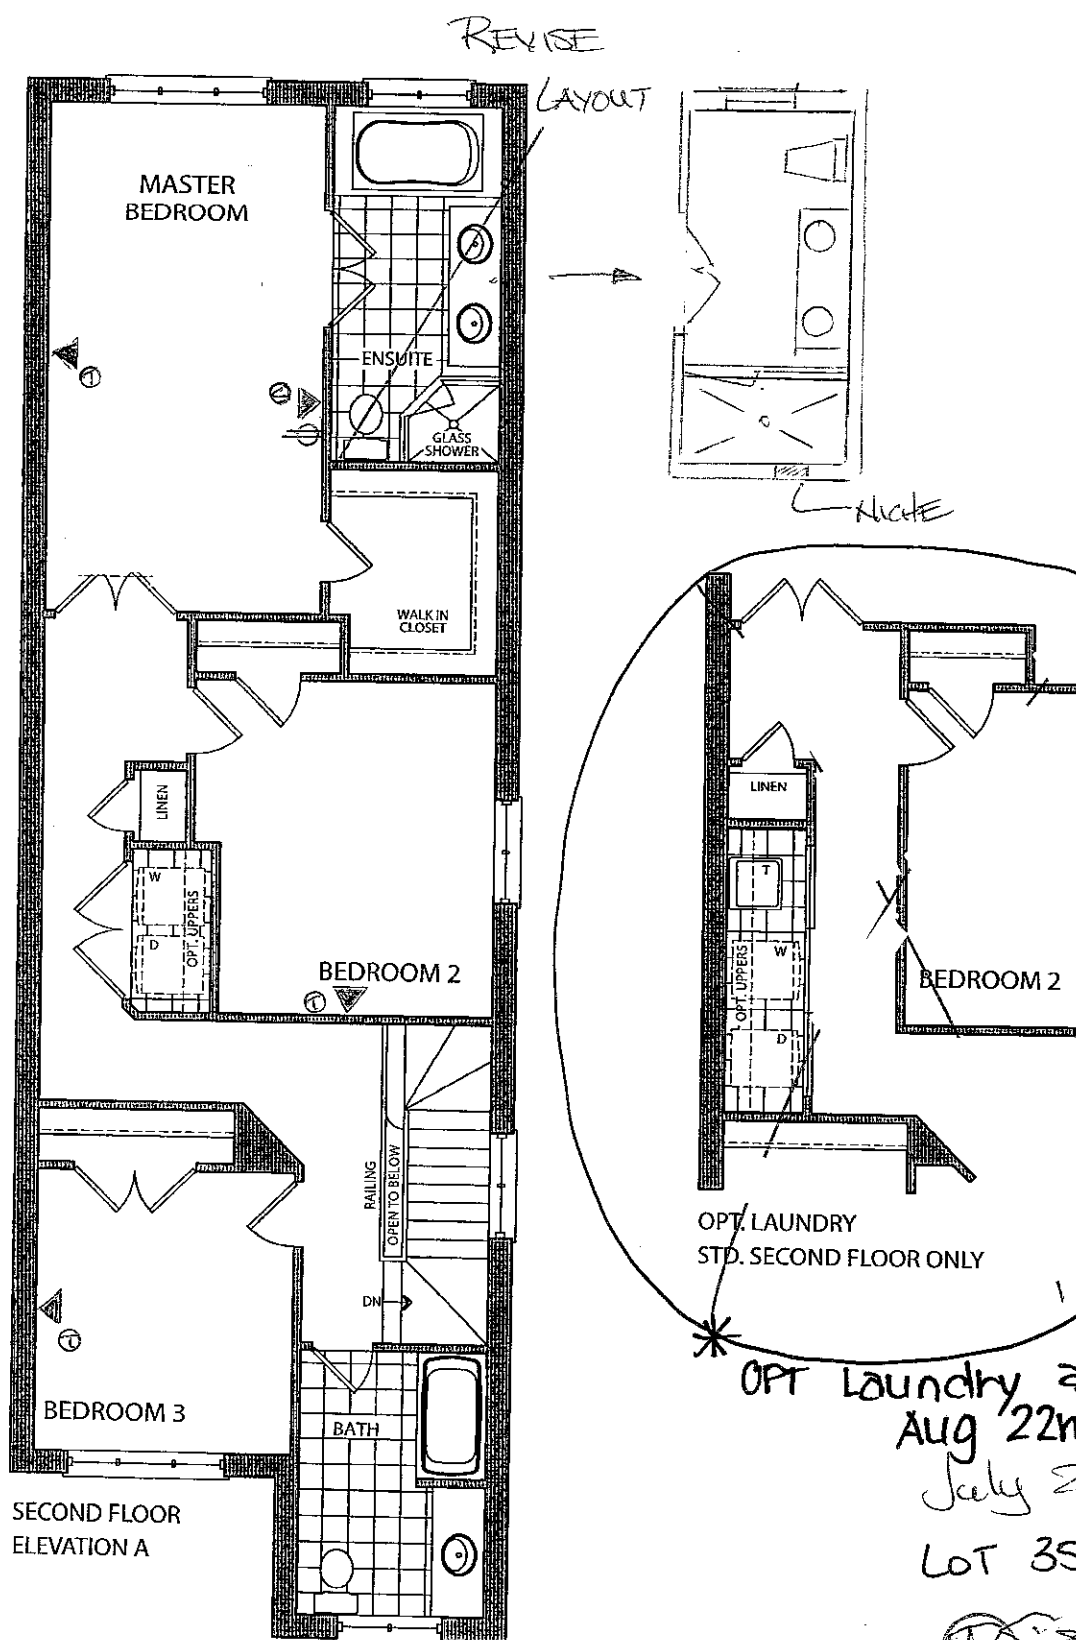

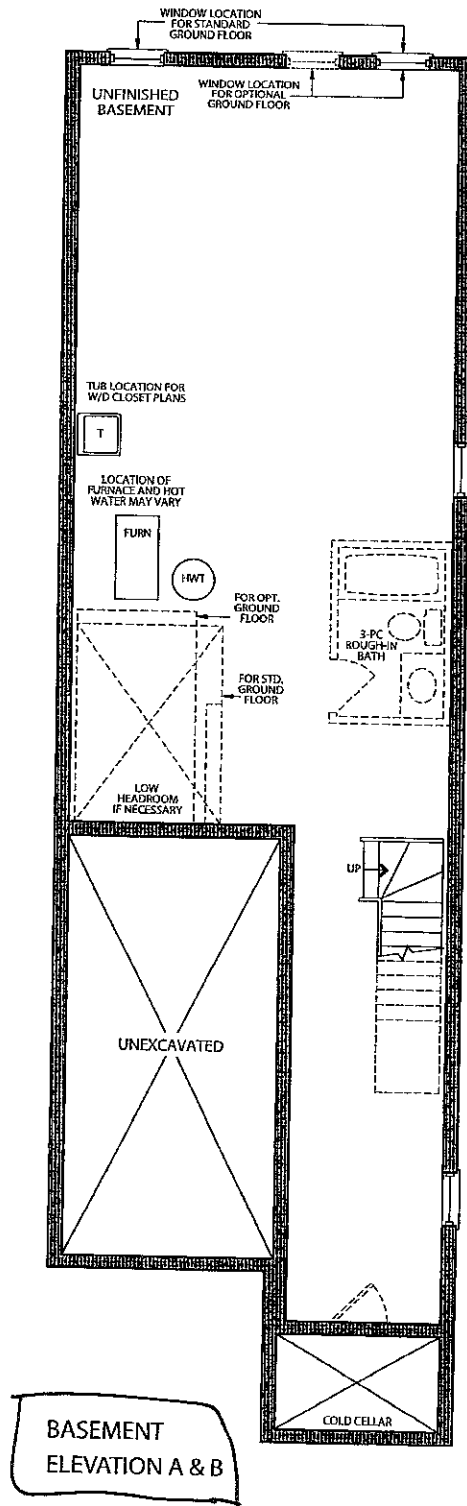

July 25 2016
LOT 3SL

[Handwritten signature]



Stacey Carlete
Project Coordinator



Claude Azzopardi
Contracts Manager



Nancy Martini
Corporate Controller



Model 25.1 The Riverstone			
Elevation	Circle One	A	1812.7 Square Feet
		B	1812.7 Square Feet
Taller Ceilings	Circle All that Apply	GFTC	9' Ceilings Ground Floor
		MFTC	10' Ceilings Main Floor
		SFTC	9' Ceilings Second Floor
Optional Layouts	Circle All that Apply	GFA1	GROUND FLOOR Alternative Layout Kitchen/Family Room

Model 25.2 The Hudson			
Elevation	Circle One	A	1860.8 Square Feet
		B	1858.6 Square Feet
Taller Ceilings	Circle All that Apply	GFTC	9' Ceilings Ground Floor
		MFTC	10' Ceilings Main Floor
		SFTC	9' Ceilings Second Floor
Optional Layouts	Circle All that Apply	GFA1	GROUND FLOOR Alternative Layout Kitchen/Family Room

Model 25.3 The Oakmount			
Elevation	Circle One	A	2013.0 Square Feet
		B	2013.0 Square Feet
Taller Ceilings	Circle All that Apply	GFTC	9' Ceilings Ground Floor
		MFTC	10' Ceilings Main Floor
		SFTC	9' Ceilings Second Floor
Optional Layouts	Circle All that Apply	GFA1	GROUND FLOOR Alternative Layout Kitchen/Family Room
		SFA4	SECOND FLOOR Alternative Layout Laundry Room
		SFA5	SECOND FLOOR Additional Bedroom

Model 25.4 The Stanford			
Elevation	Circle One	A	2665.6 Square Feet
		B	2665.6 Square Feet
Taller Ceilings	Circle All that Apply	GFTC	9' Ceilings Ground Floor
		MFTC	10' Ceilings Main Floor
		SFTC	9' Ceilings Second Floor
Optional Layouts	Circle All that Apply	GFA2	GROUND FLOOR Optional Piece Bathroom
		MFA1	MAIN FLOOR Alternative Layout Kitchen/Family Room
		SFA2	SECOND FLOOR Shower in Lieu of Tub (Master Ens.)
		SFA5	SECOND FLOOR Additional Bedroom

Model 25.5 The Regency			
Elevation	Circle One	A	2924.0 Square Feet
		B	2924.0 Square Feet
Taller Ceilings	Circle All that Apply	GFTC	9' Ceilings Ground Floor
		MFTC	10' Ceilings Main Floor
		SFTC	9' Ceilings Second Floor
Optional Layouts	Circle All that Apply	GFA2	GROUND FLOOR Optional Piece Bathroom
		MFA1	MAIN FLOOR Alternative Layout Kitchen/Family Room
		SFA2	SECOND FLOOR Shower in Lieu of Tub (Master Ens.)
		SFA5	SECOND FLOOR Additional Bedroom

Model 25.6 The Lincoln			
Elevation	Circle One	A	3021.0 Square Feet
		B	3014.0 Square Feet
Taller Ceilings	Circle All that Apply	GFTC	9' Ceilings Ground Floor
		MFTC	10' Ceilings Main Floor
		SFTC	9' Ceilings Second Floor
Optional Layouts	Circle All that Apply	GFA2	GROUND FLOOR Optional Piece Bathroom
		MFA1	MAIN FLOOR Alternative Layout Kitchen/Family Room

Model 25.7 The Carnegie			
Elevation	Circle One	A	3150.8 Square Feet
		B	3150.8 Square Feet
Taller Ceilings	Circle All that Apply	GFTC	9' Ceilings Ground Floor
		MFTC	10' Ceilings Main Floor
		SFTC	9' Ceilings Second Floor
Optional Layouts	Circle All that Apply	GFA2	GROUND FLOOR Optional Piece Bathroom
		MFA1	MAIN FLOOR Alternative Layout Kitchen/Family Room
		SFA1	SECOND FLOOR Shower in Lieu of Tub (Bedroom 2)


Model 25.8 The Biltmore			
Elevation	Circle One	A	1980.8 Square Feet
		B	1989.3 Square Feet
Taller Ceilings	Circle All that Apply	GFTC	9' Ceilings Ground Floor
		MFTC	10' Ceilings Main Floor
		SFTC	9' Ceilings Second Floor
Optional Layouts	Circle All that Apply		

Model			
Elevation	Circle One		
Taller Ceilings	Circle All that Apply		
Optional Layouts	Circle All that Apply		

Model			
Elevation	Circle One		
Taller Ceilings	Circle All that Apply		
Optional Layouts	Circle All that Apply		

July 25 2016.
LOT 35L

BS

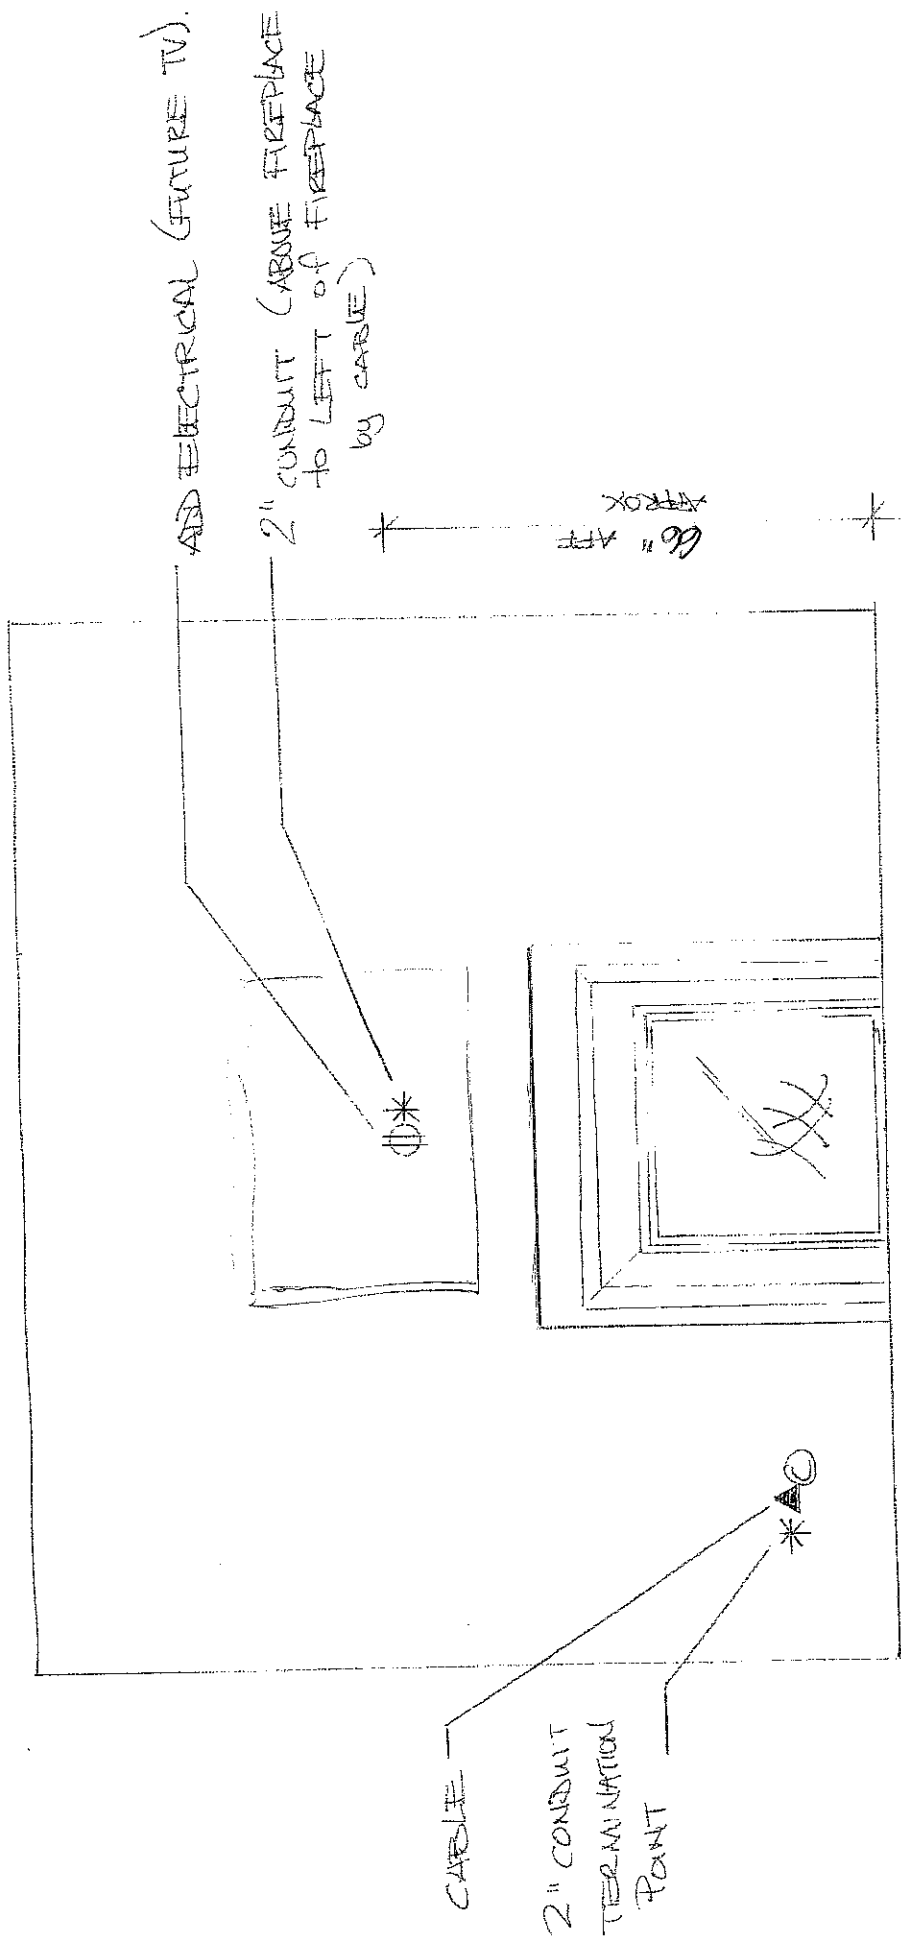

15