

Kleinburg Glen - 36L - 1 - 25-2 Elev.B HUDSON

CENTRAL VAC AND WIRING

Inv.701	1 - FAMILY ROOM: CONDUIT PIPE - FOR TELEVISION - ABOVE FIREPLACE APPROX 66" AFF. TERMINATING AT RIGHT SIDE OF FIREPLACE. PLEASE SEE DRAWING ATTACHED FOR LOCATION
Line9362	Note:
27Jul16 / 7Nov16	
Inv.701	1 - MASTER BEDROOM: LOCATE STANDARD CABLE APPROX 54" AFF NEXT TO ADDITIONAL RECEPTAVLE. PLEASE SEE FLOORPLAN FOR LOCATION
Line9390	Note:
27Jul16 / 7Nov16	
Inv.701	2 - BEDROOM 2 & 3: ADD RG6 CABLE TO EACH BEDROOM. PLEASE SEE FLOORPLAN FOR LOCATION
Line9393	Note:
27Jul16 / 7Nov16	
Inv.701	1 - MASTER BEDROOM: ROUGH - IN FOR EXTRA SECURITY KEY PAD. ABOVE LIGHT SWITCH. PLEASE SEE FLOORPLAN FOR LOCATION
Line9403	Note:
27Jul16 / 7Nov16	
Inv.701	1 - CONDUIT PIPE - FROM ATTIC TO ELECTRICAL PANEL - PLEASE INSTALL A STRAIGHT RUN FROM ATTIC TO ELECTRICAL PANEL
Line9405	Note:
27Jul16 / 7Nov16	

DRYWALL

Inv.701	1 - SMOOTH CEILINGS - (2 - Story Design) SECOND FLOOR
Line9399	Note:
27Jul16 / 7Nov16	

ELECTRICAL

Inv.701	1 - KITCHEN: 110V WALL RECEPTACLE ON DEDICATED CIRCUIT - GAS FIRED APPLIANCE - FOR AUX. EQUIPMENT - NOT A STOVE PLUG. FOR FUTURE 38" RANGE. PLEASE SEE FLOORPLAN FOR LOCATION
Line9323	Note:
27Jul16 / 7Nov16	
Inv.701	1 - KITCHEN: 110V WALL RECEPTACLE ON DEDICATED CIRCUIT - FOR MICROWAVE - MICROWAVE NOT INCLUDED. UNDERCOUNTER, RIGHT SIDE OF ISLAND. PLEASE SEE FLOOR PLAN FOR LOCATION
Line9327	Note:
27Jul16 / 7Nov16	
Inv.701	1 - KITCHEN: 110V WALL RECEPTACLE ON NORMAL CIRCUIT - AT ISLAND, UNDER BREAKFAST BAR, RIGHT SIDE. PLEASE SEE FLOORPLAN FOR LOCATION
Line9328	Note:
27Jul16 / 7Nov16	
Inv.701	1 - KITCHEN:110V WALL RECEPTACLE ON DEDICATED CIRCUIT - LEFT SIDE OF ISLAND TO ACCOMMODATE WINE FRIDGE. PLEASE SEE FLOOR PLAN FOR LOCATION
Line9345	Note:
27Jul16 / 7Nov16	
Inv.701	1 - KITCHEN CABINET VALANCE LIGHTS (UNDER CABINETS) - WITH STRIP LIGHTS - DOES NOT INCLUDE (AND REQUIRES) KITCHEN UPGRADE PRICING.
Line9346	Note: Switch above Dishwasher next to Sink Pot light switch.
27Jul16 / 7Nov16	

Kleinburg Glen - 36L - 1 - 25-2 Elev.B HUDSON

Inv.701	8 - KITCHEN: POT LIGHT: 4 INCH HALOGEN POT LIGHT - 440 WH - X8 IN KITCHEN/BREAKFAST AREA. PLEASE SEE FLOOR PLAN FOR LOCATION. ALL ON ONE SWITCH. PRICED SEPARATELY
Line9349	Note:
27Jul16 / 7Nov16	
Inv.701	1 - KITCHEN: POTLIGHTS ALL ON ONE SWITCH
Line9353	Note:
27Jul16 / 7Nov16	
Inv.701	1 - KITCHEN: RELOCATE STANDARD KITCHEN LIGHT OVER ISLAND. RIGHT SIDE.
Line9354	Note:
27Jul16 / 7Nov16	
Inv.701	1 - KITCHEN: ADDITIONAL STANDARD FIXTURE ON SAME SWITCH OVER ISLAND. PLEASE SEE FLOORPLAN FOR LOCATION
Line9355	Note:
27Jul16 / 7Nov16	
Inv.701	1 - FAMILY ROOM: 110V WALL RECEPTACLE ON NORMAL CIRCUIT - ABOVE FIREPLACE FOR FUTURE TELEVISION. APPROX 66" AFF. PLEASE SEE DRAWING ATTACHED FOR LOCATION
Line9363	Note:
27Jul16 / 7Nov16	
Inv.701	6 - FAMILY ROOM: POT LIGHT: 4 INCH HALOGEN POT LIGHT - 440 WH - X 6 ALL ON ONE SWITCH AND DIMMER. PRICED SEPARATELY. PLEASE SEE FLOORPLAN FOR LOCATIONS
Line9364	Note:
27Jul16 / 7Nov16	
Inv.701	1 - FAMILY ROOM: UPGRADE TO DIMMER SWITCH - ONE UNIT - FOR 6 POTLIGHTS. PLEASE SEE FLOORPLAN FOR LOCATION
Line9365	Note:
27Jul16 / 7Nov16	
Inv.701	1 - FAMILY ROOM: ALL POTLIGHTS ON ONE SWITCH (WITH COVER PLATE) - DOES NOT INCLUDE FIXTURE - PLEASE SEE FLOORPLAN FOR LOCATION
Line9366	Note:
27Jul16 / 7Nov16	
Inv.701	4 - LIVING/DINING ROOM: POT LIGHT: 4 INCH HALOGEN POT LIGHT - 440 WH - PRICED PER LIGHT - X4 ALL ON ONE SWITCH WITH DIMMER. PRICED SEPARATELY. PLEASE SEE FLOOR PLAN FOR LOCATION
Line9367	Note:
27Jul16 / 7Nov16	
Inv.701	1 - LIVING/DINING ROOM: UPGRADE TO DIMMER SWITCH - FOR ALL POT LIGHTS.
Line9368	Note:
27Jul16 / 7Nov16	
Inv.701	1 - LIVING/DINING ROOM: 4 POTLIGHTS ON ONE SWITCH - PLEASE SEE FLOOR PLAN FOR LOCATION
Line9369	Note:
27Jul16 / 7Nov16	
Inv.701	1 - POWDER ROOM: DELETE STANDARD VANITY LIGHT AND ADD STANDARD CEILING FIXTURE ON SAME SWITCH. PLEASE CENTER CEILING LIGHT IN POWDER ROOM.
Line9371	Note:
27Jul16 / 7Nov16	
Inv.701	11 - EXTERIOR POT LIGHT: 4 INCH LINE VOLTAGE POT LIGHT - (EXTERIOR) - EACH. PLEASE SEE 2ND FLOOR FLOORPLAN FOR LOCATIONS
Line9404	Note:
27Jul16 / 7Nov16	

Kleinburg Glen - 36L - 1 - 25-2 Elev.B HUDSON

Inv.701	3 - MAIN FLOOR HALLWAY: DELETE STANDARD HALLWAY LIGHT AND REPLACE WITH POT LIGHT: 4 INCH HALOGEN POT LIGHT - 440 WH - PRICED PER LIGHT - X3. PLEASE SEE FLOOR PLAN FOR LOCATION
Line9375	Note:
27Jul16 / 7Nov16	
Inv.701	1 - 200 AMP ELECTRICAL SERVICE
Line9377	Note:
27Jul16 / 7Nov16	
Inv.701	1 - MASTER ENSUITE: ADDITIONAL POT LIGHT: 6 INCH RECESSED SHOWER POT LIGHT. ONE ON EITHER SIDE OF RAIN HEAD ROUGH-IN
Line9383	Note:
27Jul16 / 7Nov16	
Inv.701	3 - MASTER ENSUITE: POT LIGHT: 4 INCH HALOGEN POT LIGHT - 440 WH (INSULATED) - PRICED PER LIGHT - X3. ALL ON SAME SWITH AS VANITY LIGHTS. PLEASE SEE FLOORPLAN FOR LOCATION
Line9385	Note:
27Jul16 / 7Nov16	
Inv.701	1 - MASTER BEDROOM: 110V WALL RECEPTACLE ON NORMAL CIRCUIT - APPROX 54" AFF. PLEASE SEE FLOORPLAN FOR LOCATION
Line9389	Note:
27Jul16 / 7Nov16	
Inv.701	4 - MASTER BEDROOM: POT LIGHT: 4 INCH HALOGEN POT LIGHT - 440 WH (INSULATED) - PRICED PER LIGHT - X4. PLEASE SEE FLOORPLAN FOR LOCATION. ALL TO BE ON ONE SWITCH WITH CENTER CEILING LIGHT
Line9391	Note:
27Jul16 / 7Nov16	
Inv.701	1 - MASTER BEDROOM: UPGRADE TO DIMMER SWITCH - ONE UNIT - TO CONTROL ALL 4 POTLIGHTS AND CENTER CEILING LIGHT
Line9392	Note:
27Jul16 / 7Nov16	
Inv.701	8 - BEDROOM 2 & 3: POT LIGHT: 4 INCH HALOGEN POT LIGHT - 440 WH (INSULATED) - PRICED PER LIGHT - 4 IN EACH ROOM. TO BE ON SAME SWITCH WITH CENTER CEILING LIGHT.
Line9397	Note:
27Jul16 / 7Nov16	
Inv.701	1 - SECOND FLOOR BATHROOM: POT LIGHT: 4 INCH HALOGEN POT LIGHT - 440 WH (INSULATED) - PRICED PER LIGHT - ON SAME SWITCH AS VANITY
Line9398	Note:
27Jul16 / 7Nov16	
Inv.701	4 - SECOND FLOOR HALLWAY: DELETE STANDARD HALLWAY LIGHT AND REPLACE WITH POT LIGHT: 4 INCH HALOGEN POT LIGHT - 440 WH (INSULATED) - PRICED PER LIGHT - 3 IN HALLWAY AND 1 OVER MAIN FLOOR LANDING. PLEASE SEE FLOORPLAN FOR LOCATION
Line9400	Note:
27Jul16 / 7Nov16	
Inv.701	3 - LAUNDRY: DELETE STANDARD LIGHT FIXTURE AND REPLACE WITH 3 POT LIGHT: 4 INCH HALOGEN POT LIGHT - 440 WH (INSULATED) - PRICED PER LIGHT - PLEASE SEE FLOORPLAN FOR LOCATION.
Line9402	Note: 2 centered to room. 1 over sink. All on the same switch.
27Jul16 / 7Nov16	
Inv.701	1 - KITCHEN: POT LIGHT: 4 INCH HALOGEN POT LIGHT - 440 WH - OVER KITCHEN SINK ON A SEPARATE SWITCH. PRICED SEPARATELY
Line9930	Note:
27Jul16 / 7Nov16	

Kleinburg Glen - 36L - 1 - 25-2 Elev.B HUDSON

Inv.701	1 - KITCHEN: SWITCH (WITH COVER PLATE) - DOES NOT INCLUDE FIXTURE - FOR OVER SINK POTLIGHT. SWITCH LOCATED ABOVE DISHWASHER ON BACKSPLASH
Line9931	Note:
27Jul16 / 7Nov16	

Inv.701	1 - LAUNDRY: SWITCH LOCATION OF WASHER AND DRYER. WASHER TO BE ON LEFT SIDE, DRYER TO BE ON RIGHT. PLEASE SEE FLOORPLAN FOR LOCATIONS
Line13497	Note:
27Jul16 / 7Nov16	

EXTERIOR COLOURS

Inv.701	1 - EXTERIOR COLOUR PACKAGE 7
Line13499	Note:
27Jul16 / 7Nov16	

FORMING

Inv.701	1 - BASEMENT: INSTALL BACK-FLOW PREVENTER
Line13496	Note:
27Jul16 / 7Nov16	

FRAMING

Inv.701	1 - FAMILY ROOM: BUILD FIREPLACE SURROUND TO CEILING. PLEASE SEE SPEC SHEET/DRAWING ATTACHED FOR DETAIL
Line9361	Note:
27Jul16 / 7Nov16	

Inv.701	1 - MASTER ENSUITE: DELETE ONE DOOR TO ACCOMMODATE NEW FLOORPLAN LAYOUT FOR RELOCATED VENT.
Line9380	Note:
27Jul16 / 7Nov16	

Inv.701	1 - MASTER ENSUITE: FULL WIDTH SHOWER IN LIEU OF TUB – 10MM FRAMELESS GLASS WITH POTLIGHT. PLEASE SEE FLOORPLAN FOR LOCATION.
Line13494	Note:
27Jul16 / 7Nov16	

GLASS AND MIRROR

Inv.701	1 - MASTER ENSUITE: FULL WIDTH SHOWER IN LIEU OF TUB – 10MM FRAMELESS GLASS WITH POTLIGHT. PLEASE SEE FLOORPLAN FOR LOCATION.
Line9379	Note:
27Jul16 / 7Nov16	

HVAC

Inv.701	1 - KITCHEN: GAS LINE ROUGH - GROUND FLOOR FOR FUTURE 38" GAS RANGE. PLEASE SEE FLOORPLAN FOR LOCATION
Line9322	Note:
27Jul16 / 7Nov16	

Inv.701	1 - KITCHEN: UPGRADE VENTING FOR STOVE TO 8 INCH PIPE EXTERIOR WALL
Line9324	Note:
27Jul16 / 7Nov16	

Inv.701	1 - LAUNDRY: SWITCH LOCATION OF WASHER AND DRYER. WASHER TO BE ON LEFT SIDE, DRYER TO BE ON RIGHT. PLEASE SEE FLOORPLAN FOR LOCATIONS
Line13498	Note:
27Jul16 / 7Nov16	

INTERIOR TRIM AND DOORS

Kleinburg Glen - 36L - 1 - 25-2 Elev.B HUDSON

Inv.701	2 - MAIN FLOOR: EXTENDED HEIGHT ARCHWAY (PRICE PER DOORWAY) - X2
Line9372	Note:
27Jul16 / 7Nov16	

Inv.701	4 - MAIN FLOOR: STANDARD DOOR EXTENDED HEIGHT 96 INCH (PRICE PER DOOR) - GROUND FLOOR 2 STOREY MODELS
Line9373	Note:
27Jul16 / 7Nov16	

KITCHEN AND BATH CABINetry

Inv.701	1 - MASTER ENSUITE: FULL WIDTH SHOWER IN LIEU OF TUB – 10MM FRAMELESS GLASS WITH POTLIGHT. PLEASE SEE FLOORPLAN FOR LOCATION.
Line13495	Note:
27Jul16 / 7Nov16	

MISC.

Inv.701	1 - Purchaser has attended a Structural appointment at the Decor Centre & has DECLINED any additional upgrades and accepts and acknowledges that there will be no further structural changes/additions/deletions to be made upon signing on July 27, 2016.
Line9406	Note:
27Jul16 / 7Nov16	

Inv.701	1 - Purchasers are aware & accepts that ANY changes made to upgrades after signing this Purchasers Extra Form are subject to a minimum administration fee of \$500. PLUS a 10% holdback fee.
Line9407	Note:
27Jul16 / 7Nov16	

Inv.701	1 - BONUS PACKAGE: \$5,000.00 (INCLUDING TAXES) WORTH OF UPGRADES FROM GOLD PARK HOMES DÉCOR CENTRE IS BEING APPLIED TOWARD THE STRUCTURAL APPOINTMENT. PURCHASER HAS A REMAINING AMOUNT OF \$00 (INCLUDING TAXES) TO BE USED TOWARD THE COLOUR APPOINTMENT.
Line9409	Note:
27Jul16 / 7Nov16	

Inv.701	1 - BALANCE AFTER CREDIT: \$36,397.55
	50% DEPOSIT: \$18,198.78
	50% BALANCE ON CLOSING: \$18,198.78
Line9457	Note:
27Jul16 / 7Nov16	

PLUMBING

Inv.701	1 - KITCHEN: ROUGH - IN - WATERLINE FOR FRIDGE
Line9347	Note:
27Jul16 / 7Nov16	

Inv.701	1 - BASEMENT: INSTALL BACK-FLOW PREVENTER
Line9376	Note:
27Jul16 / 7Nov16	

Inv.701	1 - MASTER ENSUITE: RELOCATE TOILET TO WINDOW SIDE. PLEASE SEE FLOORPLAN FOR LOCATION
Line9378	Note:
27Jul16 / 7Nov16	

Inv.701	1 - MASTER ENSUITE: TRENCH DRAIN APPROX 6 INCH SQUARE - TILED DRAIN - ACO 37239
Line9381	Note:
27Jul16 / 7Nov16	

Kleinburg Glen - 36L - 1 - 25-2 Elev.B HUDSON

Inv.701	1 - MASTER ENSUITE: ROUGH - IN FOR RAINSHOWER HEAD - SHOWER HEAD NOT INCLUDED AND MUST BE PURCHASED
Line9382	Note:
27Jul16 / 7Nov16	
Inv.701	1 - LAUNDRY: RELOCATE LAUNDRY TUB TO UNDER WINDOW. PLEASE SEE FLOORPLAN FOR LOCATION
Line9401	Note:
27Jul16 / 7Nov16	
Inv.701	2 - LAUNDRY: SWITCH LOCATION OF WASHER AND DRYER. WASHER TO BE ON LEFT SIDE, DRYER TO BE ON RIGHT. PLEASE SEE FLOORPLAN FOR LOCATIONS
Line9935	Note:
27Jul16 / 7Nov16	

Elevation A • 1,898 sq.ft.

Elevation B • 1,898 sq.ft.

ISLAND: 110V RECEPTACLE UNDER BREAKFAST BAR, RIGHT SIDE.
110V DEDICATED RECEPTACLE FOR FUTURE MICROWAVE, RIGHT SIDE
- 110V DEDICATED RECEPTACLE FOR FUTURE WINE REFRIG, LEFT SIDE

POT LIGHTS ON ONE SWITCH

PENDANTS ON ONE SWITCH

CONDUIT TERMINATING RIGHT SIDE

CONDUIT, CABLE & 110V RECEPTACLE OVER FIREPLACE APPROX 66" AFF

FIREPLACE SURROUND BUILT-UP TO CEILING. SEE ATTACHED


SWITCH FOR SINK POT LIGHT + SWITCH FOR UNDERCABINET LIGHT

UNDER CABINET LIGHTING COMPLETED

GAS BROUGH-IN FOR FUTURE 38" GAS RANGE
• 110V RECEPTACLE FOR GAS APPLIANCE

8" VENT PIPE

WATERLINE FOR FRIDGE

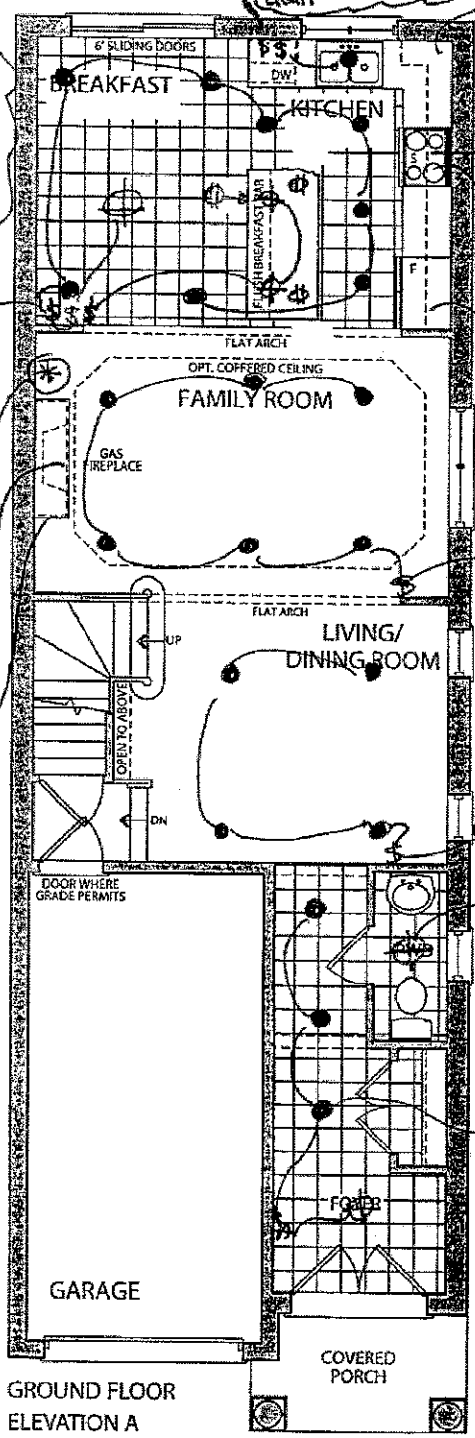

DIMMER + SWITCH FOR POTLIGHTS

DIMMER + SWITCH FOR POTLIGHTS


DELETE VANITY LIGHT + INSTALL STD CEILING FIXTURE

HALLWAY POTS ON SAME SWITCH WITH FOYER LIGHT

LEGEND

- (C) - CABLE
 - (T) - TELEPHONE
 - - POTLIGHTS
 - ⊕ - 110V RECEPTACLE
 - * - CONDUIT PIPE
 - ⊕ - CEILING LIGHT
- EXTEND DOOR HEIGHTS + ARROWAYS
- ⊙ - SOFFIT LIGHTS

GROUND FLOOR ELEVATION A

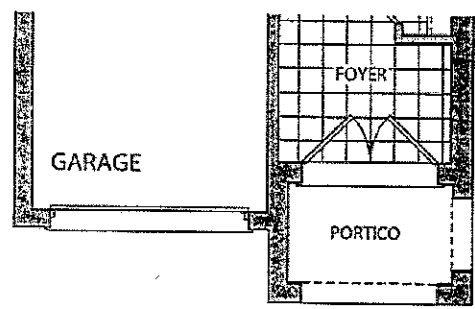


GROUND FLOOR ELEVATION B

LOT 36 L

POT LIGHTS ON
SAME SWITCH AS
VANITY LIGHT

Elevation A • 1,898 sq.ft.
Elevation B • 1,898 sq.ft.

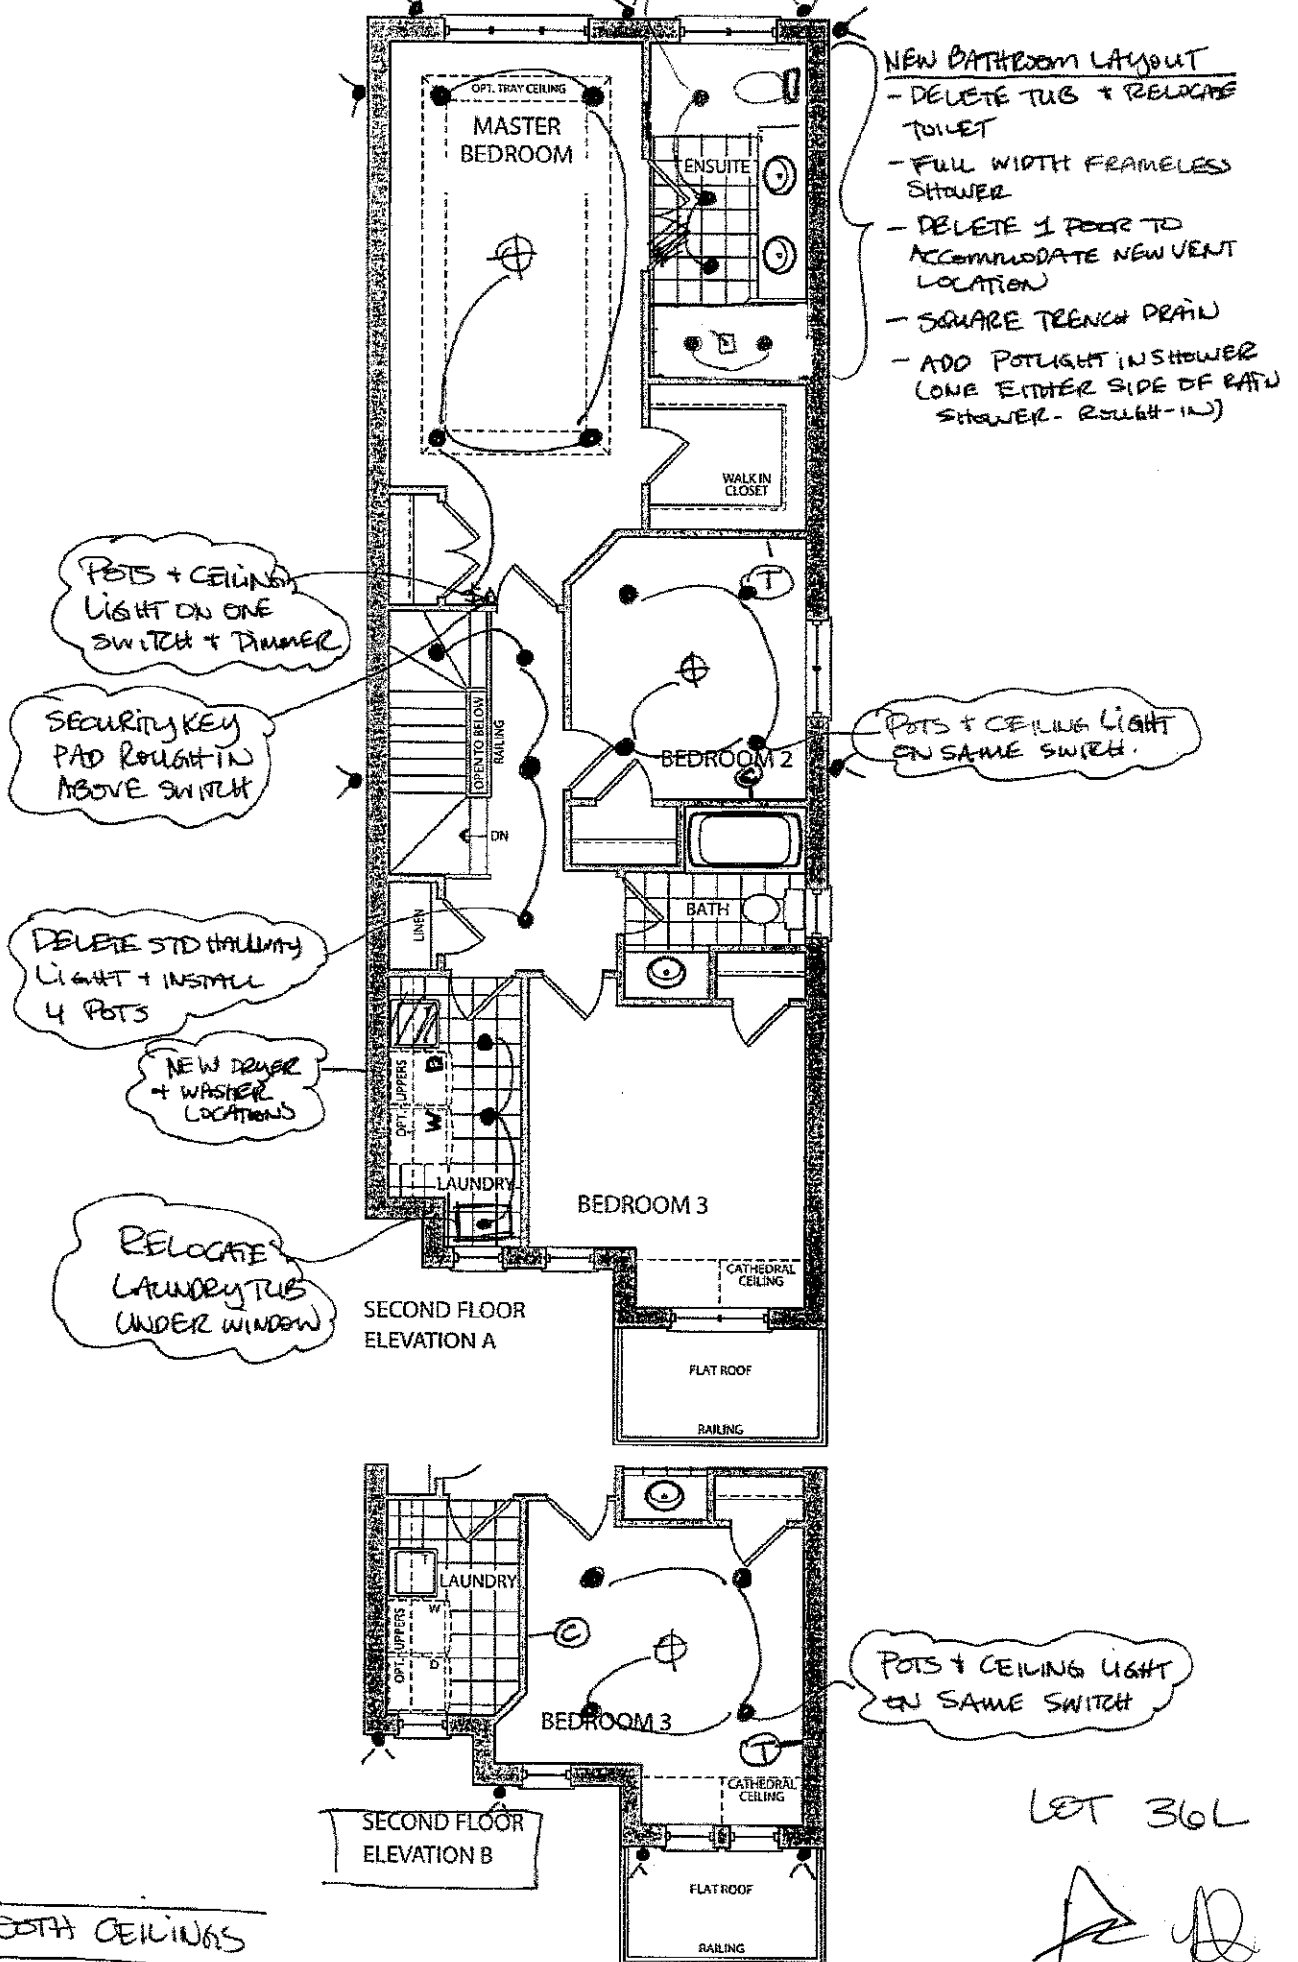


LOT 36L


Handwritten initials/signature

Elevation A • 1,898 sq.ft.

Elevation B • 1,898 sq.ft.

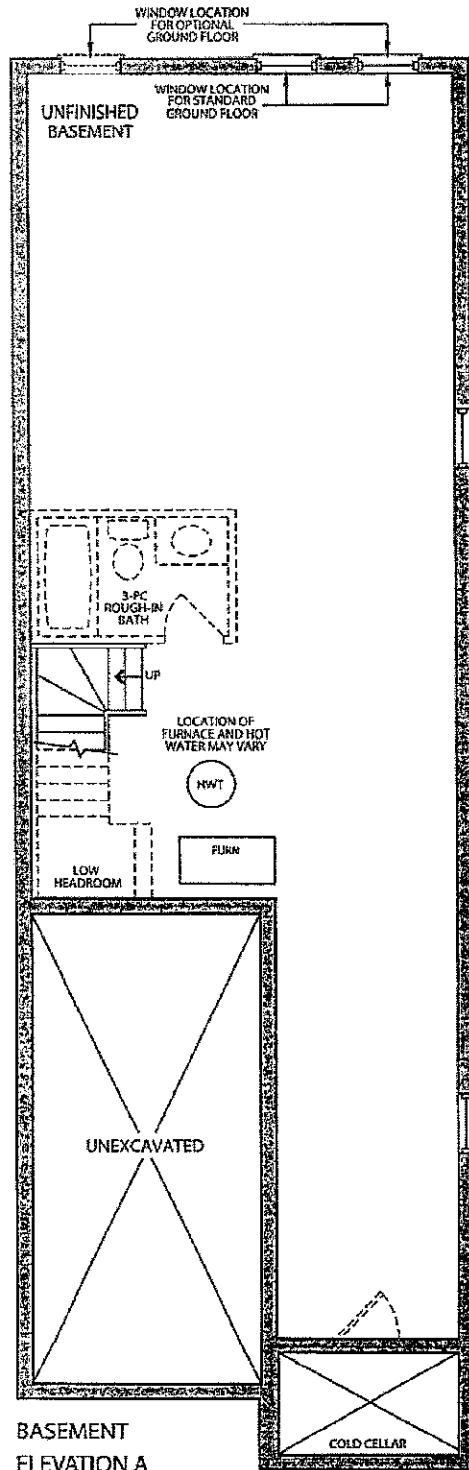

BASEMENT
ELEVATION A

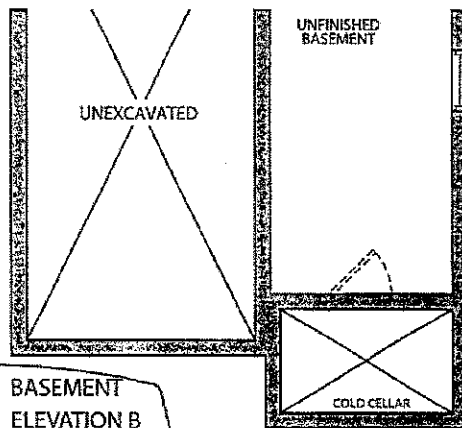


BASEMENT
ELEVATION B

LOT 36L
[Handwritten signature]

UPGRADE

FAMILY ROOM

Build to ceiling.

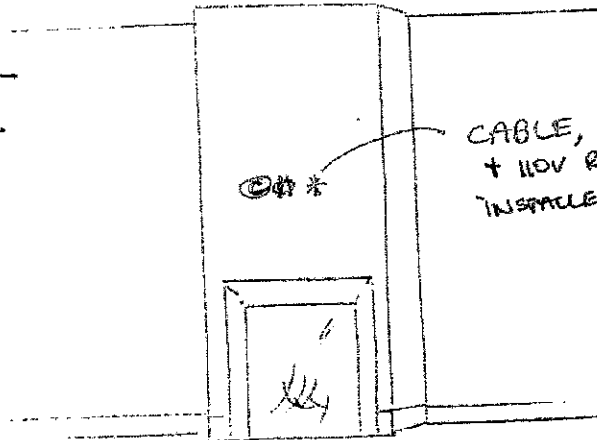

CABLE, CONDUIT PIPE
+ 110V RECEPTACLE
INSTALLED - APPROX 50' AFF

KLEINBURG, GLEN
LOT 36L



Stacey Carlete
Project Coordinator



Claude Azzopardi
Contracts Manager



Nancy Martini
Corporate Controller



Model 25.1 The Riverstone			
Elevation	Circle One	A	1812.7 Square Feet
		B	1812.7 Square Feet
Taller Ceilings	Circle All that Apply	GFTC	9' Ceilings Ground Floor
		MFTC	10' Ceilings Main Floor
		SFTC	9' Ceilings Second Floor
Optional Layouts	Circle All that Apply	GFA1	GROUND FLOOR Alternative Layout Kitchen/Family Room

Model 25.2 The Hudson			
Elevation	Circle One	A	1860.8 Square Feet
		B	1858.6 Square Feet
Taller Ceilings	Circle All that Apply	GFTC	9' Ceilings Ground Floor
		MFTC	10' Ceilings Main Floor
		SFTC	9' Ceilings Second Floor
Optional Layouts	Circle All that Apply	GFA1	GROUND FLOOR Alternative Layout Kitchen/Family Room

Model 25.3 The Oakmount			
Elevation	Circle One	A	2013.0 Square Feet
		B	2013.0 Square Feet
Taller Ceilings	Circle All that Apply	GFTC	9' Ceilings Ground Floor
		MFTC	10' Ceilings Main Floor
		SFTC	9' Ceilings Second Floor
Optional Layouts	Circle All that Apply	GFA1	GROUND FLOOR Alternative Layout Kitchen/Family Room
		SFA4	SECOND FLOOR Alternative Layout Laundry Room
		SFA5	SECOND FLOOR Additional Bedroom

Model 25.4 The Stanford			
Elevation	Circle One	A	2665.6 Square Feet
		B	2665.6 Square Feet
Taller Ceilings	Circle All that Apply	GFTC	9' Ceilings Ground Floor
		MFTC	10' Ceilings Main Floor
		SFTC	9' Ceilings Second Floor
Optional Layouts	Circle All that Apply	GFA2	GROUND FLOOR Optional Piece Bathroom
		MFA1	MAIN FLOOR Alternative Layout Kitchen/Family Room
		SFA2	SECOND FLOOR Shower in Lieu of Tub (Master Ens.)
		SFA5	SECOND FLOOR Additional Bedroom

Model 25.5 The Regency			
Elevation	Circle One	A	2924.0 Square Feet
		B	2924.0 Square Feet
Taller Ceilings	Circle All that Apply	GFTC	9' Ceilings Ground Floor
		MFTC	10' Ceilings Main Floor
		SFTC	9' Ceilings Second Floor
Optional Layouts	Circle All that Apply	GFA2	GROUND FLOOR Optional Piece Bathroom
		MFA1	MAIN FLOOR Alternative Layout Kitchen/Family Room
		SFA2	SECOND FLOOR Shower in Lieu of Tub (Master Ens.)
		SFA5	SECOND FLOOR Additional Bedroom

Model 25.6 The Lincoln			
Elevation	Circle One	A	3021.0 Square Feet
		B	3014.0 Square Feet
Taller Ceilings	Circle All that Apply	GFTC	9' Ceilings Ground Floor
		MFTC	10' Ceilings Main Floor
		SFTC	9' Ceilings Second Floor
Optional Layouts	Circle All that Apply	GFA2	GROUND FLOOR Optional Piece Bathroom
		MFA1	MAIN FLOOR Alternative Layout Kitchen/Family Room

Model 25.7 The Carnegie			
Elevation	Circle One	A	3150.8 Square Feet
		B	3150.8 Square Feet
Taller Ceilings	Circle All that Apply	GFTC	9' Ceilings Ground Floor
		MFTC	10' Ceilings Main Floor
		SFTC	9' Ceilings Second Floor
Optional Layouts	Circle All that Apply	GFA2	GROUND FLOOR Optional Piece Bathroom
		MFA1	MAIN FLOOR Alternative Layout Kitchen/Family Room
		SFA1	SECOND FLOOR Shower in Lieu of Tub (Bedroom 2)

Model 25.8 The Biltmore			
Elevation	Circle One	A	1980.8 Square Feet
		B	1989.3 Square Feet
Taller Ceilings	Circle All that Apply	GFTC	9' Ceilings Ground Floor
		MFTC	10' Ceilings Main Floor
		SFTC	9' Ceilings Second Floor
Optional Layouts	Circle All that Apply		

Model			
Elevation	Circle One		
Taller Ceilings	Circle All that Apply		
Optional Layouts	Circle All that Apply		

Model			
Elevation	Circle One		
Taller Ceilings	Circle All that Apply		
Optional Layouts	Circle All that Apply		

LOT 36L