



Structural
CONSTRUCTION SUMMARY

45 - 1 - 38-4 Elev.A VIVALDI

ELECTRICAL

Inv.477	1 - TELEPHONE AND CABLE ROUGH-IN LOCATIONS
Line5758	Note:
3May16 / 6May16	

EXTERIOR COLOURS

Inv.430	1 - EXTERIOR COLOUR PACKAGE 3
Line5197	Note:
15Apr16 / 20Apr16	

FORMING

Inv.430	1 - SIDE DOOR- HOME TO EXTERIOR- AS PER PLAN AND GRADE PERMITTING CHARGED ON APS
Line5250	Note:
15Apr16 / 20Apr16	

MISC.

Inv.430	1 - Purchaser acknowledges that basement structural purchases are final and any additional changes will be dependent of home office approval.
Line5139	Note:
15Apr16 / 20Apr16	
Inv.430	1 - BONUS DECOR DOLLARS AFTER PURCHASES ON APS - TOTAL INVOICE #430 TOTAL DECOR DOLLARS REMAING TO BE SPENT AT DECOR
Line5141	Note:
15Apr16 / 20Apr16	
Inv.477	1 - Purchaser has attended a Structural appointment at the Decor Centre & has DECLINED any additional upgrades and accepts and acknowledges that there will be no further structural changes/additions/deletions to be made upon signing on May 3, 2016.
Line5759	Note:
3May16 / 6May16	
Inv.477	1 - Purchasers are aware & accepts that ANY changes made to upgrades after signing this Purchasers Extra Form are subject to a minimum administration fee of \$500. PLUS a 10% holdback fee
Line5760	Note:
3May16 / 6May16	

PLUMBING

Inv.430	1 - ROUGH-IN - 3PC BASEMENT ROUGH-IN
Line5137	Note:
15Apr16 / 20Apr16	

WINDOWS - BASEMENT

Inv.430	4 - BASEMENT WINDOWS - UPGRADE EXISTING BASEMENT WINDOW TO 30 INCH X 24 INCH - MAY REQUIRE INSTALLATION OF WINDOW WELL
Line5138	Note:
15Apr16 / 20Apr16	

WINDOWS AND DOORS



CONSTRUCTION SUMMARY


45 - 1 - 38-4 Elev.A VIVALDI

Inv.430	1 - MAN DOOR GARAGE TO HOUSE - OPTIONAL - IF GRADE PERMITS CHARGED ON APS
Line5249	Note:
15Apr16 / 20Apr16	

Telephone — (T)
Cable — (C)
Electrical — (E)

The
Vivaldi
38' SERIES



Elevation A • 2,518 sq.ft. | Elevation B • 2,518 sq.ft.

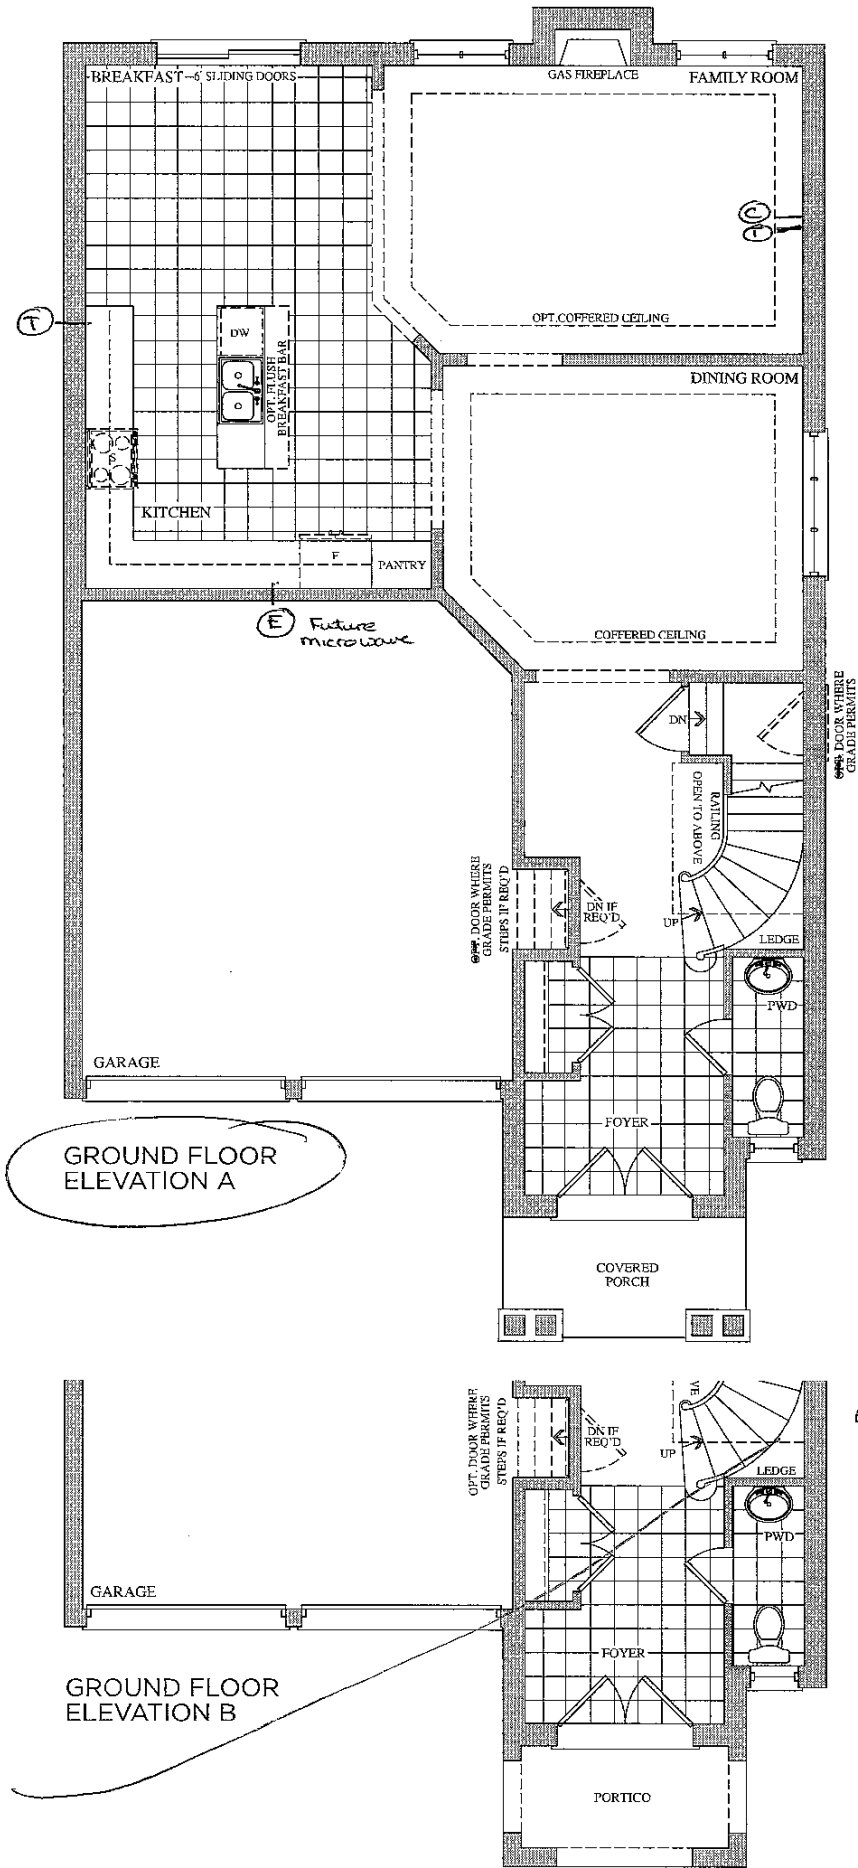

Telephone — (T)
Cable — (C)

The
Vivaldi
38' SERIES

Elevation A • 2,518 sq.ft. | Elevation B • 2,518 sq.ft.

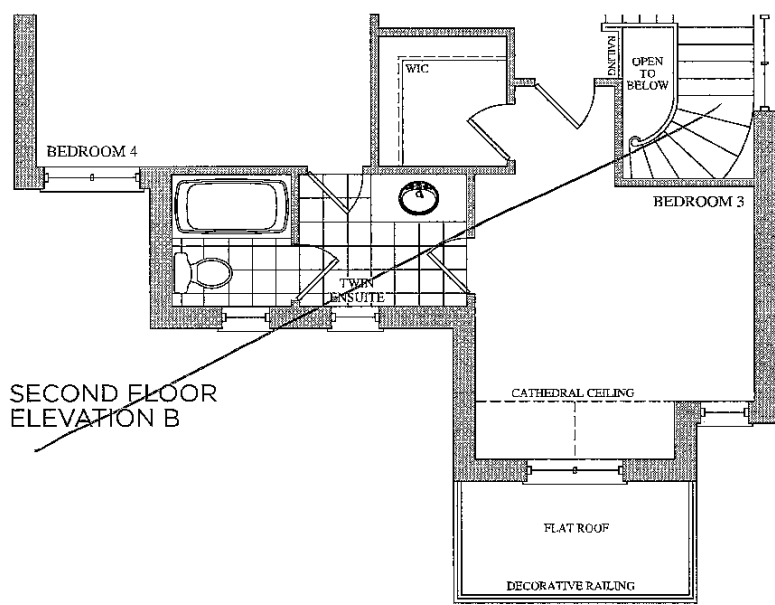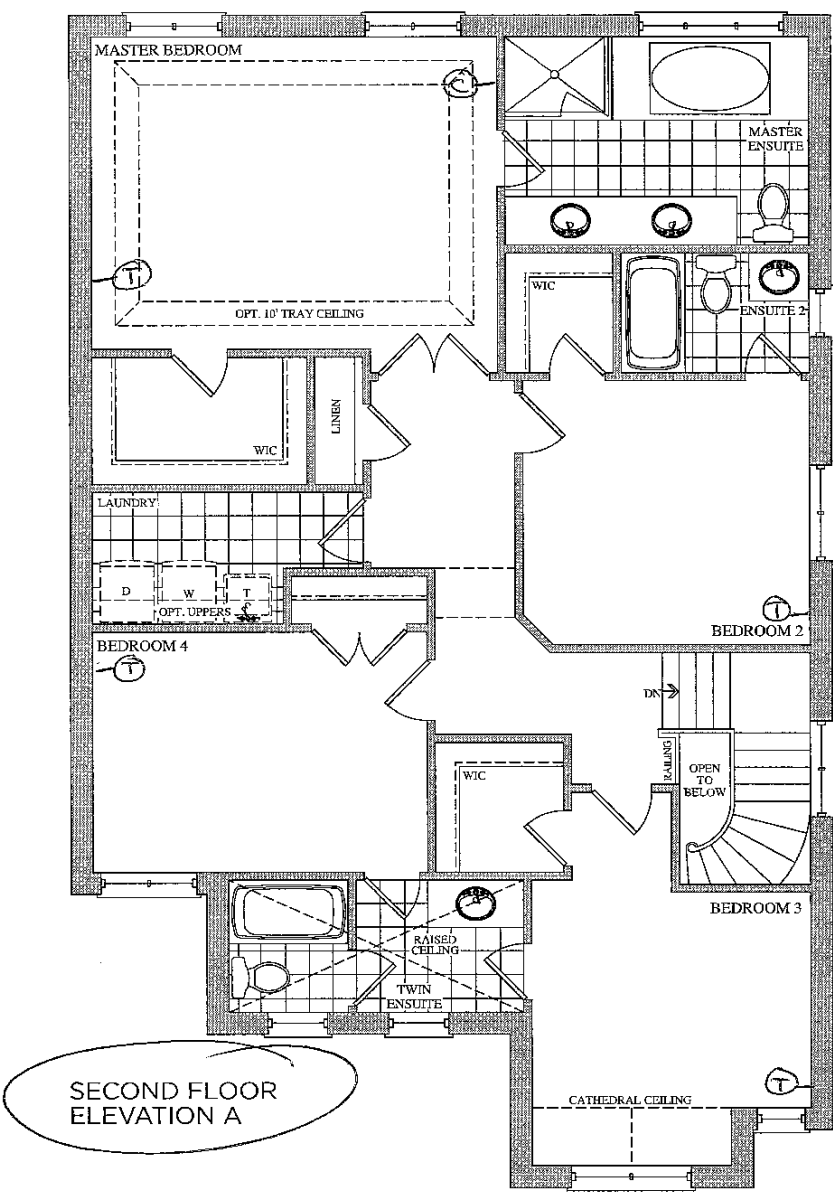


Lot 45
May 3, 16

(MT) (T-T)

Prices, figures, illustrations, sizes, features and finishes are subject to change without notice. E.&O.E. Areas and dimensions are approximate and actual usable floor space may vary from the stated area. Layout may be reverse of the unit purchased. E. & O.E.

BSMNT WINDOWS
4 x 30" x 24"

Elevation A • 2,518 sq.ft. | Elevation B • 2,518 sq.ft.

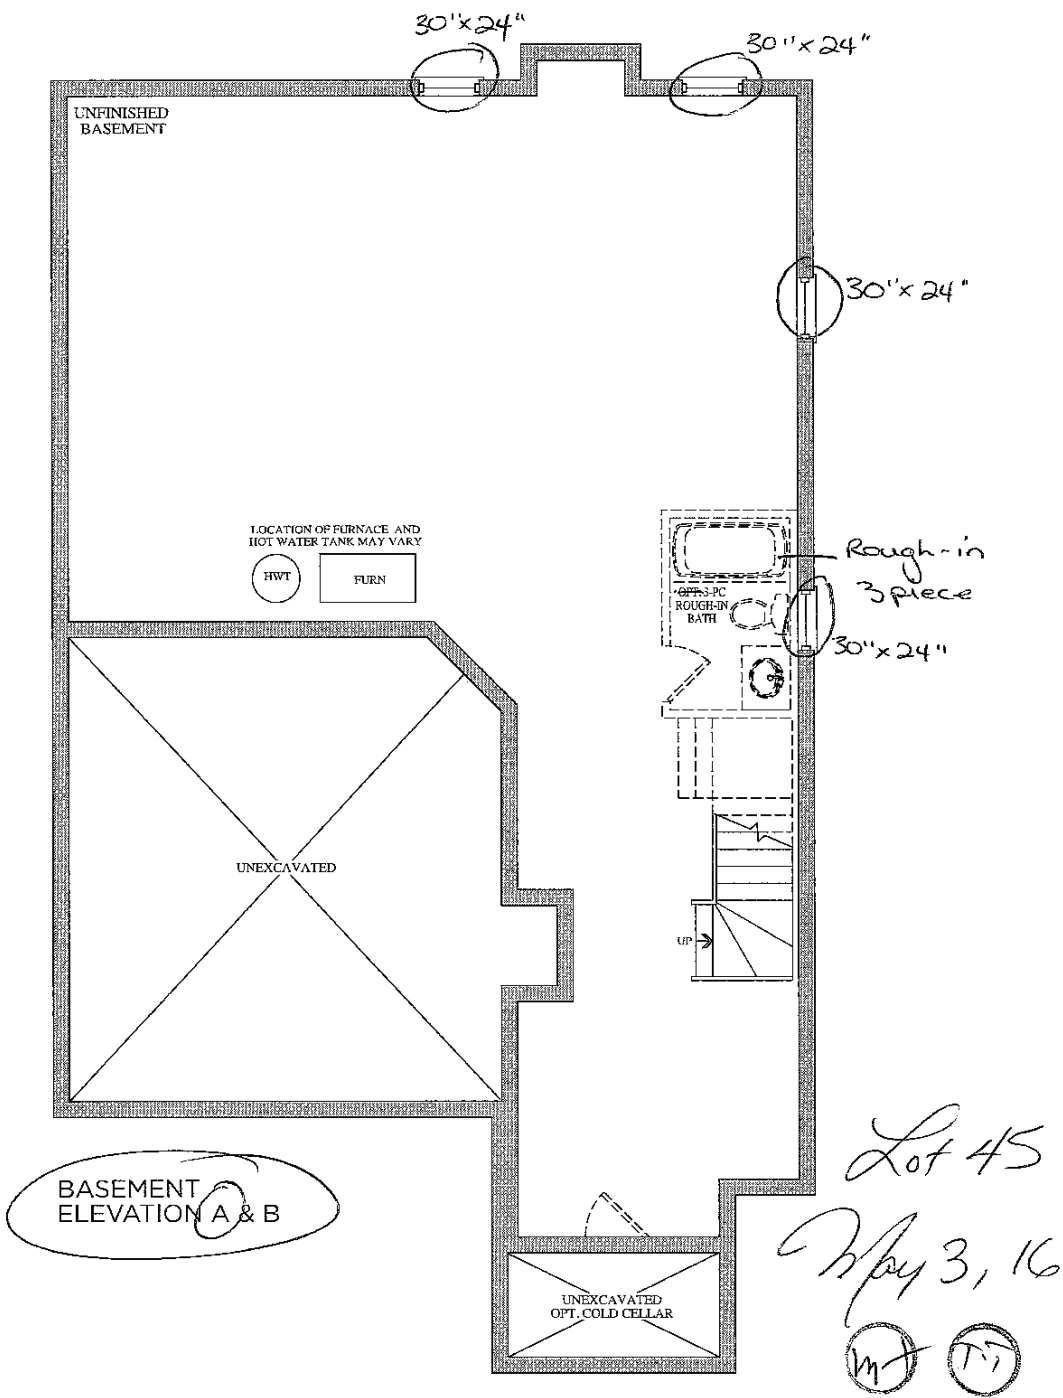



Stacey Carlete
Project Coordinator



Claude Azzopardi
Contracts Manager



Nancy Mc
Corporate C

45
Lot #



Model	38.1 The Bizet		
Elevation	Circle One	A	2189.6 Square Feet
		B	2186.7 Square Feet
Optional Layouts	Circle All that Apply		

Model	38.2 The Ravel		
Elevation	Circle One	A	2271.5 Square Feet
		B	2273.7 Square Feet
Optional Layouts	Circle All that Apply		

Model	38.3 The Haydn		
Elevation	Circle One	A	2394.5 Square Feet
		B	2388.3 Square Feet
Optional Layouts	Circle All that Apply		

Model	38.4 The Vivaldi		
Elevation	Circle One	A	2459.1 Square Feet
		B	2459.1 Square Feet
Optional Layouts	Circle All that Apply		

Model	38.5 The Handel		
Elevation	Circle One	A	2549.2 Square Feet
		B	2554.7 Square Feet
Optional Layouts	Circle All that Apply		

Model	38.9 The Puccini		
Elevation	Circle One	A	3628.0 Square Feet
		B	3634.7 Square Feet
Optional Layouts	Circle All that Apply	GFA1	GROUND FLOOR Optional Alternative Layout

Model	38.6 The Scarlatti		
Elevation	Circle One	A	3521.1 Square Feet
		B	3508.1 Square Feet
Optional Layouts	Circle All that Apply	GFA1	GROUND FLOOR Optional Alternative Layout

Model	38.7 The Schubert		
Elevation	Circle One	A	3593.8 Square Feet
		B	3610.5 Square Feet
Optional Layouts	Circle All that Apply	GFA1	GROUND FLOOR Optional Alternative Layout
		SFA4	SECOND FLOOR Additional Bedroom

Model	38.8 The Corelli		
Elevation	Circle One	A	3801.5 Square Feet
		B	3801.5 Square Feet
Optional Layouts	Circle All that Apply	GFA1	GROUND FLOOR Optional Alternative Layout
		SFA4	SECOND FLOOR Additional Bedroom w/ Ensuite

Model	41.1 The Strauss		
Elevation	Circle One	A	2554.2 Square Feet
		B	2571.2 Square Feet
Optional Layouts	Circle All that Apply	SFA1	SECOND FLOOR Shower in Lieu of Tub B2

Model	41.2 The Mozart		
Elevation	Circle One	A	2725.9 Square Feet
		B	2711.1 Square Feet
Optional Layouts	Circle All that Apply	SFA1	SECOND FLOOR Shower in Lieu of Tub B2

Model	41.3 The Chopin		
Elevation	Circle One	A	2800.0 Square Feet
		B	2810.5 Square Feet
Optional Layouts	Circle All that Apply		

Model	41.4 The Bach		
Elevation	Circle One	A	2894.4 Square Feet
		B	2894.5 Square Feet
Optional Layouts	Circle All that Apply		

Model	41.5 The Brahms		
Elevation	Circle One	A	3948.1 Square Feet
		B	3949.1 Square Feet
Optional Layouts	Circle All that Apply	GFA1	GROUND FLOOR Optional Alternative Layout
		SFA2	SECOND FLOOR Shower in Lieu of Tub B4
		SFA3	SECOND FLOOR Optional Laundry Layout

Model	41.6 The Verdi		
Elevation	Circle One	A	3862.5 Square Feet
		B	3866.4 Square Feet
Optional Layouts	Circle All that Apply	GFA1	GROUND FLOOR Optional Alternative Layout
		SFA3	SECOND FLOOR Optional Laundry Layout

