

CONSTRUCTION SUMMARY

47 - 1 - 38-5 Elev.A HANDEL ✓

ELECTRICAL

Inv.409	1 - MASTER BEDROOM: Install Security Key Pad (rough-in only) in master bedroom, beside light switch
Line4864	Note:
7Apr16 / 26Apr16	
Inv.409	1 - BEDROOM 3: Upgrade standard Cat 5 phone rough-in to a CAT 6 phone rough-in, in bedroom #3. See floor plan
Line4865	Note:
7Apr16 / 26Apr16	
Inv.409	1 - BEDROOM 4: Upgrade standard Cat 5 phone rough-in to a CAT 6 phone rough-in, in bedroom #4. See floor plan
Line4866	Note:
7Apr16 / 26Apr16	
Inv.409	1 - Phone and cable standard rough-in locations. See floor plan. Locations may vary slightly due to joist locations.
Line4867	Note:
7Apr16 / 26Apr16	
Inv.409	1 - BEDROOM 3: Install RG6 rough-in, in bedroom #3. See floor plan
Line4868	Note:
7Apr16 / 26Apr16	
Inv.409	1 - BASEMENT: Install 110V Wall Receptical on dedicated circuit in basement. See floor plan
Line4870	Note:
7Apr16 / 26Apr16	
Inv.409	1 - KITCHEN: Install rough-in for future valance lighting under kitchen cabinets. Does not include and requires the purchase of the kitchen upgrade for wood valance
Line4871	Note:
7Apr16 / 26Apr16	
Inv.409	4 - EXTERIOR: Install 4 (four) 4" Line Voltage Exterior Pot Lights, as shown on brochure. See Floor plan
Line4872	Note:
7Apr16 / 26Apr16	

EXTERIOR COLOURS

Inv.409	1 - EXTERIOR COLOUR PACKAGE 9
Line5302	Note:
7Apr16 / 26Apr16	

FORMING

Inv.409	1 - BASEMENT: additional foot to basement ceiling. Includes extended railings, stairs and pickets, 10" foundation walls and 14" x 30" basement windows
Line4879	Note:
7Apr16 / 26Apr16	

FRAMING

Inv.409	1 - MAIN FLOOR: Install 7 (seven) extended height doors (96") throughout the main floor. See floor plan
Line5459	Note:
7Apr16 / 26Apr16	

CONSTRUCTION SUMMARY

47 - 1 - 38-5 Elev.A HANDEL

Inv.409	1 - MAIN FLOOR: Install 6 (six) extended height archways on main floor. See floor plan.
Line5460	Note:
7Apr16 / 26Apr16	

HVAC

Inv.409	1 - KITCHEN: Install Vac Pan under kitchen sink. Rough-in only.
Line4863	Note:
7Apr16 / 26Apr16	

Inv.409	1 - KITCHEN: Install gas line rough-in for stove in kitchen (2-story)
Line4874	Note:
7Apr16 / 26Apr16	

INTERIOR TRIM AND DOORS

Inv.409	7 - MAIN FLOOR: Install 7 (seven) extended height doors (96") throughout the main floor. See floor plan
Line4875	Note:
7Apr16 / 26Apr16	

Inv.409	6 - MAIN FLOOR: Install 6 (six) extended height archways on main floor. See floor plan.
Line4876	Note:
7Apr16 / 26Apr16	

MISC.

Inv.409	1 - Purchasers are aware & accepts that ANY changes made to upgrades after signing this Purchasers Extra Form are subject to a minimum administration fee of \$500. PLUS a 10% holdback fee.
Line4881	Note:
7Apr16 / 26Apr16	

PLUMBING

Inv.409	1 - KITCHEN: Install waterline rough-in for fridge. (no connection)
Line4877	Note:
7Apr16 / 26Apr16	

Inv.409	1 - BASEMENT: Install 3-piece rough-in in basement
Line4878	Note:
7Apr16 / 26Apr16	

WINDOWS - BASEMENT

Inv.409	3 - BASEMENT: Install larger basement windows, in lieu of the upgraded ones given with the purchase of additional foot in basement. Windows to be 24" x 30" w. may require window wells
Line4880	Note:
7Apr16 / 26Apr16	

WINDOWS AND DOORS



Inv.409	1 - GARAGE: Install Mandoor (if grade permits) See floor plan
Line4873	Note:
7Apr16 / 26Apr16	

encore
BRAMPTON

SCHEDULE 'E'

The Handel

Elevation A • 2,603 sq.ft.

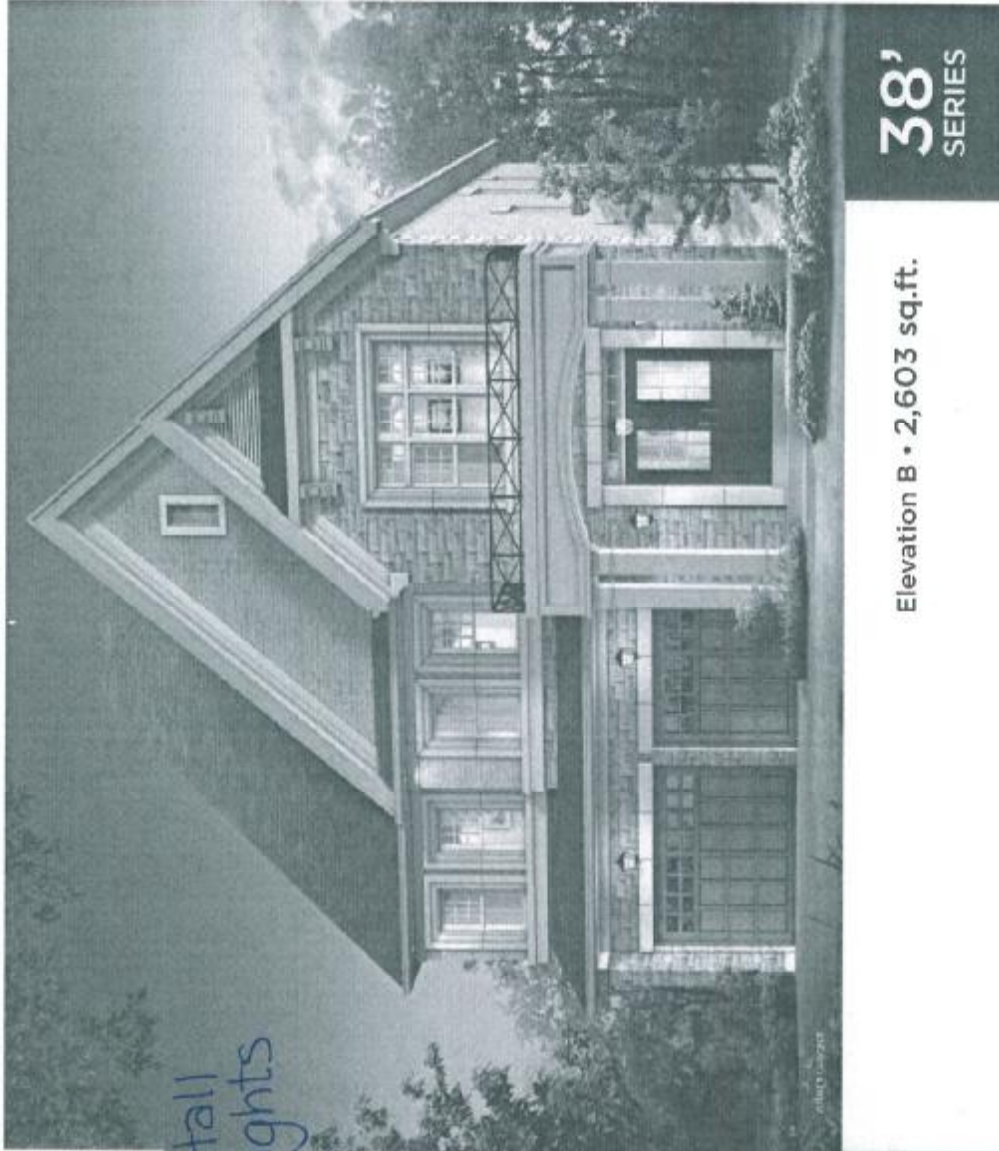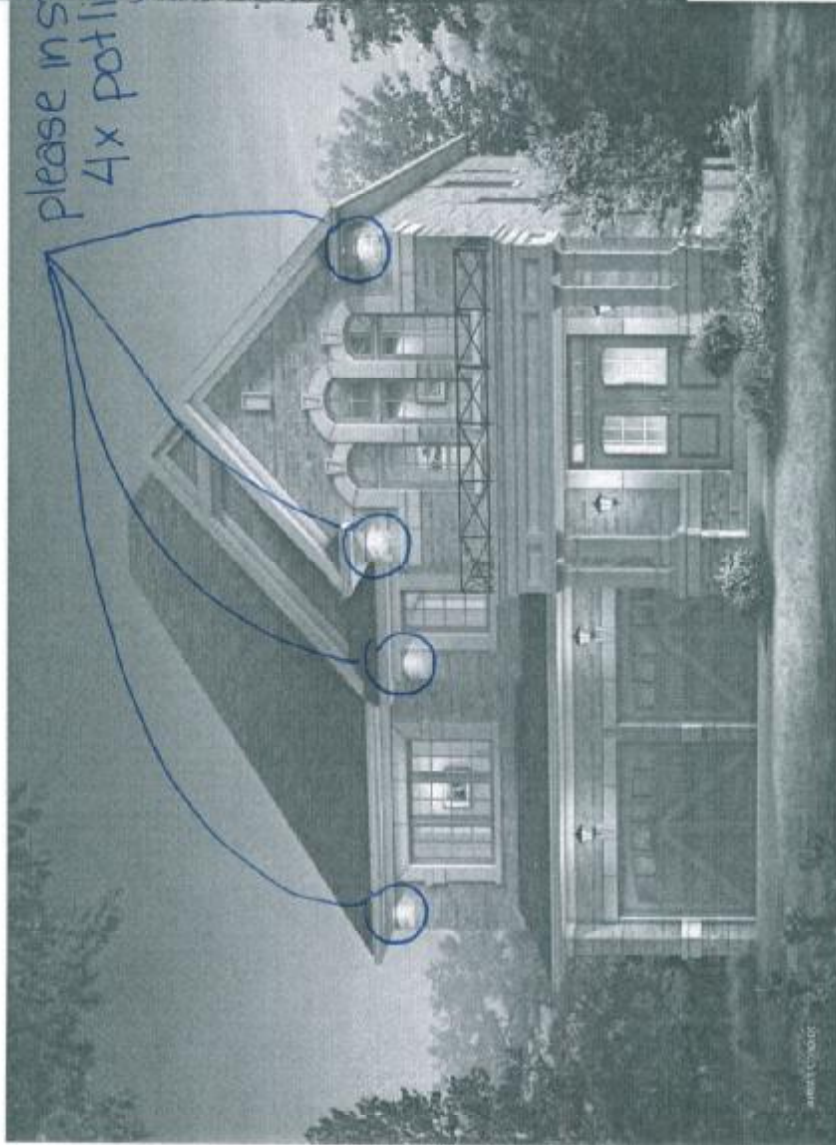

38'
SERIES

Elevation B • 2,603 sq.ft.



VENDOR	
PURCHASER	Tsk
PURCHASER	

goldpark
HOMES

A red circular stamp, likely a library or archival mark, is located in the upper right corner of the page.

Telephone — (T)

Cable — (C)

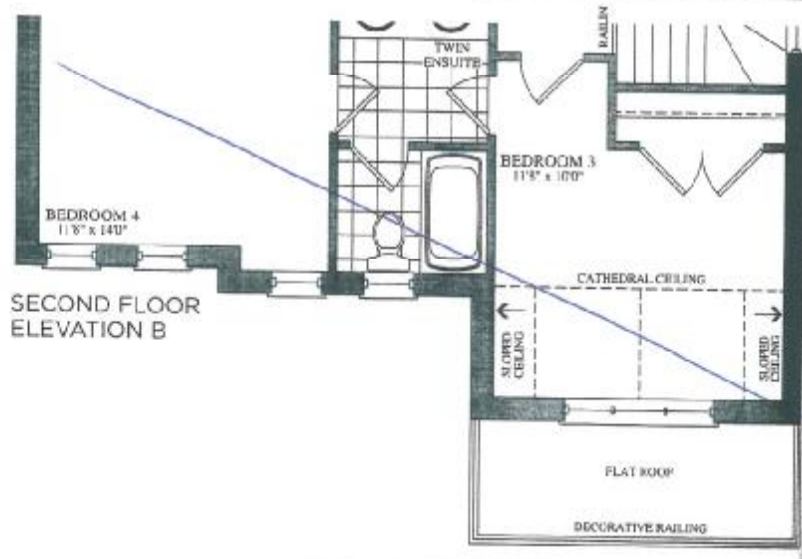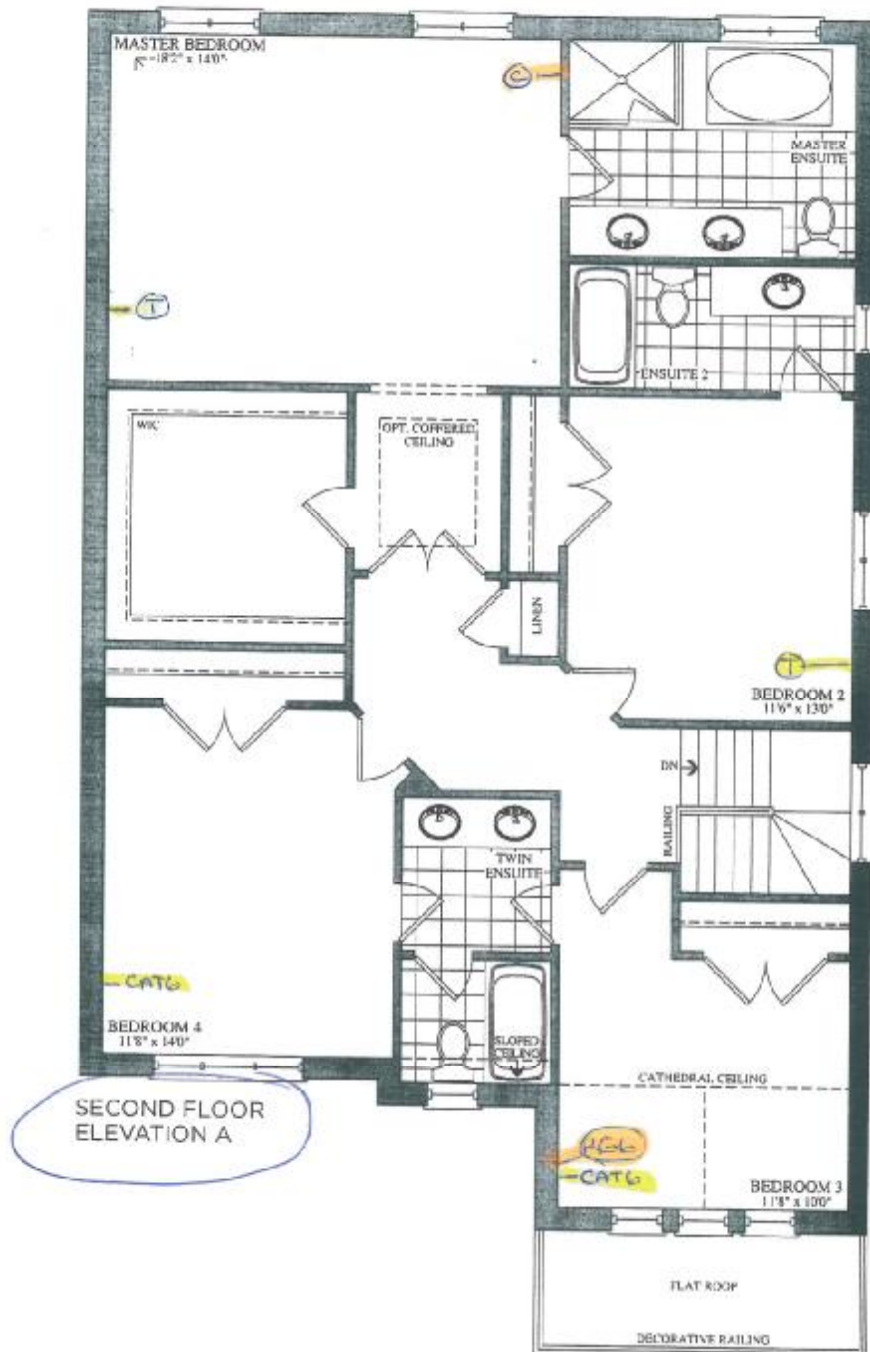

Lot 47
The Handel (A)

Tsk

Electrical - (E)

Pot Lights
x4



Elevation A = 2,603 sq.ft.




Elevation B = 2,603 sq.ft.



goldpark

Photos, figures, illustrations, drawings, and other information are subject to change without notice. © 2015. All rights reserved. All other trademarks are the property of their respective owners. Goldpark is a registered trademark of Goldpark LLC. All other trademarks are the property of their respective owners.

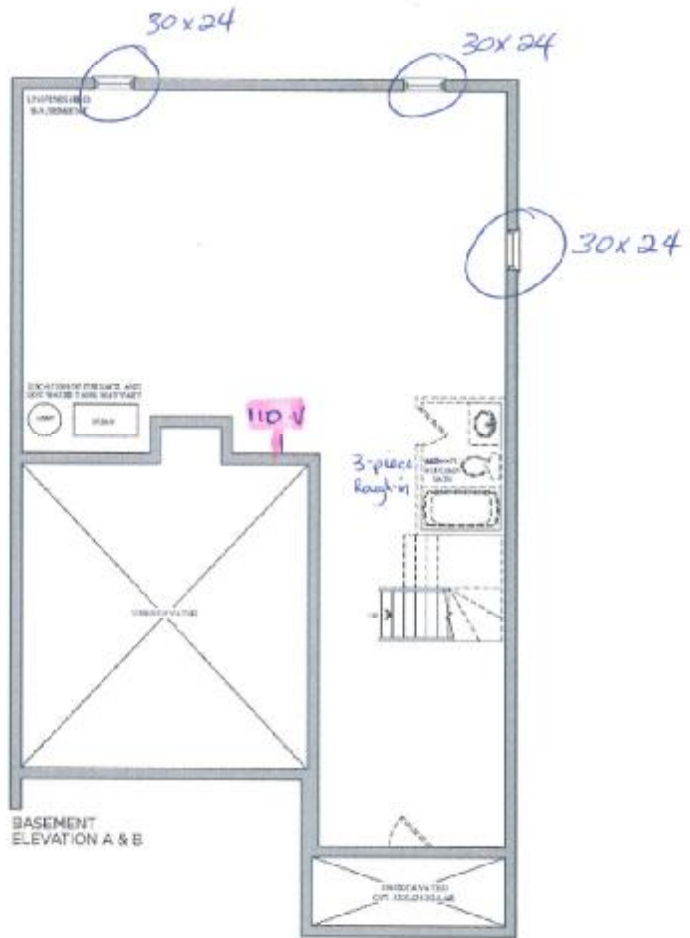

BSMNT WINDOWS
3 X 30" x 24"

Lot 47
The Handel (A)

TSK



Stacey Carlete
Project Coordinator



Claude Azzopardi
Contracts Manager



Nancy Mc
Corporate C

47
Lot #



Model	38.1 The Bizet		
Elevation	Circle One	A	2189.6 Square Feet
		B	2186.7 Square Feet
Optional Layouts	Circle All that Apply		

Model	38.2 The Ravel		
Elevation	Circle One	A	2271.5 Square Feet
		B	2273.7 Square Feet
Optional Layouts	Circle All that Apply		

Model	38.3 The Haydn		
Elevation	Circle One	A	2394.5 Square Feet
		B	2388.3 Square Feet
Optional Layouts	Circle All that Apply		

Model	38.4 The Vivaldi		
Elevation	Circle One	A	2455.1 Square Feet
		B	2455.1 Square Feet
Optional Layouts	Circle All that Apply		

Model	38.5 The Handel		
Elevation	Circle One	A	2549.2 Square Feet
		B	2554.7 Square Feet
Optional Layouts	Circle All that Apply		

Model	38.9 The Puccini		
Elevation	Circle One	A	3628.0 Square Feet
		B	3634.7 Square Feet
Optional Layouts	Circle All that Apply	GFA1	GROUND FLOOR Optional Alternative Layout

Model	38.6 The Scarlatti		
Elevation	Circle One	A	3521.1 Square Feet
		B	3508.1 Square Feet
Optional Layouts	Circle All that Apply	GFA1	GROUND FLOOR Optional Alternative Layout

Model	38.7 The Schubert		
Elevation	Circle One	A	3593.8 Square Feet
		B	3610.5 Square Feet
Optional Layouts	Circle All that Apply	GFA1	GROUND FLOOR Optional Alternative Layout
		SFA4	SECOND FLOOR Additional Bedroom

Model	38.8 The Corelli		
Elevation	Circle One	A	3801.5 Square Feet
		B	3801.5 Square Feet
Optional Layouts	Circle All that Apply	GFA1	GROUND FLOOR Optional Alternative Layout
		SFA4	SECOND FLOOR Additional Bedroom w/ Ensuite

Model	41.1 The Strauss		
Elevation	Circle One	A	2554.2 Square Feet
		B	2571.2 Square Feet
Optional Layouts	Circle All that Apply	SFA1	SECOND FLOOR Shower in Lieu of Tub B2

Model	41.2 The Mozart		
Elevation	Circle One	A	2725.9 Square Feet
		B	2711.1 Square Feet
Optional Layouts	Circle All that Apply	SFA1	SECOND FLOOR Shower in Lieu of Tub B2

Model	41.3 The Chopin		
Elevation	Circle One	A	2800.0 Square Feet
		B	2810.5 Square Feet
Optional Layouts	Circle All that Apply		

Model	41.4 The Bach		
Elevation	Circle One	A	2894.4 Square Feet
		B	2894.5 Square Feet
Optional Layouts	Circle All that Apply		

Model	41.5 The Brahms		
Elevation	Circle One	A	3948.1 Square Feet
		B	3949.1 Square Feet
Optional Layouts	Circle All that Apply	GFA1	GROUND FLOOR Optional Alternative Layout
		SFA2	SECOND FLOOR Shower in Lieu of Tub B4
		SFA3	SECOND FLOOR Optional Laundry Layout

Model	41.6 The Verdi		
Elevation	Circle One	A	3862.5 Square Feet
		B	3866.4 Square Feet
Optional Layouts	Circle All that Apply	GFA1	GROUND FLOOR Optional Alternative Layout
		SFA3	SECOND FLOOR Optional Laundry Layout

