

**CONSTRUCTION SUMMARY**

**55 - 1 - 41-5 Elev.A BRAHMS**

**ELECTRICAL**

|                 |                                                                                                                                                                                                                  |
|-----------------|------------------------------------------------------------------------------------------------------------------------------------------------------------------------------------------------------------------|
| Inv.410         | 1 - BASEMENT: Upgrade to 200 amps in lieu of the builder's standard 100 amps                                                                                                                                     |
| Line4882        | Note:                                                                                                                                                                                                            |
| 7Apr16 / 5May16 |                                                                                                                                                                                                                  |
| Inv.410         | 1 - KITCHEN: Install 110V wall receptical on dedicated circuit for future microwave unit. See floor plan for location. Kitchen cabinetry to accomodate the microwave must be purchased at the colour appointment |
| Line4887        | Note:                                                                                                                                                                                                            |
| 7Apr16 / 5May16 |                                                                                                                                                                                                                  |

**EXTERIOR COLOURS**

|                 |                               |
|-----------------|-------------------------------|
| Inv.410         | 1 - EXTERIOR COLOUR PACKAGE 6 |
| Line5199        | Note:                         |
| 7Apr16 / 5May16 |                               |

**FRAMING**

|                 |                                                                                                     |
|-----------------|-----------------------------------------------------------------------------------------------------|
| Inv.485         | 1 - MAIN FLOOR- 7 extended height doors. Throughout the main floor where applicable. See Floor Plan |
| Line5839        | Note:                                                                                               |
| 5May16 / 5May16 |                                                                                                     |

**INTERIOR TRIM AND DOORS**

|                 |                                                                                                                     |
|-----------------|---------------------------------------------------------------------------------------------------------------------|
| Inv.410         | 7 - MAIN FLOOR: Install 7 (seven) extended height doors throughout the main floor where applicable. See floor plan. |
| Line4884        | Note:                                                                                                               |
| 7Apr16 / 5May16 |                                                                                                                     |

**MISC.**

|                 |                                                                                                                                                                                                 |
|-----------------|-------------------------------------------------------------------------------------------------------------------------------------------------------------------------------------------------|
| Inv.410         | 1 -<br>Purchasers are aware & accepts that ANY changes made to upgrades after signing this Purchasers Extra Form are subject to a minimum administration fee of \$500. PLUS a 10% holdback fee. |
| Line4888        | Note:                                                                                                                                                                                           |
| 7Apr16 / 5May16 |                                                                                                                                                                                                 |

**PLUMBING**

|                 |                                                                                           |
|-----------------|-------------------------------------------------------------------------------------------|
| Inv.410         | 1 - GARAGE: Install exterior hose bib with hot and cold water valve. To go in the garage. |
| Line4885        | Note:                                                                                     |
| 7Apr16 / 5May16 |                                                                                           |



**WINDOWS - BASEMENT**

|                 |                                                                                                                |
|-----------------|----------------------------------------------------------------------------------------------------------------|
| Inv.410         | 1 - BASEMENT: Enlarge One (1) basement window to 46" x 32" High, in lieu of the builder's standard 30" x 12" h |
| Line4886        | Note:                                                                                                          |
| 7Apr16 / 5May16 |                                                                                                                |

**WINDOWS AND DOORS**

|                 |                                                                  |
|-----------------|------------------------------------------------------------------|
| Inv.410         | 1 - GARAGE: Install Mandoor. Where grade permits. See floor plan |
| Line4883        | Note:                                                            |
| 7Apr16 / 5May16 |                                                                  |

Telephone—(T)  
cable—(C)  
Electrical—(E)

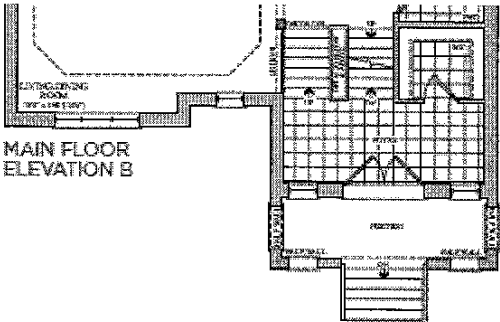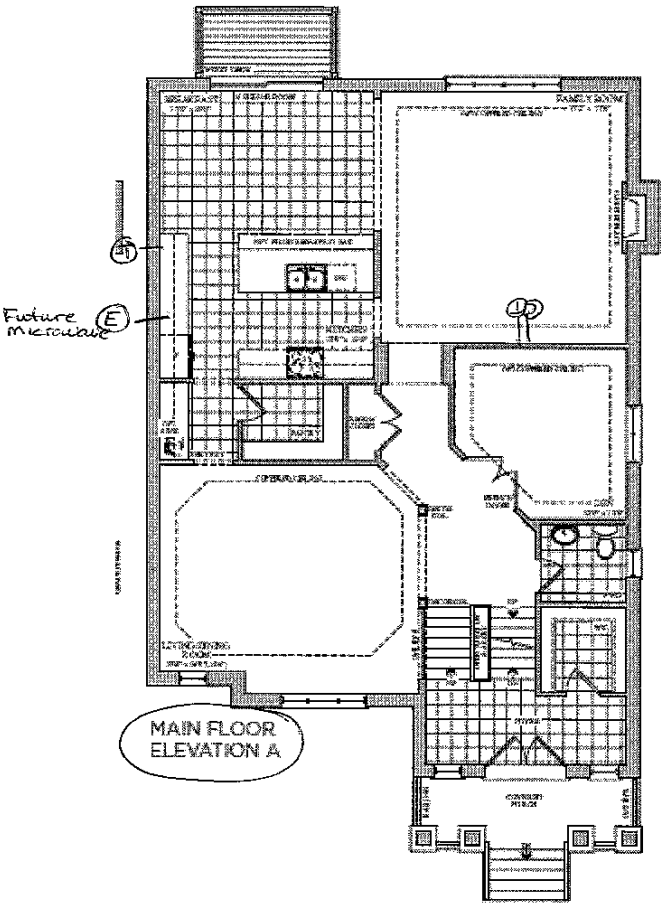

**The Brahms**  
21 SERIES

Elevation A - 3,352 sq.ft.

Elevation B - 3,352 sq.ft.

**OLD PERK**



© 2016 Old Perk LLC. All rights reserved. Old Perk LLC is a registered trademark of Old Perk LLC. All other trademarks are the property of their respective owners.

Lot 55  
The Brahms (A)

Apr. 7, 2016

(A) (B)

Telephone — ①  
 Cable — ②

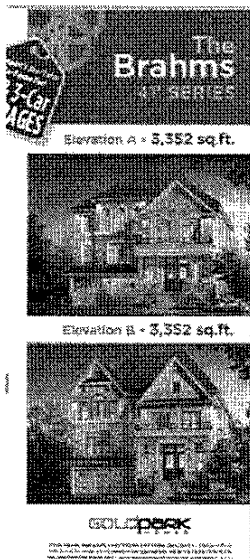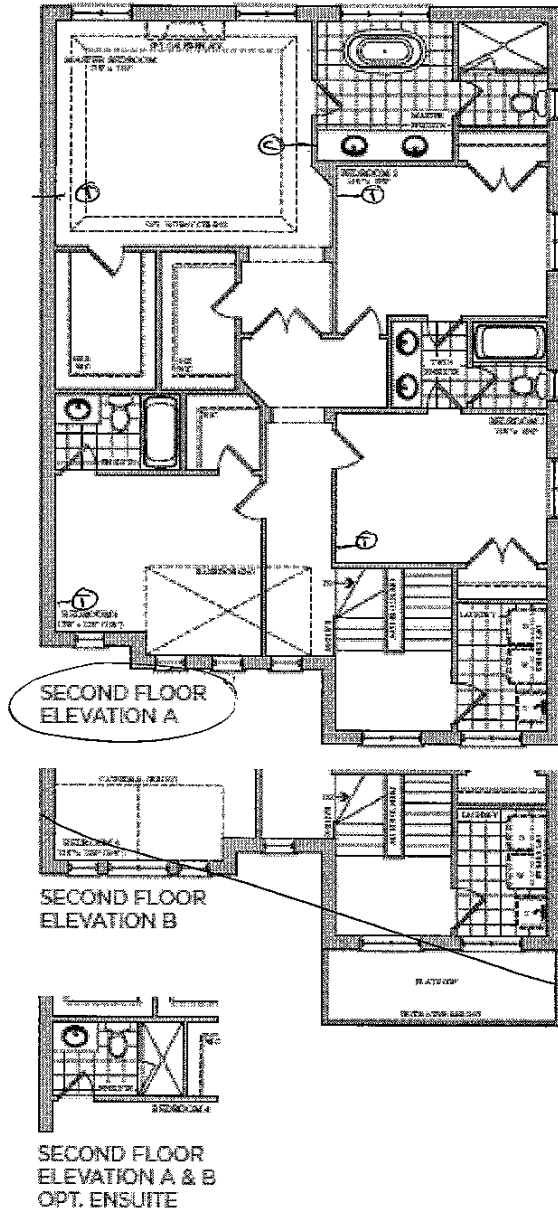

Lot 55  
 The Brahms (A)


April 7, 2016

① ②




Lot 55  
The Brahms (A)  
April 7, 2016  
AO

Enlarge to  
46" x 32" H

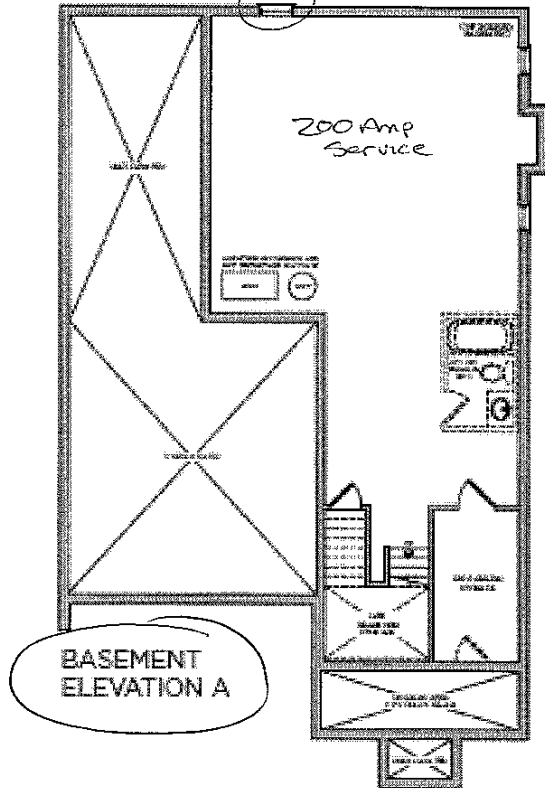

© 2016 GCA/peak. All rights reserved. This document is for informational purposes only. It is not a contract. Please consult your agent for more information.

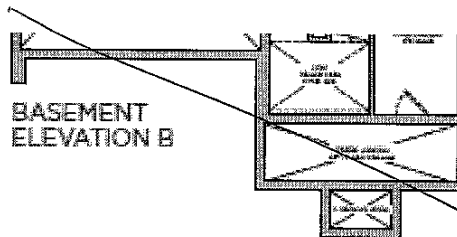

Lot 55  
The Brahms (A)

April 7, 2016

*(Signature)*



Stacey Carlete  
Project Coordinator



Claude Azzopardi  
Contracts Manager



Nancy Mc  
Corporate C

55  
Lot #



| Model            | 38.1 The Bizet        |   |                    |
|------------------|-----------------------|---|--------------------|
| Elevation        | Circle One            | A | 2189.6 Square Feet |
|                  |                       | B | 2186.7 Square Feet |
| Optional Layouts | Circle All that Apply |   |                    |
|                  |                       |   |                    |
|                  |                       |   |                    |
|                  |                       |   |                    |

| Model            | 38.2 The Ravel        |   |                    |
|------------------|-----------------------|---|--------------------|
| Elevation        | Circle One            | A | 2271.5 Square Feet |
|                  |                       | B | 2273.7 Square Feet |
| Optional Layouts | Circle All that Apply |   |                    |
|                  |                       |   |                    |
|                  |                       |   |                    |
|                  |                       |   |                    |

| Model            | 38.3 The Haydn        |   |                    |
|------------------|-----------------------|---|--------------------|
| Elevation        | Circle One            | A | 2394.5 Square Feet |
|                  |                       | B | 2388.3 Square Feet |
| Optional Layouts | Circle All that Apply |   |                    |
|                  |                       |   |                    |
|                  |                       |   |                    |
|                  |                       |   |                    |

| Model            | 38.4 The Vivaldi      |   |                    |
|------------------|-----------------------|---|--------------------|
| Elevation        | Circle One            | A | 2459.1 Square Feet |
|                  |                       | B | 2459.1 Square Feet |
| Optional Layouts | Circle All that Apply |   |                    |
|                  |                       |   |                    |
|                  |                       |   |                    |
|                  |                       |   |                    |

| Model            | 38.5 The Handel       |   |                    |
|------------------|-----------------------|---|--------------------|
| Elevation        | Circle One            | A | 2549.2 Square Feet |
|                  |                       | B | 2554.7 Square Feet |
| Optional Layouts | Circle All that Apply |   |                    |
|                  |                       |   |                    |
|                  |                       |   |                    |
|                  |                       |   |                    |

| Model            | 38.9 The Puccini      |      |                                          |
|------------------|-----------------------|------|------------------------------------------|
| Elevation        | Circle One            | A    | 3628.0 Square Feet                       |
|                  |                       | B    | 3634.7 Square Feet                       |
| Optional Layouts | Circle All that Apply | GFA1 | GROUND FLOOR Optional Alternative Layout |
|                  |                       |      |                                          |
|                  |                       |      |                                          |
|                  |                       |      |                                          |

| Model            | 38.6 The Scarlatti    |      |                                          |
|------------------|-----------------------|------|------------------------------------------|
| Elevation        | Circle One            | A    | 3521.1 Square Feet                       |
|                  |                       | B    | 3508.1 Square Feet                       |
| Optional Layouts | Circle All that Apply | GFA1 | GROUND FLOOR Optional Alternative Layout |
|                  |                       |      |                                          |
|                  |                       |      |                                          |
|                  |                       |      |                                          |

| Model            | 38.7 The Schubert     |      |                                          |
|------------------|-----------------------|------|------------------------------------------|
| Elevation        | Circle One            | A    | 3593.8 Square Feet                       |
|                  |                       | B    | 3610.5 Square Feet                       |
| Optional Layouts | Circle All that Apply | GFA1 | GROUND FLOOR Optional Alternative Layout |
|                  |                       | SFA4 | SECOND FLOOR Additional Bedroom          |
|                  |                       |      |                                          |
|                  |                       |      |                                          |

| Model            | 38.8 The Corelli      |      |                                            |
|------------------|-----------------------|------|--------------------------------------------|
| Elevation        | Circle One            | A    | 3801.5 Square Feet                         |
|                  |                       | B    | 3801.5 Square Feet                         |
| Optional Layouts | Circle All that Apply | GFA1 | GROUND FLOOR Optional Alternative Layout   |
|                  |                       | SFA4 | SECOND FLOOR Additional Bedroom w/ Ensuite |
|                  |                       |      |                                            |
|                  |                       |      |                                            |

| Model            | 41.1 The Strauss      |      |                                       |
|------------------|-----------------------|------|---------------------------------------|
| Elevation        | Circle One            | A    | 2554.2 Square Feet                    |
|                  |                       | B    | 2571.2 Square Feet                    |
| Optional Layouts | Circle All that Apply | SFA1 | SECOND FLOOR Shower in Lieu of Tub B2 |
|                  |                       |      |                                       |
|                  |                       |      |                                       |
|                  |                       |      |                                       |

| Model            | 41.2 The Mozart       |      |                                       |
|------------------|-----------------------|------|---------------------------------------|
| Elevation        | Circle One            | A    | 2725.9 Square Feet                    |
|                  |                       | B    | 2711.1 Square Feet                    |
| Optional Layouts | Circle All that Apply | SFA1 | SECOND FLOOR Shower in Lieu of Tub B2 |
|                  |                       |      |                                       |
|                  |                       |      |                                       |
|                  |                       |      |                                       |

| Model            | 41.3 The Chopin       |   |                    |
|------------------|-----------------------|---|--------------------|
| Elevation        | Circle One            | A | 2800.0 Square Feet |
|                  |                       | B | 2810.5 Square Feet |
| Optional Layouts | Circle All that Apply |   |                    |
|                  |                       |   |                    |
|                  |                       |   |                    |
|                  |                       |   |                    |

| Model            | 41.4 The Bach         |   |                    |
|------------------|-----------------------|---|--------------------|
| Elevation        | Circle One            | A | 2894.4 Square Feet |
|                  |                       | B | 2894.5 Square Feet |
| Optional Layouts | Circle All that Apply |   |                    |
|                  |                       |   |                    |
|                  |                       |   |                    |
|                  |                       |   |                    |

| Model            | 41.5 The Brahms       |      |                                          |
|------------------|-----------------------|------|------------------------------------------|
| Elevation        | Circle One            | A    | 3948.1 Square Feet                       |
|                  |                       | B    | 3949.1 Square Feet                       |
| Optional Layouts | Circle All that Apply | GFA1 | GROUND FLOOR Optional Alternative Layout |
|                  |                       | SFA2 | SECOND FLOOR Shower in Lieu of Tub B4    |
|                  |                       | SFA3 | SECOND FLOOR Optional Laundry Layout     |
|                  |                       |      |                                          |

| Model            | 41.6 The Verdi        |      |                                          |
|------------------|-----------------------|------|------------------------------------------|
| Elevation        | Circle One            | A    | 3862.5 Square Feet                       |
|                  |                       | B    | 3866.4 Square Feet                       |
| Optional Layouts | Circle All that Apply | GFA1 | GROUND FLOOR Optional Alternative Layout |
|                  |                       | SFA3 | SECOND FLOOR Optional Laundry Layout     |
|                  |                       |      |                                          |
|                  |                       |      |                                          |

April 7, 2016

