

CONSTRUCTION SUMMARY

59 - 1 - 41-5 Elev.A BRAHMS

CENTRAL VAC AND WIRING

Inv.444	1 - BEDROOM #4: INSTALL RG 6 ROUGH-IN IN BEDROOM #4, SEE SKETCH
Line5881	Note:
20Apr16 / 19May16	

ELECTRICAL

Inv.444	1 - TELEPHONE AND CABLE ROUGH-IN LOCATIONS
Line5880	Note:
20Apr16 / 19May16	

Inv.444	1 - KITCHEN: INSTALL 110V WALL RECEPTACLE ON DEDICATED CIRCUIT - FOR MICROWAVE - MICROWAVE NOT INCLUDED. TO GO ABOVE STOVE
Line5882	Note:
20Apr16 / 19May16	

EXTERIOR COLOURS

Inv.431	1 - EXTERIOR COLOUR PACKAGE 1
Line5200	Note:
15Apr16 / 20Apr16	

FRAMING

Inv.507	1 - INTERIOR DOORS EXTENDED HEIGHT 96"- ON ALL CLOSETS, POWDER ROOM, PANTRY AND DEN
Line6137	Note:
19May16 / 19May16	

INTERIOR TRIM AND DOORS

Inv.444	5 - MAIN FLOOR: INSTALL FIVE (X5) STANDARD DOORS EXTENDED HEIGHT 96" (PRICE PER DOOR) MAIN FLOOR 3 STOREY MODELS - TO GO ON CLOSETS, POWDER ROOM AND PANTRY. SEE SKETCH
Line5885	Note:
20Apr16 / 19May16	
Inv.444	2 - DEN: INSTALL TWO (X2) STANDARD FRENCH DOORS EXTENDED HEIGHT 96" (PRICE PER DOOR) MAIN FLOOR 3 STOREY MODELS - TO GO AT DEN
Line5886	Note:
20Apr16 / 19May16	

MISC.

Inv.431	1 - BONUS DECOR DOLLARS \$10 000.00 TOTAL PURCHASES (-\$3 463.45) REMAINING DECOR DOLLARS \$ 6 536.55
Line5146	Note:
15Apr16 / 20Apr16	
Inv.431	1 - Purchaser acknowledges that purchases are final and subject to head office approval.
Line5201	Note:
15Apr16 / 20Apr16	

CONSTRUCTION SUMMARY

59 - 1 - 41-5 Elev.A BRAHMS

Inv.444	1 - BONUS PACKAGE: \$4627.35 (INCLUDING TAXES) WORTH OF UPGRADES FROM GOLD PARK HOMES DÉCOR CENTRE IS BEING APPLIED TOWARD THE STRUCTURAL APPOINTMENT. PURCHASER HAS A REMAINING AMOUNT OF \$1909.20 (INCLUDING TAXES) TO BE USED TOWARD THE COLOUR APPOINTMENT.
Line5888	Note:
20Apr16 / 19May16	
Inv.444	1 - Purchaser has attended a Structural appointment at the Decor Centre & has DECLINED any additional upgrades and accepts and acknowledges that there will be no further structural changes/additions/deletions to be made upon signing on May 9, 2016
Line5889	Note:
20Apr16 / 19May16	
Inv.444	1 - Purchasers are aware & accepts that ANY changes made to upgrades after signing this Purchasers Extra Form are subject to a minimum administration fee of \$500. PLUS a 10% holdback fee.
Line5890	Note:
20Apr16 / 19May16	

PLUMBING

Inv.431	1 - ROUGH-IN - 3PC BASEMENT ROUGH-IN
Line5145	Note:
15Apr16 / 20Apr16	
Inv.444	1 - KITCHEN: INSTALL ROUGH-IN - WATERLINE FOR FRIDGE
Line5887	Note:
20Apr16 / 19May16	

WINDOWS - BASEMENT

Inv.431	1 - BASEMENT WINDOWS - UPGRADE EXISTING BASEMENT WINDOW TO 53 INCH X 16 INCH EGRESS
Line5143	Note: PENDING CONSTRUCTION APPROVAL
15Apr16 / 20Apr16	
Inv.431	2 - BASEMENT WINDOWS - UPGRADE EXISTING BASEMENT WINDOW TO 30 INCH X 24 INCH - MAY REQUIRE INSTALLATION OF WINDOW WELL
Line5144	Note:
15Apr16 / 20Apr16	

WINDOWS AND DOORS


Inv.444	1 - GARAGE: INSTALL MAN DOOR GARAGE TO HOUSE - OPTIONAL - IF GRADE PERMITS
Line5379	Note:
20Apr16 / 19May16	

encore
BRAMPTON

Telephone — (T)
Cable — (C)
Electrical — (E)

The Brahms 41' SERIES

Elevation A • 4,038 sq.ft. | Elevation B • 4,038 sq.ft.

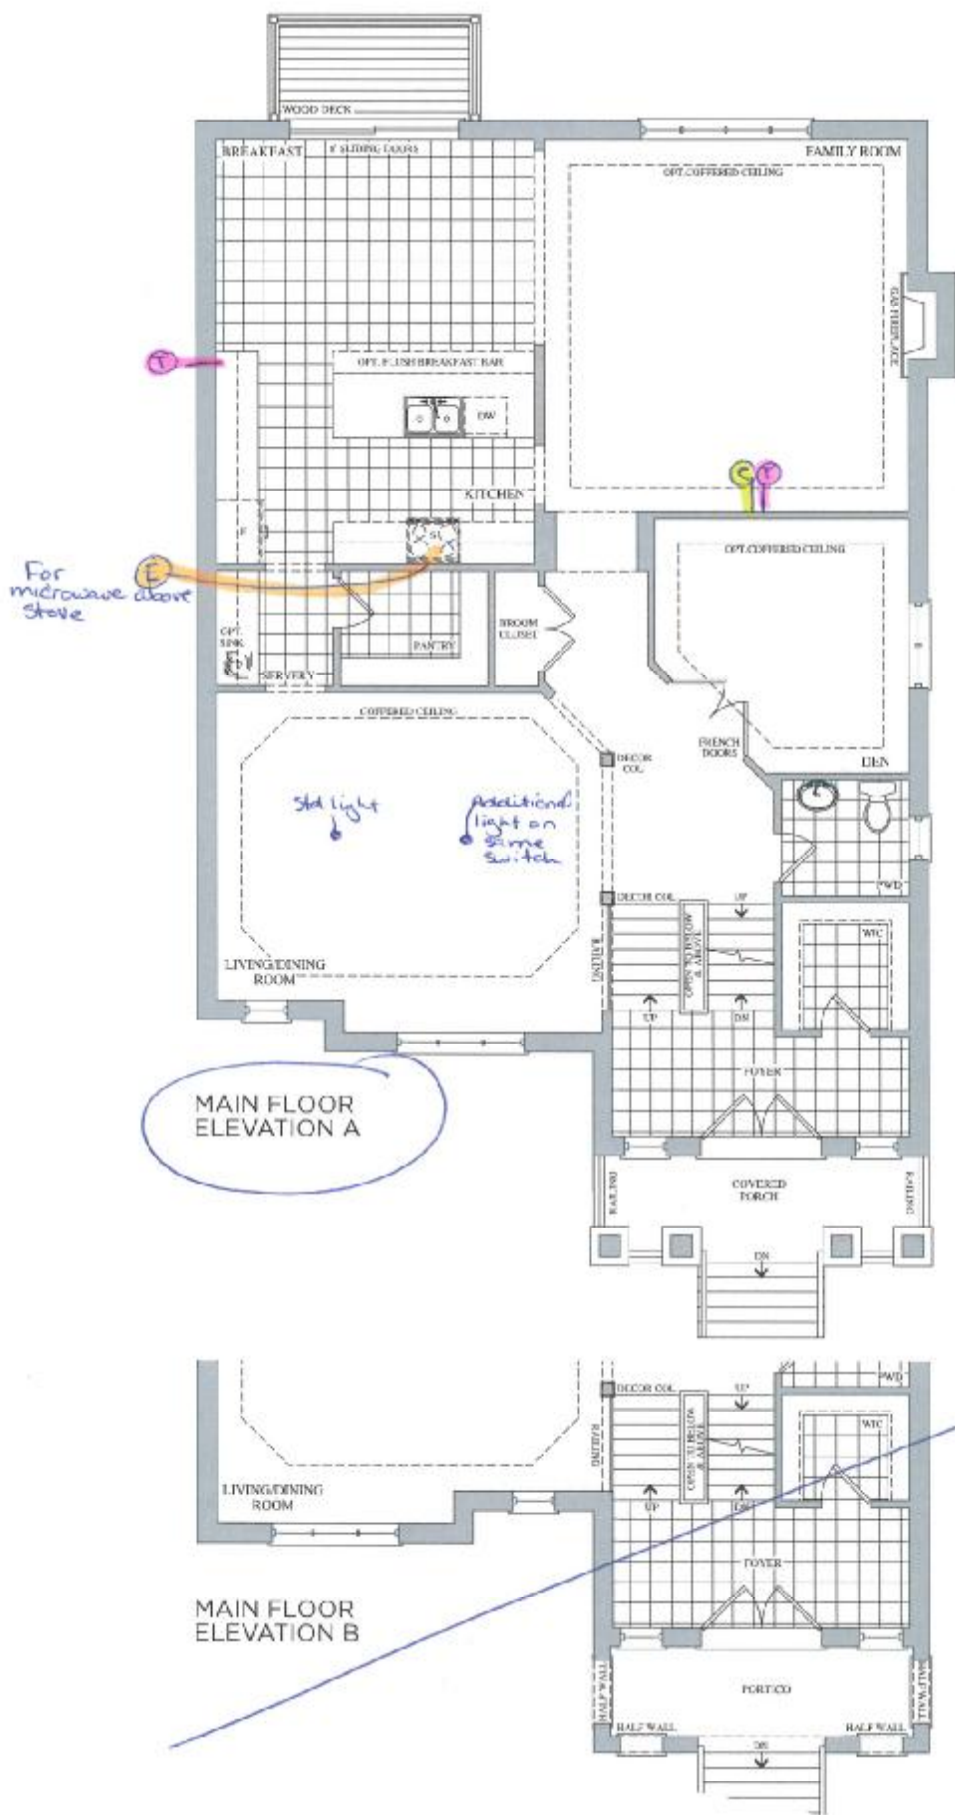


Prices, figures, illustrations, sizes, features and finishes are subject to change without notice. E.&O.E. Areas and dimensions are approximate and actual usable floor space may vary from the stated area. Layout may be reverse of the unit purchased. E. & O.E.

GOLDPARK
HOMES

The Brahms 41' SERIES

Elevation A • 4,038 sq.ft. | Elevation B • 4,038 sq.ft.

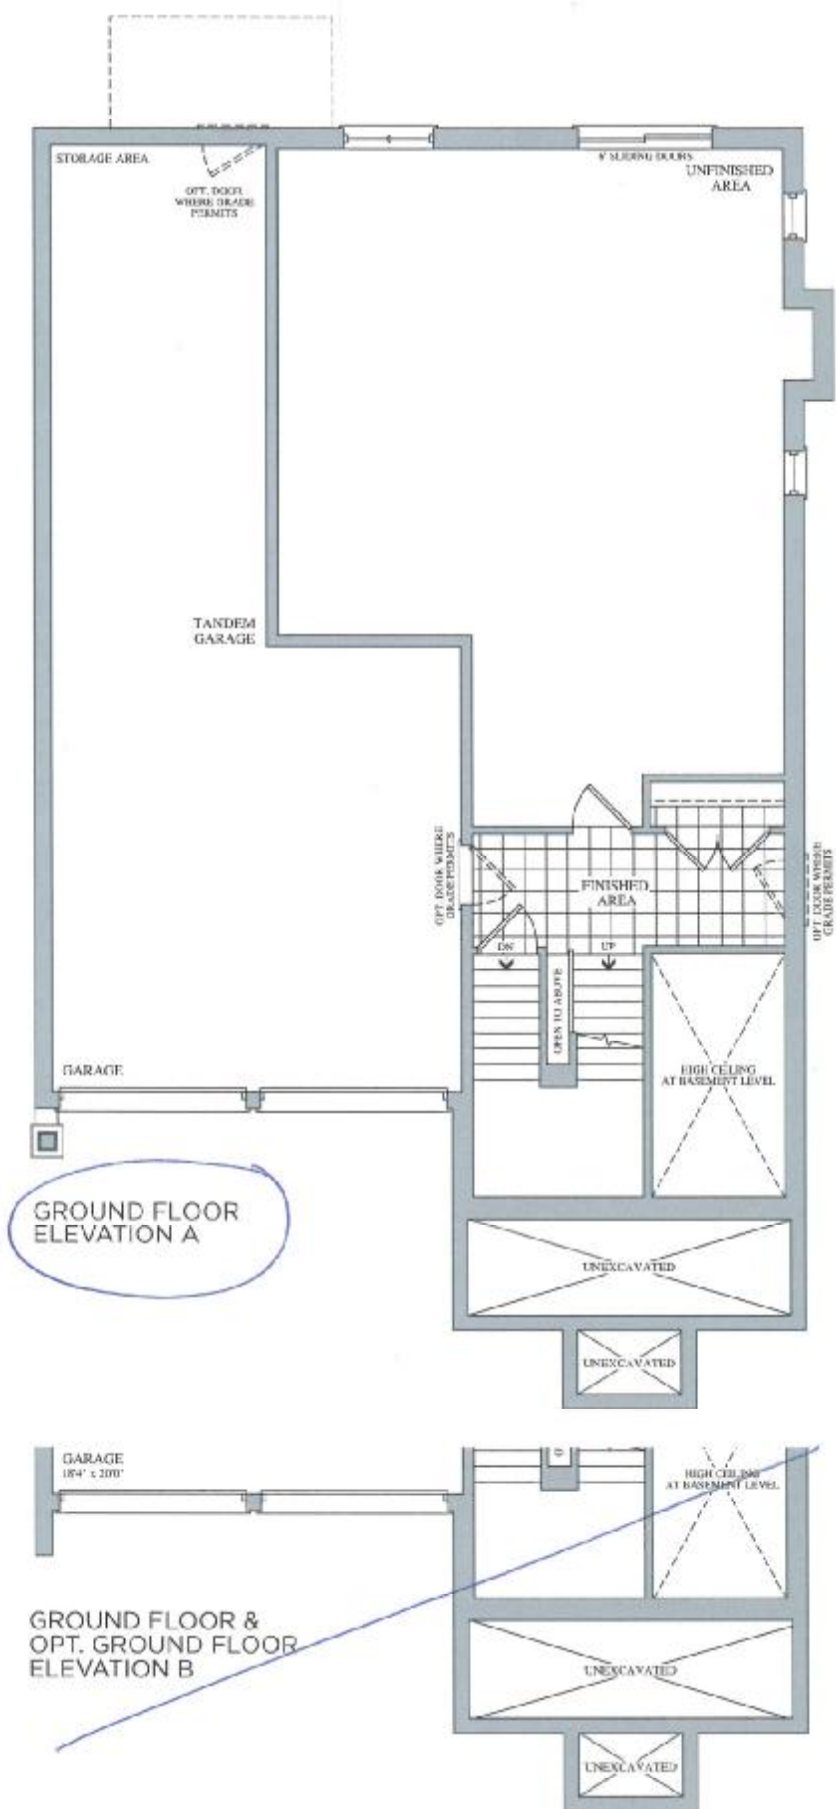

Prices, figures, illustrations, sizes, features and finishes are subject to change without notice. E&O.E. Areas and dimensions are approximate and actual usable floor space may vary from the stated area. Layout may be reverse of the unit purchased. E. & O.E.



The
Brahms
41' SERIES

BSMART WINDOWS

1 x 53" x 16"

2 x 30" x 24"

Elevation A • 4,038 sq.ft. | Elevation B • 4,038 sq.ft.

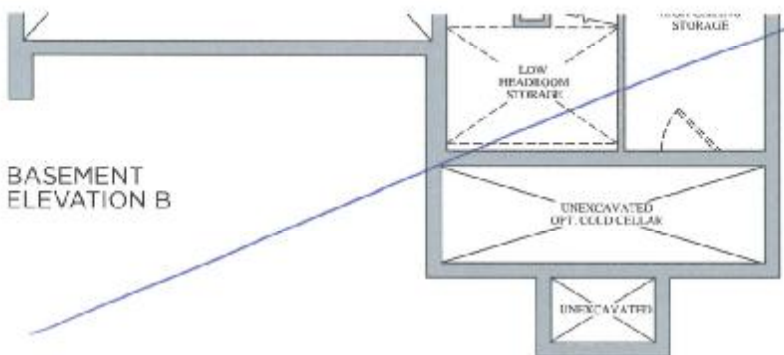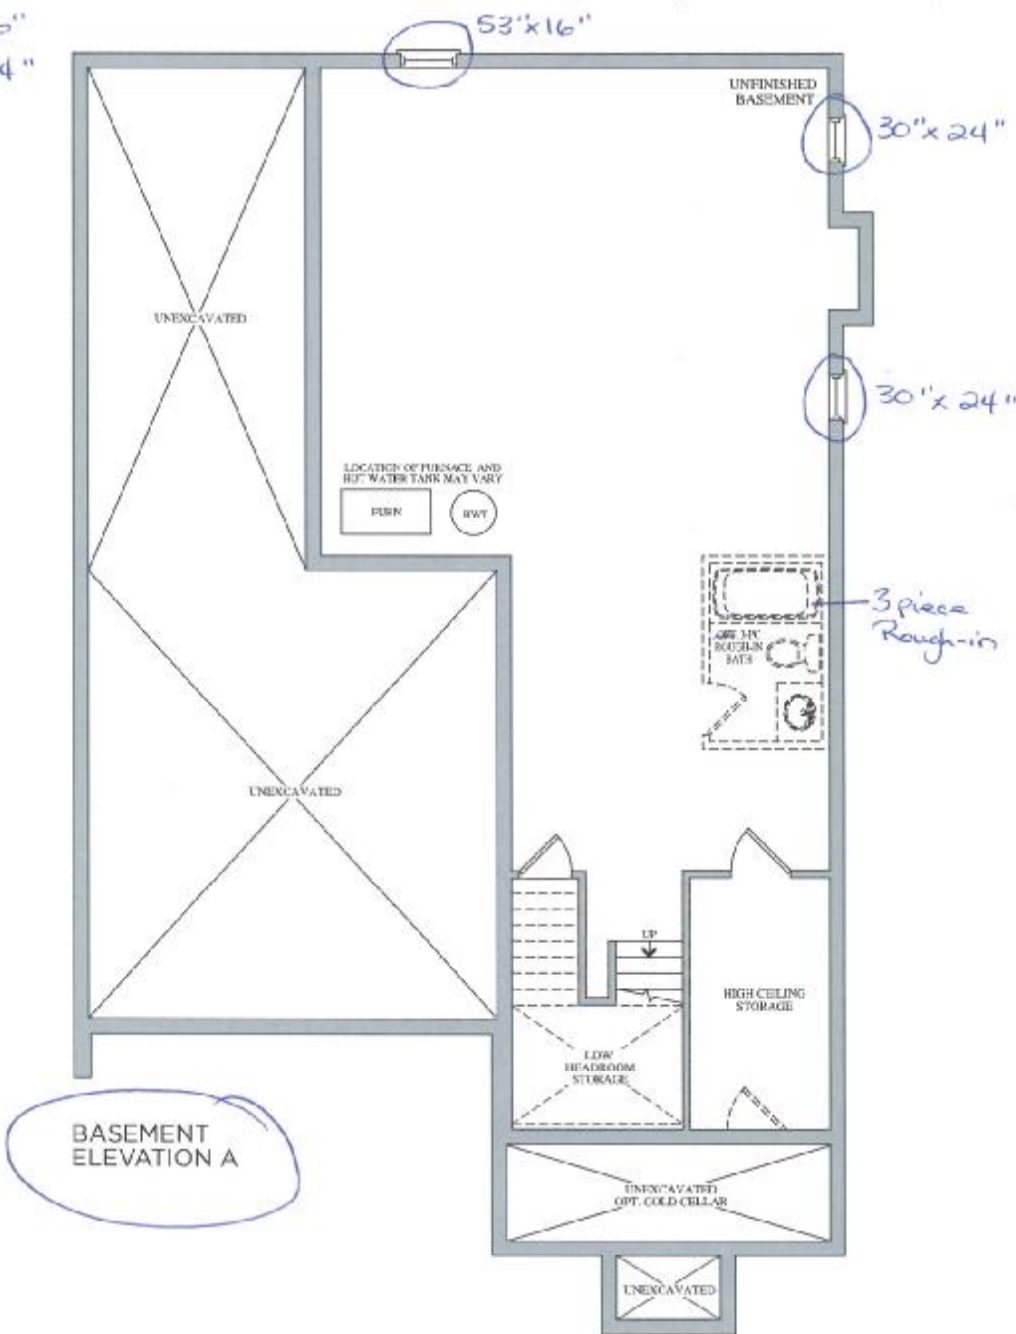

Lot 59
May 9, 16

DA



Stacey Carlete
Project Coordinator



Claude Azzopardi
Contracts Manager



Nancy Moore
Corporate Counsel

59
Lot #



Model 38.1 The Bizet			
Elevation	Circle One	A	2189.5 Square Feet
		B	2186.7 Square Feet
Optional Layouts	Circle All that Apply		

Model 38.2 The Ravel			
Elevation	Circle One	A	2271.5 Square Feet
		B	2273.7 Square Feet
Optional Layouts	Circle All that Apply		

Model 38.3 The Haydn			
Elevation	Circle One	A	2394.5 Square Feet
		B	2388.3 Square Feet
Optional Layouts	Circle All that Apply		

Model 38.4 The Vivaldi			
Elevation	Circle One	A	2459.1 Square Feet
		B	2459.1 Square Feet
Optional Layouts	Circle All that Apply		

Model 38.5 The Handel			
Elevation	Circle One	A	2549.2 Square Feet
		B	2554.7 Square Feet
Optional Layouts	Circle All that Apply		

Model 38.9 The Puccini			
Elevation	Circle One	A	3628.0 Square Feet
		B	3634.7 Square Feet
Optional Layouts	Circle All that Apply	GFA1	GROUND FLOOR Optional Alternative Layout

Model 38.6 The Scarlatti			
Elevation	Circle One	A	3521.1 Square Feet
		B	3508.1 Square Feet
Optional Layouts	Circle All that Apply	GFA1	GROUND FLOOR Optional Alternative Layout

Model 38.7 The Schubert			
Elevation	Circle One	A	3593.8 Square Feet
		B	3610.5 Square Feet
Optional Layouts	Circle All that Apply	GFA1	GROUND FLOOR Optional Alternative Layout
		SFA4	SECOND FLOOR Additional Bedroom
Optional Layouts	Circle All that Apply		

Model 38.8 The Corelli			
Elevation	Circle One	A	3801.5 Square Feet
		B	3801.5 Square Feet
Optional Layouts	Circle All that Apply	GFA1	GROUND FLOOR Optional Alternative Layout
		SFA4	SECOND FLOOR Additional Bedroom w/ Ensuite
Optional Layouts	Circle All that Apply		

Model 41.1 The Strauss			
Elevation	Circle One	A	2554.2 Square Feet
		B	2571.2 Square Feet
Optional Layouts	Circle All that Apply	SFA3	SECOND FLOOR Shower in Lieu of Tub #2

Model 41.2 The Mozart			
Elevation	Circle One	A	2725.9 Square Feet
		B	2711.1 Square Feet
Optional Layouts	Circle All that Apply	SFA1	SECOND FLOOR Shower in Lieu of Tub #2

Model 41.3 The Chopin			
Elevation	Circle One	A	2800.0 Square Feet
		B	2810.5 Square Feet
Optional Layouts	Circle All that Apply		

Model 41.4 The Bach			
Elevation	Circle One	A	2894.4 Square Feet
		B	2894.5 Square Feet
Optional Layouts	Circle All that Apply		

Model 41.5 The Brahms			
Elevation	Circle One	A	3948.1 Square Feet
		B	3949.1 Square Feet
Optional Layouts	Circle All that Apply	GFA1	GROUND FLOOR Optional Alternative Layout
		SFA2	SECOND FLOOR Shower in Lieu of Tub B4
Optional Layouts	Circle All that Apply	SFA3	SECOND FLOOR Optional Laundry Layout

Model 41.6 The Verdi			
Elevation	Circle One	A	3862.5 Square Feet
		B	3866.4 Square Feet
Optional Layouts	Circle All that Apply	GFA1	GROUND FLOOR Optional Alternative Layout
		SFA3	SECOND FLOOR Optional Laundry Layout
Optional Layouts	Circle All that Apply		

May 9, 16
P.A.