

Structural
CONSTRUCTION SUMMARY

92 - 1 - 41-6 Elev.A VERDI

CENTRAL VAC AND WIRING

Inv.417	1 - FAMILY ROOM: CONDUIT PIPE- FOR TELEVISION- MUST SPECIFY LOCATION AND TERMINATION POINT. SEE SKETCH
Line4974	Note:
11Apr16 / 20Apr16	

ELECTRICAL

Inv.417	1 - TELEPHONE AND CABLE ROUGH-IN LOCATIONS. SEE SKETCH. PURCHASER DID NOT WANT TELEPHONE IN KITCHEN AND PUT THE STANDARD FAMILY ROOM ROUGH-IN INTO THE DEN. NO CREDIT GIVEN
Line4971	Note:
11Apr16 / 20Apr16	

Inv.417	1 - LIVING ROOM: INSTALL ROUGH - IN CEILING OUTLET & SWITCH (WITH COVER PLATE) - DOES NOT INCLUDE FIXTURE - SEE SKETCH. IN ADDITION TO BUILDER'S STANDARD SWITCH CONTROLLED RECEPTICAL
Line4973	Note:
11Apr16 / 20Apr16	

Inv.417	1 - FAMILY ROOM: 110V WALL RECEPTACLE ON DEDICATED CIRCUIT - ABOVE FIREPLACE PLACE
Line4975	Note:
11Apr16 / 20Apr16	

EXTERIOR COLOURS

Inv.453	1 - EXTERIOR COLOUR PACKAGE 6
Line5471	Note:
26Apr16 / 26Apr16	

FORMING

Inv.417	1 - EXTERIOR:SIDE YARD: SIDE DOOR- HOME TO EXTERIOR- AS PER PLAN AND GRADE PERMITTING
Line4976	Note:
11Apr16 / 20Apr16	

Inv.417	1 - EXTERIOR: REAR OF GARAGE: SIDE DOOR- GARAGE TO EXTERIOR- AS PER PLAN AND GRADE PERMITTING
Line4977	Note:
11Apr16 / 20Apr16	

MISC.

Inv.417	1 - Purchaser has attended a colour chart appointment at the Decor Centre & has DECLINED any additional upgrades and accepts and acknowledges that there will be no further structural changes/additions/deletions to be made upon signing on April 11,2016
Line4981	Note:
11Apr16 / 20Apr16	

Inv.417	1 - Purchasers are aware & accepts that ANY changes made to upgrades after signing this Purchasers Extra Form are subject to a minimum administration fee of \$500. PLUS a 10% holdback fee
Line4982	Note:
11Apr16 / 20Apr16	

PLUMBING



CONSTRUCTION SUMMARY

92 - 1 - 41-6 Elev.A VERDI

Inv.417	1 - BASEMENT: INSTALL ROUGH-IN - 3PC BASEMENT ROUGH-IN, AS PER PLAN
Line4978	Note:
11Apr16 / 20Apr16	
Inv.417	1 - HOSE BIB - REAR HOSE BIB: STANDARD TO UPGRADED WITH HOT AND COLD WATER VALVE
Line4980	Note: HOSE BIB IN GARAGE TO REMAIN STANDARD
11Apr16 / 20Apr16	

WINDOWS - BASEMENT


Inv.417	3 - BASEMENT WINDOWS - THREE (3) UPGRADE EXISTING BASEMENT WINDOW TO 30 INCH X 24 INCH - MAY REQUIRE INSTALLATION OF WINDOW WELL.
Line4983	Note:
11Apr16 / 20Apr16	

WINDOWS AND DOORS

Inv.453	1 - MAN DOOR GARAGE TO HOUSE - OPTIONAL - IF GRADE PERMITS AS PER APS
Line5472	Note:
26Apr16 / 26Apr16	

Telephone — (T)

Cable — (C)

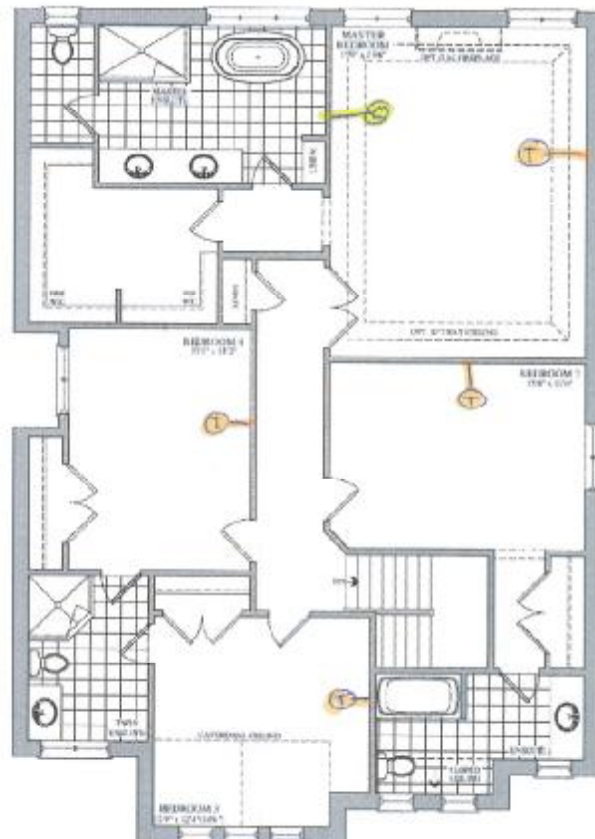

SECOND FLOOR
ELEVATION A



SECOND FLOOR
ELEVATION B



Elevation A - 3,409 sq. ft.



Elevation B - 3,409 sq. ft.




goldpark

THE GOLD PARK HOMES ARE DESIGNED AND BUILT BY GOLD PARK HOMES, INC. 1000 N. 10TH AVE. SUITE 100, DENVER, CO 80202. 303.733.7333

Lot 92
April 11, 2016

(Signature) (Signature)


Telephone — ①

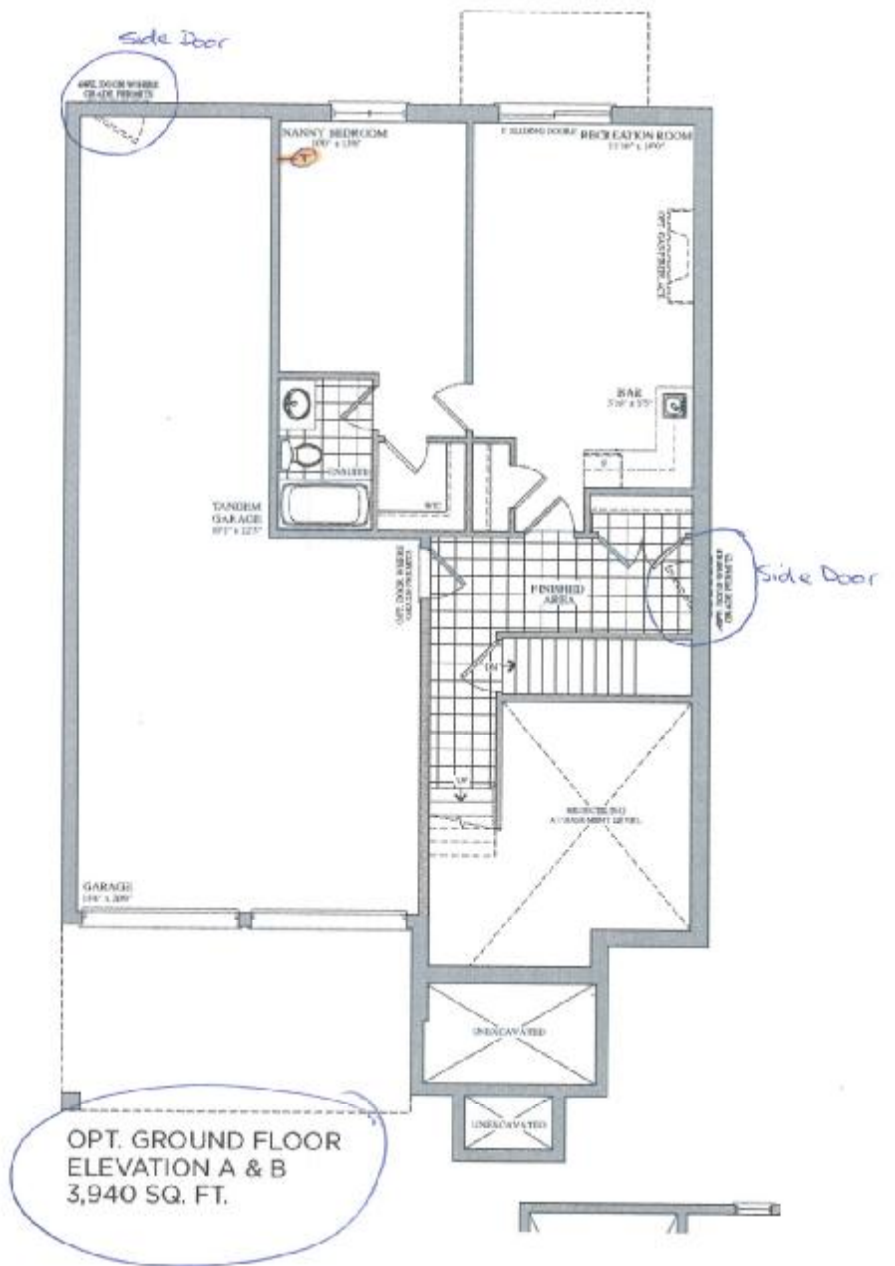

Lot 92
April 11, 2016



3x 30"x24"

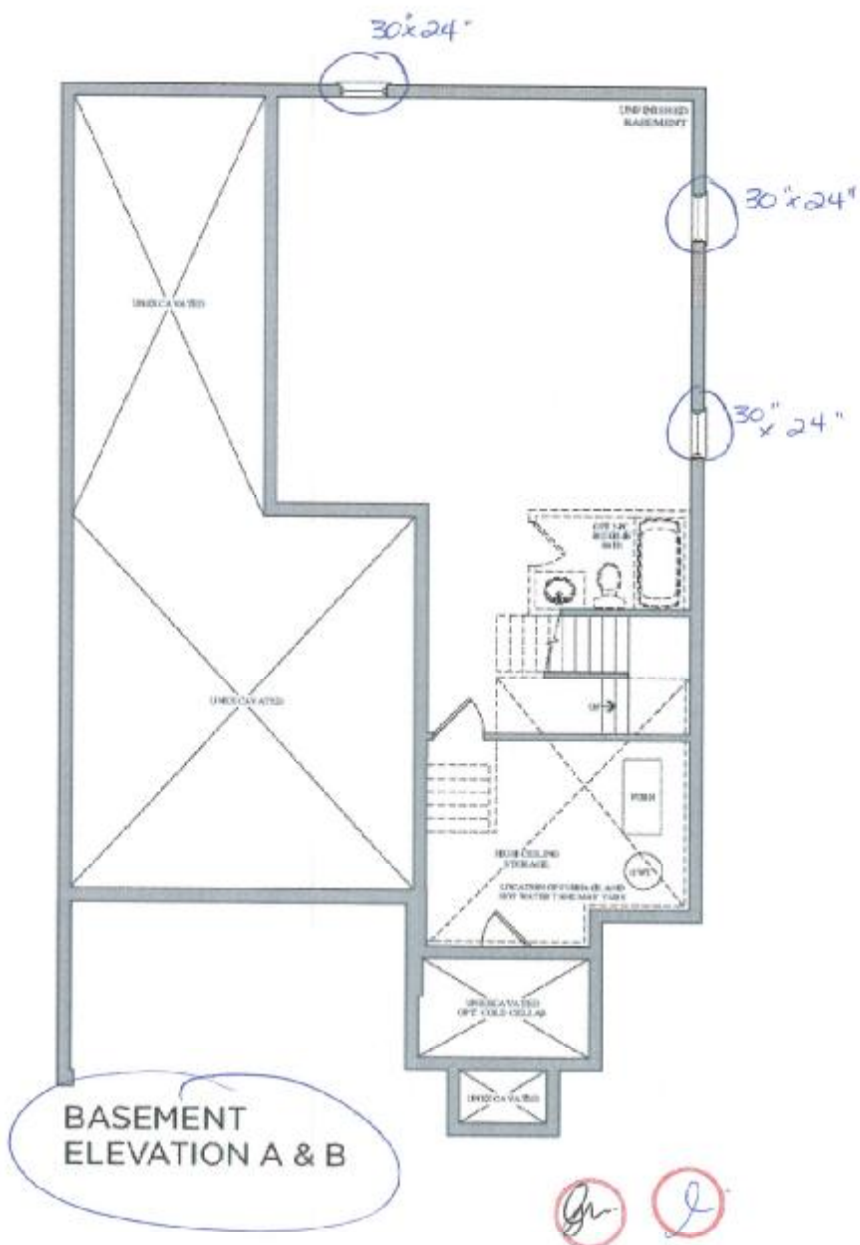

Lot 92
April 11, 2016



Stacey Carlete
Project Coordinator



Claude Azzopardi
Contracts Manager



Nancy McCorporate

92
Lot #



38.1 The Bizet			
Elevation	Circle One	A	2189.6 Square Feet
		B	2186.7 Square Feet
Optional Layouts	Circle All that Apply		

38.2 The Ravel			
Elevation	Circle One	A	2271.5 Square Feet
		B	2273.7 Square Feet
Optional Layouts	Circle All that Apply		

38.3 The Haydn			
Elevation	Circle One	A	2394.5 Square Feet
		B	2388.3 Square Feet
Optional Layouts	Circle All that Apply		

38.4 The Vivaldi			
Elevation	Circle One	A	2459.1 Square Feet
		B	2459.1 Square Feet
Optional Layouts	Circle All that Apply		

38.5 The Handel			
Elevation	Circle One	A	2549.2 Square Feet
		B	2554.7 Square Feet
Optional Layouts	Circle All that Apply		

38.9 The Puccini			
Elevation	Circle One	A	3628.0 Square Feet
		B	3634.7 Square Feet
Optional Layouts	Circle All that Apply	GFA1	GROUND FLOOR Optional Alternative Layout

38.6 The Scarlatti			
Elevation	Circle One	A	3521.1 Square Feet
		B	3508.1 Square Feet
Optional Layouts	Circle All that Apply	GFA1	GROUND FLOOR Optional Alternative Layout

38.7 The Schubert			
Elevation	Circle One	A	3593.8 Square Feet
		B	3610.5 Square Feet
Optional Layouts	Circle All that Apply	GFA1	GROUND FLOOR Optional Alternative Layout
		SFA4	SECOND FLOOR Additional Bedroom

38.8 The Corelli			
Elevation	Circle One	A	3801.5 Square Feet
		B	3801.5 Square Feet
Optional Layouts	Circle All that Apply	GFA1	GROUND FLOOR Optional Alternative Layout
		SFA4	SECOND FLOOR Additional Bedroom w/ Ensuite

41.1 The Strauss			
Elevation	Circle One	A	2594.2 Square Feet
		B	2571.2 Square Feet
Optional Layouts	Circle All that Apply	SFA1	SECOND FLOOR Shower in Lieu of Tub B2

41.2 The Mozart			
Elevation	Circle One	A	2725.9 Square Feet
		B	2711.1 Square Feet
Optional Layouts	Circle All that Apply	SFA1	SECOND FLOOR Shower in Lieu of Tub B2

41.3 The Chopin			
Elevation	Circle One	A	2800.0 Square Feet
		B	2810.5 Square Feet
Optional Layouts	Circle All that Apply		

41.4 The Bach			
Elevation	Circle One	A	2834.4 Square Feet
		B	2834.5 Square Feet
Optional Layouts	Circle All that Apply		

41.5 The Brahms			
Elevation	Circle One	A	3948.1 Square Feet
		B	3945.1 Square Feet
Optional Layouts	Circle All that Apply	GFA1	GROUND FLOOR Optional Alternative Layout
		SFA2	SECOND FLOOR Shower in Lieu of Tub B4
		SFA3	SECOND FLOOR Optional Laundry Layout

41.6 The Verdi			
Elevation	Circle One	A	3862.3 Square Feet
		B	3866.4 Square Feet
Optional Layouts	Circle All that Apply	GFA1	GROUND FLOOR Optional Alternative Layout
		SFA3	SECOND FLOOR Optional Laundry Layout

April 11, 2016

