

Structural
CONSTRUCTION SUMMARY

96 - 1 - 41-5 Elev.A BRAHMS OPT - GFA1

CENTRAL VAC AND WIRING

Inv.419	1 - FAMILY ROOM: INSTALL CONDUIT PIPE- FOR TELEVISION- MUST SPECIFY LOCATION AND TERMINATION POINT. SEE FLOOR PLAN
Line4988	Note:
12Apr16 / 20Apr16	
Inv.419	1 - BEDROOM #4: RG 6 WIRING - INSTALL ROUGH-IN RG 6- IN BED #4. SEE FLOOR PLAN
Line4990	Note:
12Apr16 / 20Apr16	
Inv.419	1 - DEN: RG 6 WIRING - INSTALL ROUGH-IN RG 6- IN DEN. SEE FLOOR PLAN
Line4991	Note:
12Apr16 / 20Apr16	
Inv.419	1 - NANNY BEDROOM: RG 6 WIRING - INSTALL ROUGH-IN RG 6- IN NANNY BEDROOM. SEE FLOOR PLAN
Line4992	Note:
12Apr16 / 20Apr16	

ELECTRICAL

Inv.419	1 - TELEPHONE AND CABLE ROUGH-IN LOCATIONS. SEE SKETCH
Line4987	Note:
12Apr16 / 20Apr16	
Inv.419	1 - FAMILY ROOM: INSTALL 110V WALL RECEPTACLE ON DEDICATED CIRCUIT - ABOVE FIREPLACE
Line4989	Note:
12Apr16 / 20Apr16	
Inv.419	1 - KITCHEN: INSTALL 110V WALL RECEPTACLE ON DEDICATED CIRCUIT - FOR FUTURE MICROWAVE - MICROWAVE NOT INCLUDED. CABINETRY TO BE PURCHASED AT THE TIME OF COLOURS
Line4993	Note:
12Apr16 / 20Apr16	
Inv.419	1 - KITCHEN: INSTALL 220V WALL RECEPTICAL ON DEDICATED CIRCUIT- FOR FUTRE 4 WIRE BUILT-IN WALL OVEN - SEE SKETCH. CABINETRY TO BE PURCHASED AT THE TIME OF COLOUR APPOINTMENT
Line4994	Note:
12Apr16 / 20Apr16	
Inv.419	1 - BASEMENT: INSTALL 200 AMP ELECTRICAL SERVICE
Line4995	Note:
12Apr16 / 20Apr16	
Inv.419	1 - LIVING ROOM: INSTALL ROUGH - IN CEILING OUTLET & SWITCH (WITH COVER PLATE) - DOES NOT INCLUDE FIXTURE - MUST SPECIFY LOCATION. NOTE LOCATION OF STANDARD DINING ROOM LIGHT. KEEP BUILDER'S STANDARD SWITCH CONTROLLED RECEPTICAL
Line4996	Note:
12Apr16 / 20Apr16	
Inv.419	1 - KITCHEN: INSTALL KITCHEN CABINET VALANCE LIGHTS (UNDER CABINETS) - WITH STRIP LIGHTS - DOES NOT INCLUDE (AND REQUIRES) KITCHEN UPGRADE PRICING
Line4997	Note:
12Apr16 / 20Apr16	

EXTERIOR COLOURS



CONSTRUCTION SUMMARY

96 - 1 - 41-5 Elev.A BRAHMS OPT - GFA1

Inv.450	1 - EXTERIOR COLOUR PACKAGE 4
Line5468	Note:
26Apr16 / 26Apr16	

FORMING

Inv.419	1 - EXTERIOR: INSTALL SIDE DOOR- HOME TO EXTERIOR- AS PER PLAN AND GRADE PERMITTING
Line4998	Note:
12Apr16 / 20Apr16	

FRAMING

Inv.419	1 - SECOND FLOOR: SMOOTH CEILINGS - (3-Story Design) 2ND FLOOR
Line5000	Note:
12Apr16 / 20Apr16	
Inv.419	1 - BEDROOM #4: SHOWER IN LIEU OF TUB- INCLUDES FRAMED GLASS SHOWER ENCLOSURE- MUST ADD PLUMBING NOTE
Line5002	Note:
12Apr16 / 20Apr16	
Inv.419	1 - MAIN FLOOR: FIVE (5) STANDARD DOORS EXTENDED HEIGHT 96" (PRICE PER DOOR) MAIN FLOOR 3 STOREY MODELS - INCLUDE FRAMING NOTE. TO GO IN POWDER ROOM, 3 CLOSET DOORS, AND PANTRY. SEE SKETCH
Line5374	Note:
12Apr16 / 20Apr16	
Inv.419	1 - MAIN FLOOR: TWO (2) STANDARD FRENCH DOORS EXTENDED HEIGHT 96" (PRICE PER DOOR) MAIN FLOOR 3 STOREY MODELS - INCLUDE FRAMING NOTE. TWO DOORS AT DEN. SEE SKETCH
Line5375	Note:
12Apr16 / 20Apr16	
Inv.486	1 - OPTIONAL GROUND FLOOR LAYOUT
Line5844	Note:
5May16 / 5May16	

GARAGE DOORS

Inv.419	1 - GARAGE: ONE DIGITAL ENTRY KEYPAD.
Line5006	Note:
12Apr16 / 20Apr16	
Inv.419	2 - GARAGE: TWO (2) EXTRA REMOTE CONTROLS FOR GARAGE DOORS
Line5007	Note:
12Apr16 / 20Apr16	
Inv.419	2 - GARAGE: INSTALL TWO (2) GARAGE DOOR OPENERS - WITH 1 REMOTE EACH- PRICE IS PER DOOR
Line5008	Note:
12Apr16 / 20Apr16	

GLASS AND MIRROR

Inv.419	1 - BEDROOM #4: SHOWER IN LIEU OF TUB- INCLUDES FRAMED GLASS SHOWER ENCLOSURE
Line5373	Note:
12Apr16 / 20Apr16	



CONSTRUCTION SUMMARY

96 - 1 - 41-5 Elev.A BRAHMS OPT - GFA1

HVAC

Inv.419	1 - KITCHEN: GAS LINE ROUGH - MAIN FLOOR - (3 STOREY MODELS) FOR STOVE
Line5005	Note:
12Apr16 / 20Apr16	

INTERIOR TRIM AND DOORS

Inv.419	5 - MAIN FLOOR: FIVE (5) STANDARD DOORS EXTENDED HEIGHT 96" (PRICE PER DOOR) MAIN FLOOR 3 STOREY MODELS - INCLUDE FRAMING NOTE. TO GO IN POWDER ROOM, 3 CLOSET DOORS, AND PANTRY. SEE SKETCH
Line5011	Note:
12Apr16 / 20Apr16	

Inv.419	2 - MAIN FLOOR: TWO (2) STANDARD FRENCH DOORS EXTENDED HEIGHT 96" (PRICE PER DOOR) MAIN FLOOR 3 STOREY MOBELS - INCLUDE FRAMING NOTE. TWO DOORS AT DEN. SEE SKETCH
Line5012	Note:
12Apr16 / 20Apr16	

MISC.

Inv.419	1 - BONUS PACKAGE: \$10,000.00 (INCLUDING TAXES) WORTH OF UPGRADES FROM GOLD PARK HOMES DECOR CENTRE HAS BEEN USED TOWARD THIS STRUCTURAL APPOINTMENT
Line5015	Note:
12Apr16 / 20Apr16	

Inv.419	1 - Purchaser has attended a colour chart appointment at the Decor Centre & has DECLINED any additional upgrades and accepts and acknowledges that there will be no further structural changes/additions/deletions to be made upon signing on April 12,2016
Line5016	Note:
12Apr16 / 20Apr16	

Inv.419	1 - Purchasers are aware & accepts that ANY changes made to upgrades after signing this Purchasers Extra Form are subject to a minimum administration fee of \$500. PLUS a 10% holdback fee
Line5017	Note:
12Apr16 / 20Apr16	

PLUMBING

Inv.419	1 - EXTERIOR: HOSE BIB - STANDARD TO UPGRADED WITH HOT AND COLD WATER VALVE. IN THE GARAGE
Line5001	Note:
12Apr16 / 20Apr16	

Inv.419	1 - KITCHEN: ROUGH-IN - WATERLINE FOR FRIDGE
Line5013	Note:
12Apr16 / 20Apr16	

Inv.419	1 - BASEMENT: INSTALL ROUGH-IN - 3PC BASEMENT ROUGH-IN. AS PER FLOOR PLAN
Line5014	Note:
12Apr16 / 20Apr16	

Inv.419	1 - BEDROOM #4: SHOWER IN LIEU OF TUB- INCLUDES FRAMED GLASS SHOWER ENCLOSURE- MUST ADD PLUMBING NOTE
Line5372	Note: see framing note
12Apr16 / 20Apr16	

WINDOWS - BASEMENT



CONSTRUCTION SUMMARY

96 - 1 - 41-5 Elev.A BRAHMS OPT - GFA1




Inv.419	2 - BASEMENT: INSTALL TWO (2) BASEMENT WINDOWS - UPGRADE EXISTING BASEMENT WINDOW TO 30 INCH X 16 INCH ON SIDE OF HOUSE. SEE SKETCH.MAY REQUIRE INSTALLATION OF WINDOW WELL. TO GO AT THE REAR OF THE HOUSE
Line5003	Note:
12Apr16 / 20Apr16	

Inv.419	1 - BASEMENT: INSTALL ONE (1) BASEMENT WINDOW - UPGRADE EXISTING BASEMENT WINDOW TO 30 INCH X 24 INCH - MAY REQUIRE INSTALLATION OF WINDOW WELL. TO GO AT THE REAR OF THE HOUSE
Line5004	Note:
12Apr16 / 20Apr16	

WINDOWS AND DOORS

Inv.419	1 - GARAGE: INSTALL MAN DOOR GARAGE TO HOUSE - OPTIONAL - IF GRADE PERMITS
Line4999	Note:
12Apr16 / 20Apr16	

Telephone — (T)
 Cable — (C)
 Electrical — (E)

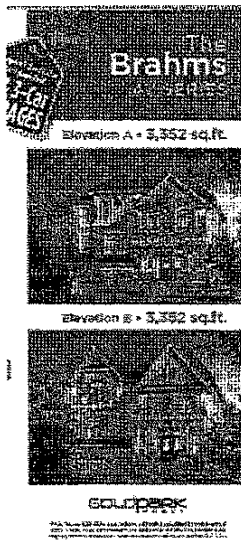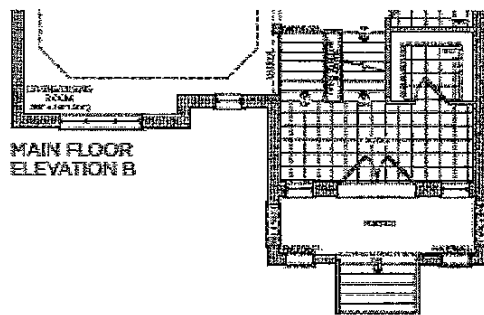
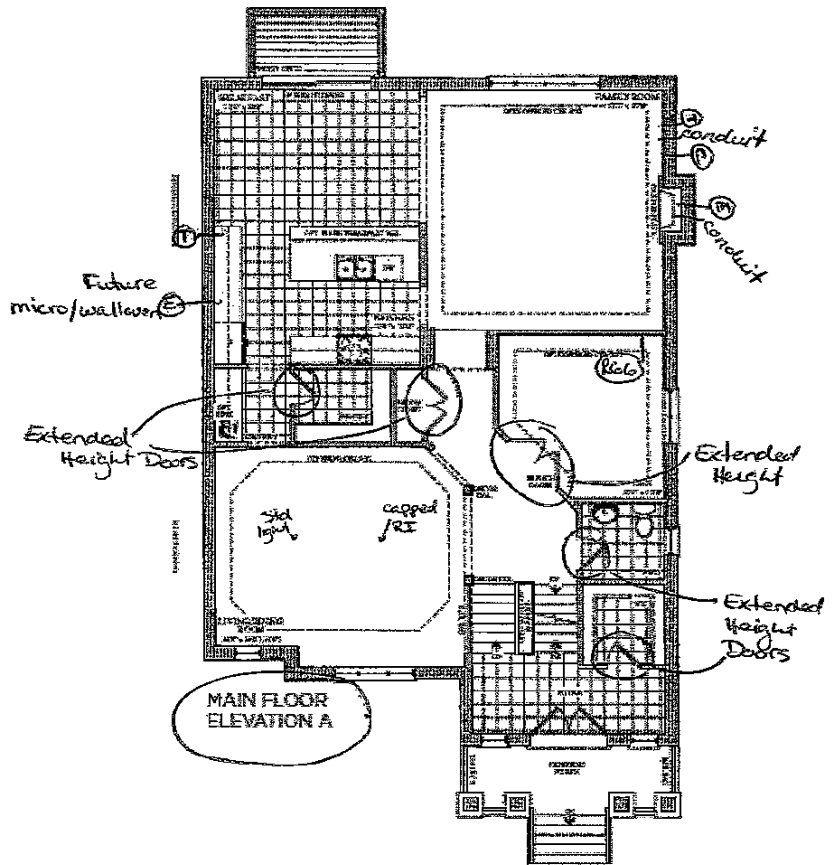


Lot 96

April 12, 2016



[Signature]

Telephone — (T)
 Cable — (C)

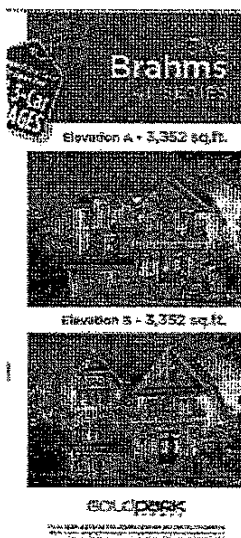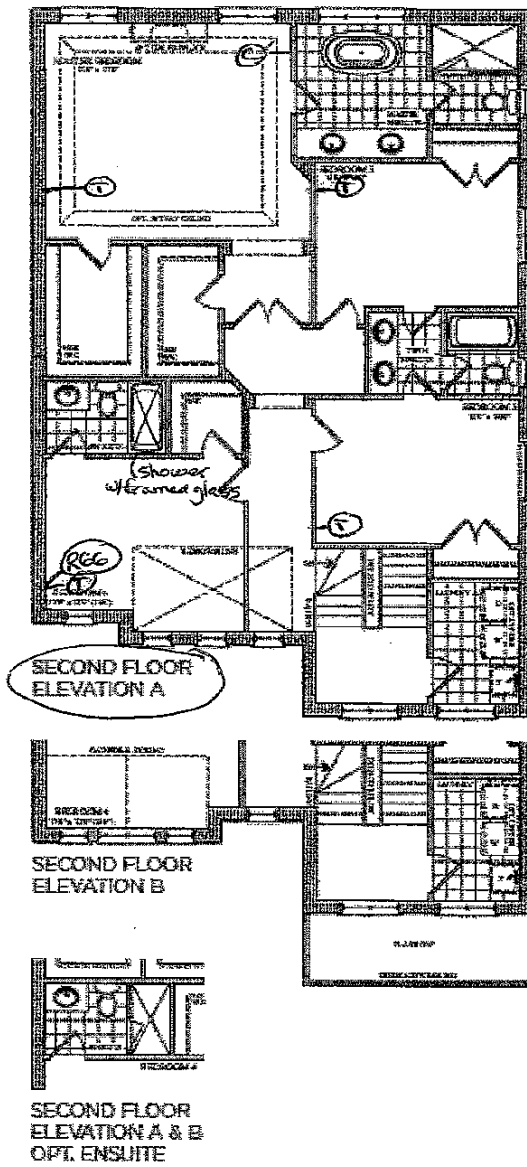

Lot 96
 April 12, 2016
 (Signature) (Initials)

Telephone — (1)
 Cable — (C)

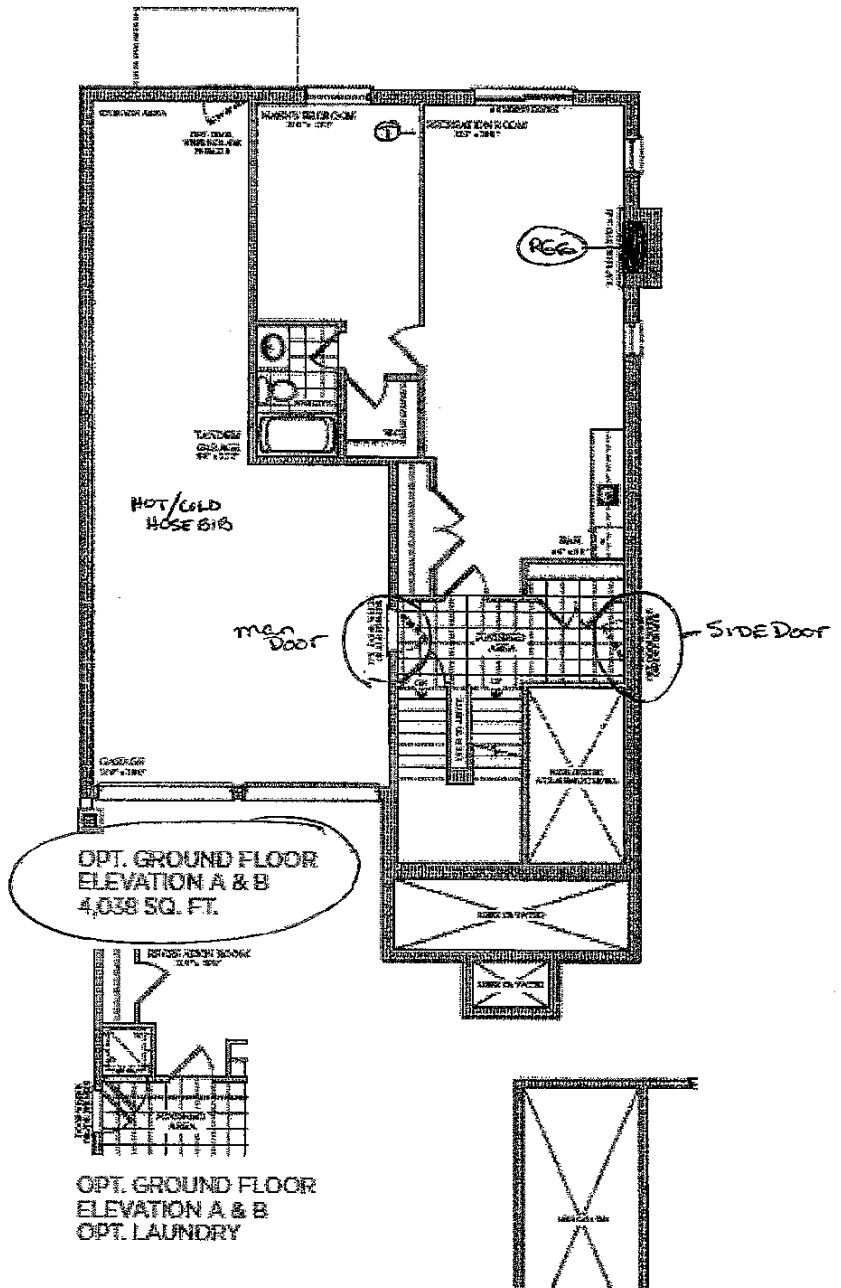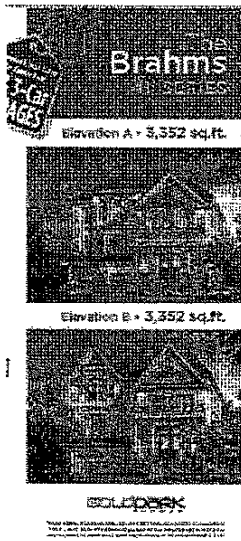

Lot 96




April 12, 2016

(Signature)

BSMNT WINDOWS

1 X 30" X 24"

2 X 30" X 16"

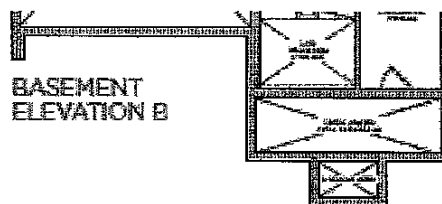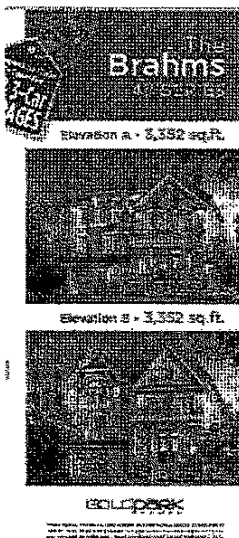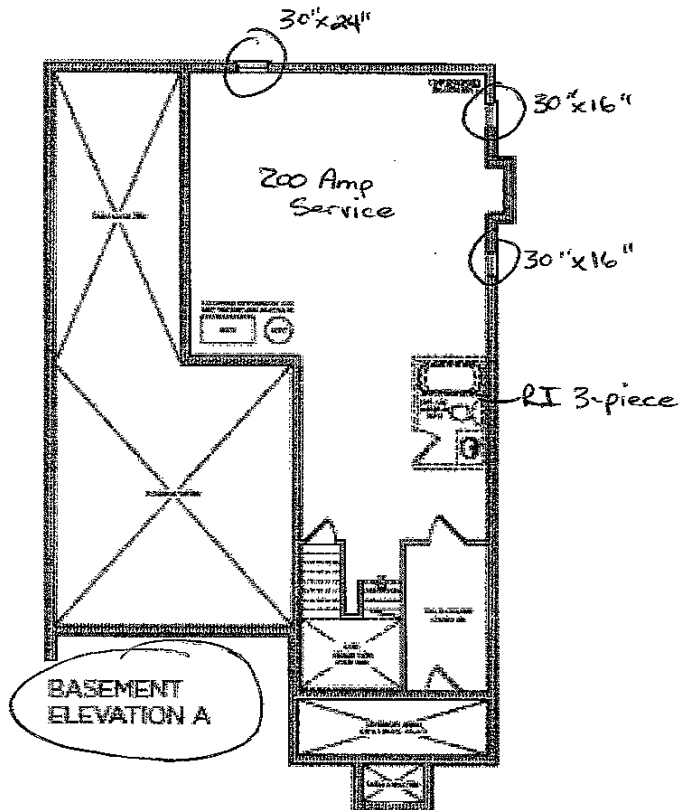

Lot 96

April 12, 2016





Stacey Carlete
Project Coordinator



Claude Azzopardi
Contracts Manager



Nancy Mc
Corporate G

96
Lot #



Model	38.1 The Bizet		
Elevation	Circle One	A	2189.6 Square Feet
		B	2186.7 Square Feet
Optional Layouts	Circle All that Apply		

Model	38.2 The Ravel		
Elevation	Circle One	A	2271.5 Square Feet
		B	2273.7 Square Feet
Optional Layouts	Circle All that Apply		

Model	38.3 The Haydn		
Elevation	Circle One	A	2394.5 Square Feet
		B	2388.3 Square Feet
Optional Layouts	Circle All that Apply		

Model	38.4 The Vivaldi		
Elevation	Circle One	A	2459.1 Square Feet
		B	2459.1 Square Feet
Optional Layouts	Circle All that Apply		

Model	38.5 The Handel		
Elevation	Circle One	A	2549.2 Square Feet
		B	2554.7 Square Feet
Optional Layouts	Circle All that Apply		

Model	38.9 The Puccini		
Elevation	Circle One	A	3628.0 Square Feet
		B	3634.7 Square Feet
Optional Layouts	Circle All that Apply	GFA1	GROUND FLOOR Optional Alternative Layout

Model	38.6 The Scarlatti		
Elevation	Circle One	A	3521.1 Square Feet
		B	3508.1 Square Feet
Optional Layouts	Circle All that Apply	GFA1	GROUND FLOOR Optional Alternative Layout

Model	38.7 The Schubert		
Elevation	Circle One	A	3593.8 Square Feet
		B	3610.5 Square Feet
Optional Layouts	Circle All that Apply	GFA1	GROUND FLOOR Optional Alternative Layout
		SFA4	SECOND FLOOR Additional Bedroom

Model	38.8 The Corelli		
Elevation	Circle One	A	3801.5 Square Feet
		B	3801.5 Square Feet
Optional Layouts	Circle All that Apply	GFA1	GROUND FLOOR Optional Alternative Layout
		SFA4	SECOND FLOOR Additional Bedroom w/ Ensuite

Model	41.1 The Strauss		
Elevation	Circle One	A	2554.2 Square Feet
		B	2571.2 Square Feet
Optional Layouts	Circle All that Apply	SFA1	SECOND FLOOR Shower in Lieu of Tub B2

Model	41.2 The Mozart		
Elevation	Circle One	A	2725.9 Square Feet
		B	2711.1 Square Feet
Optional Layouts	Circle All that Apply	SFA1	SECOND FLOOR Shower in Lieu of Tub B2

Model	41.3 The Chopin		
Elevation	Circle One	A	2800.0 Square Feet
		B	2810.5 Square Feet
Optional Layouts	Circle All that Apply		

Model	41.4 The Bach		
Elevation	Circle One	A	2894.4 Square Feet
		B	2894.5 Square Feet
Optional Layouts	Circle All that Apply		

Model	41.5 The Brahms		
Elevation	Circle One	A	3948.1 Square Feet
		B	3949.1 Square Feet
Optional Layouts	Circle All that Apply	GFA1	GROUND FLOOR Optional Alternative Layout
		SFA2	SECOND FLOOR Shower in Lieu of Tub B4
		SFA3	SECOND FLOOR Optional Laundry Layout

Model	41.6 The Verdi		
Elevation	Circle One	A	3862.5 Square Feet
		B	3866.4 Square Feet
Optional Layouts	Circle All that Apply	GFA1	GROUND FLOOR Optional Alternative Layout
		SFA3	SECOND FLOOR Optional Laundry Layout

April 12, 2016

