



Structural
CONSTRUCTION SUMMARY
52 - 1 - 38-1 Elev. A BIZET

CENTRAL VAC AND WIRING

Inv.437	1 - FAMILY ROOM: CAT 6 WIRING - UPGRADE AN OUTLET TO CAT 6 IN FAMILY ROOM. SEE SKETCH
Line5271	Note:
19Apr16 / 27May16	
Inv.437	1 - BEDROOM #4: INSTALL RG 6 WIRING IN BEDROOM 4, SEE SKETCH
Line5273	Note:
19Apr16 / 27May16	
Inv.437	1 - BEDROOM #4: INSTALL CAT 6 WIRING - UPGRADE AN OUTLET TO CAT 6- IN BEDROOM 4, SEE SKETCH
Line5272	Note:
19Apr16 / 27May16	

ELECTRICAL

Inv.437	1 - TELEPHONE AND CABLE ROUGH-IN LOCATIONS. SEE SKETCH
Line5270	Note:
19Apr16 / 27May16	
Inv.437	1 - BASEMENT: INSTALL 200 AMP ELECTRICAL SERVICE
Line5274	Note:
19Apr16 / 27May16	

EXTERIOR COLOURS

Inv.523	1 - EXTERIOR COLOUR PACKAGE 2
Line6310	Note:
27May16 / 27May16	

FORMING

Inv.437	1 - EXTERIOR: INSTALL SIDE DOOR- HOME TO EXTERIOR- AS PER PLAN AND GRADE PERMITTING
Line5275	Note:
19Apr16 / 27May16	

FRAMING

Inv.437	1 - SMOOTH CEILINGS - (2-Story Design) 2ND FLOOR
Line5278	Note:
19Apr16 / 27May16	
Inv.437	1 - SECOND FLOOR CEILING 9FT. INCLUDES EXTENDED HEIGHT DOORS, TALLER FLAT ARCHES AND TALLER FRONT AND REAR ELEVATION WINDOWS, WHERE APPLICABLE
Line5279	Note: TO BE APPROVED BY CONSTRUCTION
19Apr16 / 27May16	

GARAGE DOORS

Inv.437	2 - GARAGE: INSULATION KIT - STANDARD GARAGE DOORS - EACH HOUSE REQUIRES 2 INSULATION KITS- PER DOOR PRICE
Line5277	Note:
19Apr16 / 27May16	

MISC.



CONSTRUCTION SUMMARY

52 - 1 - 38-1 Elev.A BIZET

Inv.427	1 - Purchaser acknowledges that basement structural purchases are final and any additional changes will be dependent of home office approval.
Line5136	Note:
14Apr16 / 27May16	
Inv.427	1 - OPTIONAL COLD CELLAR - AS PER PLAN
Line5100	Note:
14Apr16 / 27May16	
Inv.427	1 - BONUS PACKAGE FROM APS INCLUDES \$10 000.00 IN DECOR DOLLARS (-\$9 362.05) INVOICE TOTAL \$637.95 REMAINING DECOR DOLLARS
Line5142	Note:
14Apr16 / 27May16	
Inv.437	1 - BONUS PACKAGE: \$637.95 (INCLUDING TAXES) WORHT OF UPGRADES FROM GOLD PARK HOMES DÉCOR CENTRE IS BEING APPLIED TOWARD THE STRUCTURAL APPOINTMENT.
Line5280	Note:
19Apr16 / 27May16	
Inv.437	1 - Purchaser has attended a Structural appointment at the Decor Centre & has DECLINED any additional upgrades and accepts and acknowledges that there will be no further structural changes/additions/deletions to be made upon signing on April 19,2016
Line5281	Note:
19Apr16 / 27May16	
Inv.437	1 - Purchasers are aware & accepts that ANY changes made to upgrades after signing this Purchasers Extra Form are subject to a minimum administration fee of \$500. PLUS a 10% holdback fee
Line5282	Note:
19Apr16 / 27May16	

PLUMBING

Inv.427	1 - ROUGH-IN - 3PC BASEMENT ROUGH-IN
Line5099	Note:
14Apr16 / 27May16	

WINDOWS - BASEMENT

Inv.427	1 - BASEMENT WINDOWS - UPGRADE EXISTING BASEMENT WINDOW TO 30 INCH X 24 INCH - MAY REQUIRE INSTALLATION OF WINDOW WELL
Line5134	Note:
14Apr16 / 27May16	
Inv.427	2 - BASEMENT WINDOWS - UPGRADE EXISTING BASEMENT WINDOW TO 46 INCH X 32 INCH EGRESS - MAY REQUIRE INSTALLATION OF WINDOW WELL
Line5133	Note:
14Apr16 / 27May16	

WINDOWS AND DOORS



Inv.437	1 - GARAGE: INSTALL MAN DOOR GARAGE TO HOUSE - OPTIONAL - IF GRADE PERMIT'S
Line5276	Note:
19Apr16 / 27May16	

The Bizet

38' SERIES

Elevation A • 2,234 sq.ft. | Elevation B • 2,222 sq.ft.

Coffered Ceiling

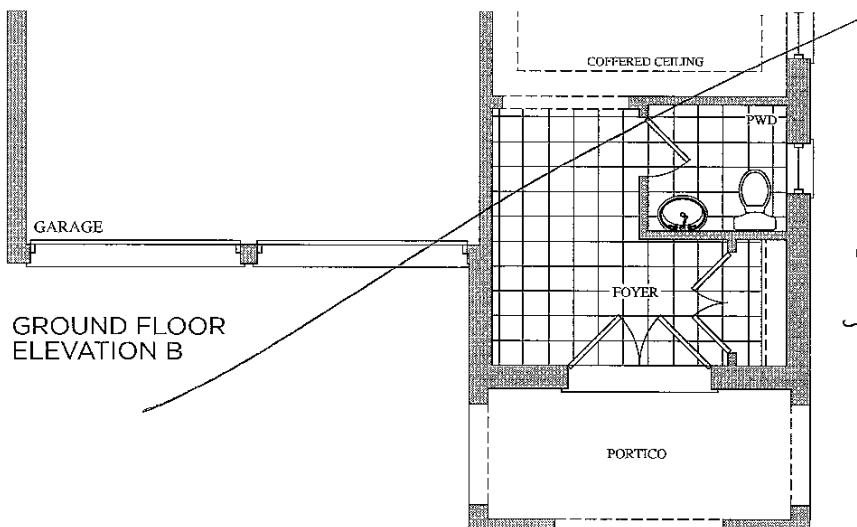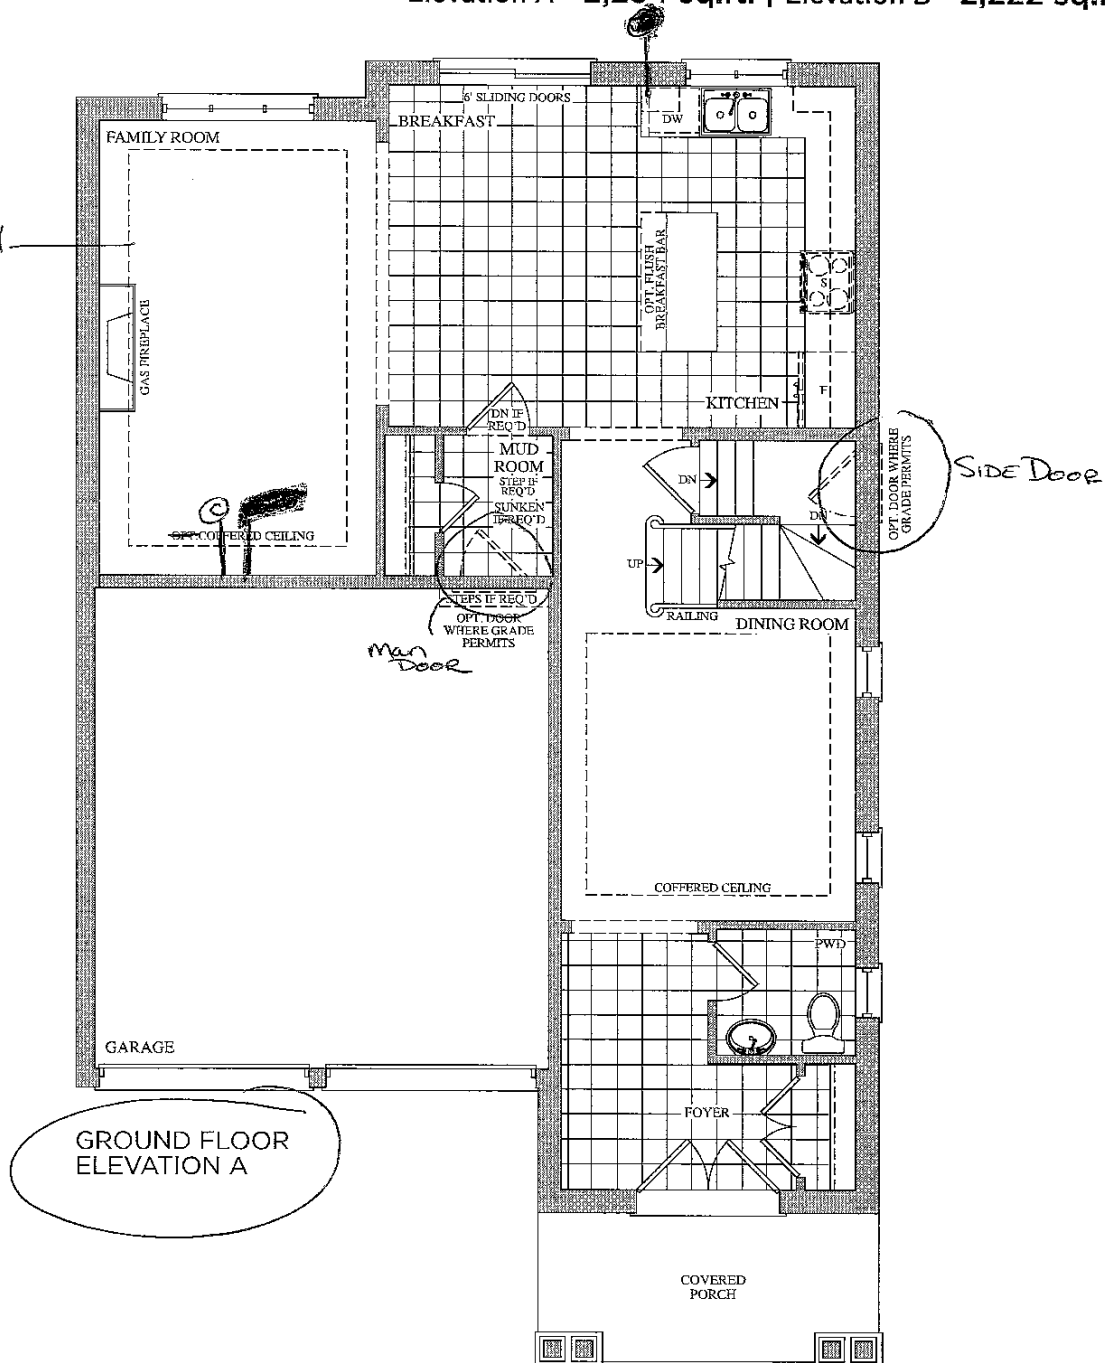



Lot 52
April 19, 2016
 

- Smooth ceilings, 2nd Floor
- 9' ceilings

The Bizet 38' SERIES

Elevation A • 2,234 sq.ft. | Elevation B • 2,222 sq.ft.

Telephone — (T)
Cable — (C)

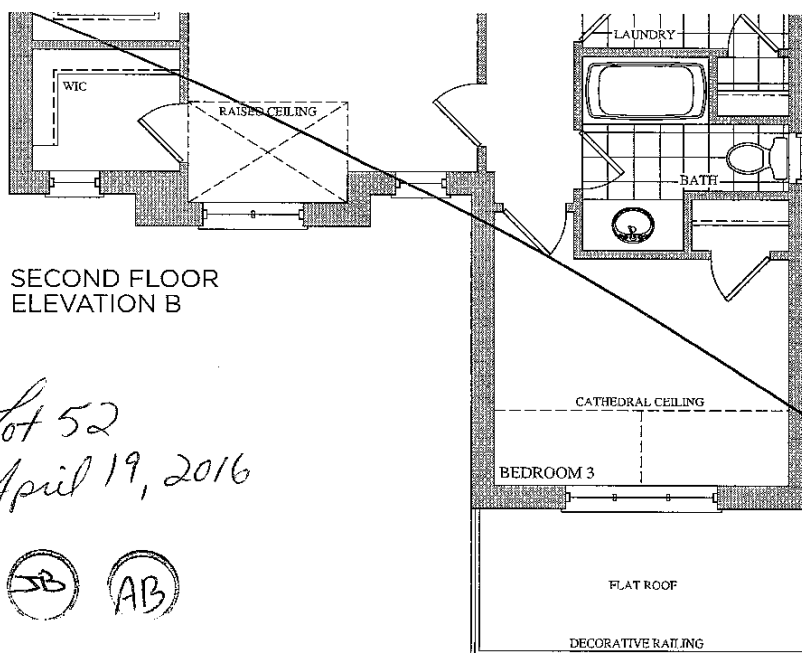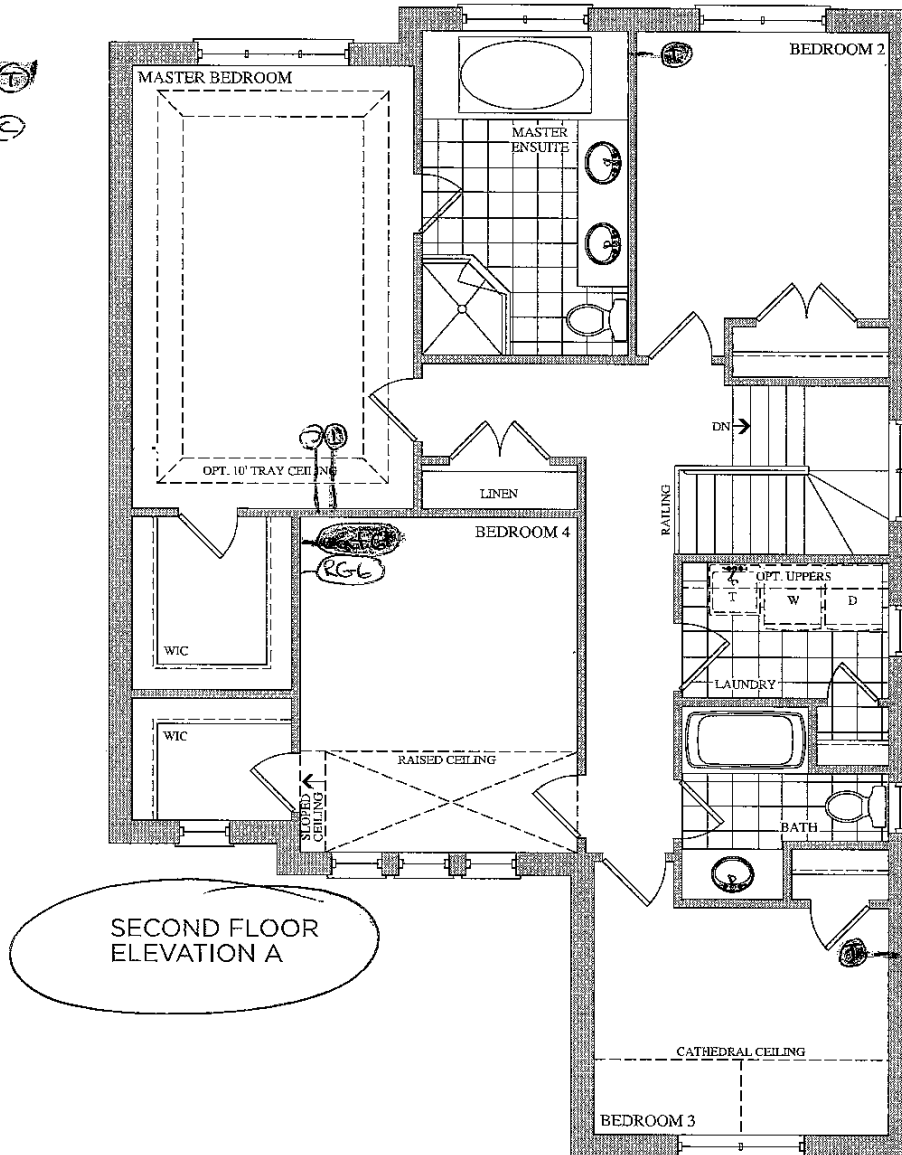


Lot 52
April 19, 2016

SB AB

The
Bizet
38' SERIES

Elevation A • 2,234 sq.ft. | Elevation B • 2,222 sq.ft.

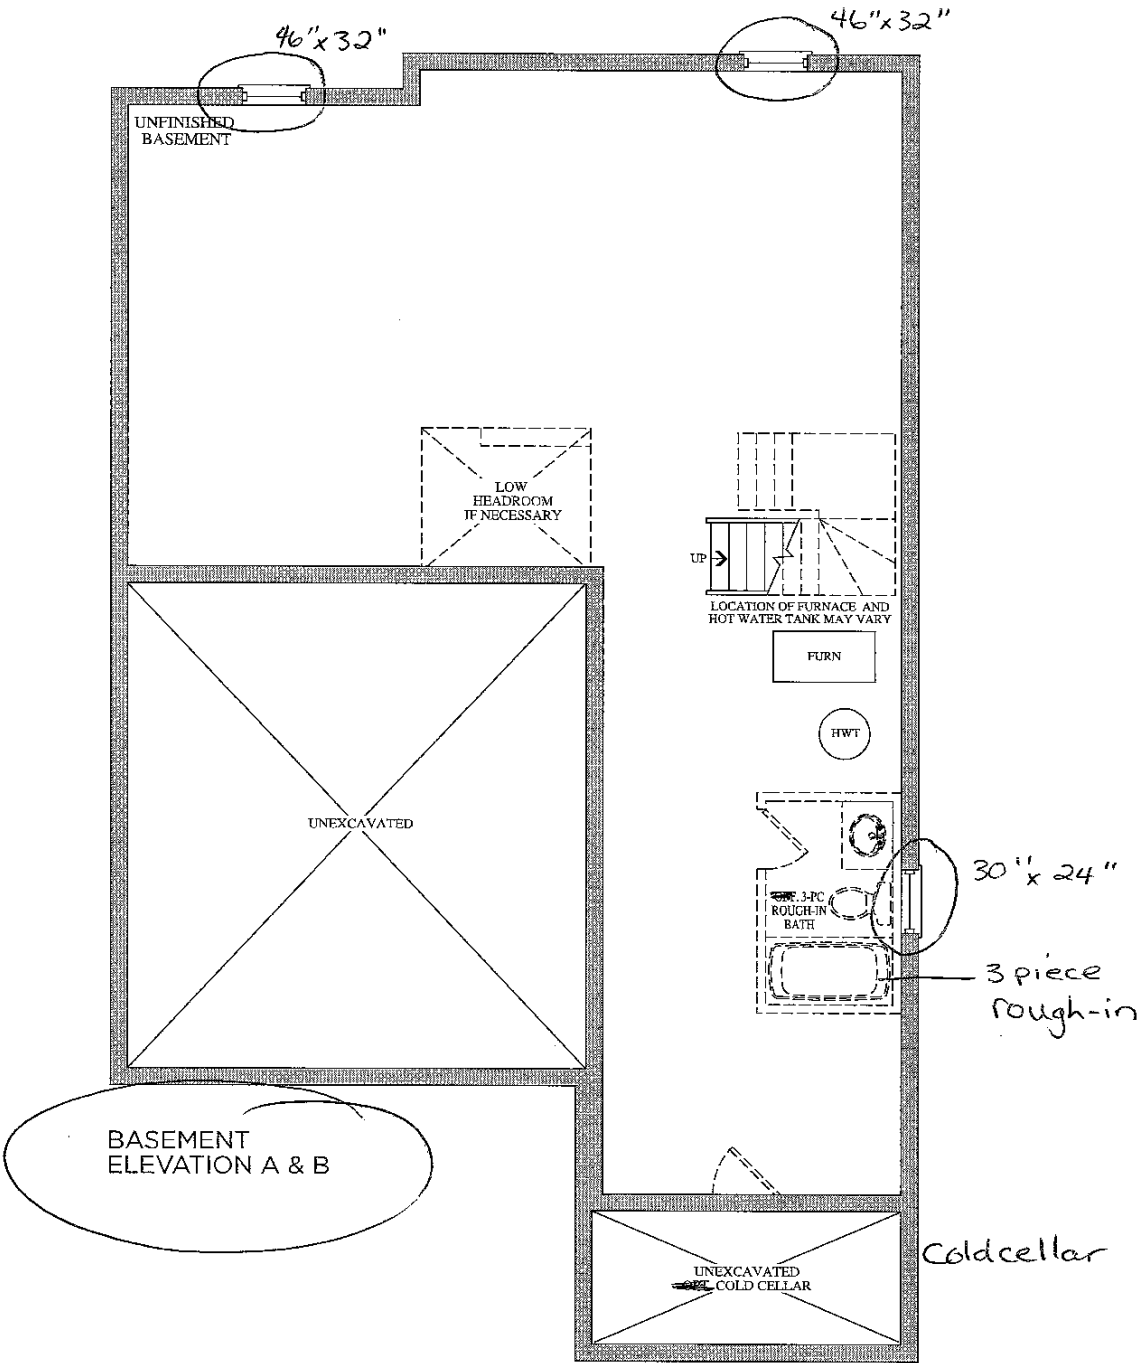

Lot 52
April 19, 2016
JB AB



Stacey Carlete
Project Coordinator



Claude Azzopardi
Contracts Manager



Nancy Mc
Corporate

52
Lot #



38.1 The Bizet			
Elevation	Circle One	A	2189.6 Square Feet
		B	2186.7 Square Feet
Optional Layouts	Circle All that Apply		

38.2 The Ravel			
Elevation	Circle One	A	2271.5 Square Feet
		B	2273.7 Square Feet
Optional Layouts	Circle All that Apply		

38.3 The Haydn			
Elevation	Circle One	A	2394.5 Square Feet
		B	2388.3 Square Feet
Optional Layouts	Circle All that Apply		

38.4 The Vivaldi			
Elevation	Circle One	A	2459.1 Square Feet
		B	2459.1 Square Feet
Optional Layouts	Circle All that Apply		

38.5 The Handel			
Elevation	Circle One	A	2549.2 Square Feet
		B	2554.7 Square Feet
Optional Layouts	Circle All that Apply		

38.9 The Puccini			
Elevation	Circle One	A	3628.0 Square Feet
		B	3634.7 Square Feet
Optional Layouts	Circle All that Apply	GFA1	GROUND FLOOR Optional Alternative Layout

38.6 The Scarlatti			
Elevation	Circle One	A	3521.1 Square Feet
		B	3508.1 Square Feet
Optional Layouts	Circle All that Apply	GFA1	GROUND FLOOR Optional Alternative Layout

38.7 The Schubert			
Elevation	Circle One	A	3593.8 Square Feet
		B	3610.5 Square Feet
Optional Layouts	Circle All that Apply	GFA1	GROUND FLOOR Optional Alternative Layout
		SFA4	SECOND FLOOR Additional Bedroom

38.8 The Corelli			
Elevation	Circle One	A	3801.5 Square Feet
		B	3801.5 Square Feet
Optional Layouts	Circle All that Apply	GFA1	GROUND FLOOR Optional Alternative Layout
		SFA4	SECOND FLOOR Additional Bedroom w/ Ensuite

41.1 The Strauss			
Elevation	Circle One	A	2554.2 Square Feet
		B	2571.2 Square Feet
Optional Layouts	Circle All that Apply	SFA1	SECOND FLOOR Shower in Lieu of Tub B2

41.2 The Mozart			
Elevation	Circle One	A	2725.9 Square Feet
		B	2711.1 Square Feet
Optional Layouts	Circle All that Apply	SFA1	SECOND FLOOR Shower in Lieu of Tub B2

41.3 The Chopin			
Elevation	Circle One	A	2800.0 Square Feet
		B	2810.5 Square Feet
Optional Layouts	Circle All that Apply		

41.4 The Bach			
Elevation	Circle One	A	2894.4 Square Feet
		B	2894.5 Square Feet
Optional Layouts	Circle All that Apply		

41.5 The Brahms			
Elevation	Circle One	A	3948.1 Square Feet
		B	3949.1 Square Feet
Optional Layouts	Circle All that Apply	GFA1	GROUND FLOOR Optional Alternative Layout
		SFA2	SECOND FLOOR Shower in Lieu of Tub B4
		SFA3	SECOND FLOOR Optional Laundry Layout

41.6 The Verdi			
Elevation	Circle One	A	3862.5 Square Feet
		B	3866.4 Square Feet
Optional Layouts	Circle All that Apply	GFA1	GROUND FLOOR Optional Alternative Layout
		SFA3	SECOND FLOOR Optional Laundry Layout

April 19, 2016

JB

AB