



* Structural *

CONSTRUCTION SUMMARY

61 - 1 - 41-4 Elev.B BACH

CENTRAL VAC AND WIRING

Inv.489	1 - TELEPHONE AND CABLE ROUGH-IN LOCATION SKETCH
Line5892	Note:
10May16 / 6Jun16	
Inv.489	1 - FAMILY ROOM: INSTALL CONDUIT PIPE- FOR TELEVISION- MUST SPECIFY LOCATION AND TERMINATION POINT
Line5893	Note:
10May16 / 6Jun16	
Inv.489	2 - FAMILY ROOM: INSTALL ROUGH-IN WIRING FOR TWO PAIR OF SPEAKERS - IN FAMILY ROOM. SEE SKETCH
Line5908	Note:
10May16 / 6Jun16	

ELECTRICAL

Inv.489	5 - KITCHEN: INSTALL FIVE (X5) POT LIGHTS: 4 INCH HALOGEN POT LIGHT - 440 WH- IN KITCHEN. SEE SKETCH
Line5897	Note:
10May16 / 6Jun16	
Inv.489	1 - KITCHEN: INSTALL 110V WALL RECEPTACLE ON DEDICATED CIRCUIT - FOR MICROWAVE - MICROWAVE NOT INCLUDED. SEE SKETCH FOR LOCATION
Line5899	Note:
10May16 / 6Jun16	
Inv.489	1 - FAMILY ROOM: INSTALL 110V WALL RECEPTACLE ON DEDICATED CIRCUIT - ABOVE FIREPLACE. SEE SKETCH
Line5894	Note:
10May16 / 6Jun16	
Inv.489	1 - KITCHEN: RELOCATE STANDARD FIXTURE IN KITCHEN, ABOVE ISLAND. SEE SKETCH
Line5896	Note:
10May16 / 6Jun16	
Inv.489	5 - EXTERIOR: INSTALL FIVE (X5) POT LIGHTS: 4 INCH LINE VOLTAGE POT LIGHT - (EXTERIOR) -AS SHOWN ON BROCHURE. SEE SKETCH
Line5898	Note:
10May16 / 6Jun16	
Inv.489	1 - BASEMENT: INSTALL TANKLESS HWT CONNECTION - HWT ON RENTAL BASIS / TANK NOT INCLUDED
Line6527	Note:
10May16 / 6Jun16	
Inv.489	1 - MASTER ENSUITE: INSTALL STANDARD JET TUB IN MASTER ENSUITE
Line6528	Note:
10May16 / 6Jun16	

EXTERIOR COLOURS

Inv.456	1 - EXTERIOR COLOUR PACKAGE 10
Line6512	Note:
26Apr16 / 6Jun16	

GARAGE DOORS



CONSTRUCTION SUMMARY

61 - 1 - 41-4 Elev.B BACH

Inv.489	1 - GARAGE: INSTALL DIGITAL ENTRY KEYPAD, FOR GARAGE WITH THE GARAGE DOOR OPENER. SEE SKETCH
Line5907	Note:
10May16 / 6Jun16	
Inv.489	1 - GARAGE: INSTALL ONE GARAGE DOOR OPENER - WITH 1 REMOTE- PRICE IS PER DOOR. PURCHASER ONLY WANTS ONE OPENER FOR DOOR CLOSEST TO FRONT DOOR. SEE SKETCH
Line5901	Note: PURCHASER ACCEPTS AND AKNOWLEDGES THAT ONE DOOR WILL OPEN MANUALLY
10May16 / 6Jun16	

HVAC

Inv.489	1 - BASEMENT: INSTALL HUMIDIFIER: WB3 - 17 (UP TO 3,000 SQ.FT.)
Line5911	Note: PURCHASER UNDERSTANDS THAT THEIR HOME IS MORE THAN 3000 SQ FEET.
10May16 / 6Jun16	
Inv.489	1 - KITCHEN: INSTALL GAS LINE ROUGH - MAIN FLOOR - (2 STOREY MODELS) FOR STOVE
Line5902	Note:
10May16 / 6Jun16	
Inv.489	1 - BASEMENT: INSTALL TANKLESS HWT CONNECTION - HWT ON RENTAL BASIS / TANK NOT INCLUDED
Line5904	Note:
10May16 / 6Jun16	
Inv.489	1 - BASEMENT: INSTALL HEPA FILTER: LENNOX MODEL HEPA - 60
Line5910	Note:
10May16 / 6Jun16	

MISC.

Inv.456	1 - BONUS PACKAGE: \$1949.25 (INCLUDING TAXES) WORHT OF UPGRADES FROM GOLD PARK HOMES DÉCOR CENTRE IS BEING APPLIED TOWARD THE STRUCTURAL APPOINTMENT. PURCHASER HAS A REMAINING AMOUNT OF \$13 050.75 (INCLUDING TAXES) TO BE USED TOWARD THE COLOUR APPOINTMENT.
Line5478	Note:
26Apr16 / 6Jun16	
Inv.456	1 - Purchasers are aware & accepts that ANY changes made to upgrades after signing this Purchasers Extra Form are subject to a minimum administration fee of \$500. PLUS a 10% holdback fee
Line5479	Note:
26Apr16 / 6Jun16	
Inv.489	1 - BONUS PACKAGE: \$13,050.75 (INCLUDING TAXES) WORTH OF UPGRADES FROM GOLD PARK HOMES DÉCOR CENTRE IS BEING APPLIED TOWARD THE STRUCTURAL APPOINTMENT.
Line5912	Note:
10May16 / 6Jun16	
Inv.489	1 - Purchaser has attended a Structural appointment at the Decor Centre & has DECLINED any additional upgrades and accepts and acknowledges that there will be no further structural changes/additions/deletions to be made upon signing on May 10, 2016.
Line5913	Note:
10May16 / 6Jun16	
Inv.489	1 - Purchasers are aware & accepts that ANY changes made to upgrades after signing this Purchasers Extra Form are subject to a minimum administration fee of \$500. PLUS a 10% holdback fee
Line5914	Note:
10May16 / 6Jun16	

CONSTRUCTION SUMMARY

61 - 1 - 41-4 Elev.B BACH

PLUMBING

Inv.456	1 - ROUGH-IN - 3PC BASEMENT ROUGH-IN
Line5477	Note:
26Apr16 / 6Jun16	
Inv.489	1 - MASTER ENSUITE: INSTALL STANDARD JET TUB IN MASTER ENSUITE
Line5905	Note:
10May16 / 6Jun16	
Inv.489	1 - KITCHEN: INSTALL ROUGH-IN - WATERLINE FOR FRIDGE
Line5906	Note:
10May16 / 6Jun16	

WINDOWS - BASEMENT

Inv.489	3 - BASEMENT: INSTALL THREE (X3) BASEMENT WINDOWS - UPGRADE EXISTING BASEMENT WINDOW TO 30 INCH X 24 INCH - MAY REQUIRE INSTALLATION OF WINDOW WELL
Line5903	Note:
10May16 / 6Jun16	


WINDOWS AND DOORS

Inv.489	1 - GARAGE: INSTALL MAN DOOR GARAGE TO HOUSE - OPTIONAL - IF GRADE PERMITS
Line5900	Note:
10May16 / 6Jun16	


Telephone - (T)
Cable - (C)
Electrical - (E)

The
Bach
41' SERIES

Elevation A • 3,046 sq.ft. | Elevation B • 3,046 sq.ft.

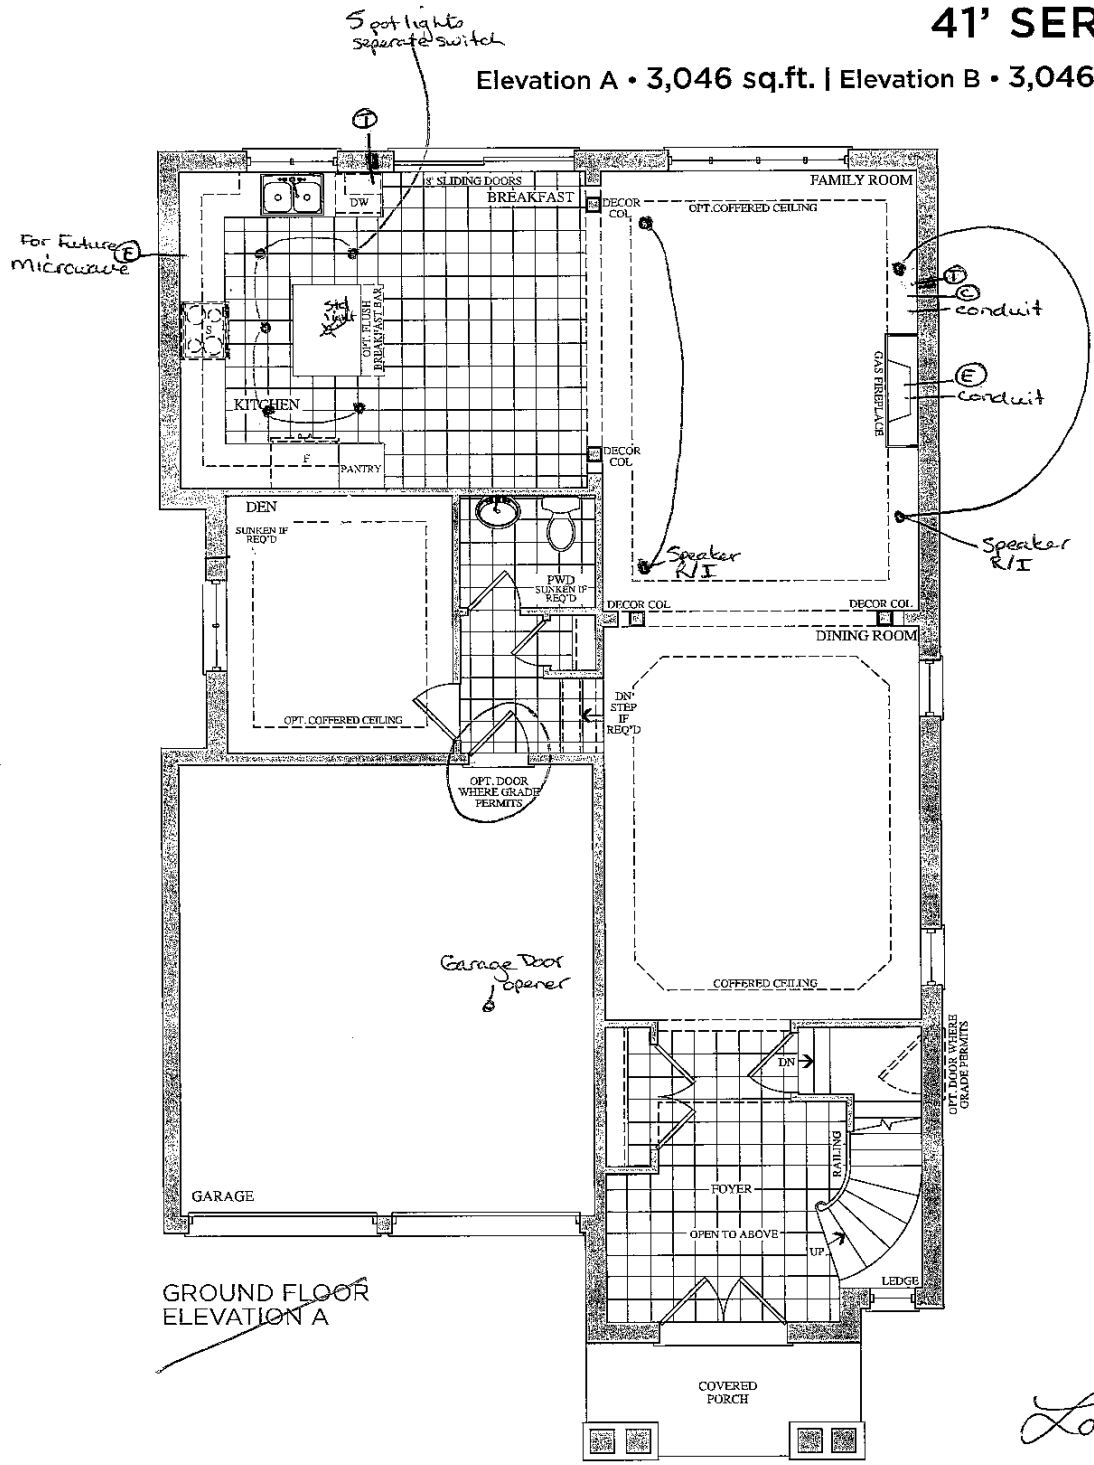

GROUND FLOOR
ELEVATION A

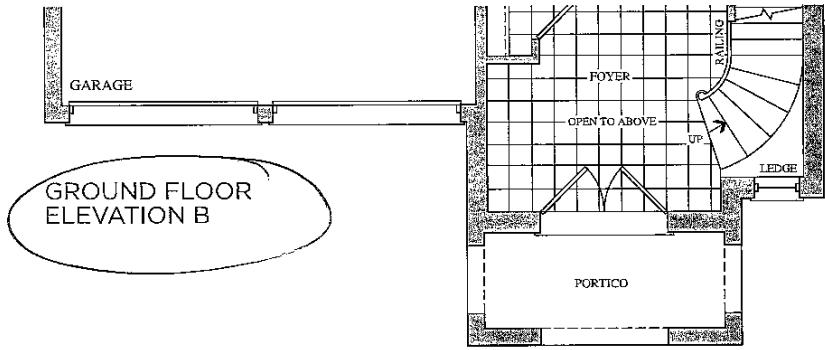

GROUND FLOOR
ELEVATION B


Lot 61
May 10, 16
(S) (B)

Prices, figures, illustrations, sizes, features and finishes are subject to change without notice. E.&O.E. Areas and dimensions are approximate and actual usable floor space may vary from the stated area. Layout may be reverse of the unit purchased. E. & O.E.


Telephone — (T)
Cable — (C)
Electrical — (E)

The
Bach
41' SERIES

Elevation A • 3,046 sq.ft. | Elevation B • 3,046 sq.ft.

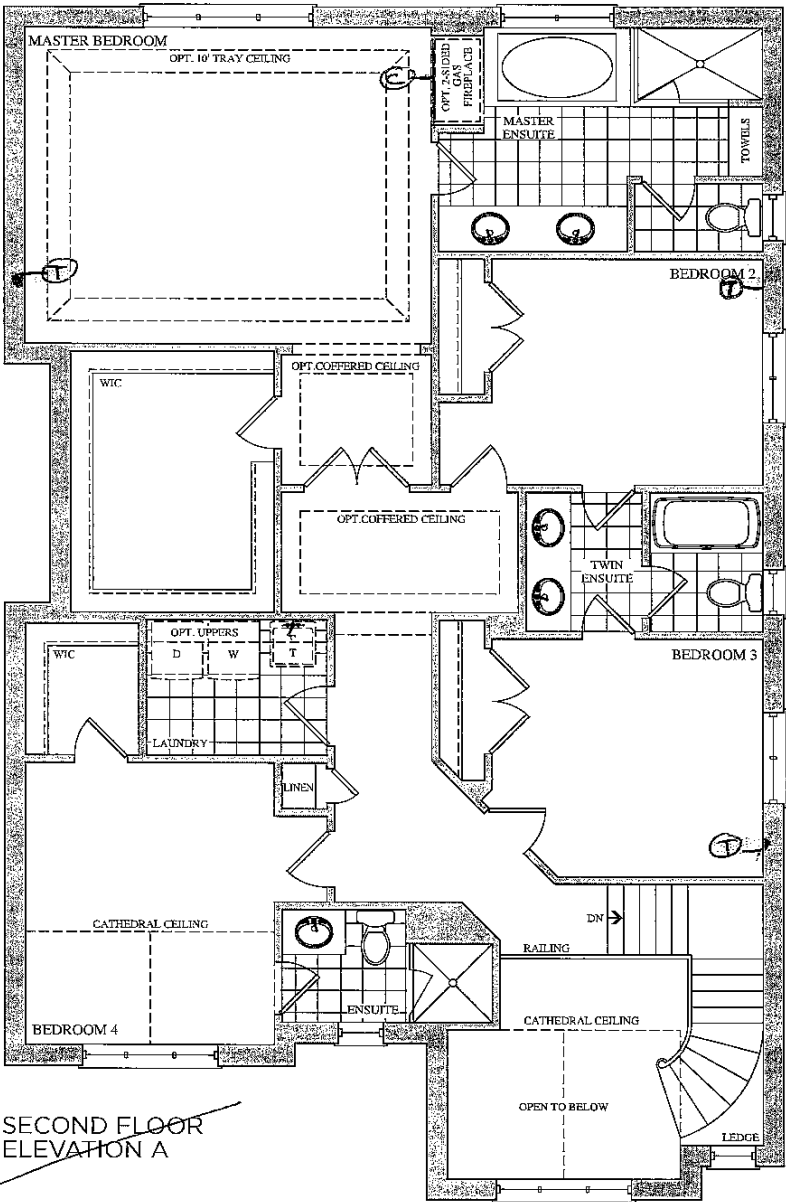

SECOND FLOOR
ELEVATION A

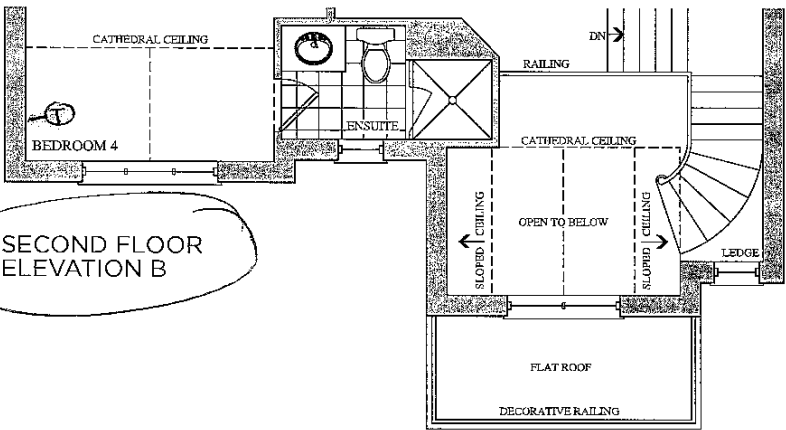


SECOND FLOOR
ELEVATION B

Lot 61
May 10, 16
(82) (4)

BSMNT WINDOWS
3x 30"x24"

Elevation A • 3,046 sq.ft. | Elevation B • 3,046 sq.ft.

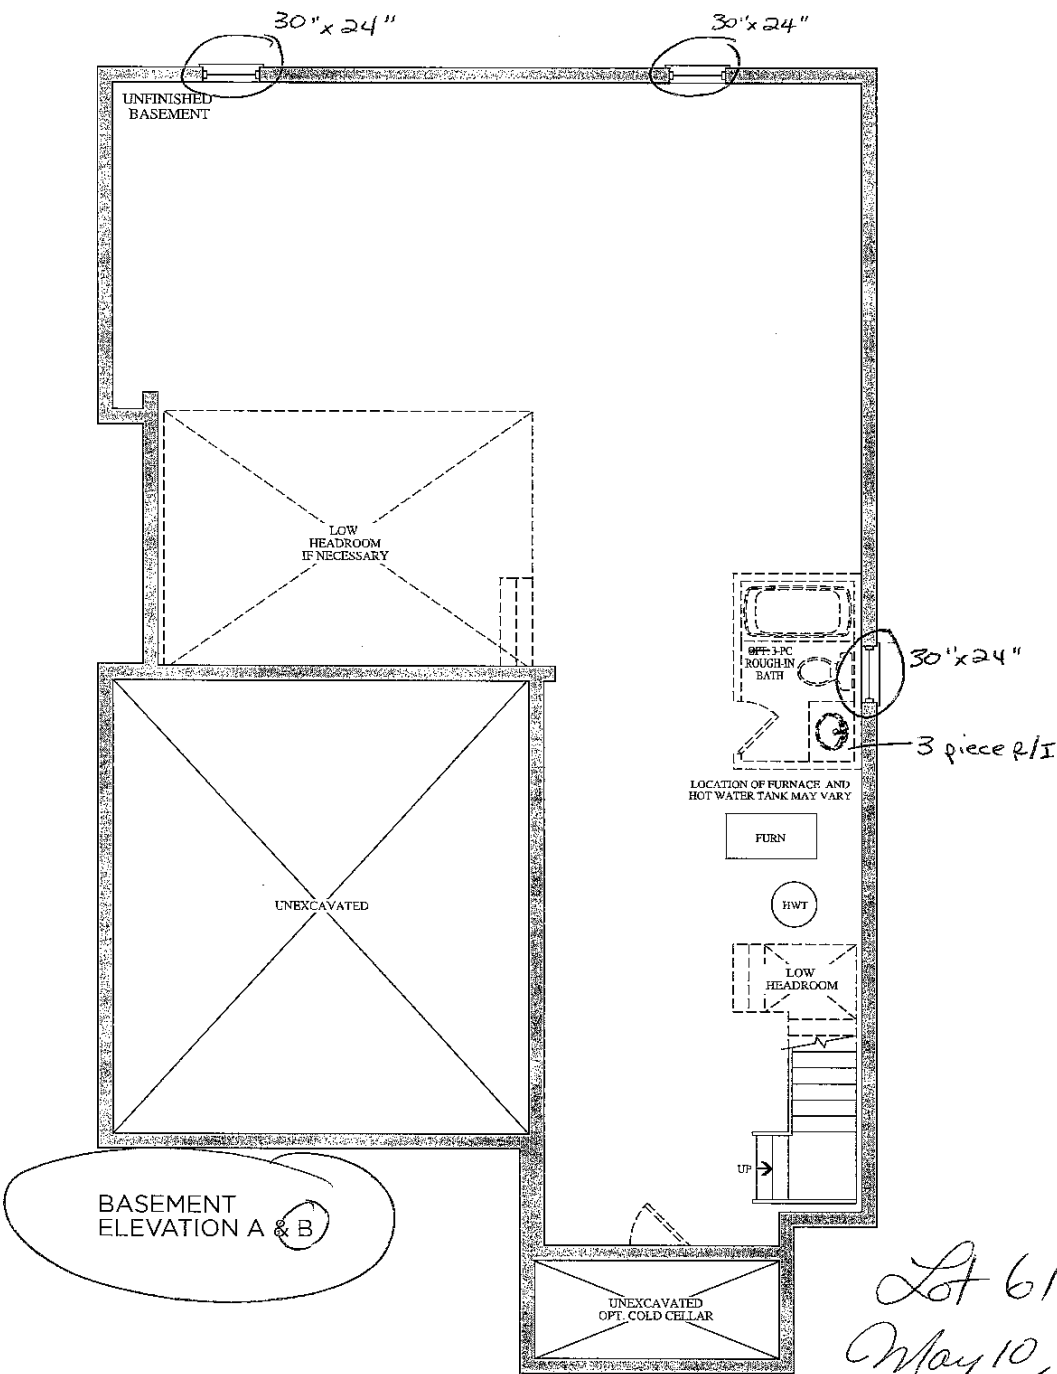



Stacey Carlete
Project Coordinator



Claude Azzopardi
Contracts Manager



Nancy Mc
Corporate C

61
Lot #



38.1 The Bizet			
Elevation	Circle One	A	2189.6 Square Feet
		B	2186.7 Square Feet
Optional Layouts	Circle All that Apply		

38.2 The Ravel			
Elevation	Circle One	A	2271.5 Square Feet
		B	2273.7 Square Feet
Optional Layouts	Circle All that Apply		

38.3 The Haydn			
Elevation	Circle One	A	2394.5 Square Feet
		B	2388.3 Square Feet
Optional Layouts	Circle All that Apply		

38.4 The Vivaldi			
Elevation	Circle One	A	2459.1 Square Feet
		B	2459.1 Square Feet
Optional Layouts	Circle All that Apply		

38.5 The Handel			
Elevation	Circle One	A	2549.2 Square Feet
		B	2554.7 Square Feet
Optional Layouts	Circle All that Apply		

38.9 The Puccini			
Elevation	Circle One	A	3628.0 Square Feet
		B	3634.7 Square Feet
Optional Layouts	Circle All that Apply	GFA1	GROUND FLOOR Optional Alternative Layout

38.6 The Scarlatti			
Elevation	Circle One	A	3521.1 Square Feet
		B	3508.1 Square Feet
Optional Layouts	Circle All that Apply	GFA1	GROUND FLOOR Optional Alternative Layout

38.7 The Schubert			
Elevation	Circle One	A	3593.8 Square Feet
		B	3610.5 Square Feet
Optional Layouts	Circle All that Apply	GFA1	GROUND FLOOR Optional Alternative Layout
		SFA4	SECOND FLOOR Additional Bedroom

38.8 The Corelli			
Elevation	Circle One	A	3801.5 Square Feet
		B	3801.5 Square Feet
Optional Layouts	Circle All that Apply	GFA1	GROUND FLOOR Optional Alternative Layout
		SFA4	SECOND FLOOR Additional Bedroom w/ Ensuite

41.1 The Strauss			
Elevation	Circle One	A	2554.2 Square Feet
		B	2571.2 Square Feet
Optional Layouts	Circle All that Apply	SFA1	SECOND FLOOR Shower in Lieu of Tub B2

41.2 The Mozart			
Elevation	Circle One	A	2725.9 Square Feet
		B	2711.1 Square Feet
Optional Layouts	Circle All that Apply	SFA1	SECOND FLOOR Shower in Lieu of Tub B2


41.3 The Chopin			
Elevation	Circle One	A	2800.0 Square Feet
		B	2810.5 Square Feet
Optional Layouts	Circle All that Apply		

41.4 The Bach			
Elevation	Circle One	A	2894.4 Square Feet
		B	2894.5 Square Feet
Optional Layouts	Circle All that Apply		

41.5 The Brahms			
Elevation	Circle One	A	3948.1 Square Feet
		B	3949.1 Square Feet
Optional Layouts	Circle All that Apply	GFA1	GROUND FLOOR Optional Alternative Layout
		SFA2	SECOND FLOOR Shower in Lieu of Tub B4
		SFA3	SECOND FLOOR Optional Laundry Layout


41.6 The Verdi			
Elevation	Circle One	A	3862.5 Square Feet
		B	3866.4 Square Feet
Optional Layouts	Circle All that Apply	GFA1	GROUND FLOOR Optional Alternative Layout
		SFA3	SECOND FLOOR Optional Laundry Layout

May 10, 2016

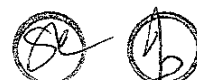


The Bach

Elevation A • 3,046 sq.ft.

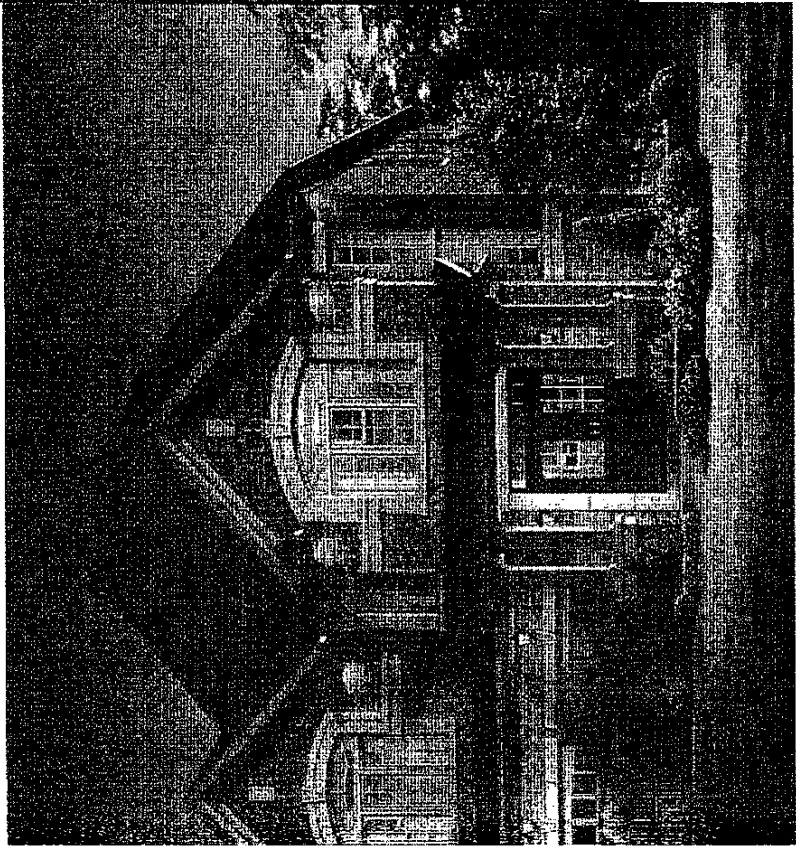

encore
DRAUGHTON

5 exterior
Pot lights

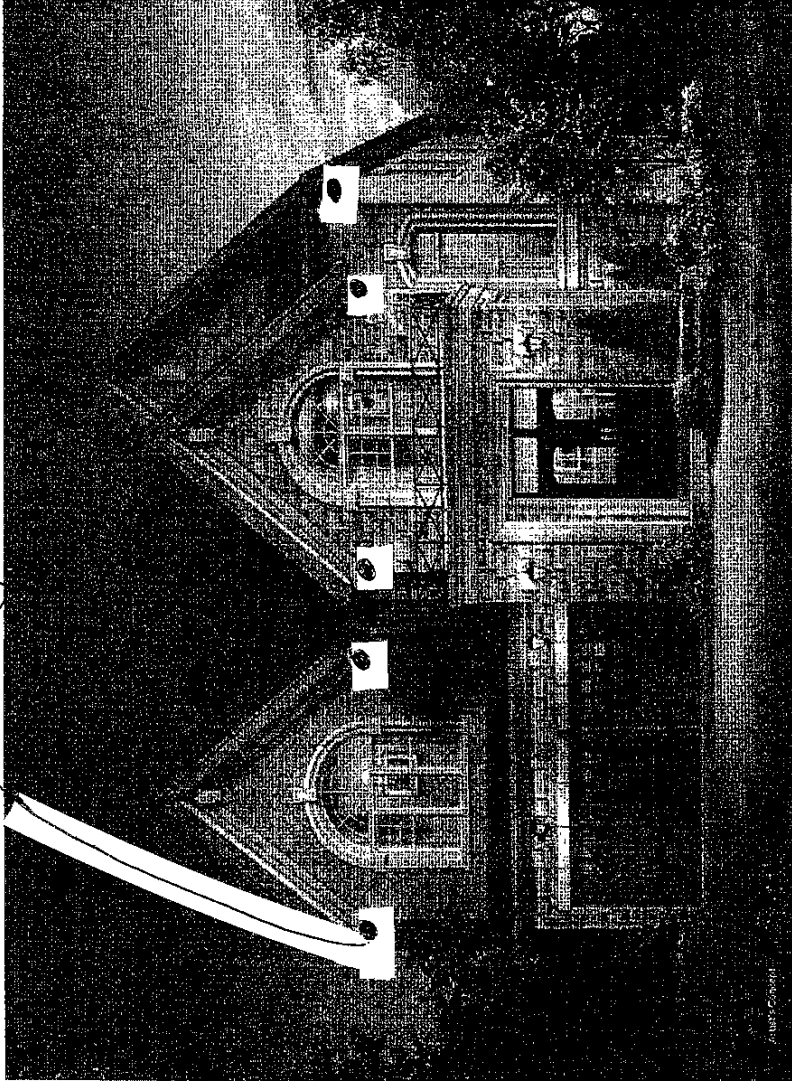

Elevation B • 3,046 sq.ft.

41'
SERIES

ark
COMES

Lot 61
May 10, 16
AV DB

VENDOR

PURCHASER

PURCHASER