



Structural

CONSTRUCTION SUMMARY

93 - 1 - 41-5 Elev.A BRAHMS

CENTRAL VAC AND WIRING

Inv.460	1 - TELEPHONE AND CABLE ROUGH-IN LOCATIONS
Line5761	Note:
27Apr16 / 6Jun16	

ELECTRICAL

Inv.460	1 - KITCHEN: INSTALL 220V WALL RECEPTICAL ON DEDICATED CIRCUIT- FOR 4 WIRE BUILT-IN WALL OVEN -FOR FUTURE MICRO/WALL OVEN UNIT. PURCHASER IS AWARE THAT THEY NEED TO BUY THE APPROPRIATE CABINETRY AT THE TIME OF COLOURS. SEE SKETCH.
Line5987	Note:
27Apr16 / 6Jun16	

Inv.460	1 - KITCHEN: INSTALL 110V WALL RECEPTACLE ON DEDICATED CIRCUIT - FOR MICROWAVE - MICROWAVE NOT INCLUDED. FOR FUTURE MICRO/WALL OVEN UNIT. PURCHASER IS AWARE THAT THEY NEED TO BUY THE APPROPRIATE CABINETRY AT THE TIME OF COLOURS. SEE SKETCH.
Line5988	Note:
27Apr16 / 6Jun16	

Inv.460	1 - BASEMENT: INSTALL 200 AMP ELECTRICAL SERVICE
Line5989	Note:
27Apr16 / 6Jun16	

Inv.460	1 - KITCHEN: INSTALL ADDITIONAL STANDARD FIXTURE WITH SWITCH - MUST SPECIFY LOCATION ON ITS OWN SEPERATE SWITCH. SEE LOCATION
Line5990	Note:
27Apr16 / 6Jun16	

Inv.460	1 - LIVING ROOM: INSTALL ADDITIONAL STANDARD FIXTURE WITH SWITCH - IN LIVING ROOM. SEE SKETCH
Line5996	Note:
27Apr16 / 6Jun16	

Inv.460	1 - BREAKFAST AREA: RELOCATE STANDARD FIXTURE - MUST PROVIDE LOCATION. SEE SKETCH
Line5993	Note:
27Apr16 / 6Jun16	

EXTERIOR COLOURS

Inv.460	1 - EXTERIOR COLOUR PACKAGE 7
Line6562	Note:
27Apr16 / 6Jun16	

FORMING

Inv.460	1 - EXTERIOR: INSTALL SIDE DOOR- HOME TO EXTERIOR- AS PER PLAN AND GRADE PERMITTING
Line5994	Note:
27Apr16 / 6Jun16	

FRAMING

Inv.460	1 - GARAGE: INSTALL MANDOOR - GARAGE TO HOUSE- AS PER PLAN AND GRADE PERMITTING
Line5995	Note: AS PER APS BONUS PACKAGE
27Apr16 / 6Jun16	

CONSTRUCTION SUMMARY

93 - 1 - 41-5 Elev.A BRAHMS

Inv.460	1 - TWIN ENSUITE: INSTALL SHOWER IN LIEU OF TUB- INCLUDES FRAMED GLASS SHOWER ENCLOSURE- IN TWIN ENSUITE
Line5999	Note:
27Apr16 / 6Jun16	
Inv.460	1 - ENSUITE (BED #2) : INSTALL SHOWER IN LIEU OF TUB- INCLUDES FRAMED GLASS SHOWER ENCLOSURE- IN ENSUITE (BED #2)
Line6396	Note:
27Apr16 / 6Jun16	
Inv.460	1 - MANDOOR - GARAGE TO HOUSE- AS PER PLAN AND GRADE PERMITING
Line6564	Note: AS PER APS BONUS PACKAGE
27Apr16 / 6Jun16	

HVAC

Inv.460	1 - KITCHEN: INSTALL GAS LINE ROUGH - MAIN FLOOR - (3 STOREY MODELS) FOR STOVE
Line6000	Note:
27Apr16 / 6Jun16	
Inv.460	1 - Purchaser has attended a Structural appointment at the Decor Centre & has DECLINED any additional upgrades and accepts and acknowledges that there will be no further structural changes/additions/deletions to be made upon signing on May 12, 2016.
Line6003	Note:
27Apr16 / 6Jun16	

MISC.

Inv.460	1 - BONUS PACKAGE: \$10,000.00 (INCLUDING TAXES) WORTH OF UPGRADES FROM GOLD PARK HOMES DÉCOR CENTRE IS BEING APPLIED TOWARD THE STRUCTURAL APPOINTMENT.
Line6002	Note:
27Apr16 / 6Jun16	
Inv.460	1 - Purchasers are aware & accepts that ANY changes made to upgrades after signing this Purchasers Extra Form are subject to a minimum administration fee of \$500. PLUS a 10% holdback fee
Line6004	Note:
27Apr16 / 6Jun16	

PLUMBING

Inv.460	1 - BASEMENT- Install ROUGH-IN - 3PC BASEMENT ROUGH-IN as per floorplan
Line5537	Note:
27Apr16 / 6Jun16	
Inv.460	1 - KITCHEN: INSTALL ROUGH-IN - WATERLINE FOR FRIDGE
Line6001	Note:
27Apr16 / 6Jun16	
Inv.460	1 - TWIN ENSUITE: INSTALL SHOWER IN LIEU OF TUB- INCLUDES FRAMED GLASS SHOWER ENCLOSURE- IN TWIN ENSUITE
Line6567	Note:
27Apr16 / 6Jun16	
Inv.460	1 - ENSUITE (BED #2) : INSTALL SHOWER IN LIEU OF TUB- INCLUDES FRAMED GLASS SHOWER ENCLOSURE- IN ENSUITE (BED #2)
Line6568	Note:
27Apr16 / 6Jun16	

WINDOWS - BASEMENT



CONSTRUCTION SUMMARY

93 - 1 - 41-5 Elev.A BRAHMS

Inv.460	3 - BASEMENT- INSTALL THREE (X3) BASEMENT WINDOWS - UPGRADE EXISTING BASEMENT WINDOW TO 30 INCH X 24 INCH - MAY REQUIRE INSTALLATION OF WINDOW WELL - to be approved by construction
Line5536	Note:
27Apr16 / 6Jun16	




GOLDPARK
HOMES

Telephone — (T)

Cable — (C)

The
Brahms
41' SERIES

Elevation A • 4,038 sq.ft. | Elevation B • 4,038 sq.ft.

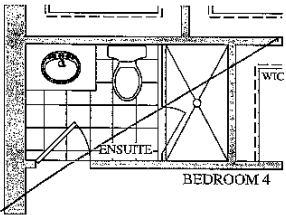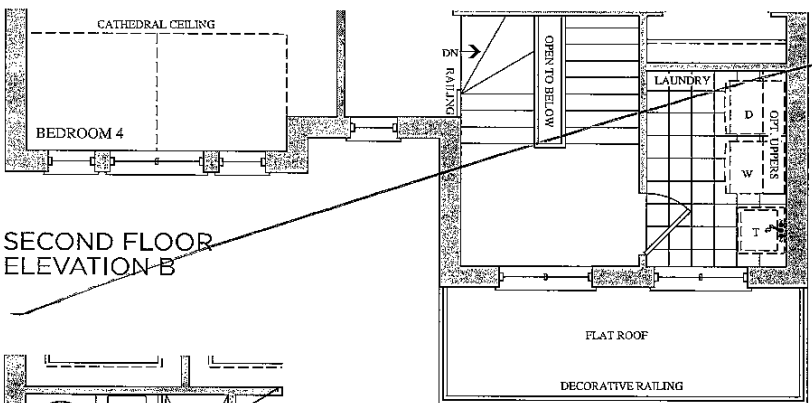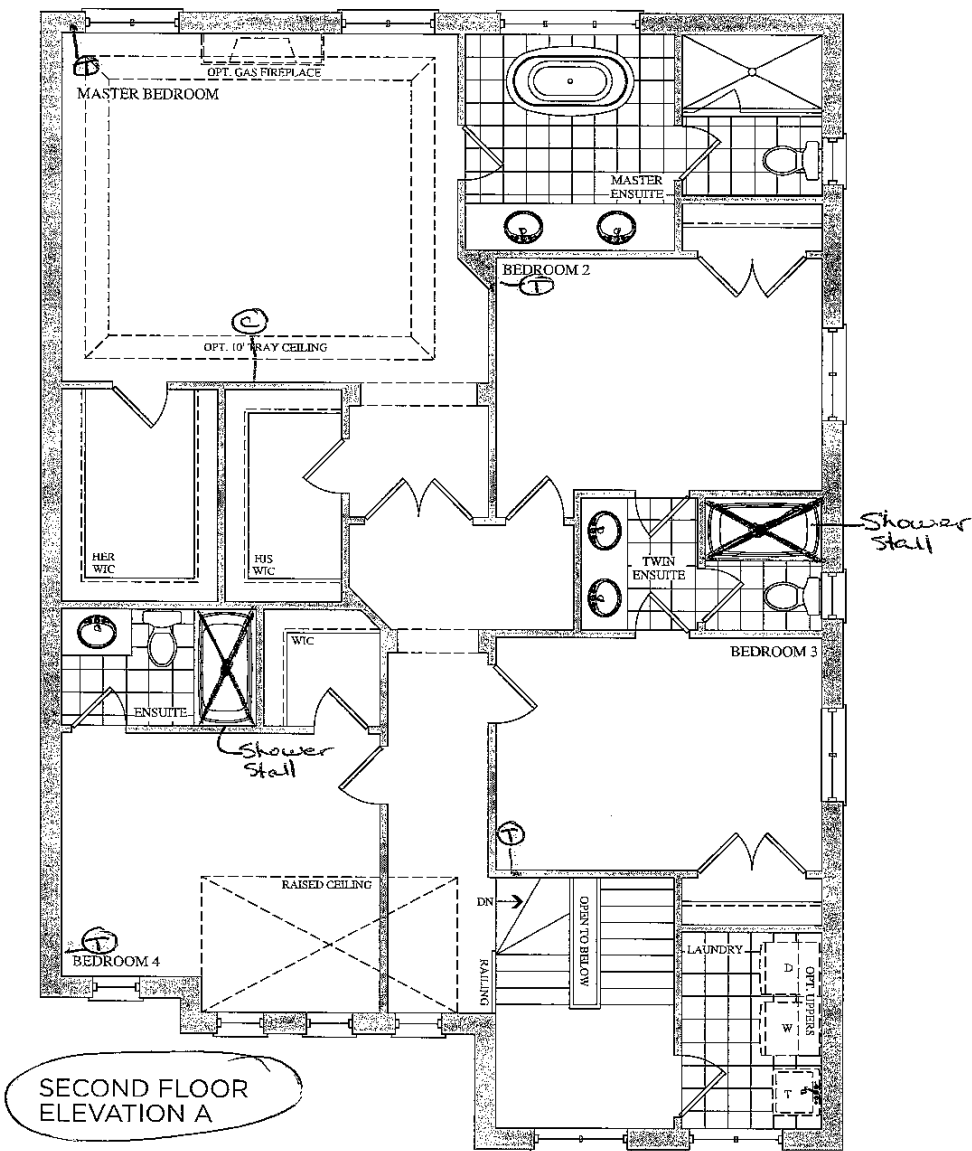

SECOND FLOOR
ELEVATION A & B
OPT. ENSUITE

Lot 93
May 12, 16



(Handwritten signatures)

Prices, figures, illustrations, sizes, features and finishes are subject to change without notice. E.&O.E. Areas and dimensions are approximate and actual usable floor space may vary from the stated area. Layout may be reverse of the unit purchased. E. & O.E.

Elevation A • 4,038 sq.ft. | Elevation B • 4,038 sq.ft.


BASEMENT WINDOWS x 3
↳ 30" x 24"

LOT 93
APRIL 27, 2016

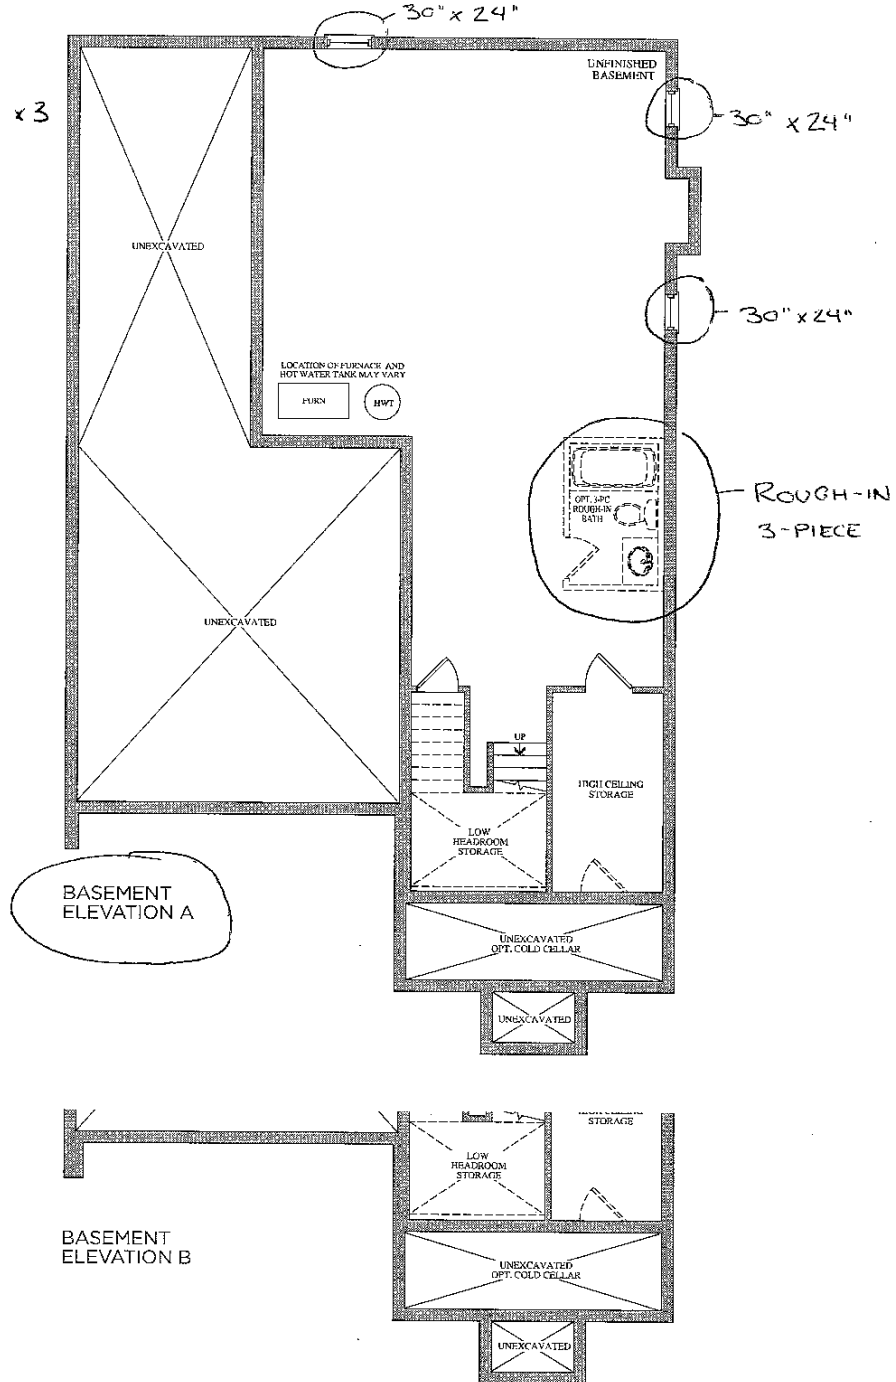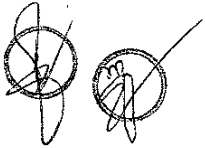


Prices, figures, illustrations, sizes, features and finishes are subject to change without notice. E.&O.E. Areas and dimensions are approximate and actual usable floor space may vary from the stated area. Layout may be reverse of the unit purchased. E. & O.E.

Elevation A • 4,038 sq.ft. | Elevation B • 4,038 sq.ft.

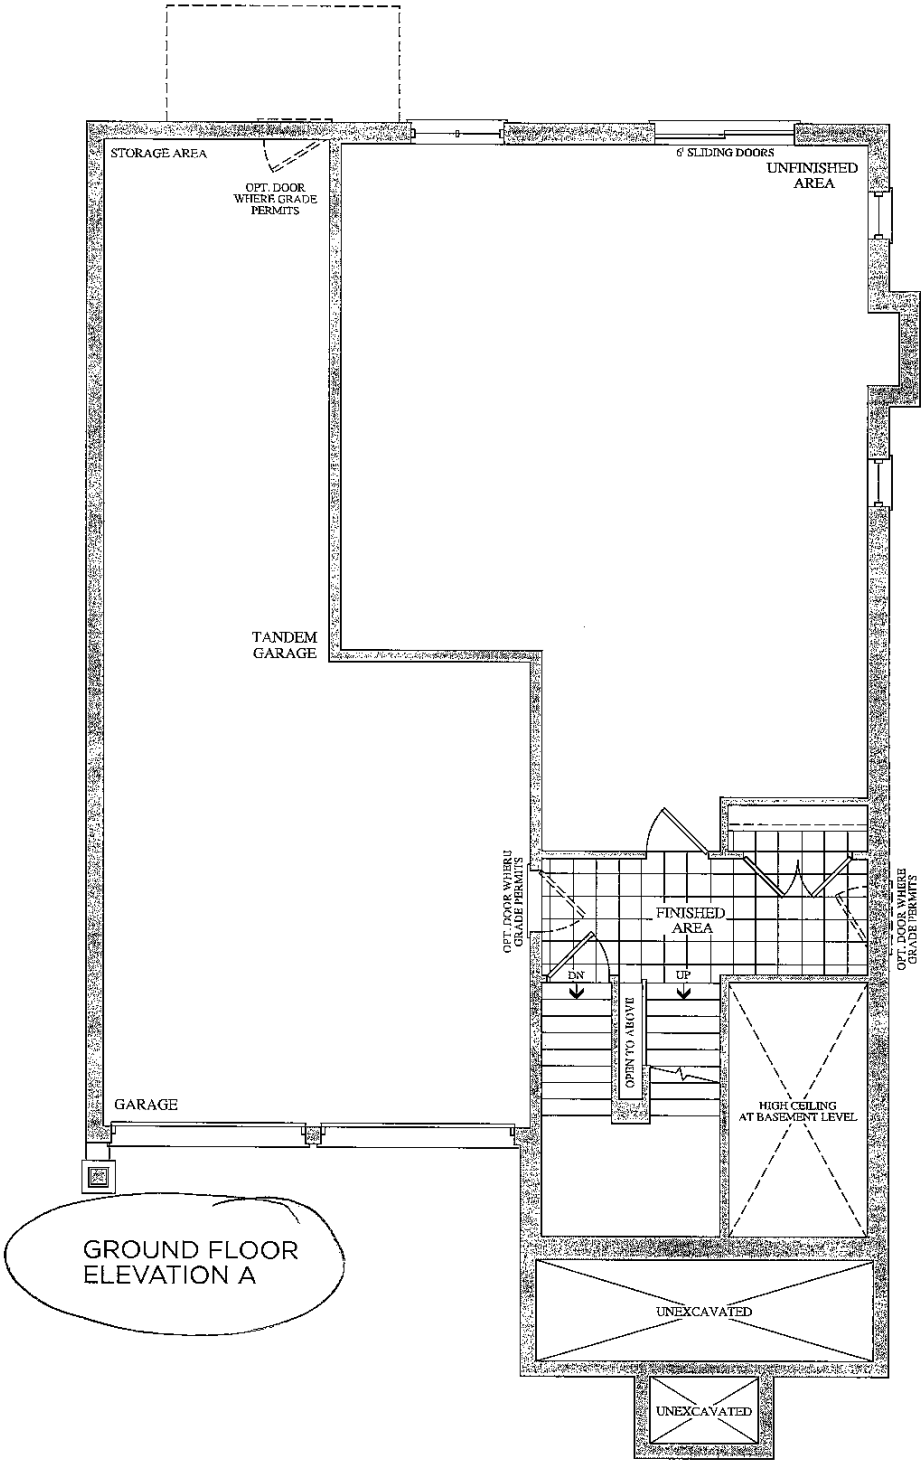

GROUND FLOOR
ELEVATION A

Lot 93
May 12, 16

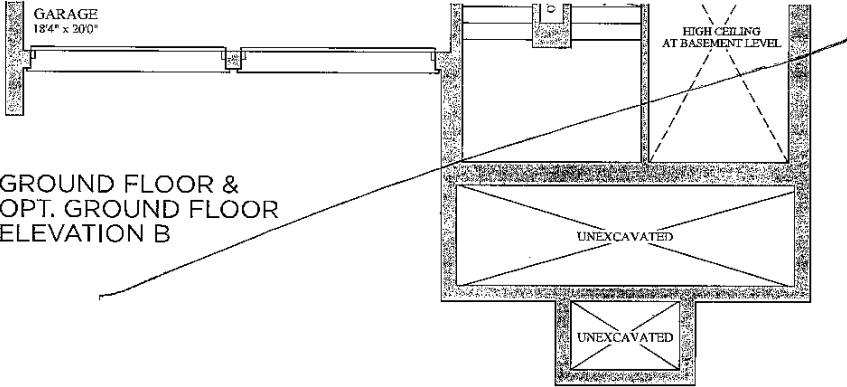

GROUND FLOOR &
OPT. GROUND FLOOR
ELEVATION B

Prices, figures, illustrations, sizes, features and finishes are subject to change without notice. E.&O.E. Areas and dimensions are approximate and actual usable floor space may vary from the stated area. Layout may be reverse of the unit purchased. E. & O.E.