



CONSTRUCTION SUMMARY

98 - 1 - 41-1 Elev.A STRAUSS

CENTRAL VAC AND WIRING

Inv.429	1 - FAMILY ROOM: INSTALL CONDUIT PIPE- FOR TELEVISION- MUST SPECIFY LOCATION AND TERMINATION POINT
Line5635	Note:
15Apr16 / 27May16	
Inv.429	1 - TELEPHONE AND CABLE ROUGH-IN LOCATIONS
Line5634	Note:
15Apr16 / 27May16	

ELECTRICAL

Inv.429	1 - FAMILY ROOM: INSTALL 110V WALL RECEPTACLE ON DEDICATED CIRCUIT - ABOVE FIREPLACE. SEE SKETCH
Line5636	Note:
15Apr16 / 27May16	
Inv.429	1 - KITCHEN: INSTALL 220V WALL RECEPTICAL ON DEDICATED CIRCUIT- FOR 4 WIRE BUILT-IN WALL OVEN - FOR FUTURE MICRO/WALL OVEN UNIT. PURCHASER MUST BUY APPROPRIATE CABINETRY AT THE TIME OF COLOURS. SEE SKETCH
Line5651	Note:
15Apr16 / 27May16	
Inv.429	1 - KITCHEN: INSTALL 110V WALL RECEPTACLE ON DEDICATED CIRCUIT - FOR MICROWAVE - MICROWAVE NOT INCLUDED FOR FUTURE MICRO/WALL OVEN UNIT. PURCHASER MUST BUY APPROPRIATE CABINETRY AT THE TIME OF COLOURS
Line5645	Note:
15Apr16 / 27May16	

EXTERIOR COLOURS

Inv.429	1 - EXTERIOR COLOUR PACKAGE 2
Line6302	Note:
15Apr16 / 27May16	

FRAMING

Inv.429	1 - EXTERIOR: INSTALL SIDE DOOR- HOME TO EXTERIOR- AS PER PLAN AND GRADE PERMITTING
Line5122	Note:
15Apr16 / 27May16	
Inv.429	1 - FAMILY ROOM: INSTALL OPTIONAL COFFERED CEILING - FAMILY ROOM (PER ROOM AS PER PLAN)
Line5646	Note:
15Apr16 / 27May16	
Inv.429	1 - MASTER ENSUITE: INSTALL SHOWER STALL SHAMPOO SHELF IN MASTER ENSUITE SHOWER STALL
Line5648	Note:
15Apr16 / 27May16	
Inv.429	1 - MANDOOR - GARAGE TO HOUSE- AS PER PLAN AND GRADE PERMITING
Line6301	Note: AS PER APS BONUS PKG
15Apr16 / 27May16	

INTERIOR TRIM AND DOORS

CONSTRUCTION SUMMARY

98 - 1 - 41-1 Elev.A STRAUSS

Inv.429	6 - MAIN FLOOR: INSTALL SIX (6) STANDARD DOOR EXTENDED HEIGHT 96" (PRICE PER DOOR)- GROUND FLOOR 2 STOREY MODELS. TO GO IN CLOSETS, POWDER ROOM, LAUNDRY ROOM AND BASEMENT. SEE SKETCH
Line5649	Note:
15Apr16 / 27May16	

MISC.

Inv.429	1 - BONUS PACKAGE: \$10,000.00 (INCLUDING TAXES) WORHT OF UPGRADES FROM GOLD PARK HOMES DÉCOR CENTRE IS BEING APPLIED TOWARD THE STRUCTURAL APPOINTMENT.
Line5652	Note:
15Apr16 / 27May16	

Inv.429	1 - Purchaser has attended a Structural appointment at the Decor Centre & has DECLINED any additional upgrades and accepts and acknowledges that there will be no further structural changes/additions/deletions to be made upon signing on April 28,2016
Line5653	Note:
15Apr16 / 27May16	

Inv.429	1 - Purchasers are aware & accepts that ANY changes made to upgrades after signing this Purchasers Extra Form are subject to a minimum administration fee of \$500. PLUS a 10% holdback fee
Line5654	Note:
15Apr16 / 27May16	

PLUMBING

Inv.429	1 - KITCHEN: INSTALL ROUGH-IN - WATERLINE FOR FRIDGE
Line5650	Note:
15Apr16 / 27May16	

WINDOWS - BASEMENT

Inv.429	4 - BASEMENT: INSTALL FOUR (4) BASEMENT WINDOWS - UPGRADE EXISTING BASEMENT WINDOW TO 30 INCH X 24 INCH - MAY REQUIRE INSTALLATION OF WINDOW WELL
Line5120	Note:
15Apr16 / 27May16	


WINDOWS AND DOORS

Inv.429	1 - MAN DOOR GARAGE TO HOUSE - OPTIONAL - IF GRADE PERMITS
Line6300	Note: AS PER APS BONUS PKG
15Apr16 / 27May16	

The Strauss

41' SERIES

Elevation A • 2,607 sq.ft. | Elevation B • 2,625 sq.ft.

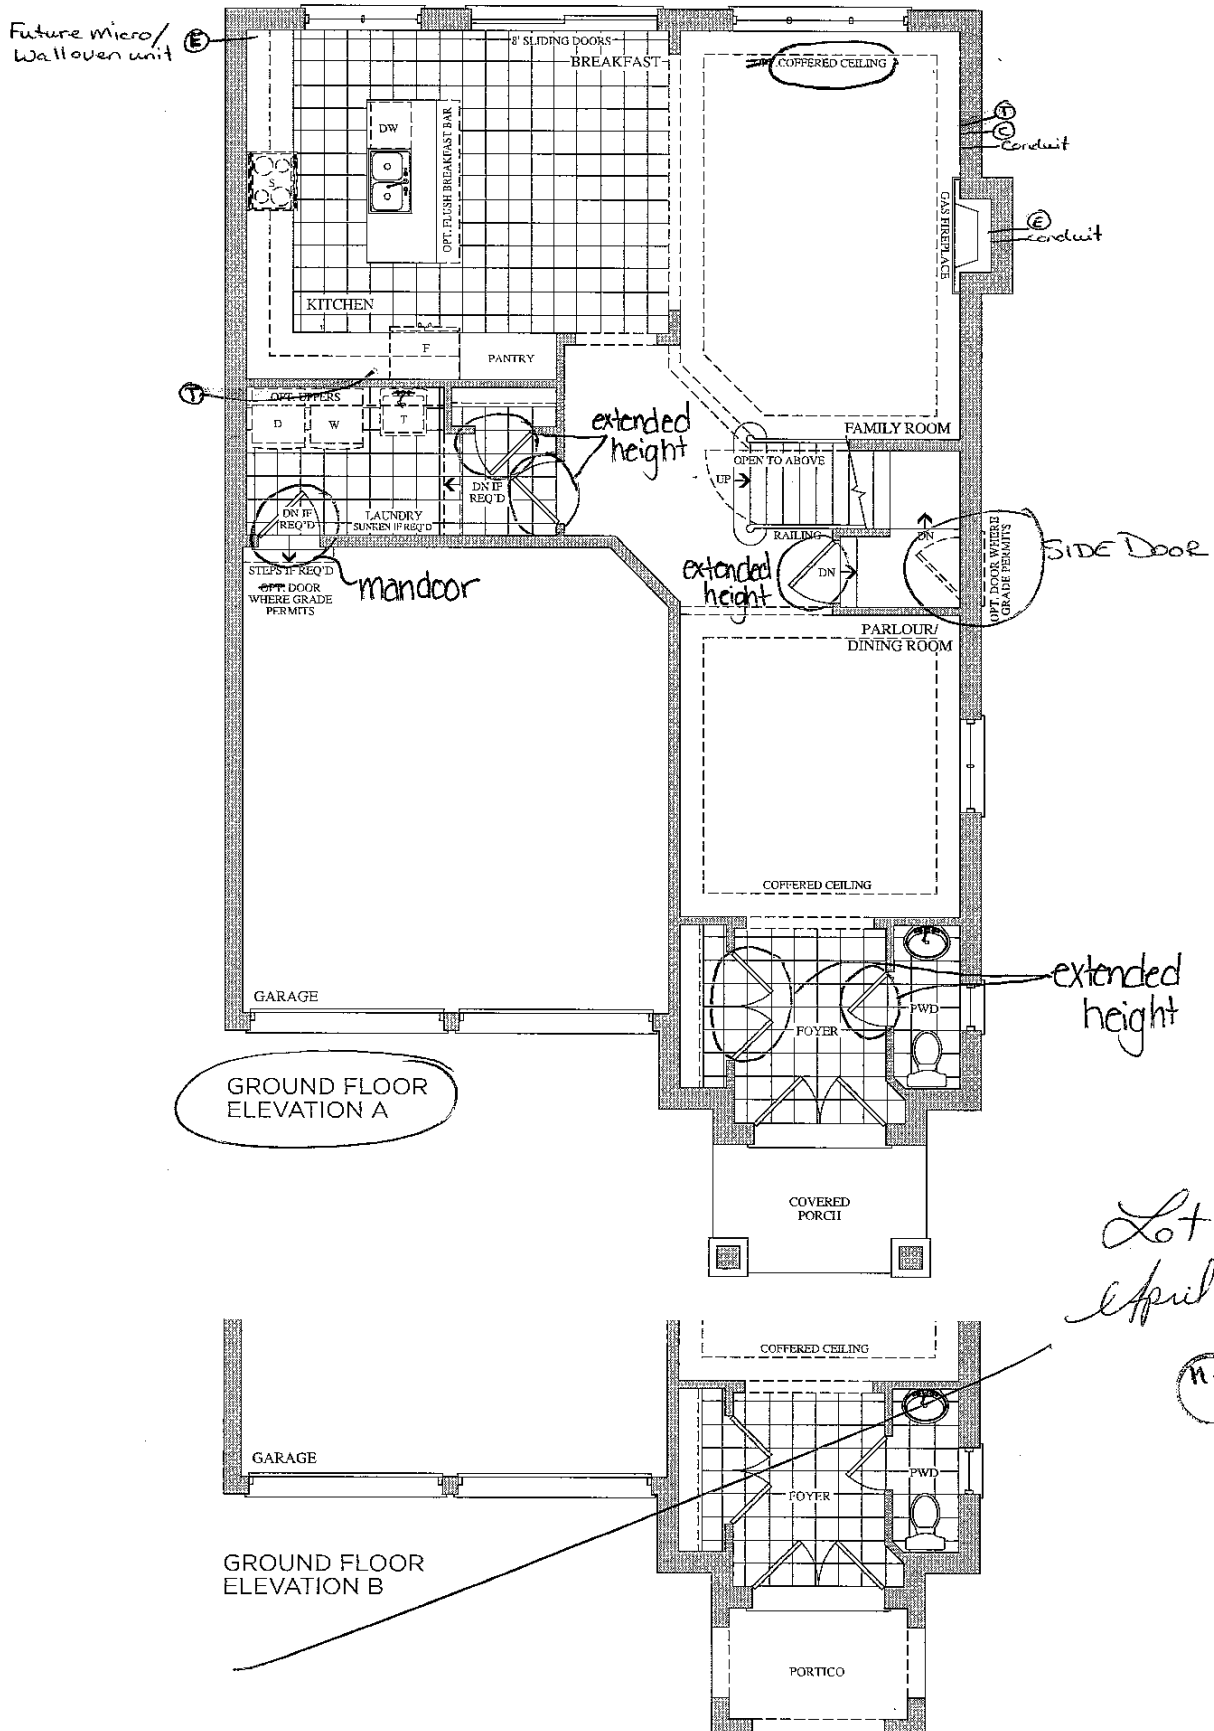




encore
BRAMPTON

Telephone — (T)
Cable — (C)

The Strauss

41' SERIES

Elevation A • 2,607 sq.ft. | Elevation B • 2,625 sq.ft.

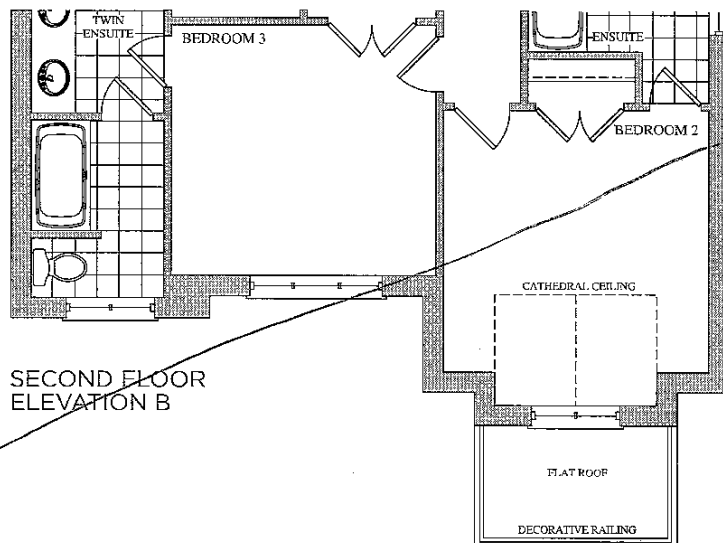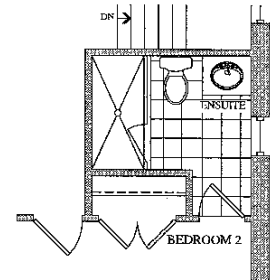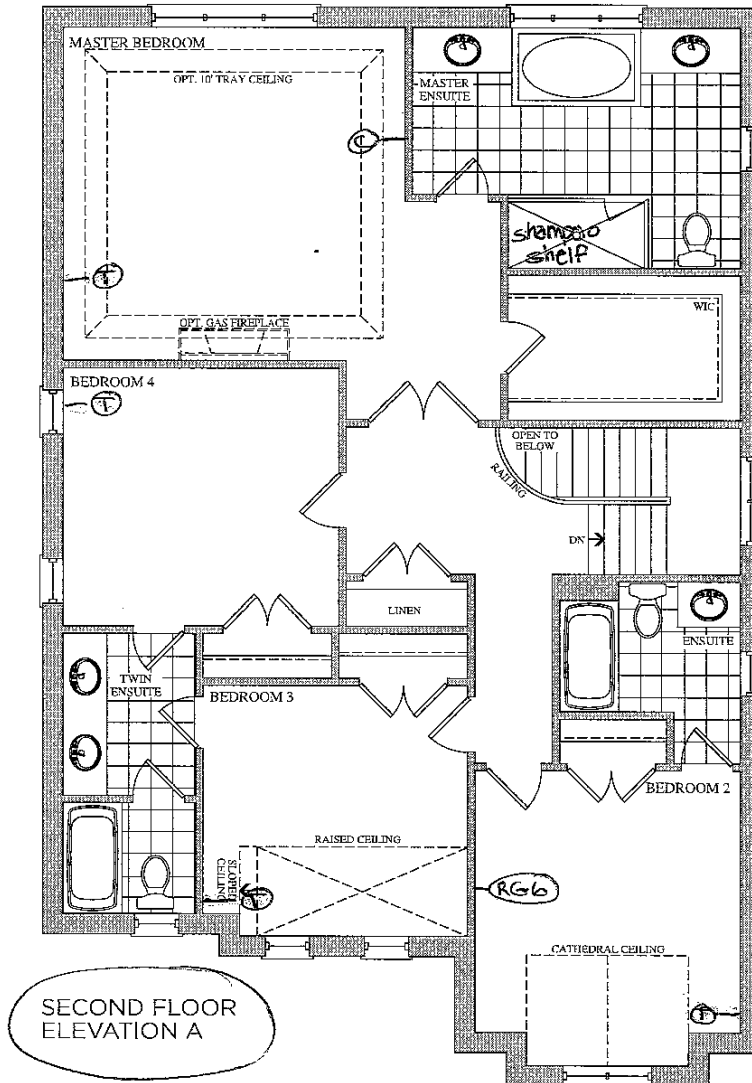

Lot 98
April 28, 16


(H.S.)

Prices, figures, illustrations sizes features and finishes are subject to change without notice. E.&O.E. Areas and dimensions are approximate and actual usable floor space may vary from the stated area. Layout may be reverse of the unit purchased. E. & O.E.

GOLD PARK
HOMES

BSMNT WINDOWS
4 x 30" x 24"

Elevation A • 2,607 sq.ft. | Elevation B • 2,625 sq.ft.

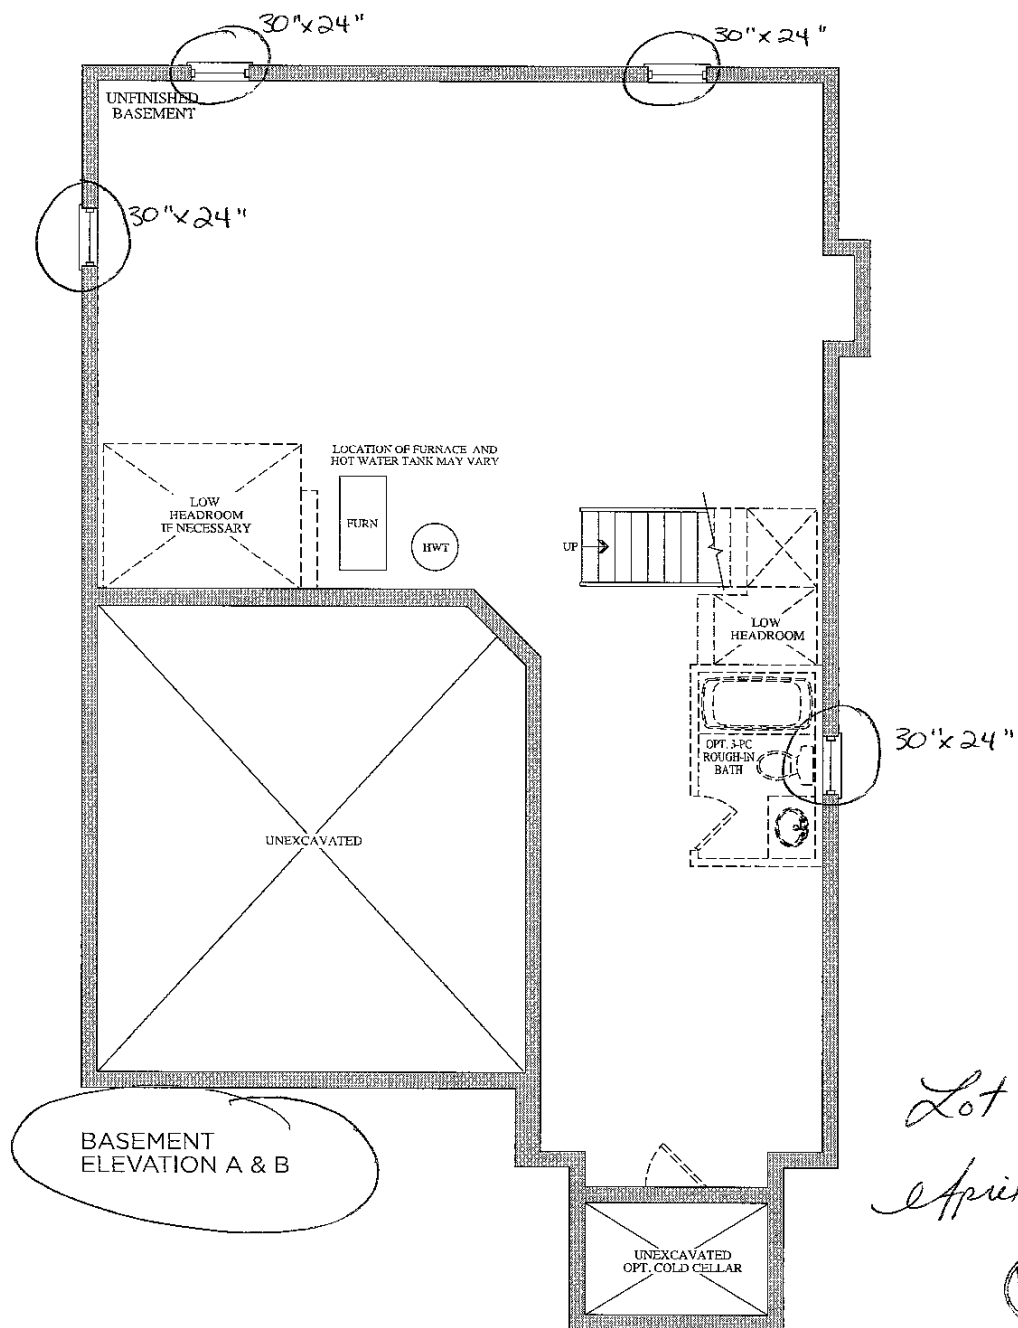

Lot 98
April 28, 16

M.S.



Stacey Carlete
Project Coordinator



Claude Azzopardi
Contracts Manager



Nancy Mc
Corporate C

98
Lot #



38.1 The Bizet			
Elevation	Circle One	A	2189.6 Square Feet
		B	2186.7 Square Feet
Optional Layouts	Circle All that Apply		

38.2 The Ravel			
Elevation	Circle One	A	2271.5 Square Feet
		B	2273.7 Square Feet
Optional Layouts	Circle All that Apply		

38.3 The Haydn			
Elevation	Circle One	A	2394.5 Square Feet
		B	2388.3 Square Feet
Optional Layouts	Circle All that Apply		

38.4 The Vivaldi			
Elevation	Circle One	A	2459.1 Square Feet
		B	2459.1 Square Feet
Optional Layouts	Circle All that Apply		

38.5 The Handel			
Elevation	Circle One	A	2549.2 Square Feet
		B	2554.7 Square Feet
Optional Layouts	Circle All that Apply		

38.9 The Puccini			
Elevation	Circle One	A	3628.0 Square Feet
		B	3634.7 Square Feet
Optional Layouts	Circle All that Apply	GFA1	GROUND FLOOR Optional Alternative Layout

38.6 The Scarlatti			
Elevation	Circle One	A	3521.1 Square Feet
		B	3508.1 Square Feet
Optional Layouts	Circle All that Apply	GFA1	GROUND FLOOR Optional Alternative Layout

38.7 The Schubert			
Elevation	Circle One	A	3593.8 Square Feet
		B	3610.5 Square Feet
Optional Layouts	Circle All that Apply	GFA1	GROUND FLOOR Optional Alternative Layout
		SFA4	SECOND FLOOR Additional Bedroom

38.8 The Corelli			
Elevation	Circle One	A	3801.5 Square Feet
		B	3801.5 Square Feet
Optional Layouts	Circle All that Apply	GFA1	GROUND FLOOR Optional Alternative Layout
		SFA4	SECOND FLOOR Additional Bedroom w/ Ensuite

41.1 The Strauss			
Elevation	Circle One	A	2554.2 Square Feet
		B	2571.2 Square Feet
Optional Layouts	Circle All that Apply	SFA1	SECOND FLOOR Shower in Lieu of Tub B2

41.2 The Mozart			
Elevation	Circle One	A	2725.9 Square Feet
		B	2711.1 Square Feet
Optional Layouts	Circle All that Apply	SFA1	SECOND FLOOR Shower in Lieu of Tub B2

41.3 The Chopin			
Elevation	Circle One	A	2800.0 Square Feet
		B	2810.5 Square Feet
Optional Layouts	Circle All that Apply		

41.4 The Bach			
Elevation	Circle One	A	2894.4 Square Feet
		B	2894.5 Square Feet
Optional Layouts	Circle All that Apply		

41.5 The Brahms			
Elevation	Circle One	A	3948.1 Square Feet
		B	3949.1 Square Feet
Optional Layouts	Circle All that Apply	GFA1	GROUND FLOOR Optional Alternative Layout
		SFA2	SECOND FLOOR Shower in Lieu of Tub B4
		SFA3	SECOND FLOOR Optional Laundry Layout

41.6 The Verdi			
Elevation	Circle One	A	3862.5 Square Feet
		B	3866.4 Square Feet
Optional Layouts	Circle All that Apply	GFA1	GROUND FLOOR Optional Alternative Layout
		SFA3	SECOND FLOOR Optional Laundry Layout

April 28, 16

