

CONSTRUCTION SUMMARY

100 - 1 - 41-4 Elev.B BACH

CENTRAL VAC AND WIRING

Inv.459	1 - TELEPHONE AND CABLE ROUGH-IN LOCATIONS
Line5514	Note:
27Apr16 / 8Jun16	
Inv.459	1 - FAMILY ROOM: INSTALL CONDUIT PIPE- FOR TELEVISION- MUST SPECIFY LOCATION AND TERMINATION POINT. SEE SKETCH
Line5515	Note:
27Apr16 / 8Jun16	
Inv.459	1 - BEDROOM #2: INSTALL RG 6 ROUGH-IN IN BED #2. SEE SKETCH
Line5517	Note:
27Apr16 / 8Jun16	
Inv.459	1 - BEDROOM #3: INSTALL RG 6 ROUGH-IN IN BED #3. SEE SKETCH
Line5518	Note:
27Apr16 / 8Jun16	
Inv.459	1 - BEDROOM #4: INSTALL RG 6 ROUGH-IN IN BED #4. SEE SKETCH
Line5519	Note:
27Apr16 / 8Jun16	

ELECTRICAL

Inv.459	1 - FAMILY ROOM: INSTALL 110V WALL RECEPTACLE ON DEDICATED CIRCUIT ABOVE FIREPLACE. SEE SKETCH
Line5516	Note:
27Apr16 / 8Jun16	
Inv.459	1 - BASEMENT: INSTALL 200 AMP ELECTRICAL SERVICE
Line5520	Note:
27Apr16 / 8Jun16	
Inv.459	1 - KITCHEN: INSTALL KITCHEN CABINET STRIP VALANCE LIGHTS (UNDER CABINETS) - ROUGH - IN -ONLY. DOES NOT INCLUDE (AND REQUIRES) KITCHEN UPGRADE PRICING
Line5521	Note:
27Apr16 / 8Jun16	
Inv.459	1 - KITCHEN: INSTALL 110V WALL RECEPTACLE ON DEDICATED CIRCUIT - FOR MICROWAVE - MICROWAVE NOT INCLUDED. TO ACCOMODATE A FUTURE MICROWAVE/WALL OVEN UNIT BETWEEN FRIDGE AND PANTRY. APPROPRIATE CABINETRY TO BE PURCHASED AT TIME OF COLOURS. SEE SKETCH
Line5530	Note:
27Apr16 / 8Jun16	
Inv.459	1 - KITCHEN: INSTALL 220V WALL RECEPTICAL ON DEDICATED CIRCUIT- FOR 4 WIRE BUILT-IN WALL OVEN - MUST SPECIFY LOCATION. TO ACCOMODATE A FUTURE MICROWAVE/WALL OVEN UNIT BETWEEN FRIDGE AND PANTRY. APPROPRIATE CABINETRY TO BE PURCHASED AT TIME OF COLOURS. SEE SK
Line5531	Note:
27Apr16 / 8Jun16	

EXTERIOR COLOURS

Inv.459	1 - EXTERIOR COLOUR PACKAGE 8
Line6727	Note:
27Apr16 / 8Jun16	

FORMING



CONSTRUCTION SUMMARY

100 - 1 - 41-4 Elev.B BACH

Inv.459	1 - EXTERIOR: INSTALL SIDE DOOR- HOME TO EXTERIOR- AS PER PLAN AND GRADE PERMITTING
Line5522	Note:
27Apr16 / 8Jun16	

FRAMING

Inv.459	1 - MANDOOR - GARAGE TO HOUSE- AS PER PLAN AND GRADE PERMITTING
Line6570	Note: AS PER APS BONUS PACKAGE
27Apr16 / 8Jun16	

Inv.459	1 - FRAME MAIN FLOOR DOORS AT 96" - ADDED WITH THE ADDITION OF TALLER INTERIOR DOORS
Line6725	Note:
27Apr16 / 8Jun16	

Inv.459	1 - MAIN FLOOR: INSTALL FOUR (4) EXTENDED HEIGHT ARCHWAYS (PRICE PER DOORWAY) -SEE SKETCH
Line6726	Note:
27Apr16 / 8Jun16	

HVAC

Inv.459	1 - KITCHEN: INSTALL GAS LINE ROUGH - MAIN FLOOR -FOR STOVE
Line5525	Note:
27Apr16 / 8Jun16	

INTERIOR TRIM AND DOORS

Inv.459	4 - MAIN FLOOR: INSTALL FOUR (4) EXTENDED HEIGHT ARCHWAYS (PRICE PER DOORWAY) -SEE SKETCH
Line5523	Note:
27Apr16 / 8Jun16	

Inv.459	6 - MAIN FLOOR: INSTALL SIX (6) STANDARD DOORS EXTENDED HEIGHT 96" (PRICE PER DOOR)- GROUND FLOOR 2 STOREY MODELS. FOR CLOSETS, BASEMENT, DEN, AND POWDER ROOM. SEE SKETCH
Line5524	Note:
27Apr16 / 8Jun16	

KITCHEN AND BATH CABINETRY

Inv.459	1 - KITCHEN: PANTRY TO BE MOVED OVER APPROX. 3 FEET TO ACCOMODATE A MICROWAVE/WALL OVEN UNIT BETWEEN FRIDGE AND PANTRY. SEE SKETCH
Line5529	Note: PURCHASER IS AWARE THAT THEY MUST BUY APPROPRIATE KITCHEN CABINETRY UPGRADES AT THE TIME OF THE COLOUR APPOINTMENT.
27Apr16 / 8Jun16	

MISC.

Inv.459	1 - BONUS PACKAGE: \$10,000.00 (INCLUDING TAXES) WORHT OF UPGRADES FROM GOLD PARK HOMES DÉCOR CENTRE IS BEING APPLIED TOWARD THE STRUCTURAL APPOINTMENT.
Line5533	Note:
27Apr16 / 8Jun16	

Inv.459	1 - Purchaser has attended a Structural appointment at the Decor Centre & has DECLINED any additional upgrades and accepts and acknowledges that there will be no further structural changes/additions/deletions to be made upon signing on April 27,2016
Line5534	Note:
27Apr16 / 8Jun16	



CONSTRUCTION SUMMARY

100 - 1 - 41-4 Elev.B BACH

Inv.459	1 - Purchasers are aware & accepts that ANY changes made to upgrades after signing this Purchasers Extra Form are subject to a minimum administration fee of \$500. PLUS a 10% holdback fee.
Line5535	Note:
27Apr16 / 8Jun16	

PLUMBING

Inv.459	1 - BASEMENT: INSTALL ROUGH-IN - 3PC BASEMENT ROUGH-IN, AS PER PLAN
Line5526	Note:
27Apr16 / 8Jun16	
Inv.459	1 - KITCHEN: INSTALL ROUGH-IN - WATERLINE FOR FRIDGE
Line5527	Note:
27Apr16 / 8Jun16	
Inv.459	1 - MASTER ENSUITE: INSTALL JET TUB IN LIEU OF STANDARD TUB IN MASTER ENSUITE
Line5528	Note:
27Apr16 / 8Jun16	

WINDOWS - BASEMENT

Inv.459	3 - BASEMENT: INSTALL THREE (3) BASEMENT WINDOWS - UPGRADE EXISTING BASEMENT WINDOW TO 53 INCH X 16 INCH EGRESS. TO BE APPROVED BY CONSTRUCTION
Line5532	Note:
27Apr16 / 8Jun16	



WINDOWS AND DOORS

Inv.459	1 - MAN DOOR GARAGE TO HOUSE - OPTIONAL - IF GRADE PERMITS
Line6569	Note: AS PER APS BONUS PACKAGE
27Apr16 / 8Jun16	

Telephone — (T)
Cable — (C)
Electrical — (E)

The
Bach
41' SERIES

Elevation A • 3,046 sq.ft. | Elevation B • 3,046 sq.ft.

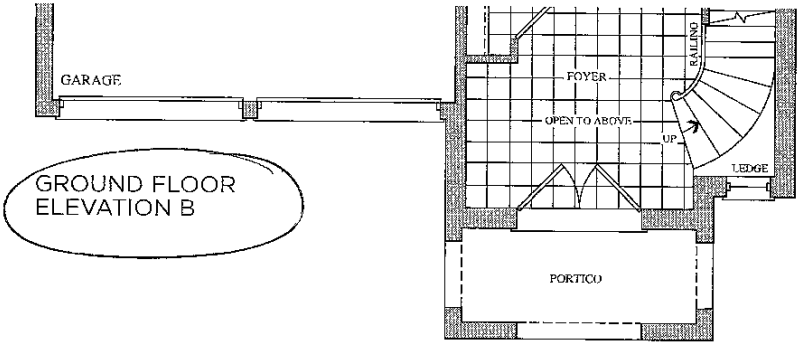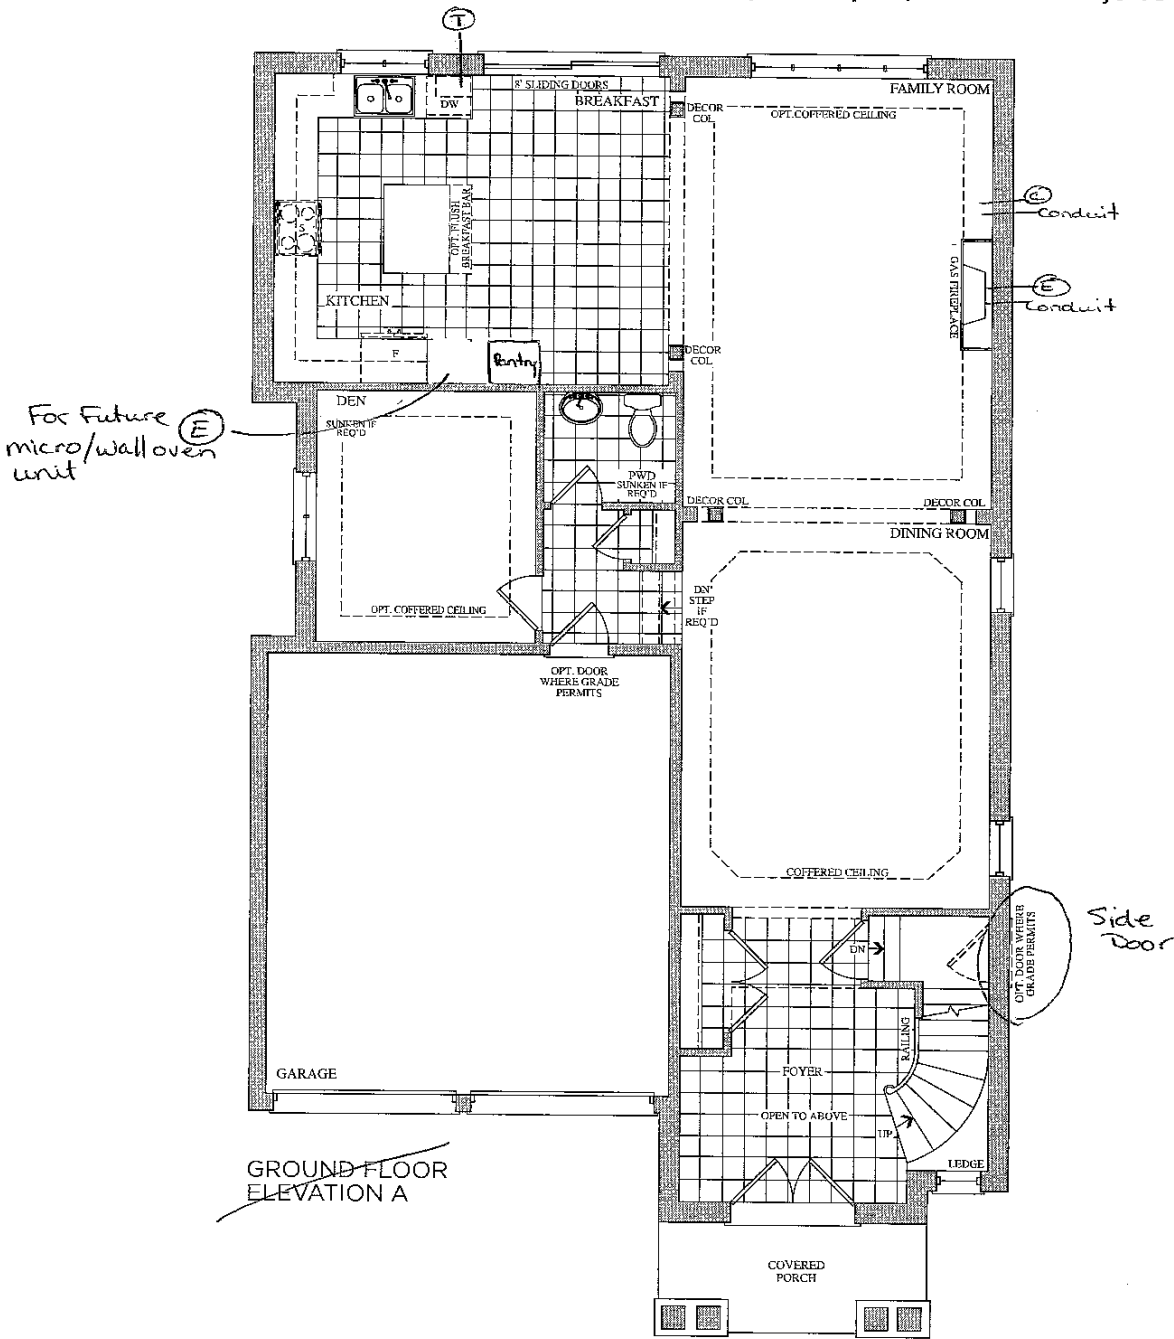



Prices, figures, illustrations, sizes, features and finishes are subject to change without notice. E.&O.E. Areas and dimensions are approximate and actual usable floor space may vary from the stated area. Layout may be reverse of the unit purchased. E. & O.E.

GOLDPARK
HOMES

Telephone — (T)
Cable — (C)

The
Bach
41' SERIES

Elevation A • 3,046 sq.ft. | Elevation B • 3,046 sq.ft.

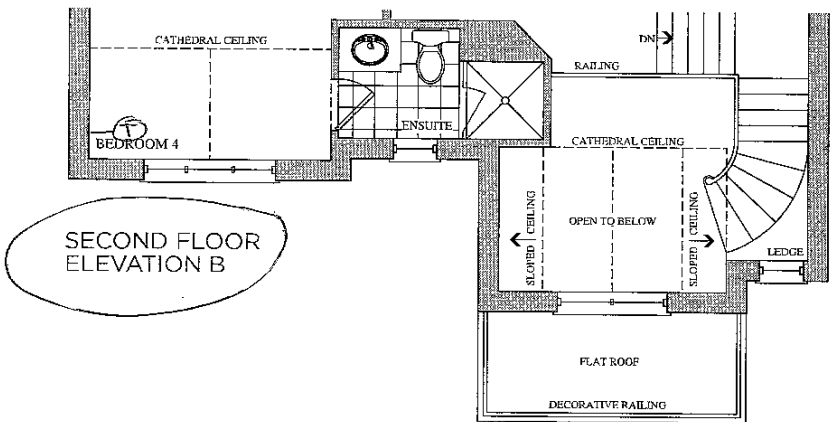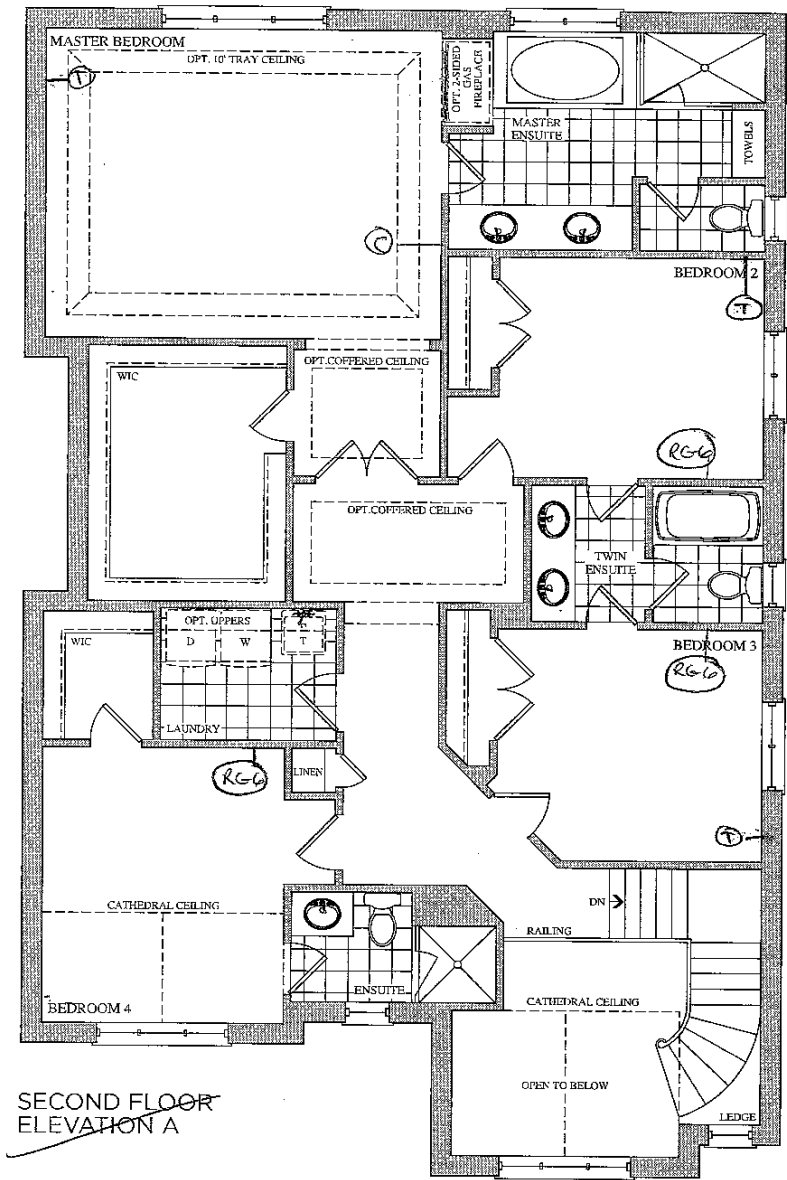


Prices, figures, illustrations, sizes, features and finishes are subject to change without notice. E.&O.E. Areas and dimensions are approximate and actual usable floor space may vary from the stated area. Layout may be reverse of the unit purchased. E. & O.E.

encore
BRAMPTON


BSMT WINDOWS
3x 53"x16"

The
Bach
41' SERIES

Elevation A • 3,046 sq.ft. | Elevation B • 3,046 sq.ft.

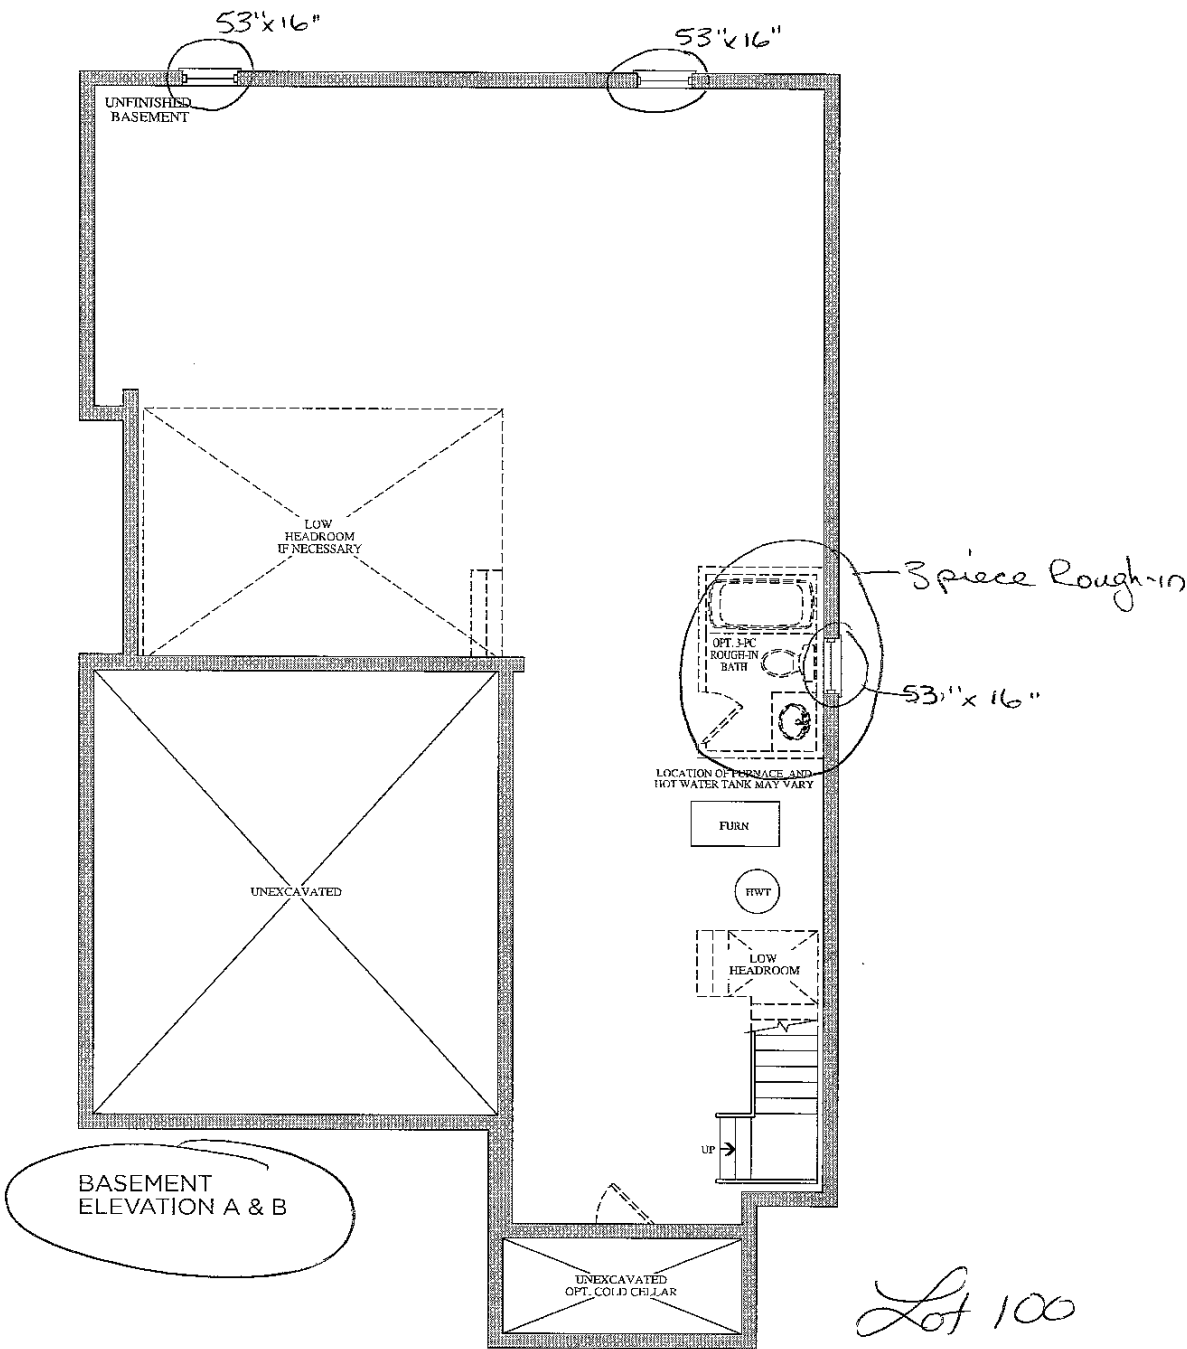

Lot 100
April 27, 16

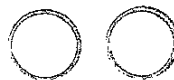

Prices, figures, illustrations, sizes, features and finishes are subject to change without notice. E.&O.E. Areas and dimensions are approximate and actual usable floor space may vary from the stated area. Layout may be reverse of the unit purchased. E. & O.E.

GOLDPARK
HOMES



Stacey Carlete
Project Coordinator



Claude Azzopardi
Contracts Manager



Nancy Mc
Corporate C

100
Lot #



Model	38.1 The Bizet		
Elevation	Circle One	A	2189.6 Square Feet
		B	2186.7 Square Feet
Optional Layouts	Circle All that Apply		

Model	38.2 The Ravel		
Elevation	Circle One	A	2271.5 Square Feet
		B	2273.7 Square Feet
Optional Layouts	Circle All that Apply		

Model	38.3 The Haydn		
Elevation	Circle One	A	2394.5 Square Feet
		B	2388.3 Square Feet
Optional Layouts	Circle All that Apply		

Model	38.4 The Vivaldi		
Elevation	Circle One	A	2459.1 Square Feet
		B	2459.1 Square Feet
Optional Layouts	Circle All that Apply		

Model	38.5 The Handel		
Elevation	Circle One	A	2549.2 Square Feet
		B	2554.7 Square Feet
Optional Layouts	Circle All that Apply		

Model	38.9 The Puccini		
Elevation	Circle One	A	3628.0 Square Feet
		B	3634.7 Square Feet
Optional Layouts	Circle All that Apply	GFA1	GROUND FLOOR Optional Alternative Layout

Model	38.6 The Scarlatti		
Elevation	Circle One	A	3521.1 Square Feet
		B	3508.1 Square Feet
Optional Layouts	Circle All that Apply	GFA1	GROUND FLOOR Optional Alternative Layout

Model	38.7 The Schubert		
Elevation	Circle One	A	3593.8 Square Feet
		B	3610.5 Square Feet
Optional Layouts	Circle All that Apply	GFA1	GROUND FLOOR Optional Alternative Layout
		SFA4	SECOND FLOOR Additional Bedroom

Model	38.8 The Corelli		
Elevation	Circle One	A	3801.5 Square Feet
		B	3801.5 Square Feet
Optional Layouts	Circle All that Apply	GFA1	GROUND FLOOR Optional Alternative Layout
		SFA4	SECOND FLOOR Additional Bedroom w/ Ensuite

Model	41.1 The Strauss		
Elevation	Circle One	A	2554.2 Square Feet
		B	2571.2 Square Feet
Optional Layouts	Circle All that Apply	SFA1	SECOND FLOOR Shower in Lieu of Tub B2

Model	41.2 The Mozart		
Elevation	Circle One	A	2725.9 Square Feet
		B	2711.1 Square Feet
Optional Layouts	Circle All that Apply	SFA1	SECOND FLOOR Shower in Lieu of Tub B2

Model	41.3 The Chopin		
Elevation	Circle One	A	2800.0 Square Feet
		B	2810.5 Square Feet
Optional Layouts	Circle All that Apply		

Model	41.4 The Bach		
Elevation	Circle One	A	2894.4 Square Feet
		B	2894.5 Square Feet
Optional Layouts	Circle All that Apply		

Model	41.5 The Brahms		
Elevation	Circle One	A	3948.1 Square Feet
		B	3949.1 Square Feet
Optional Layouts	Circle All that Apply	GFA1	GROUND FLOOR Optional Alternative Layout
		SFA2	SECOND FLOOR Shower in Lieu of Tub B4
		SFA3	SECOND FLOOR Optional Laundry Layout

Model	41.6 The Verdi		
Elevation	Circle One	A	3862.5 Square Feet
		B	3866.4 Square Feet
Optional Layouts	Circle All that Apply	GFA1	GROUND FLOOR Optional Alternative Layout
		SFA3	SECOND FLOOR Optional Laundry Layout

April 27, 16

