



CONSTRUCTION SUMMARY

106 - 1 - 38-5 Elev.A HANDEL

CENTRAL VAC AND WIRING

Inv.449	1 - TELEPHONE AND CABLE LOCATION SKETCH
Line5428	Note:
25Apr16 / 9Jun16	
Inv.449	1 - FAMILY ROOM: INSTALL CONDUIT PIPE- FOR TELEVISION- MUST SPECIFY LOCATION AND TERMINATION POINT. SEE SKETCH
Line5429	Note:
25Apr16 / 9Jun16	

ELECTRICAL

Inv.449	1 - FAMILY ROOM: INSTALL 110V WALL RECEPTACLE ON DEDICATED CIRCUIT - ABOVE FIREPLACE. SEE SKETCH
Line5430	Note:
25Apr16 / 9Jun16	
Inv.449	1 - KITCHEN: INSTALL 220V WALL RECEPTICAL ON DEDICATED CIRCUIT- FOR 4 WIRE BUILT-IN WALL OVEN - MUST SPECIFY LOCATION. FOR FUTURE WALL OVEN/MICROWAVE COMBO. PURCHASER IS AQWARE THAT THEY NEED TO PURCHASE APPROPRIATE CABINETRY AT TIME OF COLOUR APPOINTMENT
Line5431	Note:
25Apr16 / 9Jun16	
Inv.449	1 - KITCHEN: INSTALL 110V WALL RECEPTACLE ON DEDICATED CIRCUIT - FOR MICROWAVE - MICROWAVE NOT INCLUDED. FOR FUTURE WALL OVEN/MICROWAVE COMBO. PURCHASER IS AQWARE THAT THEY NEED TO PURCHASE APPROPRIATE CABINETRY AT TIME OF COLOUR APPOINTMENT. SEE SKETCH
Line5432	Note:
25Apr16 / 9Jun16	
Inv.449	1 - BASEMENT: INSTALL 200 AMP ELECTRICAL SERVICE IN LIEU OF STANDARD 100 AMPS
Line5433	Note:
25Apr16 / 9Jun16	
Inv.495	1 - KITCHEN: INSTALL 110V WALL RECEPTACLE ON DEDICATED CIRCUIT - FOR FUTURE WARMING DRAWER, TO GO IN A WALL OVEN/MICROWAVE/WARMING DRAWER UNIT. SEE SKETCH
Line6011	Note: PURCHASE IS AWARE THAT THEY WILL NEED TO BUY THE APROPRIATE CABINETRY AT THE TIME OF COLOURS
12May16 / 9Jun16	

EXTERIOR COLOURS

Inv.449	1 - EXTERIOR COLOUR PACKAGE 6
Line6728	Note:
25Apr16 / 9Jun16	

FORMING

Inv.449	1 - EXTERIOR: INSTALL SIDE DOOR- HOME TO EXTERIOR- AS PER PLAN AND GRADE PERMITTING
Line5434	Note:
25Apr16 / 9Jun16	

FRAMING

Inv.449	1 - MANDOOR - GARAGE TO HOUSE- AS PER PLAN AND GRADE PERMITING
Line6730	Note: AS PER APS BONUS PACKAGE
25Apr16 / 9Jun16	

CONSTRUCTION SUMMARY

106 - 1 - 38-5 Elev.A HANDEL

MISC.

Inv.449	1 - BONUS PACKAGE: \$5661.30 (INCLUDING TAXES) WORHT OF UPGRADES FROM GOLD PARK HOMES DÉCOR CENTRE IS BEING APPLIED TOWARD THE STRUCTURAL APPOINTMENT. PURCHASER HAS A REMAINING AMOUNT OF \$9338.70 (INCLUDING TAXES) TO BE USED TOWARD THE COLOUR APPOINTMENT
Line5436	Note:
25Apr16 / 9Jun16	
Inv.449	1 - Purchaser has attended a Structural appointment at the Decor Centre & has DECLINED any additional upgrades and accepts and acknowledges that there will be no further structural changes/additions/deletions to be made upon signing on April 25,2016
Line5437	Note:
25Apr16 / 9Jun16	
Inv.449	1 - Purchasers are aware & accepts that ANY changes made to upgrades after signing this Purchasers Extra Form are subject to a minimum administration fee of \$500. PLUS a 10% holdback fee.
Line5438	Note:
25Apr16 / 9Jun16	
Inv.495	1 - FEE TO RE-OPEN FILE:
	WAIVED AS PER HEAD OFFICE
Line6012	Note:
12May16 / 9Jun16	
Inv.495	1 - BONUS PACKAGE: \$197.75 (INCLUDING TAXES) WORTH OF UPGRADES FROM GOLD PARK HOMES DÉCOR CENTRE IS BEING APPLIED TOWARD THE STRUCTURAL APPOINTMENT. PURCHASER HAS A REMAINING AMOUNT OF \$9140.95(INCLUDING TAXES) TO BE USED TOWARD THE COLOUR APPOINTMENT
Line6013	Note:
12May16 / 9Jun16	
Inv.495	1 - Purchasers are aware & accepts that ANY changes made to upgrades after signing this Purchasers Extra Form are subject to a minimum administration fee of \$500. PLUS a 10% holdback fee
Line6014	Note:
12May16 / 9Jun16	

WINDOWS - BASEMENT

Inv.449	3 - BASEMENT: INSTALL (THREE (3) BASEMENT WINDOWS - UPGRADE EXISTING BASEMENT WINDOW TO 30 INCH X 24 INCH - MAY REQUIRE INSTALLATION OF WINDOW WELL
Line5435	Note:
25Apr16 / 9Jun16	

WINDOWS AND DOORS


Inv.449	1 - MAN DOOR GARAGE TO HOUSE - OPTIONAL - IF GRADE PERMITS
Line6729	Note: AS PER APS BONUS PACKAGE
25Apr16 / 9Jun16	

Telephone — (T)
Cable — (C)
Electrical — (E)


The Handel

38' SERIES

Elevation A • 2,603 sq.ft. | Elevation B • 2,603 sq.ft.

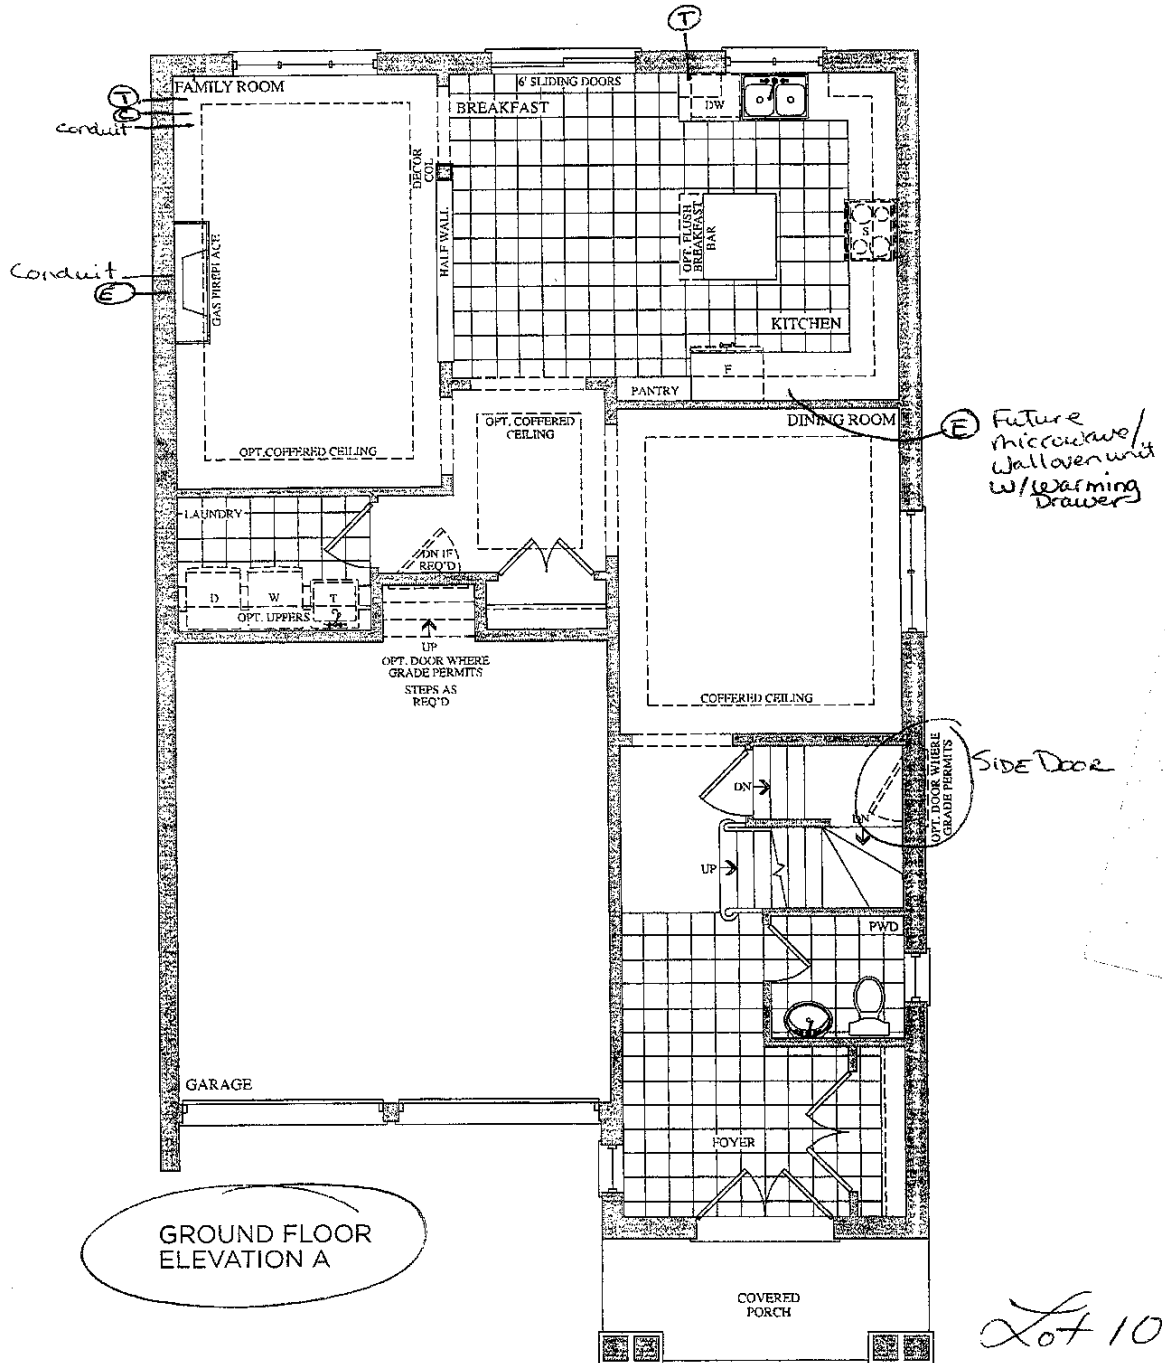

GROUND FLOOR
ELEVATION A

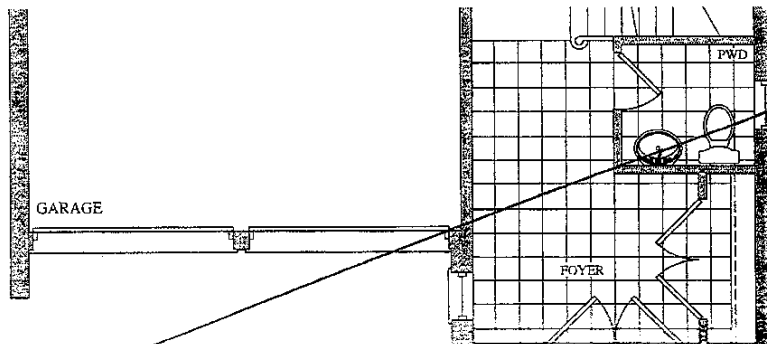

Lot 106
April 25, 16

APM DAM

Lot 106
May 12, 16

OO



SEE NEXT PAGE FOR
SIGNATURES

Telephone — (T)
Cable — (C)

The Handel

38' SERIES

Elevation A • 2,603 sq.ft. | Elevation B • 2,603 sq.ft.

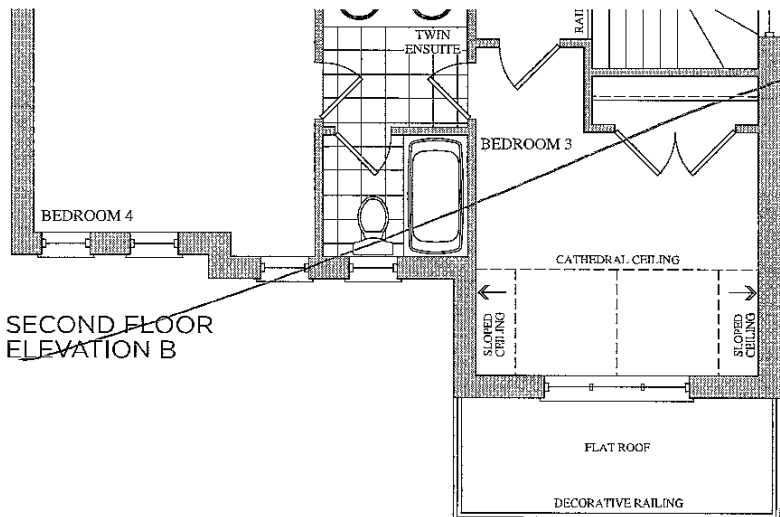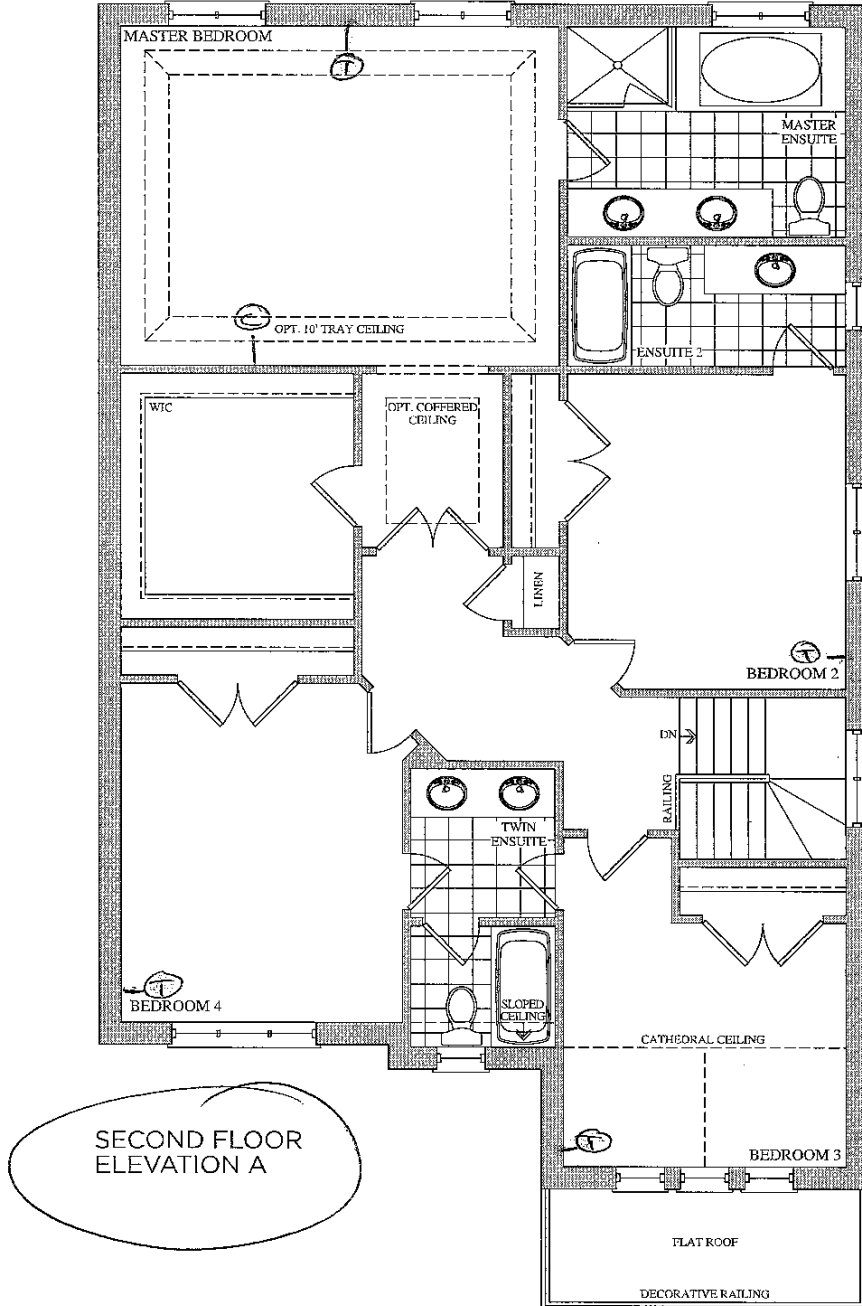


Lot 106
April 25, 16

AAM DAN

BSMWT WINDOWS
3 x 30" x 24"

Elevation A • 2,603 sq.ft. | Elevation B • 2,603 sq.ft.

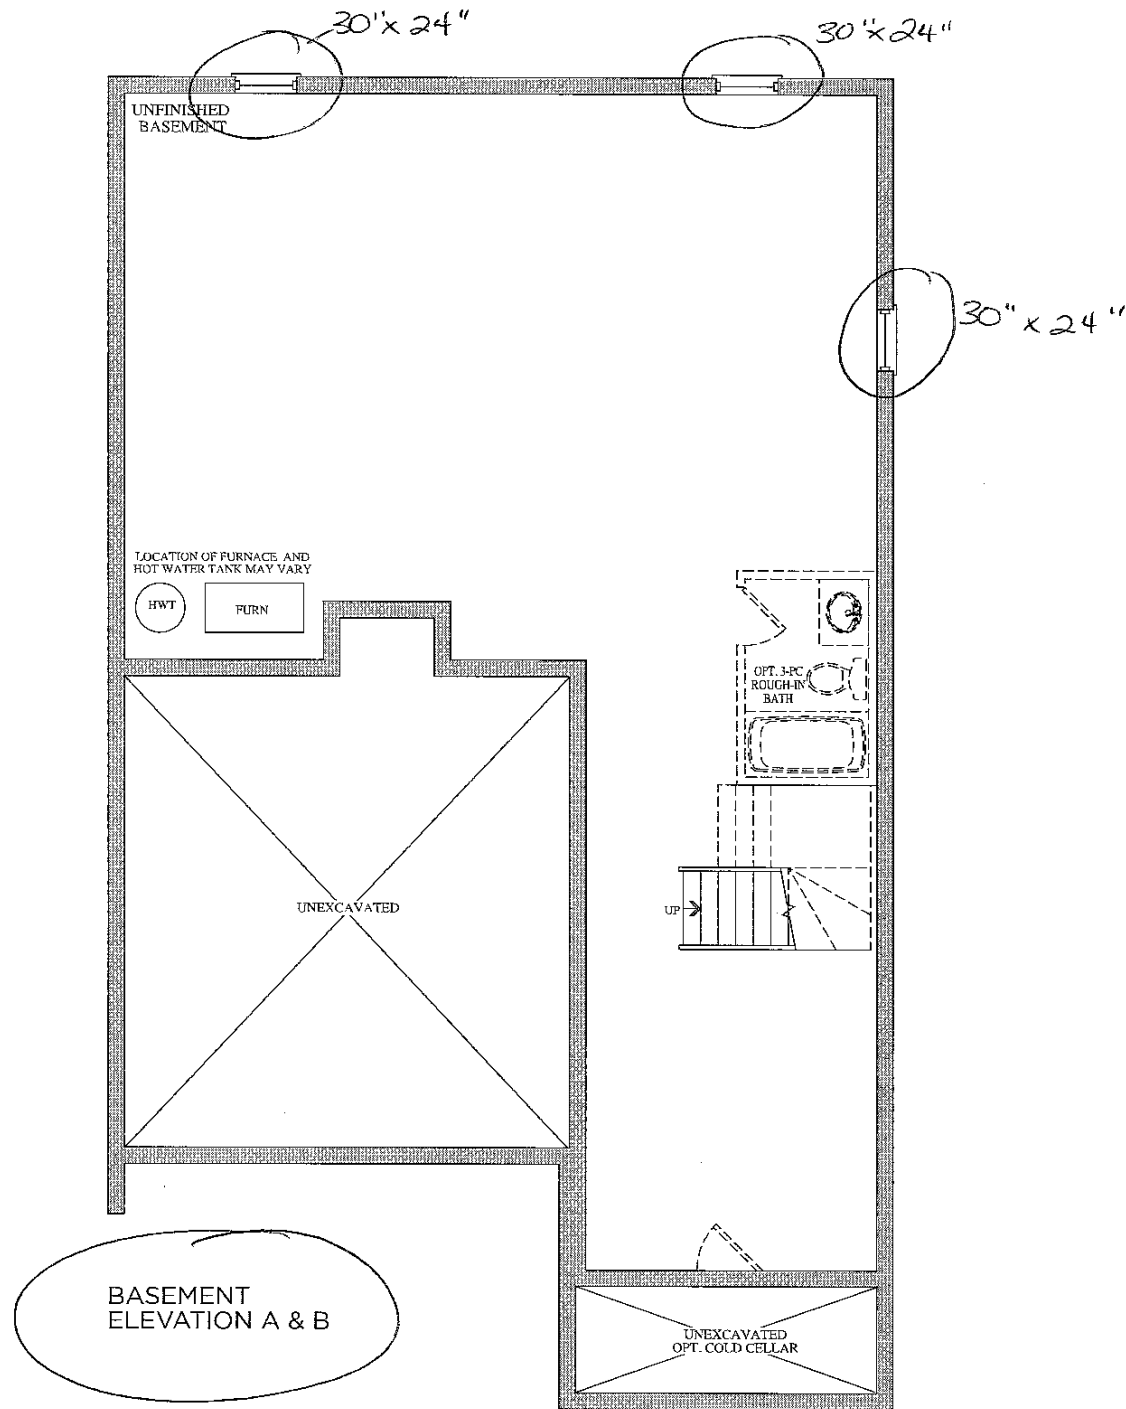

Lot 106
April 25, 2016
AAM DAM

Prices, figures, illustrations, sizes, features and finishes are subject to change without notice. E.&O.E. Areas and dimensions are approximate and actual usable floor space may vary from the stated area. Layout may be reverse of the unit purchased. E. & O.E.



Stacey Carlete
Project Coordinator



Claude Azzopardi
Contracts Manager



Nancy Mc
Corporate C

106
Lot #



38.1 The Bizet			
Elevation	Circle One	A	2189.6 Square Feet
		B	2186.7 Square Feet
Optional Layouts	Circle All that Apply		

38.2 The Ravel			
Elevation	Circle One	A	2271.5 Square Feet
		B	2273.7 Square Feet
Optional Layouts	Circle All that Apply		

38.3 The Haydn			
Elevation	Circle One	A	2394.5 Square Feet
		B	2388.3 Square Feet
Optional Layouts	Circle All that Apply		

38.4 The Vivaldi			
Elevation	Circle One	A	2459.1 Square Feet
		B	2459.1 Square Feet
Optional Layouts	Circle All that Apply		

38.5 The Handel			
Elevation	Circle One	A	2549.2 Square Feet
		B	2554.7 Square Feet
Optional Layouts	Circle All that Apply		

38.9 The Puccini			
Elevation	Circle One	A	3628.0 Square Feet
		B	3634.7 Square Feet
Optional Layouts	Circle All that Apply	GFA1	GROUND FLOOR Optional Alternative Layout

38.6 The Scarlatti			
Elevation	Circle One	A	3521.1 Square Feet
		B	3508.1 Square Feet
Optional Layouts	Circle All that Apply	GFA1	GROUND FLOOR Optional Alternative Layout

38.7 The Schubert			
Elevation	Circle One	A	3593.8 Square Feet
		B	3610.5 Square Feet
Optional Layouts	Circle All that Apply	GFA1	GROUND FLOOR Optional Alternative Layout
		SFA4	SECOND FLOOR Additional Bedroom

38.8 The Corelli			
Elevation	Circle One	A	3801.5 Square Feet
		B	3801.5 Square Feet
Optional Layouts	Circle All that Apply	GFA1	GROUND FLOOR Optional Alternative Layout
		SFA4	SECOND FLOOR Additional Bedroom w/ Ensuite

41.1 The Strauss			
Elevation	Circle One	A	2554.2 Square Feet
		B	2571.2 Square Feet
Optional Layouts	Circle All that Apply	SFA1	SECOND FLOOR Shower in Lieu of Tub B2

41.2 The Mozart			
Elevation	Circle One	A	2725.9 Square Feet
		B	2711.1 Square Feet
Optional Layouts	Circle All that Apply	SFA1	SECOND FLOOR Shower in Lieu of Tub B2

41.3 The Chopin			
Elevation	Circle One	A	2800.0 Square Feet
		B	2810.5 Square Feet
Optional Layouts	Circle All that Apply		

41.4 The Bach			
Elevation	Circle One	A	2894.4 Square Feet
		B	2894.5 Square Feet
Optional Layouts	Circle All that Apply		

41.5 The Brahms			
Elevation	Circle One	A	3948.1 Square Feet
		B	3949.1 Square Feet
Optional Layouts	Circle All that Apply	GFA1	GROUND FLOOR Optional Alternative Layout
		SFA2	SECOND FLOOR Shower in Lieu of Tub B4
		SFA3	SECOND FLOOR Optional Laundry Layout

41.6 The Verdi			
Elevation	Circle One	A	3862.5 Square Feet
		B	3866.4 Square Feet
Optional Layouts	Circle All that Apply	GFA1	GROUND FLOOR Optional Alternative Layout
		SFA3	SECOND FLOOR Optional Laundry Layout

April 25, 16

AAM

DAM