

CONSTRUCTION SUMMARY

111 - 1 - 38-4 Elev.A VIVALDI

CENTRAL VAC AND WIRING

Inv.432	1 - TELEPHONE AND CABLE ROUGH-IN LOCATIONS.
Line5147	Note:
18Apr16 / 9Jun16	

ELECTRICAL

Inv.432	1 - KITCHEN: INSTALL 110V WALL RECEPTACLE ON DEDICATED CIRCUIT - FOR MICROWAVE - MICROWAVE NOT INCLUDED. TO GO ABOVE STOVE
Line5148	Note:
18Apr16 / 9Jun16	

EXTERIOR COLOURS

Inv.432	1 - EXTERIOR COLOUR PACKAGE 8
Line6767	Note:
18Apr16 / 9Jun16	

FORMING

Inv.432	1 - EXTERIOR: INSTALL SIDE DOOR- HOME TO EXTERIOR- AS PER PLAN AND GRADE PERMITTING
Line5150	Note:
18Apr16 / 9Jun16	

FRAMING

Inv.432	1 - TWIN ENSUITE: INSTALL UPGRADED SHOWER IN LIEU OF TUB -INCLUDES FRAMED GLASS WITH POT LIGHT
Line6768	Note:
18Apr16 / 9Jun16	

MISC.

Inv.432	1 - BONUS PACKAGE: \$7797.00 (INCLUDING TAXES) WORHT OF UPGRADES FROM GOLD PARK HOMES DÉCOR CENTRE IS BEING APPLIED TOWARD THE STRUCTURAL APPOINTMENT. PURCHASER HAS A REMAINING AMOUNT OF \$7203.00 (INCLUDING TAXES) TO BE USED TOWARD THE COLOUR APPOINTMENT
Line5153	Note:
18Apr16 / 9Jun16	

Inv.432	1 - Purchaser has attended a STRUCTURAL appointment at the Decor Centre & has DECLINED any additional upgrades and accepts and acknowledges that there will be no further structural changes/additions/deletions to be made upon signing on April 18,2016
Line5154	Note:
18Apr16 / 9Jun16	

Inv.432	1 - Purchasers are aware & accepts that ANY changes made to upgrades after signing this Purchasers Extra Form are subject to a minimum administration fee of \$500. PLUS a 10% holdback fee
Line5155	Note:
18Apr16 / 9Jun16	

PLUMBING

Inv.432	1 - BASEMENT: INSTALL ROUGH-IN - 3PC BASEMENT ROUGH-IN, AS PER PLAN
Line5151	Note:
18Apr16 / 9Jun16	

CONSTRUCTION SUMMARY

111 - 1 - 38-4 Elev.A VIVALDI

Inv.432	1 - TWIN ENSUITE: INSTALL UPGRADED SHOWER IN LIEU OF TUB -INCLUDES FRAMED GLASS WITH POT LIGHT
Line5152	Note:
18Apr16 / 9Jun16	



WINDOWS AND DOORS

Inv.432	1 - GARAGE: MAN DOOR GARAGE TO HOUSE - OPTIONAL - IF GRADE PERMITS **AS PER AGREEMENT OF PURCHASE AND SALE.**
Line5149	Note:
18Apr16 / 9Jun16	

Telephone — (T)
Cable — (C)
Electrical — (E)

The Vivaldi
38' SERIES

Elevation A • 2,518 sq.ft. | Elevation B • 2,518 sq.ft.

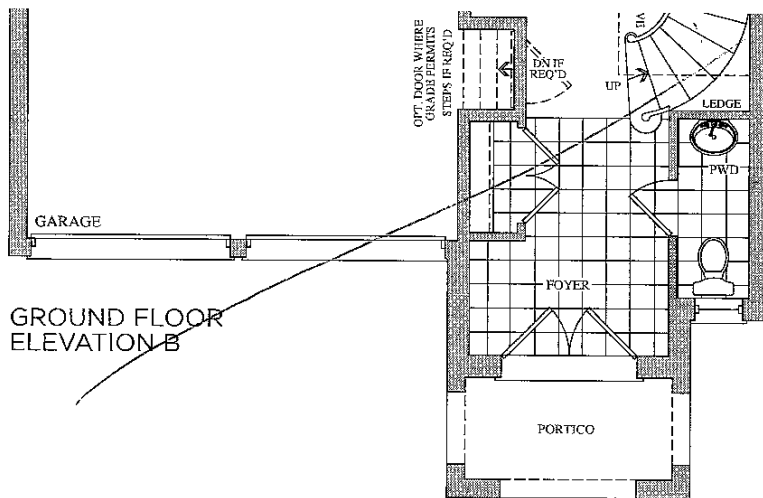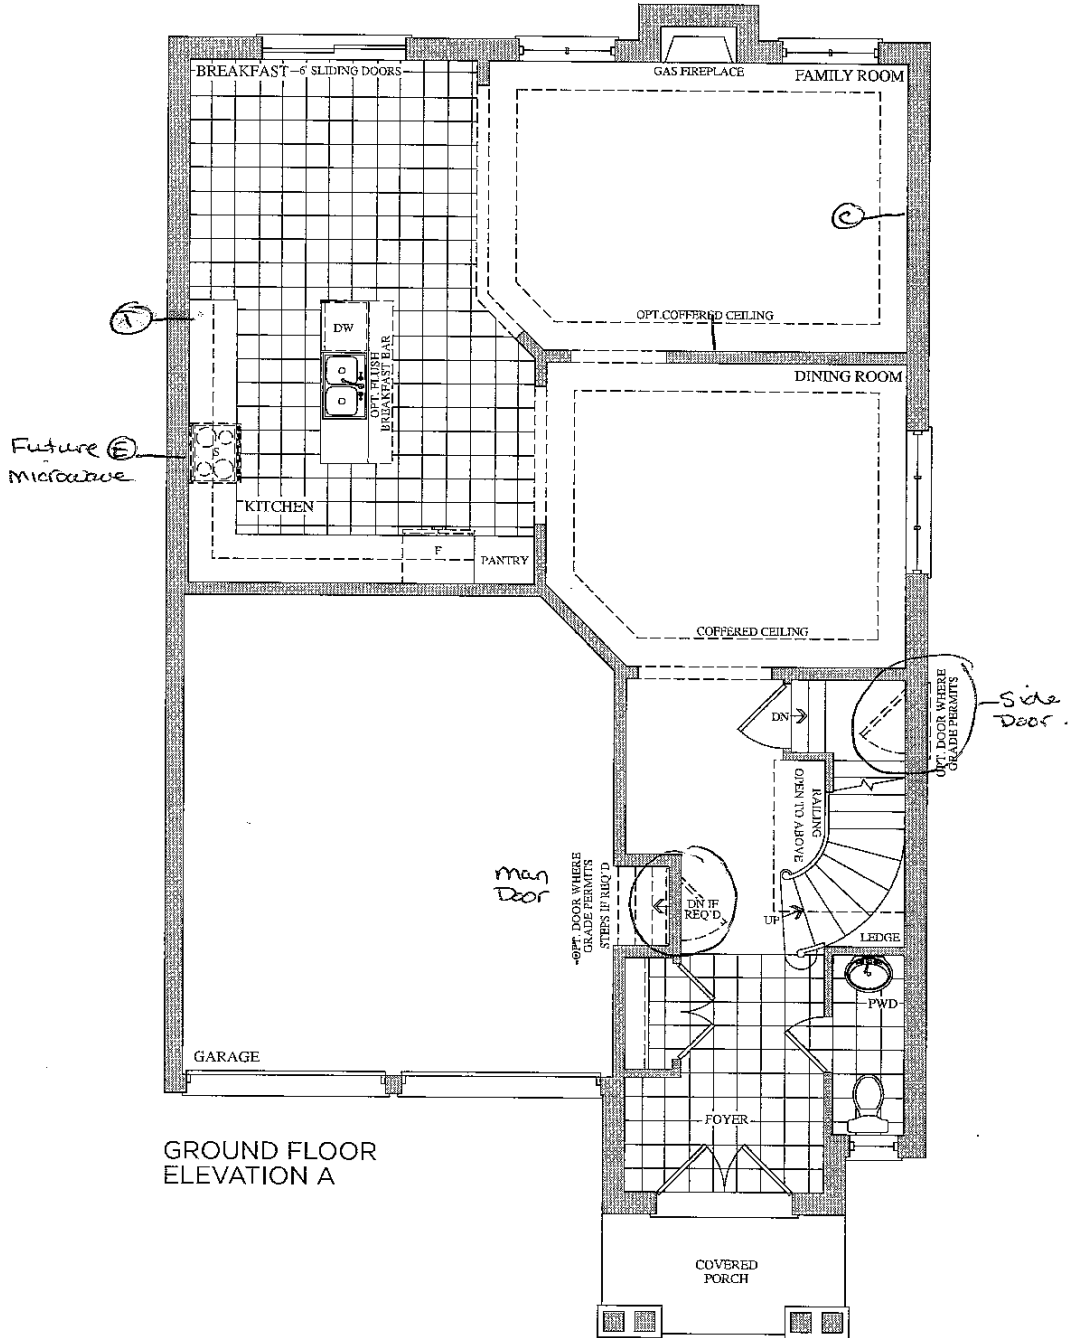

Lot 111
April 18, 2016



(M) (O)

Prices, figures, illustrations, sizes, features and finishes are subject to change without notice. E.&O.E. Areas and dimensions are approximate and actual usable floor space may vary from the stated area. Layout may be reverse of the unit purchased. E. & O.E.

Telephone — (T)
cable — (C)

The Vivaldi
38' SERIES


Elevation A • 2,518 sq.ft. | Elevation B • 2,518 sq.ft.

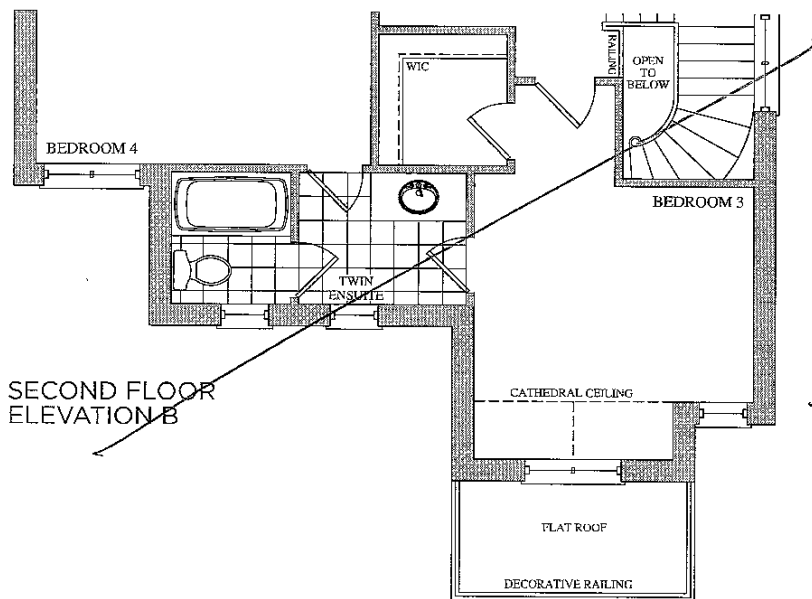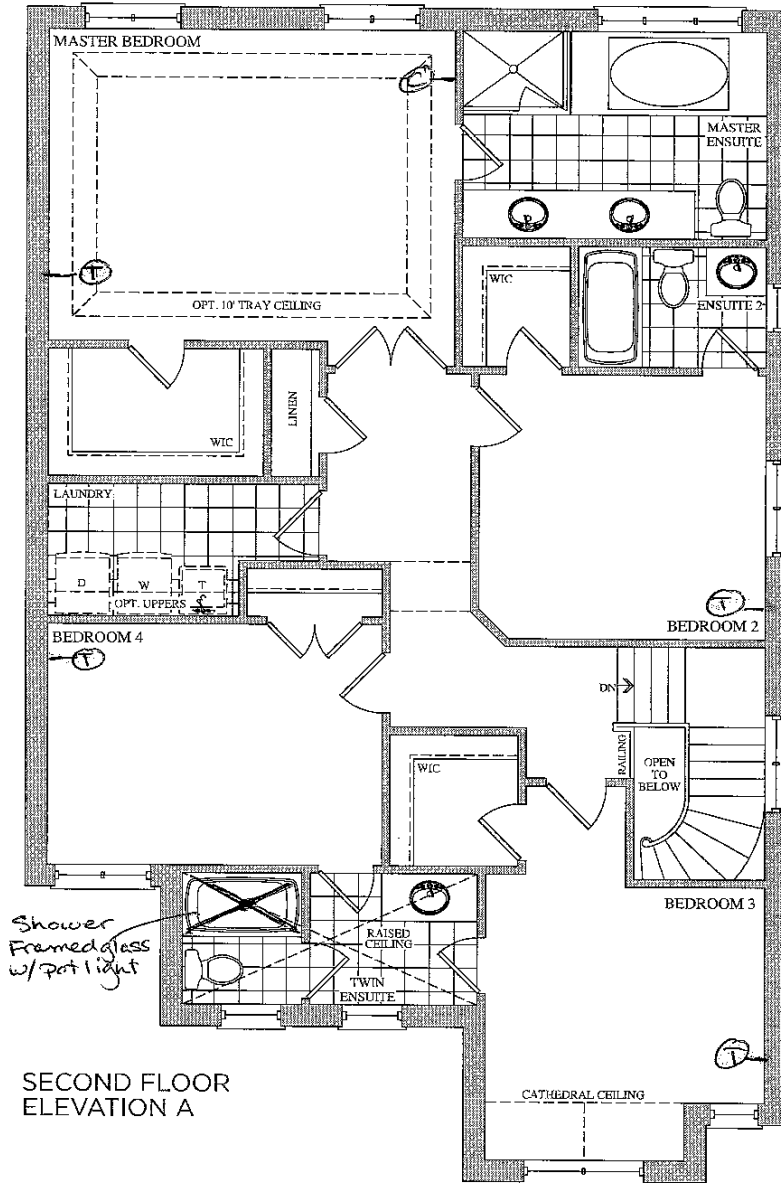

Lot 111
April 18, 2016



Prices, figures, illustrations, sizes, features and finishes are subject to change without notice. E.&O.E. Areas and dimensions are approximate and actual usable floor space may vary from the stated area. Layout may be reverse of the unit purchased. E. & O.E.

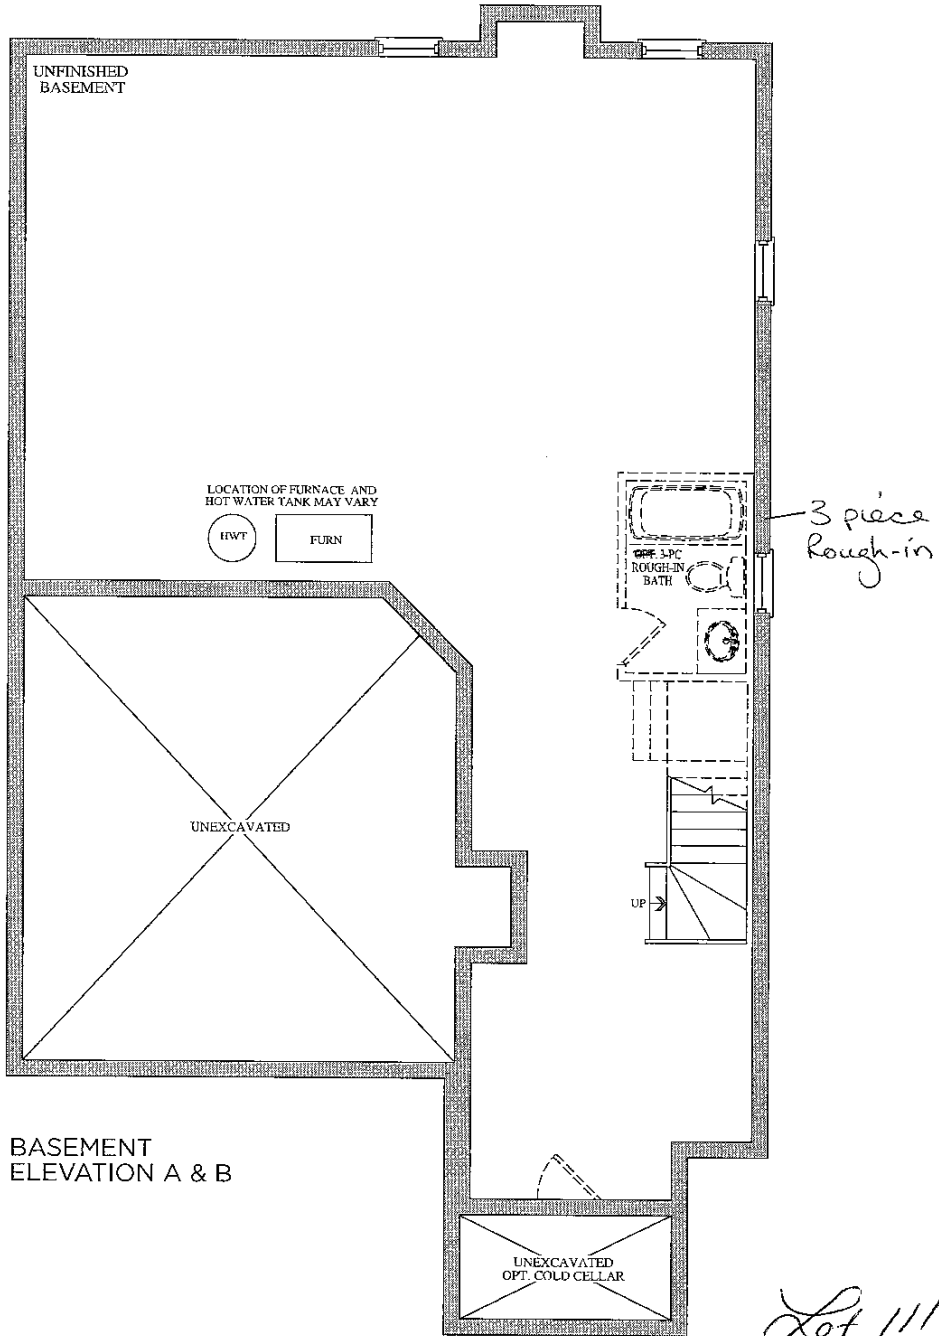

BASEMENT
ELEVATION A & B

Lot 111
April 18, 2016
M.D. ○




Stacey Carlete
Project Coordinator



Claude Azzopardi
Contracts Manager



Nancy Mc
Corporate C

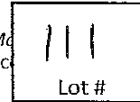

Model 38.1 The Bizet			
Elevation	Circle One	A	2189.6 Square Feet
		B	2186.7 Square Feet
Optional Layouts	Circle All that Apply		

Model 38.2 The Ravel			
Elevation	Circle One	A	2271.5 Square Feet
		B	2273.7 Square Feet
Optional Layouts	Circle All that Apply		

Model 38.3 The Haydn			
Elevation	Circle One	A	2394.5 Square Feet
		B	2388.3 Square Feet
Optional Layouts	Circle All that Apply		

Model 38.4 The Vivaldi			
Elevation	Circle One	A	2459.1 Square Feet
		B	2459.1 Square Feet
Optional Layouts	Circle All that Apply		

Model 38.5 The Handel			
Elevation	Circle One	A	2549.2 Square Feet
		B	2554.7 Square Feet
Optional Layouts	Circle All that Apply		

Model 38.9 The Puccini			
Elevation	Circle One	A	3628.0 Square Feet
		B	3634.7 Square Feet
Optional Layouts	Circle All that Apply	GFA1	GROUND FLOOR Optional Alternative Layout

Model 38.6 The Scarlatti			
Elevation	Circle One	A	3521.1 Square Feet
		B	3508.1 Square Feet
Optional Layouts	Circle All that Apply	GFA1	GROUND FLOOR Optional Alternative Layout

Model 38.7 The Schubert			
Elevation	Circle One	A	3593.8 Square Feet
		B	3610.5 Square Feet
Optional Layouts	Circle All that Apply	GFA1	GROUND FLOOR Optional Alternative Layout
		SFA4	SECOND FLOOR Additional Bedroom

Model 38.8 The Corelli			
Elevation	Circle One	A	3801.5 Square Feet
		B	3801.5 Square Feet
Optional Layouts	Circle All that Apply	GFA1	GROUND FLOOR Optional Alternative Layout
		SFA4	SECOND FLOOR Additional Bedroom w/ Ensuite

Model 41.1 The Strauss			
Elevation	Circle One	A	2554.2 Square Feet
		B	2571.2 Square Feet
Optional Layouts	Circle All that Apply	SFA1	SECOND FLOOR Shower in Lieu of Tub B2

Model 41.2 The Mozart			
Elevation	Circle One	A	2725.9 Square Feet
		B	2711.1 Square Feet
Optional Layouts	Circle All that Apply	SFA1	SECOND FLOOR Shower in Lieu of Tub B2

Model 41.3 The Chopin			
Elevation	Circle One	A	2800.0 Square Feet
		B	2810.5 Square Feet
Optional Layouts	Circle All that Apply		

Model 41.4 The Bach			
Elevation	Circle One	A	2894.4 Square Feet
		B	2894.5 Square Feet
Optional Layouts	Circle All that Apply		

Model 41.5 The Brahms			
Elevation	Circle One	A	3948.1 Square Feet
		B	3949.1 Square Feet
Optional Layouts	Circle All that Apply	GFA1	GROUND FLOOR Optional Alternative Layout
		SFA2	SECOND FLOOR Shower in Lieu of Tub B4
		SFA3	SECOND FLOOR Optional Laundry Layout

Model 41.6 The Verdi			
Elevation	Circle One	A	3862.5 Square Feet
		B	3866.4 Square Feet
Optional Layouts	Circle All that Apply	GFA1	GROUND FLOOR Optional Alternative Layout
		SFA3	SECOND FLOOR Optional Laundry Layout