

Brampton Encore - 28 - 1 - 38-6 Elev.A SCARLATTI
CENTRAL VAC AND WIRING

Inv.525	1 - TELEPHONE AND CABLE ROUGH-IN LOCATION SKETCH
Line6324	Note:
30May16 / 26Sep16	
Inv.525	1 - FAMILY ROOM: INSTALL CONDUIT PIPE- FOR TELEVISION- MUST SPECIFY LOCATION AND TERMINATION POINT
Line6424	Note:
30May16 / 26Sep16	

ELECTRICAL

Inv.525	1 - KITCHEN: INSTALL 220V WALL RECEPTICAL ON DEDICATED CIRCUIT- FOR 4 WIRE BUILT-IN WALL OVEN - FOR FUTURE WALL OVEN/MICROWAVE UNIT. SEE SKETCH. PURCHASER IS AWARE THAT THEY MUST BUY THE APPROPRIATE CABINETRY AT THE TIME OF COLOURS
Line6327	Note:
30May16 / 26Sep16	
Inv.525	1 - KITCHEN: INSTALL 110V WALL RECEPTACLE ON DEDICATED CIRCUIT - FOR MICROWAVE - MICROWAVE NOT INCLUDED. FOR FUTURE WALL OVEN/MICROWAVE UNIT. SEE SKETCH. PURCHASER IS AWARE THAT THEY MUST BUY THE APPROPRIATE CABINETRY AT THE TIME OF COLOURS
Line6328	Note:
30May16 / 26Sep16	
Inv.525	1 - LIVING ROOM: INSTALL ADDITIONAL STANDARD FIXTURE WITH SWITCH, IN LIVING ROOM. IN ADDITION TO BUILDER'S STANDARD SWITCH CONTROLLED RECEPTICAL
Line6329	Note:
30May16 / 26Sep16	
Inv.525	1 - KITCHEN: INSTALL ROUGH - IN WALL OUTLET & SWITCH (WITH COVER PLATE) - DOES NOT INCLUDE FIXTURE - TO GO ABOVE ISLAND. SEE SKETCH
Line6339	Note:
30May16 / 26Sep16	
Inv.525	1 - KITCHEN: INSTALL ROUGH - IN CEILING OUTLET ON SAME SWITCH - DOES NOT INCLUDE FIXTURE - PUT ON SAME SWITCH AS OTHER ROUGH-IN ON KITCHEN ISLAND. SEE SKETCH
Line6340	Note:
30May16 / 26Sep16	
Inv.525	1 - FAMILY ROOM: INSTALL 110V WALL RECEPTACLE ON DEDICATED CIRCUIT - ABOVE FIREPLACE. SEE SKETCH
Line6419	Note:
30May16 / 26Sep16	

EXTERIOR COLOURS

Inv.525	1 - EXTERIOR COLOUR PACKAGE 6
Line11992	Note:
30May16 / 26Sep16	

FORMING

Inv.525	1 - EXTERIOR: INSTALL SIDE DOOR- HOME TO EXTERIOR- AS PER PLAN AND GRADE PERMITTING
Line6331	Note: GRADE DOES NOT PERMIT- TO BE REFUNDED TO HOMEOWNER
30May16 / 26Sep16	

FRAMING

Brampton Encore - 28 - 1 - 38-6 Elev.A SCARLATTI

Inv.525	1 - GARAGE: INSTALL MANDOOR - GARAGE TO HOUSE- AS PER PLAN AND GRADE PERMITING
Line6330	Note: GIVEN IN AGREEMENT OF PURCHASE AND SALE
30May16 / 26Sep16	
Inv.525	1 - LIVING ROOM: INSTALL OPTIONAL COFFERED CEILING - LIVING ROOM (PER ROOM AS PER PLAN). SEE SKETCH
Line6333	Note:
30May16 / 26Sep16	
Inv.525	1 - MANDOOR - GARAGE TO HOUSE- AS PER PLAN AND GRADE PERMITING
Line11994	Note: APS BONUS PACKAGE
30May16 / 26Sep16	

HVAC

Inv.525	1 - KITCHEN: INSTALL GAS LINE ROUGH - MAIN FLOOR - (2 STOREY MODELS) FOR STOVE
Line6335	Note:
30May16 / 26Sep16	

INTERIOR TRIM AND DOORS

Inv.525	4 - MAIN FLOOR: INSTALL FOUR (X4) STANDARD DOORS EXTENDED HEIGHT 96" (PRICE PER DOOR) MAIN FLOOR 3 STOREY MODELS - TO GO ON CLOSETS, POWDER ROOM, LAUNDRY
Line6336	Note:
30May16 / 26Sep16	

MISC.

Inv.525	1 - BONUS PACKAGE: \$9622.00 (INCLUDING TAXES) WORTH OF UPGRADES FROM GOLD PARK HOMES DÉCOR CENTRE IS BEING APPLIED TOWARD THE STRUCTURAL APPOINTMENT. PURCHASER HAS A REMAINING AMOUNT OF \$734.00 (INCLUDING TAXES) TO BE USED TOWARD THE COLOUR APPOINTMENT
Line6344	Note:
30May16 / 26Sep16	
Inv.525	1 - Purchaser has attended a Structural appointment at the Decor Centre & has DECLINED any additional upgrades and accepts and acknowledges that there will be no further structural changes/additions/deletions to be made upon signing on May 30, 2016
Line6342	Note:
30May16 / 26Sep16	
Inv.525	1 - Purchasers are aware & accepts that ANY changes made to upgrades after signing this Purchasers Extra Form are subject to a minimum administration fee of \$500. PLUS a 10% holdback fee
Line6343	Note:
30May16 / 26Sep16	

PLUMBING

Inv.525	1 - KITCHEN: INSTALL ROUGH-IN - WATERLINE FOR FRIDGE
Line6338	Note:
30May16 / 26Sep16	

WINDOWS - BASEMENT

Inv.525	2 - BASEMENT: INSTALL TWO (X2) BASEMENT WINDOWS - UPGRADE EXISTING BASEMENT WINDOW TO 30 INCH X 24 INCH - MAY REQUIRE INSTALLATION OF WINDOW WELL. SEE SKETCH
Line6334	Note: ONE BASEMENT WINDOW TO REMAIN STANDARD
30May16 / 26Sep16	


WINDOWS AND DOORS



CONSTRUCTION SUMMARY


Brampton Encore - 28 - 1 - 38-6 Elev.A SCARLATTI

Inv.525	1 - MAN DOOR GARAGE TO HOUSE - OPTIONAL - IF GRADE PERMITS
Line11993	Note: APS BONUS PACKAGE
30May16 / 26Sep16	

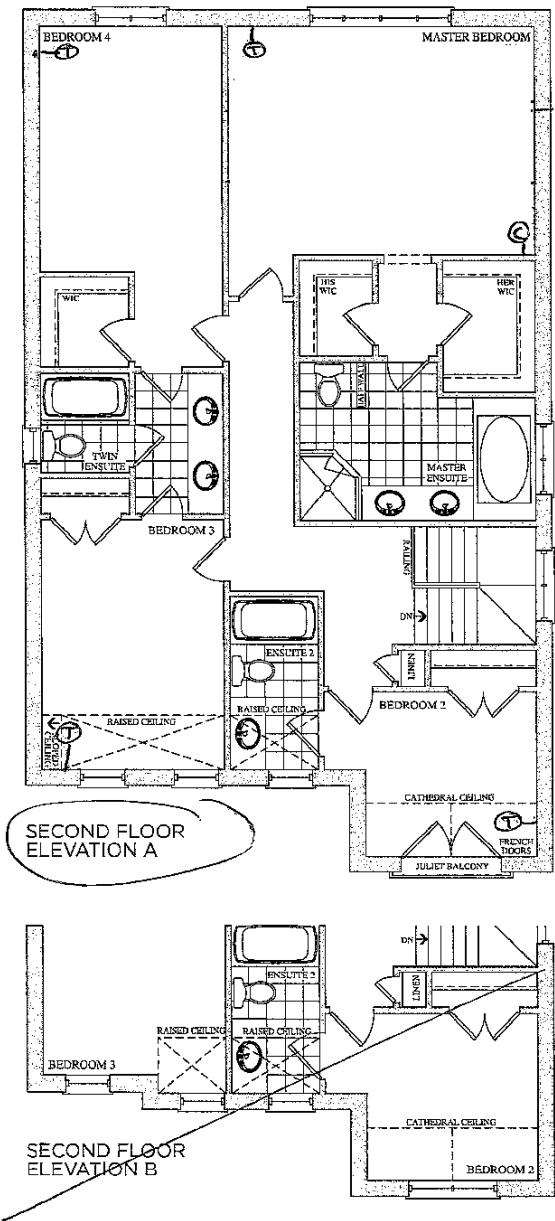

Prices, figures, illustrations, sizes, features and finishes are subject to change without notice. E.&O.E. Areas and dimensions are approximate and actual usable floor space may vary from the stated area. Layout may be reverse of the unit purchased. E. & O.E.


GOLD PARK
HOMES

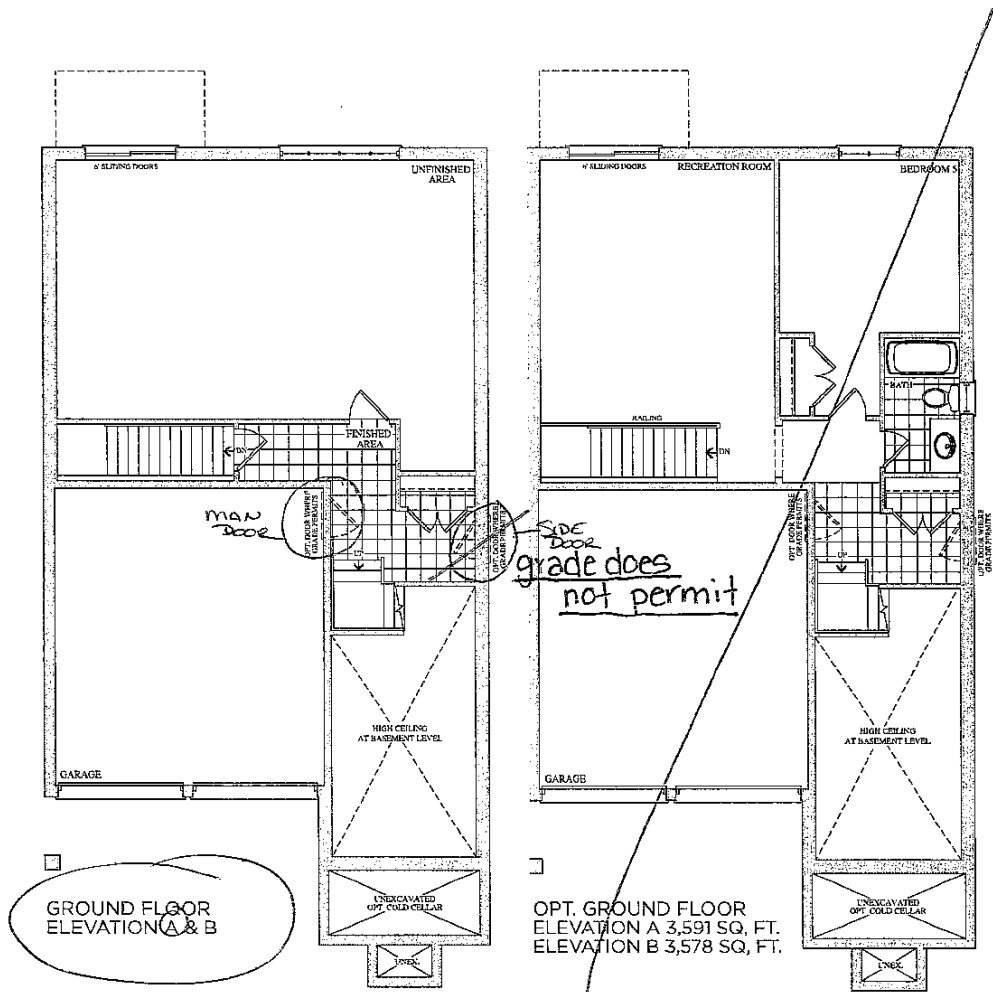

Lot 28
May 30, 116


BSMNT WINDOWS
2x30"x24"

Elevation A • 3,591 sq.ft. | Elevation B • 3,578 sq.ft.

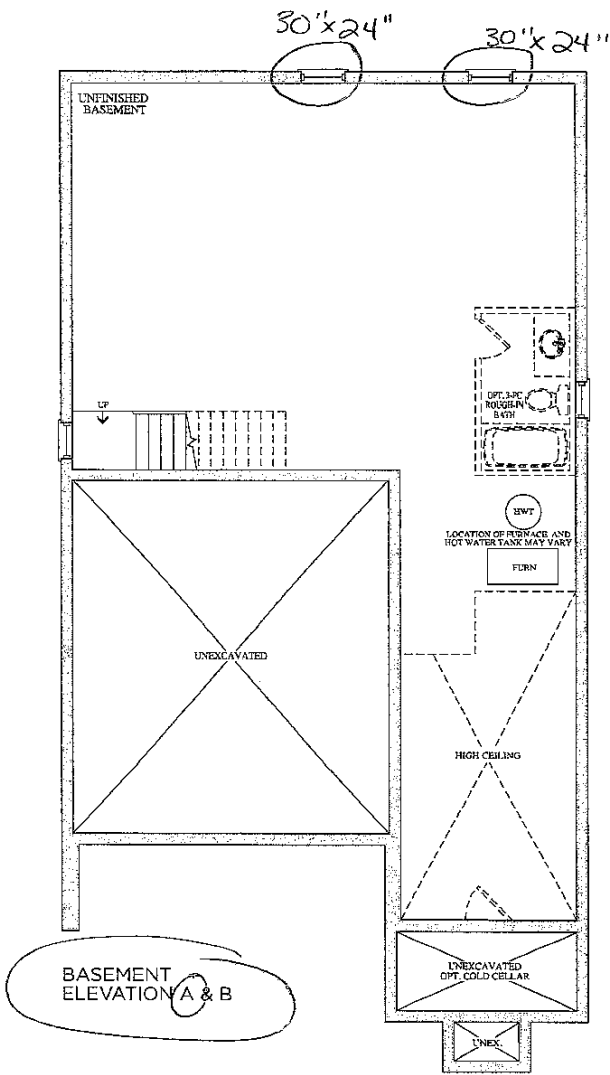

Lot 28
On May 30, 16

A.B. 4.1

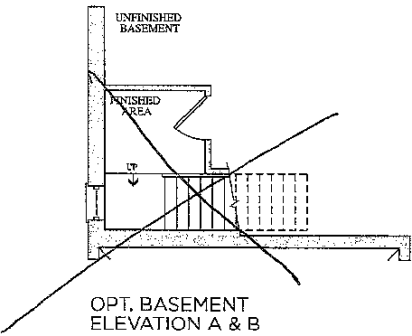

Prices, figures, illustrations, sizes, features and finishes are subject to change without notice. E.&O.E. Areas and dimensions are approximate and actual usable floor space may vary from the stated area. Layout may be reverse of the unit purchased. E. & O.E.



Stacey Carlete
Project Coordinator



Claude Azzopardi
Contracts Manager



Nancy Mc
Corporate C

28
Lot #



Model 38.1 The Bizet			
Elevation	Circle One	A	2189.6 Square Feet
		B	2186.7 Square Feet
Optional Layouts	Circle All that Apply		

Model 38.2 The Ravel			
Elevation	Circle One	A	2271.5 Square Feet
		B	2273.7 Square Feet
Optional Layouts	Circle All that Apply		

Model 38.3 The Haydn			
Elevation	Circle One	A	2394.5 Square Feet
		B	2388.3 Square Feet
Optional Layouts	Circle All that Apply		

Model 38.4 The Vivaldi			
Elevation	Circle One	A	2459.1 Square Feet
		B	2459.1 Square Feet
Optional Layouts	Circle All that Apply		

Model 38.5 The Handel			
Elevation	Circle One	A	2549.2 Square Feet
		B	2554.7 Square Feet
Optional Layouts	Circle All that Apply		

Model 38.9 The Puccini			
Elevation	Circle One	A	3628.0 Square Feet
		B	3634.7 Square Feet
Optional Layouts	Circle All that Apply	GFA1	GROUND FLOOR Optional Alternative Layout

Model 38.6 The Scarlatti			
Elevation	Circle One	A	3521.1 Square Feet
		B	3508.1 Square Feet
Optional Layouts	Circle All that Apply	GFA1	GROUND FLOOR Optional Alternative Layout

Model 38.7 The Schubert			
Elevation	Circle One	A	3593.8 Square Feet
		B	3610.5 Square Feet
Optional Layouts	Circle All that Apply	GFA1	GROUND FLOOR Optional Alternative Layout
		SFA4	SECOND FLOOR Additional Bedroom

Model 38.8 The Corelli			
Elevation	Circle One	A	3801.5 Square Feet
		B	3801.5 Square Feet
Optional Layouts	Circle All that Apply	GFA1	GROUND FLOOR Optional Alternative Layout
		SFA4	SECOND FLOOR Additional Bedroom w/ Ensuite

Model 41.1 The Strauss			
Elevation	Circle One	A	2554.2 Square Feet
		B	2571.2 Square Feet
Optional Layouts	Circle All that Apply	SFA1	SECOND FLOOR Shower in Lieu of Tub B2

Model 41.2 The Mozart			
Elevation	Circle One	A	2725.9 Square Feet
		B	2711.1 Square Feet
Optional Layouts	Circle All that Apply	SFA1	SECOND FLOOR Shower in Lieu of Tub B2

Model 41.3 The Chopin			
Elevation	Circle One	A	2800.0 Square Feet
		B	2810.5 Square Feet
Optional Layouts	Circle All that Apply		

Model 41.4 The Bach			
Elevation	Circle One	A	2894.4 Square Feet
		B	2894.5 Square Feet
Optional Layouts	Circle All that Apply		

Model 41.5 The Brahms			
Elevation	Circle One	A	3948.1 Square Feet
		B	3949.1 Square Feet
Optional Layouts	Circle All that Apply	GFA1	GROUND FLOOR Optional Alternative Layout
		SFA2	SECOND FLOOR Shower in Lieu of Tub B4
		SFA3	SECOND FLOOR Optional Laundry Layout

Model 41.6 The Verdi			
Elevation	Circle One	A	3862.5 Square Feet
		B	3866.4 Square Feet
Optional Layouts	Circle All that Apply	GFA1	GROUND FLOOR Optional Alternative Layout
		SFA3	SECOND FLOOR Optional Laundry Layout

May 30, 2016

