



CONSTRUCTION SUMMARY

Brampton Encore - 77 - 1 - 41-4 Elev.A BACH  
CENTRAL VAC AND WIRING

|                   |                                             |
|-------------------|---------------------------------------------|
| Inv.519           | 1 - TELEPHONE AND CABLE ROUGH-IN LOCATIONS. |
| Line6246          | Note:                                       |
| 26May16 / 26Sep16 |                                             |

EXTERIOR COLOURS

|                   |                               |
|-------------------|-------------------------------|
| Inv.519           | 1 - EXTERIOR COLOUR PACKAGE 6 |
| Line11983         | Note:                         |
| 26May16 / 26Sep16 |                               |

FORMING

|                   |                                                                                     |
|-------------------|-------------------------------------------------------------------------------------|
| Inv.519           | 1 - EXTERIOR; INSTALL SIDE DOOR- HOME TO EXTERIOR- AS PER PLAN AND GRADE PERMITTING |
| Line6251          | Note: YES, GRADING PERMITS PER SITING DATED AUGUST 2, 2016                          |
| 26May16 / 26Sep16 |                                                                                     |

FRAMING

|                                                                        |                                                                                 |
|------------------------------------------------------------------------|---------------------------------------------------------------------------------|
| Inv.519                                                                | 1 - GARAGE: INSTALL MANDOOR - GARAGE TO HOUSE- AS PER PLAN AND GRADE PERMITTING |
| Line6248                                                               | Note: GIVEN, AS PER AGREEMENT OF PURCHASE AND SALE                              |
| 26May16 / 26Sep16 YES, GRADING PERMITS PER SITING DATED AUGUST 2, 2016 |                                                                                 |

INTERIOR TRIM AND DOORS


|                   |                                                                                                                                                                                 |
|-------------------|---------------------------------------------------------------------------------------------------------------------------------------------------------------------------------|
| Inv.519           | 6 - MAIN FLOOR: INSTALL SIX (X6) STANDARD DOORS EXTENDED HEIGHT 96" (PRICE PER DOOR)- GROUND FLOOR 2 STOREY MODELS. TO GO ON CLOSETS, POWDER ROOM, DEN AND BASEMENT. SEE SKETCH |
| Line6252          | Note:                                                                                                                                                                           |
| 26May16 / 26Sep16 |                                                                                                                                                                                 |

MISC.

|                   |                                                                                                                                                                                                                                                                 |
|-------------------|-----------------------------------------------------------------------------------------------------------------------------------------------------------------------------------------------------------------------------------------------------------------|
| Inv.519           | 1 - BONUS PACKAGE: \$5904.25 (INCLUDING TAXES) WORTH OF UPGRADES FROM GOLD PARK HOMES DÉCOR CENTRE IS BEING APPLIED TOWARD THE STRUCTURAL APPOINTMENT. PURCHASER HAS A REMAINING AMOUNT OF \$4095.75 (INCLUDING TAXES) TO BE USED TOWARD THE COLOUR APPOINTMENT |
| Line6253          | Note:                                                                                                                                                                                                                                                           |
| 26May16 / 26Sep16 |                                                                                                                                                                                                                                                                 |
| Inv.519           | 1 - Purchaser has attended a Structural appointment at the Decor Centre & has DECLINED any additional upgrades and accepts and acknowledges that there will be no further structural changes/additions/deletions to be made upon signing on May 26, 2016        |
| Line6254          | Note:                                                                                                                                                                                                                                                           |
| 26May16 / 26Sep16 |                                                                                                                                                                                                                                                                 |
| Inv.519           | 1 - Purchasers are aware & accepts that ANY changes made to upgrades after signing this Purchasers Extra Form are subject to a minimum administration fee of \$500. PLUS a 10% holdback fee.                                                                    |
| Line6255          | Note:                                                                                                                                                                                                                                                           |
| 26May16 / 26Sep16 |                                                                                                                                                                                                                                                                 |


PLUMBING

|                   |                                                                     |
|-------------------|---------------------------------------------------------------------|
| Inv.519           | 1 - BASEMENT: INSTALL ROUGH-IN - 3PC BASEMENT ROUGH-IN, AS PER PLAN |
| Line6250          | Note:                                                               |
| 26May16 / 26Sep16 |                                                                     |

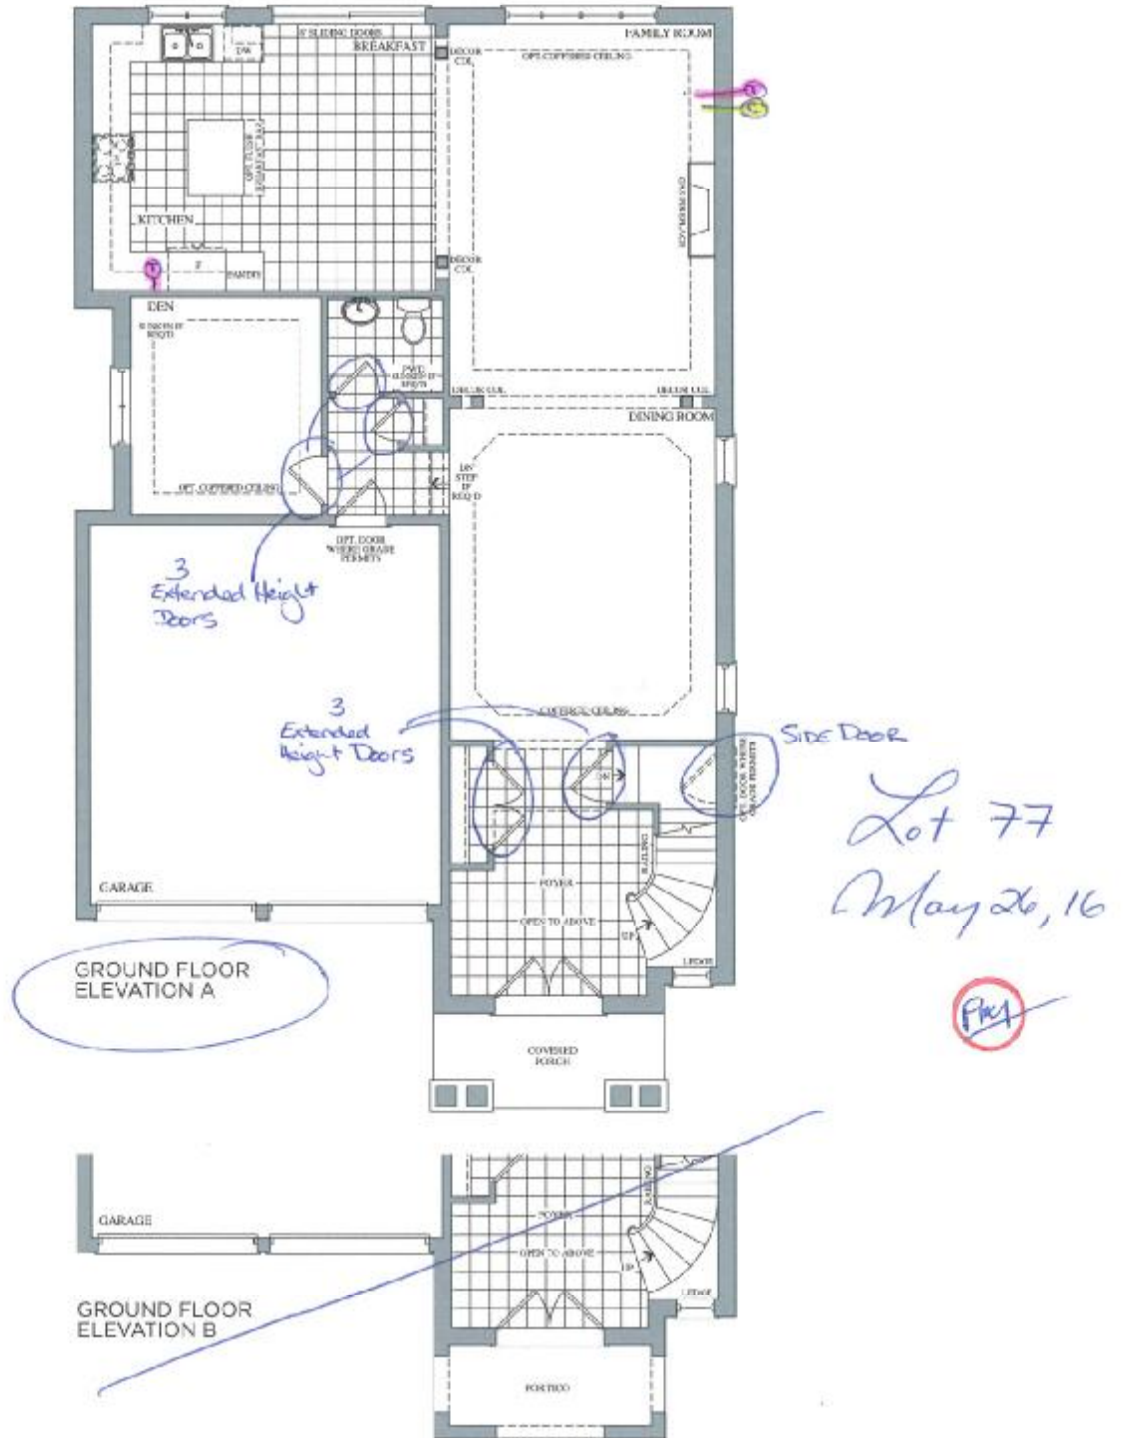


The  
Bach  
41' SERIES

Elevation A • 3,046 sq.ft. | Elevation B • 3,046 sq.ft.

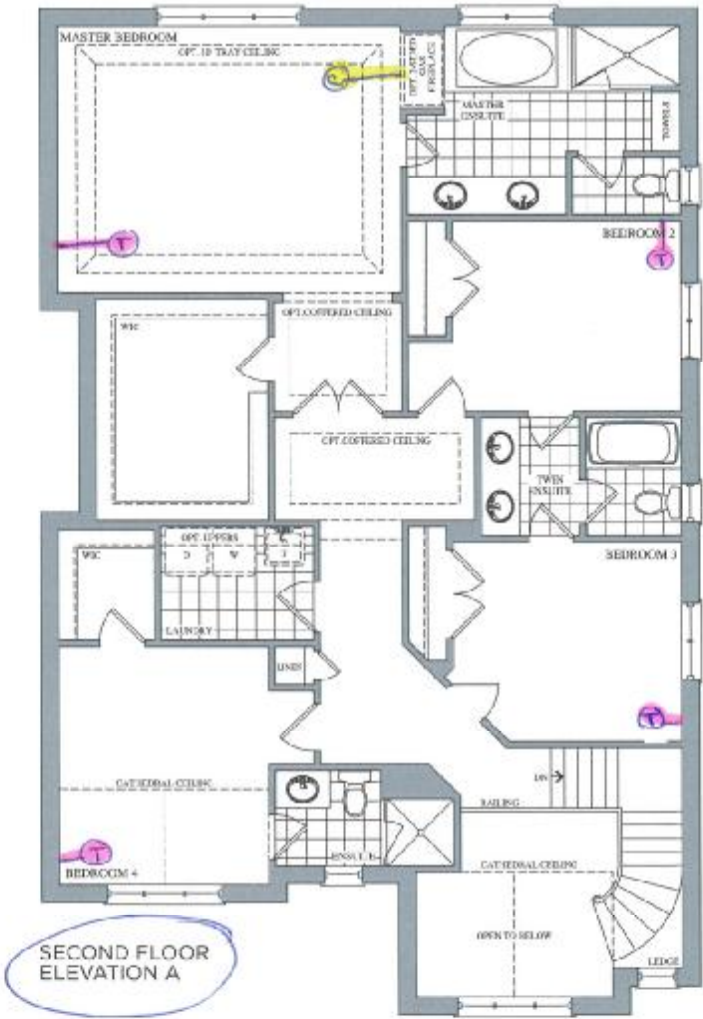


Lot 77  
May 26, 16

*Pr*

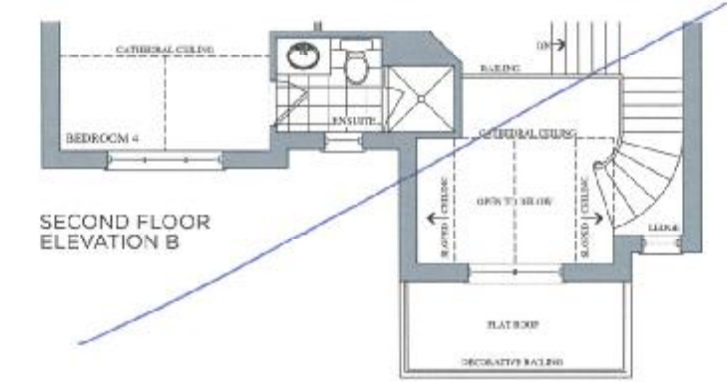

Prices, figures, illustrations, sizes, features and finishes are subject to change without notice. E&O.E. Areas and dimensions are approximate and actual usable floor space may vary from the stated area. Layout may be reverse of the unit purchased. E. & O.E.

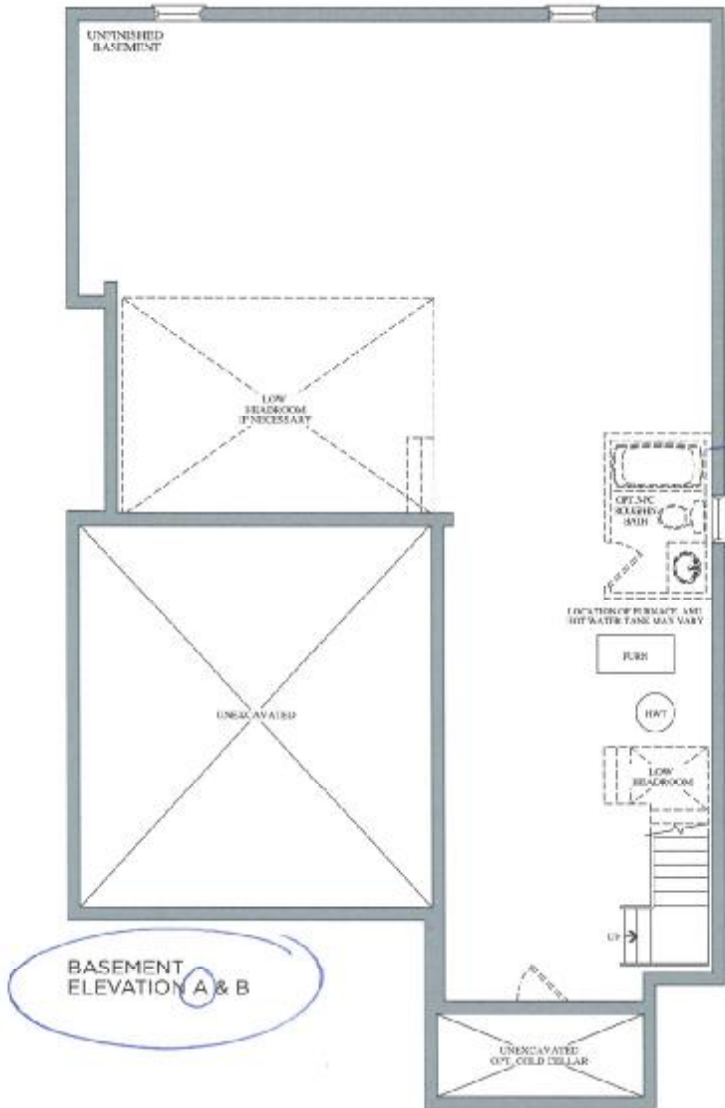

3 piece  
R/T  
Lot 77  
May 26, 16



Stacey Carlete  
Project Coordinator



Claude Azzopardi  
Contracts Manager



Nancy Mc  
Corporate C

77  
Lot #



| 38.1 The Bizet   |                       |   |                    |
|------------------|-----------------------|---|--------------------|
| Elevation        | Circle One            | A | 2189.6 Square Feet |
|                  |                       | B | 2186.7 Square Feet |
| Optional Layouts | Circle All that Apply |   |                    |
|                  |                       |   |                    |

| 38.2 The Ravel   |                       |   |                    |
|------------------|-----------------------|---|--------------------|
| Elevation        | Circle One            | A | 2271.5 Square Feet |
|                  |                       | B | 2273.7 Square Feet |
| Optional Layouts | Circle All that Apply |   |                    |
|                  |                       |   |                    |

| 38.3 The Haydn   |                       |   |                    |
|------------------|-----------------------|---|--------------------|
| Elevation        | Circle One            | A | 2394.5 Square Feet |
|                  |                       | B | 2388.3 Square Feet |
| Optional Layouts | Circle All that Apply |   |                    |
|                  |                       |   |                    |

| 38.4 The Vivaldi |                       |   |                    |
|------------------|-----------------------|---|--------------------|
| Elevation        | Circle One            | A | 2459.1 Square Feet |
|                  |                       | B | 2459.1 Square Feet |
| Optional Layouts | Circle All that Apply |   |                    |
|                  |                       |   |                    |

| 38.5 The Handel  |                       |   |                    |
|------------------|-----------------------|---|--------------------|
| Elevation        | Circle One            | A | 2549.2 Square Feet |
|                  |                       | B | 2554.7 Square Feet |
| Optional Layouts | Circle All that Apply |   |                    |
|                  |                       |   |                    |

| 38.9 The Puccini |                       |      |                                          |
|------------------|-----------------------|------|------------------------------------------|
| Elevation        | Circle One            | A    | 3628.0 Square Feet                       |
|                  |                       | B    | 3634.7 Square Feet                       |
| Optional Layouts | Circle All that Apply | GFA1 | GROUND FLOOR Optional Alternative Layout |
|                  |                       |      |                                          |

| 38.6 The Scarlatti |                       |      |                                          |
|--------------------|-----------------------|------|------------------------------------------|
| Elevation          | Circle One            | A    | 3571.1 Square Feet                       |
|                    |                       | B    | 3508.1 Square Feet                       |
| Optional Layouts   | Circle All that Apply | GFA1 | GROUND FLOOR Optional Alternative Layout |
|                    |                       |      |                                          |

| 38.7 The Schubert |                       |      |                                          |
|-------------------|-----------------------|------|------------------------------------------|
| Elevation         | Circle One            | A    | 3553.8 Square Feet                       |
|                   |                       | B    | 3630.5 Square Feet                       |
| Optional Layouts  | Circle All that Apply | GFA1 | GROUND FLOOR Optional Alternative Layout |
|                   |                       | SFA4 | SECOND FLOOR Additional Bedroom          |

| 38.8 The Corelli |                       |      |                                            |
|------------------|-----------------------|------|--------------------------------------------|
| Elevation        | Circle One            | A    | 3801.5 Square Feet                         |
|                  |                       | B    | 3801.5 Square Feet                         |
| Optional Layouts | Circle All that Apply | GFA1 | GROUND FLOOR Optional Alternative Layout   |
|                  |                       | SFA4 | SECOND FLOOR Additional Bedroom w/ Ensuite |

| 41.1 The Strauss |                       |      |                                       |
|------------------|-----------------------|------|---------------------------------------|
| Elevation        | Circle One            | A    | 2554.2 Square Feet                    |
|                  |                       | B    | 2571.2 Square Feet                    |
| Optional Layouts | Circle All that Apply | SFA1 | SECOND FLOOR Shower in Lieu of Tub B2 |
|                  |                       |      |                                       |

| 41.2 The Mozart  |                       |      |                                       |
|------------------|-----------------------|------|---------------------------------------|
| Elevation        | Circle One            | A    | 2725.9 Square Feet                    |
|                  |                       | B    | 2711.1 Square Feet                    |
| Optional Layouts | Circle All that Apply | SFA1 | SECOND FLOOR Shower in Lieu of Tub B2 |
|                  |                       |      |                                       |

| 41.3 The Chopin  |                       |   |                    |
|------------------|-----------------------|---|--------------------|
| Elevation        | Circle One            | A | 2800.0 Square Feet |
|                  |                       | B | 2810.5 Square Feet |
| Optional Layouts | Circle All that Apply |   |                    |
|                  |                       |   |                    |

| 41.4 The Bach    |                       |   |                    |
|------------------|-----------------------|---|--------------------|
| Elevation        | Circle One            | A | 2894.4 Square Feet |
|                  |                       | B | 2894.5 Square Feet |
| Optional Layouts | Circle All that Apply |   |                    |
|                  |                       |   |                    |

| 41.5 The Brahms  |                       |      |                                          |
|------------------|-----------------------|------|------------------------------------------|
| Elevation        | Circle One            | A    | 3948.1 Square Feet                       |
|                  |                       | B    | 3949.1 Square Feet                       |
| Optional Layouts | Circle All that Apply | GFA1 | GROUND FLOOR Optional Alternative Layout |
|                  |                       | SFA2 | SECOND FLOOR Shower in Lieu of Tub B4    |
|                  |                       | SFA3 | SECOND FLOOR Optional Laundry Layout     |
|                  |                       |      |                                          |

| 41.6 The Verdi   |                       |      |                                          |
|------------------|-----------------------|------|------------------------------------------|
| Elevation        | Circle One            | A    | 3862.5 Square Feet                       |
|                  |                       | B    | 3866.4 Square Feet                       |
| Optional Layouts | Circle All that Apply | GFA1 | GROUND FLOOR Optional Alternative Layout |
|                  |                       | SFA3 | SECOND FLOOR Optional Laundry Layout     |

May 26, 16

