

CONSTRUCTION SUMMARY

117 - 1 - 38-4 Elev.A VIVALDI

CENTRAL VAC AND WIRING

Inv.654	1 - TELEPHONE AND CABLE ROUGH-IN LOCATIONS
Line8297	Note:
12Jul16 / 26Sep16	

ELECTRICAL

Inv.654	1 - KITCHEN: INSTALL 110V WALL RECEPTACLE ON DEDICATED CIRCUIT - FOR MICROWAVE - MICROWAVE NOT INCLUDED. SEE SKETCH
Line8298	Note:
12Jul16 / 26Sep16	

EXTERIOR COLOURS

Inv.654	1 - EXTERIOR COLOUR PACKAGE 5
Line11987	Note:
12Jul16 / 26Sep16	

FORMING

Inv.654	1 - EXTERIOR: INSTALL SIDE DOOR- HOME TO EXTERIOR- AS PER PLAN AND GRADE PERMITTING
Line8300	Note: GRADING PERMITS PER SITING DATED AUGUST 2, 2016
12Jul16 / 26Sep16	

FRAMING

Inv.654	1 - GARAGE: INSTALL MANDOOR - GARAGE TO HOUSE- AS PER PLAN AND GRADE PERMITTING
Line8299	Note: GIVEN IN AGREEMENT OF PURCHASE AND SALE
12Jul16 / 26Sep16 GRADING PERMITS PER SITING DATED AUGUST 2, 2016	
Inv.729	1 - MAIN FLOOR: UPGRADE MAIN FLOOR CEILING TO 10FT INCLUDES TALLER FRONT DOOR W/EXTRA TRANSOMS; 8' INT.DOORS & COORD. CASINGS, EXTRA TALL FLAT ARCHES; TALLER FRONT AND REAR WINDOWS, CROWN AND FURRING PANEL OVER EXT. CABINETS, ADDED STAIRS/PICKETS/RAILINGS
Line9855	Note:
9Aug16 / 26Sep16	

INTERIOR TRIM AND DOORS

Inv.729	1 - MAIN FLOOR: UPGRADE MAIN FLOOR CEILING TO 10FT INCLUDES TALLER FRONT DOOR W/EXTRA TRANSOMS; 8' INT.DOORS & COORD. CASINGS, EXTRA TALL FLAT ARCHES; TALLER FRONT AND REAR WINDOWS, CROWN AND FURRING PANEL OVER EXT. CABINETS, ADDED STAIRS/PICKETS/RAILINGS
Line11989	Note:
9Aug16 / 26Sep16	

KITCHEN AND BATH CABINETRY

Inv.729	1 - MAIN FLOOR: UPGRADE MAIN FLOOR CEILING TO 10FT INCLUDES TALLER FRONT DOOR W/EXTRA TRANSOMS; 8' INT.DOORS & COORD. CASINGS, EXTRA TALL FLAT ARCHES; TALLER FRONT AND REAR WINDOWS, CROWN AND FURRING PANEL OVER EXT. CABINETS, ADDED STAIRS/PICKETS/RAILINGS
Line11990	Note:
9Aug16 / 26Sep16	

MISC.

CONSTRUCTION SUMMARY

117 - 1 - 38-4 Elev.A VIVALDI

Inv.654	1 - BONUS PACKAGE: \$2457.75 (INCLUDING TAXES) WORTH OF UPGRADES FROM GOLD PARK HOMES DÉCOR CENTRE IS BEING APPLIED TOWARD THE STRUCTURAL APPOINTMENT. PURCHASER HAS A REMAINING AMOUNT OF \$7542.25 (INCLUDING TAXES) TO BE USED TOWARD THE COLOUR APPOINTMENT
Line8324	Note:
12Jul16 / 26Sep16	
Inv.654	1 - Purchaser has attended a Structural appointment at the Decor Centre & has DECLINED any additional upgrades and accepts and acknowledges that there will be no further structural changes/additions/deletions to be made upon signing on July 12, 2016.
Line8325	Note:
12Jul16 / 26Sep16	
Inv.654	1 - Purchasers are aware & accepts that ANY changes made to upgrades after signing this Purchasers Extra Form are subject to a minimum administration fee of \$500. PLUS a 10% holdback fee.
Line8326	Note:
12Jul16 / 26Sep16	
Inv.729	1 - BONUS PACKAGE: \$7542.25 (INCLUDING TAXES) WORTH OF UPGRADES FROM GOLD PARK HOMES DÉCOR CENTRE IS BEING APPLIED TOWARD THE STRUCTURAL APPOINTMENT. PURCHASER HAS A REMAINING AMOUNT OF \$00 (INCLUDING TAXES) TO BE USED TOWARD THE COLOUR APPOINTMENT
Line9856	Note:
9Aug16 / 26Sep16	
Inv.729	1 - Purchasers are aware & accepts that ANY changes made to upgrades after signing this Purchasers Extra Form are subject to a minimum administration fee of \$500. PLUS a 10% holdback fee
Line9857	Note:
9Aug16 / 26Sep16	
Inv.729	1 - ADMINISTRATION FEE TO RE-OPEN FILE
Line9858	Note:
9Aug16 / 26Sep16	

STAIRS AND RAILINGS

Inv.729	1 - MAIN FLOOR: UPGRADE MAIN FLOOR CEILING TO 10FT INCLUDES TALLER FRONT DOOR W/EXTRA TRANSOMS; 8' INT.DOORS & COORD. CASINGS, EXTRA TALL FLAT ARCHES; TALLER FRONT AND REAR WINDOWS, CROWN AND FURRING PANEL OVER EXT. CABINETS, ADDED STAIRS/PICKETS/RAILINGS
Line11991	Note:
9Aug16 / 26Sep16	

WINDOWS AND DOORS

Inv.729	1 - MAIN FLOOR: UPGRADE MAIN FLOOR CEILING TO 10FT INCLUDES TALLER FRONT DOOR W/EXTRA TRANSOMS; 8' INT.DOORS & COORD. CASINGS, EXTRA TALL FLAT ARCHES; TALLER FRONT AND REAR WINDOWS, CROWN AND FURRING PANEL OVER EXT. CABINETS, ADDED STAIRS/PICKETS/RAILINGS
Line11988	Note:
9Aug16 / 26Sep16	

The
Vivaldi
38' SERIES

Elevation A • 2,518 sq.ft. | Elevation B • 2,518 sq.ft.

Taller
Ceilings 10'



SIDE DOOR

Lot 117
July 12, 16

T-8




Prices, figures, illustrations, sizes, features and finishes are subject to change without notice. L&D.L. Areas and dimensions are approximate and actual visible floor space may vary from the stated area. Layout may be revised at the time of purchase. S.A.O.C.

GOLDPARK
TOMES

encore
BRAMPTON

The
Vivaldi
38' SERIES

Elevation A • 2,518 sq.ft. | Elevation B • 2,518 sq.ft.

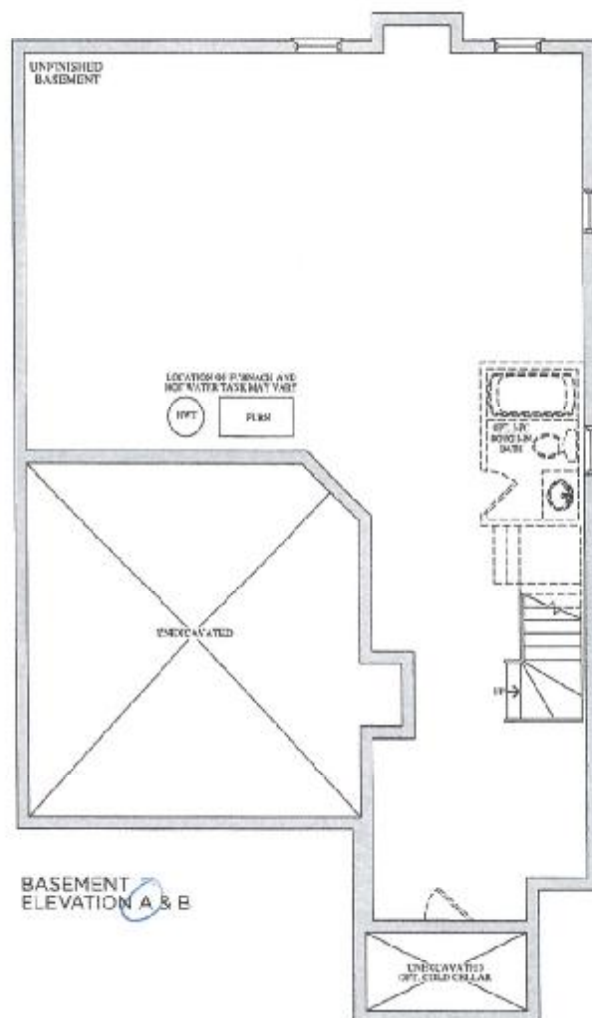

Lot 117
July 12, 16
~~118~~

Prices, figures, illustrations, sizes, features and finishes are subject to change without notice. L.S.O.E. Areas and dimensions are approximate and actual usable floor space may vary from the stated area. Layout may be reverse of the one purchased. C. & O.E.

GOLDPARK
HOMES



Stacey Coriote
Project Coordinator



Claude Azzopardi
Contracts Manager



Nancy Mc
Corporate C

117
Lot #



38.1 The Bizet			
Elevation	Circle One	A	2189.6 Square Feet
		B	2186.7 Square Feet
Optional Layouts	Circle All that Apply		

38.2 The Ravel			
Elevation	Circle One	A	2271.5 Square Feet
		B	2273.7 Square Feet
Optional Layouts	Circle All that Apply		

38.3 The Haydn			
Elevation	Circle One	A	2394.5 Square Feet
		B	2388.3 Square Feet
Optional Layouts	Circle All that Apply		

38.4 The Vivaldi			
Elevation	Circle One	A	2459.1 Square Feet
		B	2459.1 Square Feet
Optional Layouts	Circle All that Apply		

38.5 The Handel			
Elevation	Circle One	A	2549.2 Square Feet
		B	2554.7 Square Feet
Optional Layouts	Circle All that Apply		

38.9 The Puccini			
Elevation	Circle One	A	3528.0 Square Feet
		B	3634.7 Square Feet
Optional Layouts	Circle All that Apply	GFA1	GROUND FLOOR Optional Alternative Layout

38.6 The Scarlatti			
Elevation	Circle One	A	3521.1 Square Feet
		B	3508.1 Square Feet
Optional Layouts	Circle All that Apply	GFA1	GROUND FLOOR Optional Alternative Layout

38.7 The Schubert			
Elevation	Circle One	A	3593.8 Square Feet
		B	3610.5 Square Feet
Optional Layouts	Circle All that Apply	GFA1	GROUND FLOOR Optional Alternative Layout
		SFA4	SECOND FLOOR Additional Bedroom

38.8 The Corelli			
Elevation	Circle One	A	3803.5 Square Feet
		B	3801.5 Square Feet
Optional Layouts	Circle All that Apply	GFA1	GROUND FLOOR Optional Alternative Layout
		SFA4	SECOND FLOOR Additional Bedroom w/ Ensuite

41.1 The Strauss			
Elevation	Circle One	A	2554.2 Square Feet
		B	2571.2 Square Feet
Optional Layouts	Circle All that Apply	SFA1	SECOND FLOOR Shower in Lieu of Tub B2

41.2 The Mozart			
Elevation	Circle One	A	2725.9 Square Feet
		B	2711.1 Square Feet
Optional Layouts	Circle All that Apply	SFA1	SECOND FLOOR Shower in Lieu of Tub B2

41.3 The Chopin			
Elevation	Circle One	A	2803.0 Square Feet
		B	2810.5 Square Feet
Optional Layouts	Circle All that Apply		

41.4 The Bach			
Elevation	Circle One	A	2894.4 Square Feet
		B	2894.5 Square Feet
Optional Layouts	Circle All that Apply		

41.5 The Brahms			
Elevation	Circle One	A	3948.1 Square Feet
		B	3949.1 Square Feet
Optional Layouts	Circle All that Apply	GFA1	GROUND FLOOR Optional Alternative Layout
		SFA2	SECOND FLOOR Shower in Lieu of Tub B4
		SFA3	SECOND FLOOR Optional Laundry Layout

41.6 The Verdi			
Elevation	Circle One	A	3862.5 Square Feet
		B	3866.4 Square Feet
Optional Layouts	Circle All that Apply	GFA1	GROUND FLOOR Optional Alternative Layout
		SFA3	SECOND FLOOR Optional Laundry Layout

July 12, 16
T.S.