



CONSTRUCTION SUMMARY

Brampton Encore - 38 - 1 - 38-6 Elev.A SCARLATTI OPT- GFA1
CENTRAL VAC AND WIRING

Inv.502	1 - GARAGE-MAN DOOR: INSTALL ROUGH-IN FOR EXTRA SECURITY KEY PAD AT GARAGE MAN DOOR
Line6085	Note:
17May16 / 27Jul16	
Inv.502	1 - FAMILY ROOM: INSTALL CONDUIT PIPE- FOR TELEVISION- MUST SPECIFY LOCATION AND TERMINATION POINT
Line6087	Note:
17May16 / 27Jul16	
Inv.502	1 - BEDROOM #3: INSTALL RG 6 ROUGH-IN IN BED #3, SEE SKETCH
Line6089	Note:
17May16 / 27Jul16	
Inv.502	1 - GROUND FLOOR- REC ROOM: INSTALL RG 6 ROUGH-IN IN REC ROOM, SEE SKETCH
Line6090	Note:
17May16 / 27Jul16	

ELECTRICAL

Inv.502	1 - TELEPHONE AND CABLE ROUGH-IN LOCATIONS
Line6084	Note:
17May16 / 27Jul16	
Inv.502	1 - FAMILY ROOM: INSTALL 110V WALL RECEPTACLE ON DEDICATED CIRCUIT - ABOVE FIREPLACE SEE SKETCH
Line6088	Note:
17May16 / 27Jul16	
Inv.502	1 - KITCHEN: INSTALL 220V WALL RECEPTICAL ON DEDICATED CIRCUIT - FOR 4 WIRE BUILT-IN WALL OVEN - FOR FUTURE MICRO/WALL OVEN UNIT. PURCHASER IS AWARE THAT THEY MUST BUY THE APPROPRIATE CABINETRY AT THE TIME OF COLOURS. SEE SKETCH
Line6091	Note:
17May16 / 27Jul16	
Inv.502	1 - KITCHEN: INSTALL 110V WALL RECEPTACLE ON DEDICATED CIRCUIT - FOR MICROWAVE - MICROWAVE NOT INCLUDED. FOR FUTURE MICRO/WALL OVEN UNIT. PURCHASER IS AWARE THAT THEY MUST BUY THE APPROPRIATE CABINETRY AT THE TIME OF COLOURS. SEE SKETCH
Line6092	Note:
17May16 / 27Jul16	
Inv.502	1 - LIVING ROOM: INSTALL ADDITIONAL STANDARD FIXTURE WITH SWITCH - IN ADDITION TO BUILDER'S STANDARD SWITCH CONTROLLED RECEPTICAL. SEE SKETCH.
Line6094	Note:
17May16 / 27Jul16	

EXTERIOR COLOURS

Inv.502	1 - EXTERIOR COLOUR PACKAGE 6 /
Line9396	Note:
17May16 / 27Jul16	

FRAMING

Inv.502	1 - FAMILY ROOM: INSTALL OPTIONAL COFFERED CEILING - FAMILY ROOM (PER ROOM AS PER PLAN)
Line6096	Note:
17May16 / 27Jul16	

Brampton Encore - 38 - 1 - 38-6 Elev.A SCARLATTI OPT- GFA1

Inv.502	1 - SECOND FLOOR: INSTALL SMOOTH CEILINGS - (3-Story Design) 2ND FLOOR
Line6095	Note:
17May16 / 27Jul16	

INTERIOR TRIM AND DOORS

Inv.502	4 - MAIN FLOOR: INSTALL FOUR (X4) STANDARD DOORS EXTENDED HEIGHT 96" (PRICE PER DOOR) MAIN FLOOR 3 STOREY MODELS - TO GO IN CLOSETS, POWDER ROOM AND LAUNDRY ROOM. SEE SKETCH
Line6098	Note:
17May16 / 27Jul16	

MISC.

Inv.502	1 - BONUS PACKAGE: \$10,153.05 (INCLUDING TAXES) WORTH OF UPGRADES FROM GOLD PARK HOMES DÉCOR CENTRE IS BEING APPLIED TOWARD THE STRUCTURAL APPOINTMENT. PURCHASER HAS A REMAINING AMOUNT OF \$4846.95 (INCLUDING TAXES) TO BE USED TOWARD THE COLOUR APPOINTMENT
Line6100	Note:
17May16 / 27Jul16	
Inv.502	1 - Purchasers are aware & accepts that ANY changes made to upgrades after signing this Purchasers Extra Form are subject to a minimum administration fee of \$500. PLUS a 10% holdback fee
Line6102	Note:
17May16 / 27Jul16	
Inv.502	1 - Purchaser has attended a Structural appointment at the Decor Centre & has DECLINED any additional upgrades and accepts and acknowledges that there will be no further structural changes/additions/deletions to be made upon signing on May 17, 2016
Line6101	Note:
17May16 / 27Jul16	

PLUMBING

Inv.502	1 - ROUGH-IN - WATERLINE FOR FIRDGE
Line6099	Note:
17May16 / 27Jul16	

WINDOWS - BASEMENT

Inv.502	2 - BASEMENT: INSTALL TWO (X2) BASEMENT WINDOWS - UPGRADE EXISTING BASEMENT WINDOW TO 30 INCH X 24 INCH - MAY REQUIRE INSTALLATION OF WINDOW WELL
Line6097	Note:
17May16 / 27Jul16	



WINDOWS AND DOORS

Inv.502	1 - MAN DOOR GARAGE TO HOUSE - OPTIONAL - IF GRADE PERMITS
Line9394	Note: AS PER AGREEMENT OF PURCHASE AND SALE BONUS PACKAGE
17May16 / 27Jul16	

Telephone — (T)
Cable — (C)
Electrical — (E)

The
Scarlatti
38' SERIES

Elevation A • 3,591 sq.ft. | Elevation B • 3,578 sq.ft.

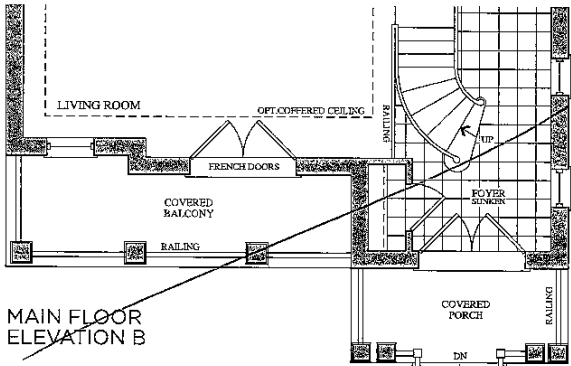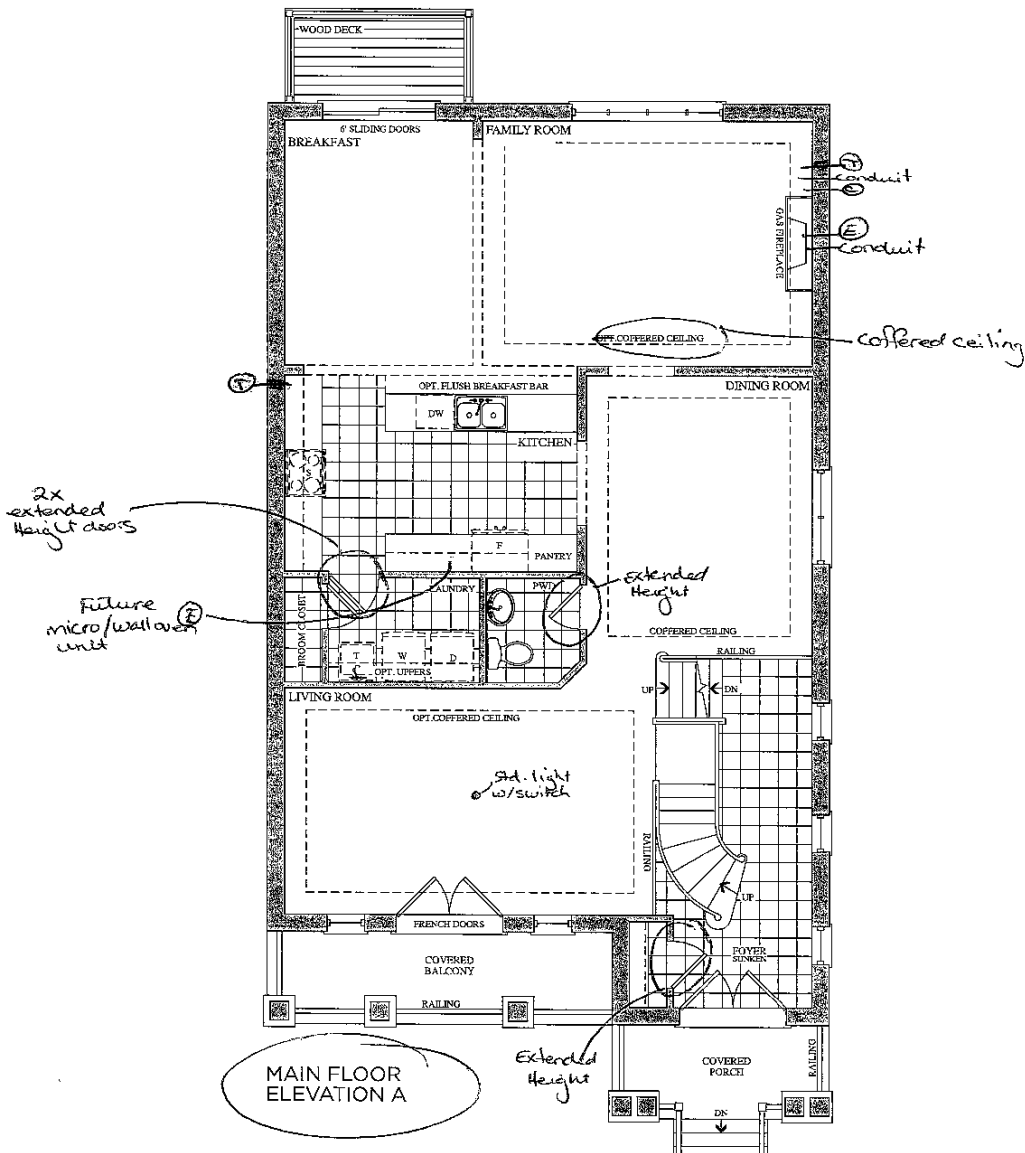

Lot 38
May 17, 16

(2)

(Bsp)



Prices, figures, illustrations, sizes, features and finishes are subject to change without notice. E.&O.E. Areas and dimensions are approximate and actual usable floor space may vary from the stated area. Layout may be reverse of the unit purchased. E. & O.E.

Handwritten signature.

Telephone — (T)
Cable — (C)
Electrical — (E)

The
Scarlatti
38' SERIES

Elevation A • 3,591 sq.ft. | Elevation B • 3,578 sq.ft.

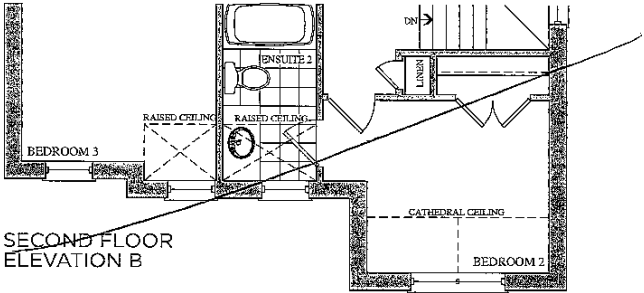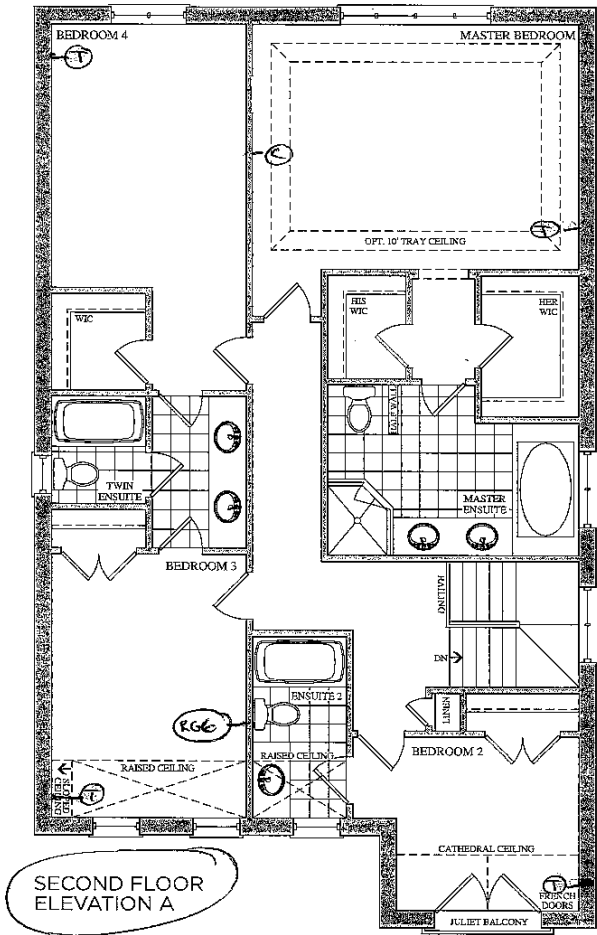


Prices, figures, illustrations, sizes, features and finishes are subject to change without notice. E.&O.E. Areas and dimensions are approximate and actual usable floor space may vary from the stated area. Layout may be reverse of the unit purchased. E. & O.E.

GOLDPARK
HOMES

Lot 38
May 17, 2016


(F)

(RP)

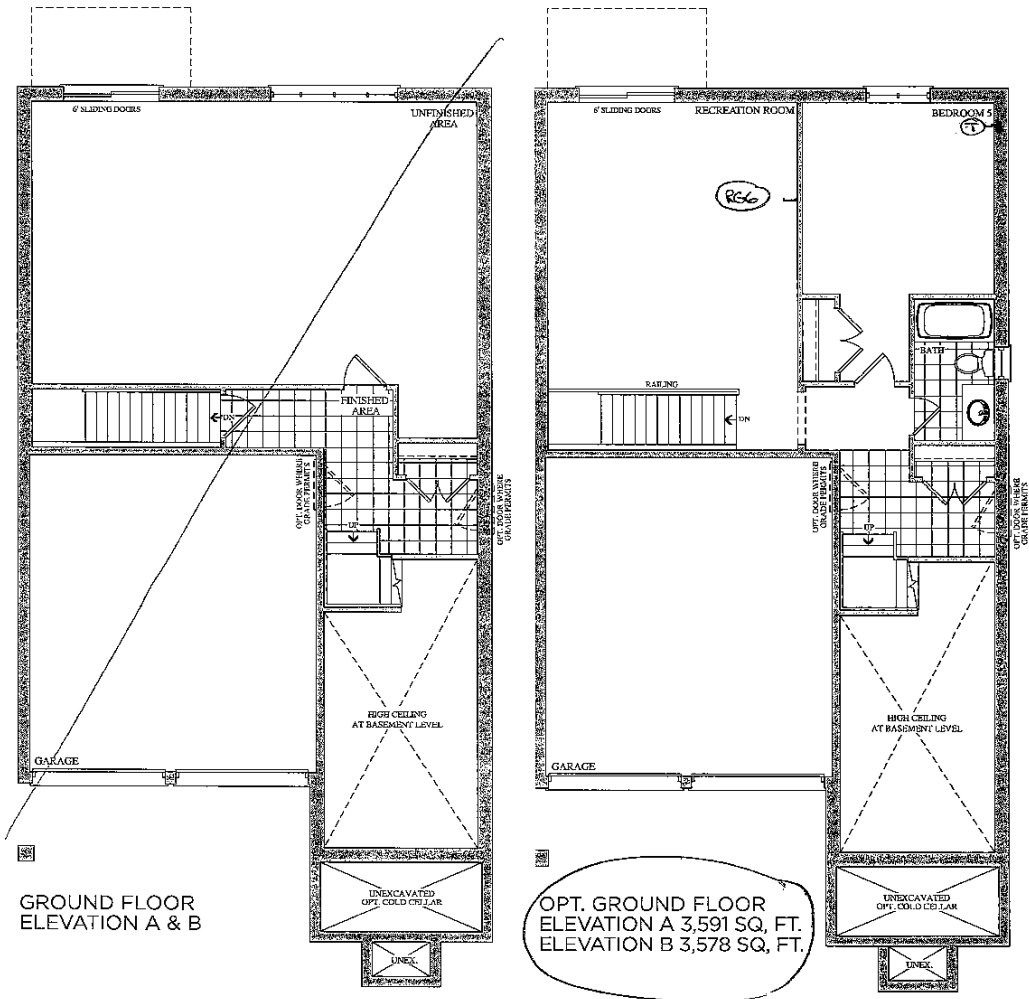


Lot 38
May 17, 16
② ⑧P

BSMWT WINDOWS
2x 30"x24"

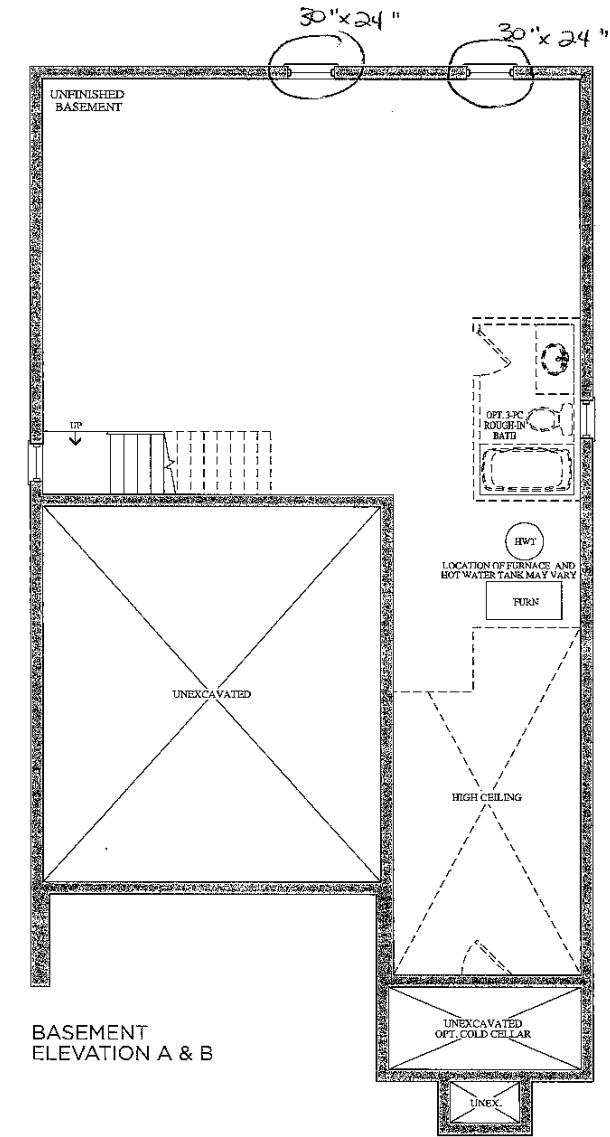

BASEMENT
ELEVATION A & B

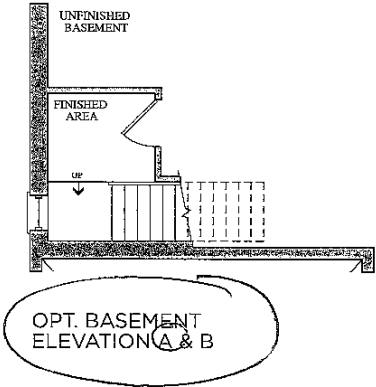

Lot 38
May 17, 2016
S DSP

2



Stacey Carlete
Project Coordinator



Claude Azzopardi
Contracts Manager



Nancy Ma
Corporate C

38
Lot #



encore
BRANTON

38.1 The Bizet			
Elevation	Circle One	A	2189.6 Square Feet
		B	2186.7 Square Feet
Optional Layouts	Circle All that Apply		

38.2 The Ravel			
Elevation	Circle One	A	2271.5 Square Feet
		B	2273.7 Square Feet
Optional Layouts	Circle All that Apply		

38.3 The Haydn			
Elevation	Circle One	A	2394.5 Square Feet
		B	2388.3 Square Feet
Optional Layouts	Circle All that Apply		

38.4 The Vivaldi			
Elevation	Circle One	A	2459.1 Square Feet
		B	2459.1 Square Feet
Optional Layouts	Circle All that Apply		

38.5 The Handel			
Elevation	Circle One	A	2549.2 Square Feet
		B	2554.7 Square Feet
Optional Layouts	Circle All that Apply		

38.9 The Puccini			
Elevation	Circle One	A	3628.0 Square Feet
		B	3634.7 Square Feet
Optional Layouts	Circle All that Apply	GFA1	GROUND FLOOR Optional Alternative Layout

38.6 The Scarlatti			
Elevation	Circle One	A	3521.1 Square Feet
		B	3508.1 Square Feet
Optional Layouts	Circle All that Apply	GFA1	GROUND FLOOR Optional Alternative Layout

38.7 The Schubert			
Elevation	Circle One	A	3593.8 Square Feet
		B	3610.5 Square Feet
Optional Layouts	Circle All that Apply	GFA1	GROUND FLOOR Optional Alternative Layout
		SFA4	SECOND FLOOR Additional Bedroom

38.8 The Corelli			
Elevation	Circle One	A	3801.5 Square Feet
		B	3801.5 Square Feet
Optional Layouts	Circle All that Apply	GFA1	GROUND FLOOR Optional Alternative Layout
		SFA4	SECOND FLOOR Additional Bedroom w/ Ensuite

41.1 The Strauss			
Elevation	Circle One	A	2554.2 Square Feet
		B	2571.2 Square Feet
Optional Layouts	Circle All that Apply	SFA1	SECOND FLOOR Shower in Lieu of Tub B2

41.2 The Mozart			
Elevation	Circle One	A	2725.9 Square Feet
		B	2711.1 Square Feet
Optional Layouts	Circle All that Apply	SFA1	SECOND FLOOR Shower in Lieu of Tub B2

41.3 The Chopin			
Elevation	Circle One	A	2800.0 Square Feet
		B	2810.5 Square Feet
Optional Layouts	Circle All that Apply		

41.4 The Bach			
Elevation	Circle One	A	2894.4 Square Feet
		B	2894.5 Square Feet
Optional Layouts	Circle All that Apply		

41.5 The Brahms			
Elevation	Circle One	A	3948.1 Square Feet
		B	3949.1 Square Feet
Optional Layouts	Circle All that Apply	GFA1	GROUND FLOOR Optional Alternative Layout
		SFA2	SECOND FLOOR Shower in Lieu of Tub B4
		SFA3	SECOND FLOOR Optional Laundry Layout

41.6 The Verdi			
Elevation	Circle One	A	3862.5 Square Feet
		B	3866.4 Square Feet
Optional Layouts	Circle All that Apply	GFA1	GROUND FLOOR Optional Alternative Layout
		SFA3	SECOND FLOOR Optional Laundry Layout

May 17, 16



8