

Kleinburg Glen - 41L - 1 - 25-3 Elev.A OAKMOUNT OPT- GFA1 AND SFA5
CENTRAL VAC AND WIRING

Inv.774	1 - GREAT ROOM: CONDUIT PIPE - FOR TELEVISION - Locate approx. 66" A.F.F. above fireplace, terminating left of fireplace by cable outlet. See plan for location.
Line10341	Note:
22Aug16 / 9Nov16	
Inv.774	1 - GARAGE ENTRANCE: ROUGH - IN FOR EXTRA SECURITY KEY PAD
Line10346	Note:
22Aug16 / 9Nov16	

ELECTRICAL

Inv.774	1 - GREAT ROOM: 110V WALL RECEPTACLE ON NORMAL CIRCUIT - Locate approx. 66" A.F.F. above fireplace.
Line10340	Note:
22Aug16 / 9Nov16	
Inv.774	5 - KITCHEN: POT LIGHT: 4 INCH HALOGEN POT LIGHT - 440 WH - PRICED PER LIGHT - 10 OR MORE See plan for location.
Line10342	Note:
22Aug16 / 9Nov16	
Inv.774	1 - KITCHEN: Single pole switch for potlights. See plan for location.
Line10343	Note:
22Aug16 / 9Nov16	
Inv.774	4 - BREAKFAST: POT LIGHT: 4 INCH HALOGEN POT LIGHT - 440 WH - PRICED PER LIGHT - 10 OR MORE See plan for location.
Line10344	Note:
22Aug16 / 9Nov16	
Inv.774	1 - BREAKFAST: Single pole switch for potlight. See plan for location.
Line10345	Note:
22Aug16 / 9Nov16	
Inv.774	1 - KITCHEN: RELOCATE STANDARD FIXTURE - Move to above island. See plan for location.
Line10347	Note:
22Aug16 / 9Nov16	
Inv.774	1 - KITCHEN: ROUGH - IN CEILING OUTLET ON SAME SWITCH - DOES NOT INCLUDE FIXTURE - Locate above island, use same switch as standard. See plan for location.
Line10349	Note:
22Aug16 / 9Nov16	
Inv.774	6 - GREAT ROOM: POT LIGHT: 4 INCH HALOGEN POT LIGHT - 440 WH - PRICED PER LIGHT - 10 OR MORE - See plan for location.
Line10350	Note:
22Aug16 / 9Nov16	
Inv.774	1 - GREAT ROOM: Single pole switch for potlights. See plan for location.
Line10351	Note:
22Aug16 / 9Nov16	
Inv.774	1 - GREAT ROOM: ROUGH - IN CEILING OUTLET & SWITCH (WITH COVER PLATE) - DOES NOT INCLUDE FIXTURE - See plan for location.
Line10352	Note:
22Aug16 / 9Nov16	
Inv.774	4 - GREAT ROOM: POT LIGHT: 4 INCH HALOGEN POT LIGHT - 440 WH - PRICED PER LIGHT - 10 OR MORE
Line10353	Note:
22Aug16 / 9Nov16	

Kleinburg Glen - 41L - 1 - 25-3 Elev.A OAKMOUNT OPT- GFA1 AND SEA5

Inv.774	1 - GREAT ROOM: Single pole switch for potlights. See plan for location.
Line10354	Note:
22Aug16 / 9Nov16	
Inv.774	1 - 200 AMP ELECTRICAL SERVICE
Line10375	Note:
22Aug16 / 9Nov16	
Inv.774	1 - MASTER ENSUITE: ROUGH - IN WALL OUTLET ON SAME SWITCH - DOES NOT INCLUDE FIXTURE - Locate above mirror, right of sink. See plan for location.
Line10392	Note:
22Aug16 / 9Nov16	
Inv.774	1 - MASTER ENSUITE: RELOCATE STANDARD FIXTURE - move to left of vanity (to allow for 2 lights above vanity.) See plan for location.
Line10393	Note:
22Aug16 / 9Nov16	

EXTERIOR COLOURS

Inv.774	1 - EXTERIOR COLOUR PACKAGE 9
Line13626	Note:
22Aug16 / 9Nov16	

FRAMING

Inv.774	2 - MAIN FLOOR: FRAME MAIN FLOOR DOORS AT 96 INCH
Line10363	Note:
22Aug16 / 9Nov16	
Inv.774	1 - MANDOOR - GARAGE TO HOUSE - AS PER PLAN AND GRADE PERMITING
Line13627	Note: AS PER APS
22Aug16 / 9Nov16	
Inv.774	1 - OPTIONAL GROUND FLOOR
Line13629	Note:
22Aug16 / 9Nov16	
Inv.774	1 - OPTIONAL 4TH BEDROOM
Line13630	Note:
22Aug16 / 9Nov16	

HVAC

Inv.774	1 - HUMIDIFIER: WB3 - 12 (UP TO 2,000 SQ.FT.)
Line10357	Note:
22Aug16 / 9Nov16	
Inv.774	1 - BASEMENT: 3 ton A/C UNIT # 13ACX
Line10358	Note:
22Aug16 / 9Nov16	

INTERIOR TRIM AND DOORS

Inv.774	2 - MAIN FLOOR: EXTENDED HEIGHT ARCHWAY (PRICE PER DOORWAY) - 96"
Line10364	Note:
22Aug16 / 9Nov16	

MISC.

Kleinburg Glen - 41L - 1 - 25-3 Elev.A OAKMOUNT OPT- GFA1 AND SFA5

Inv.774	1 - Purchaser has attended a Structural appointment at the Decor Centre & has DECLINED any additional upgrades and accepts and acknowledges that there will be no further structural changes/additions/deletions to be made upon signing on August 22, 2016.
Line10366	Note:
22Aug16 / 9Nov16	
Inv.774	1 - Purchasers are aware & accepts that ANY changes made to upgrades after signing this Purchasers Extra Form are subject to a minimum administration fee of \$500. PLUS a 10% holdback fee.
Line10368	Note:
22Aug16 / 9Nov16	
Inv.774	1 - BONUS PACKAGE: \$5,000.00 (INCLUDING TAXES) WORTH OF UPGRADES FROM GOLD PARK HOMES DÉCOR CENTRE IS BEING APPLIED TOWARD THE STRUCTURAL APPOINTMENT. PURCHASER HAS A REMAINING AMOUNT OF \$00 (INCLUDING TAXES) TO BE USED TOWARD THE COLOUR APPOINTMENT.
Line10369	Note:
22Aug16 / 9Nov16	

PLUMBING

Inv.774	1 - KITCHEN: ROUGH - IN - WATERLINE FOR FRIDGE
Line10359	Note:
22Aug16 / 9Nov16	

WINDOWS - BASEMENT

Inv.774	2 - BASEMENT WINDOWS - UPGRADE EXISTING BASEMENT WINDOW TO 30 INCH X 24 INCH - MAY REQUIRE INSTALLATION OF WINDOW WELL
Line10356	Note:
22Aug16 / 9Nov16	


WINDOWS AND DOORS

Inv.774	1 - MAN DOOR GARAGE TO HOUSE - OPTIONAL - IF GRADE PERMITS
Line13628	Note: AS PER APS
22Aug16 / 9Nov16	

✓

Elevation A • 2,053 sq.ft.

~~Elevation B • 2,053 sq.ft.~~

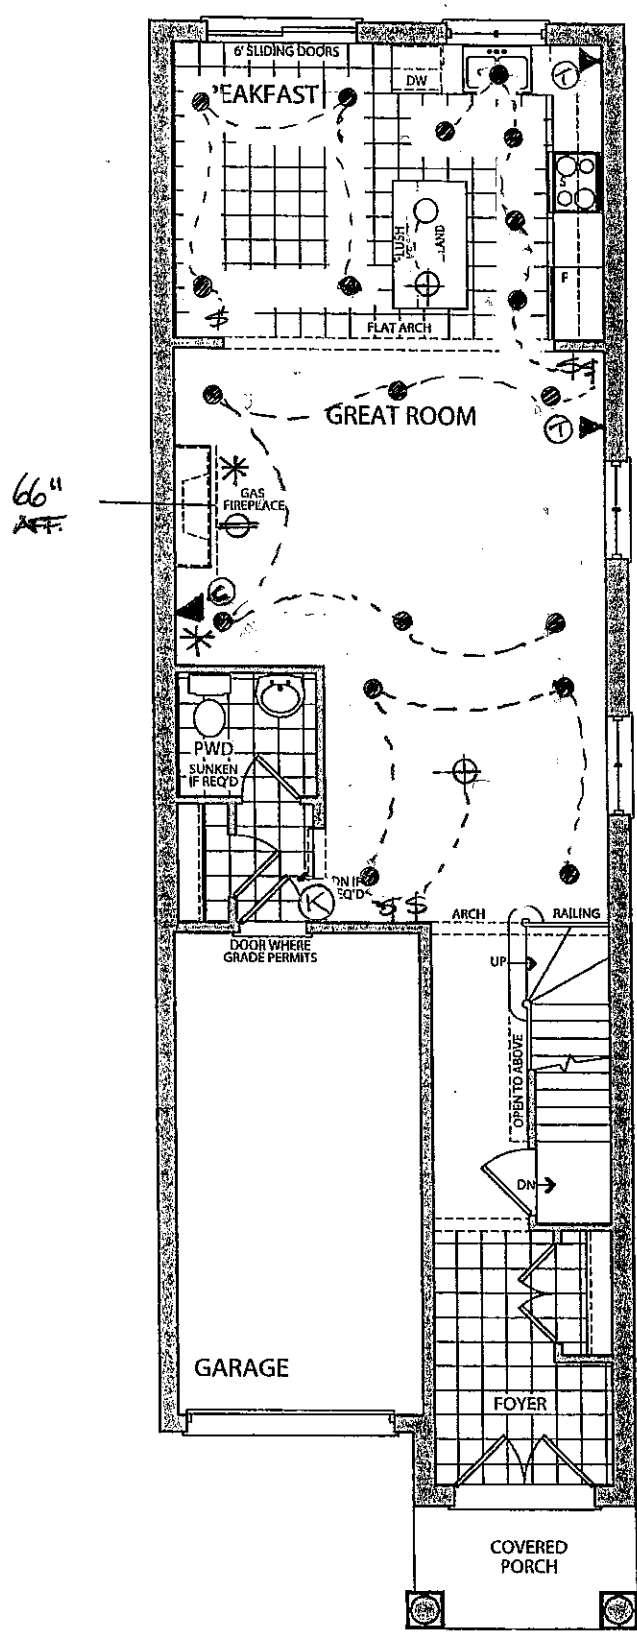


OPT. GROUND FLOOR


ELEVATION A

Elevation A • 2,053 sq.ft.

Elevation B • 2,053 sq.ft.

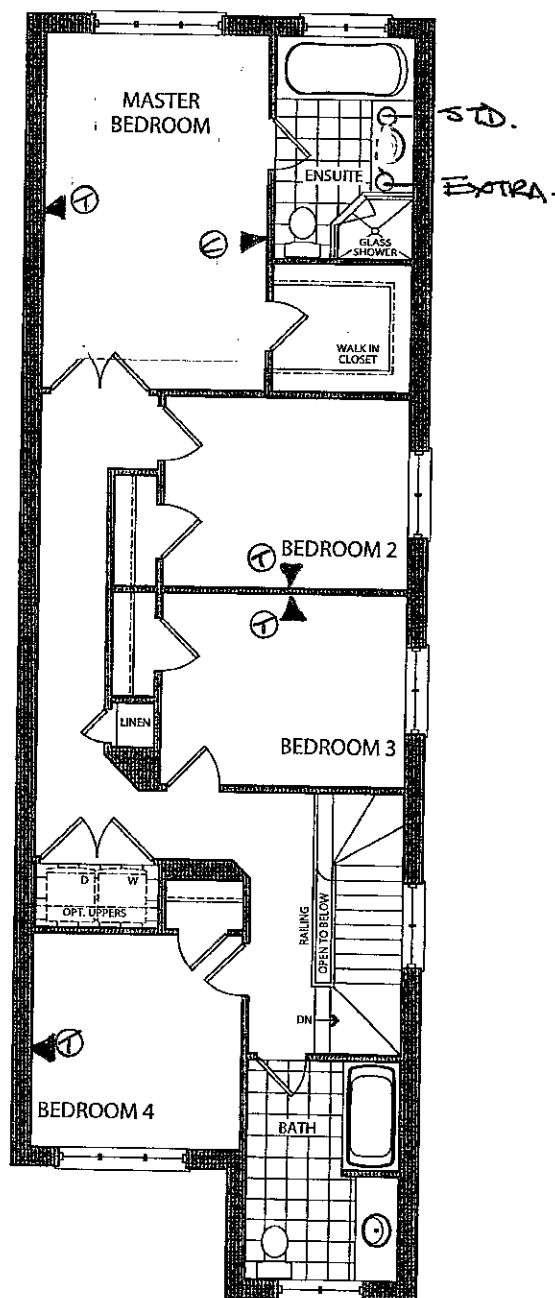

OPT. SECOND FLOOR
ELEVATION A

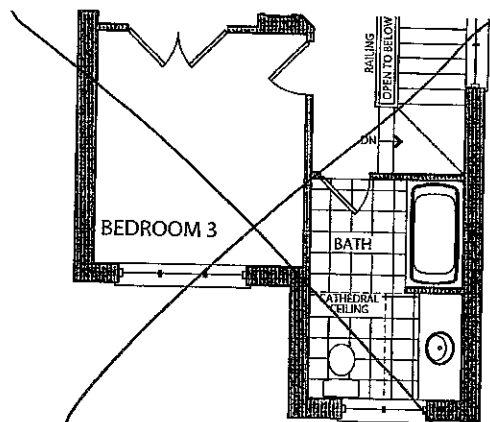

OPT. SECOND FLOOR
ELEVATION B


AUG 22 2016.
LOT 41L

MA




the *Oakmount*

✓ Elevation A • 2,053 sq.ft.
~~Elevation B • 2,053 sq.ft.~~

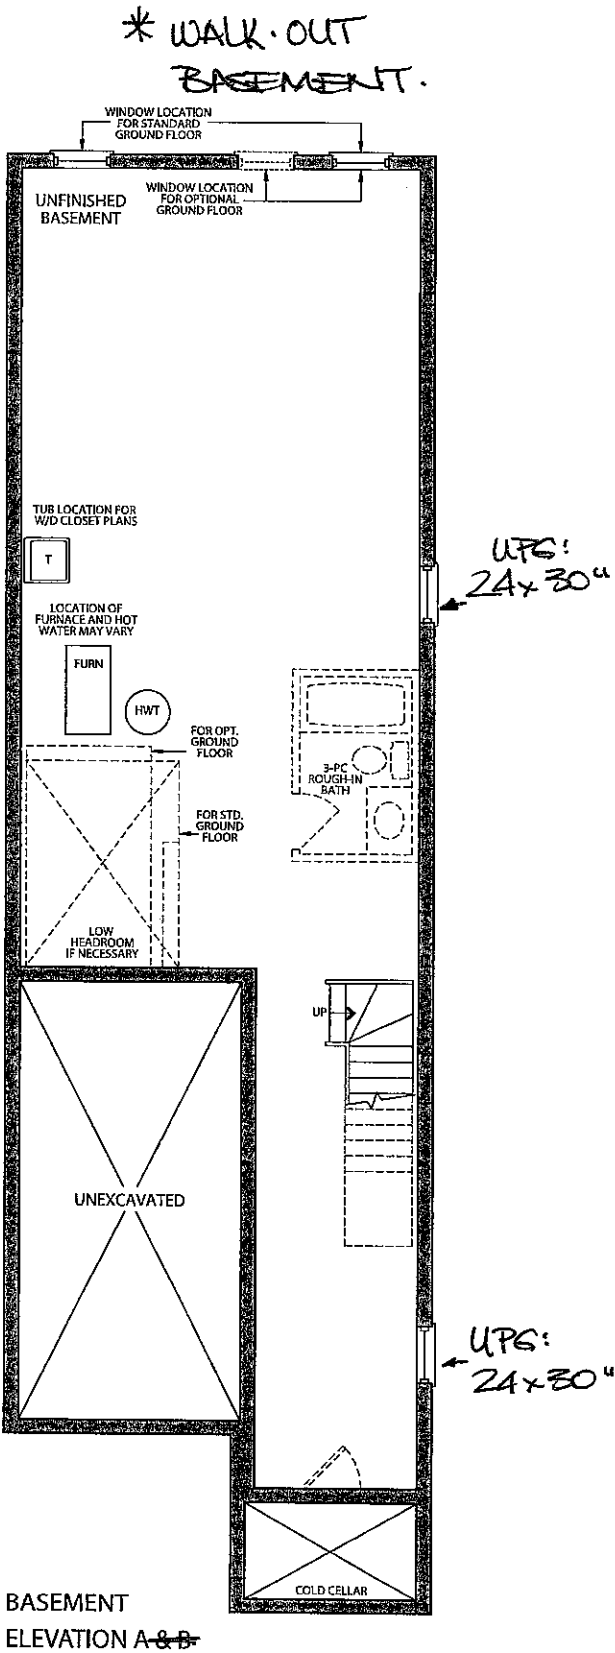

41 L (MA)
AUGUST 22 2016.

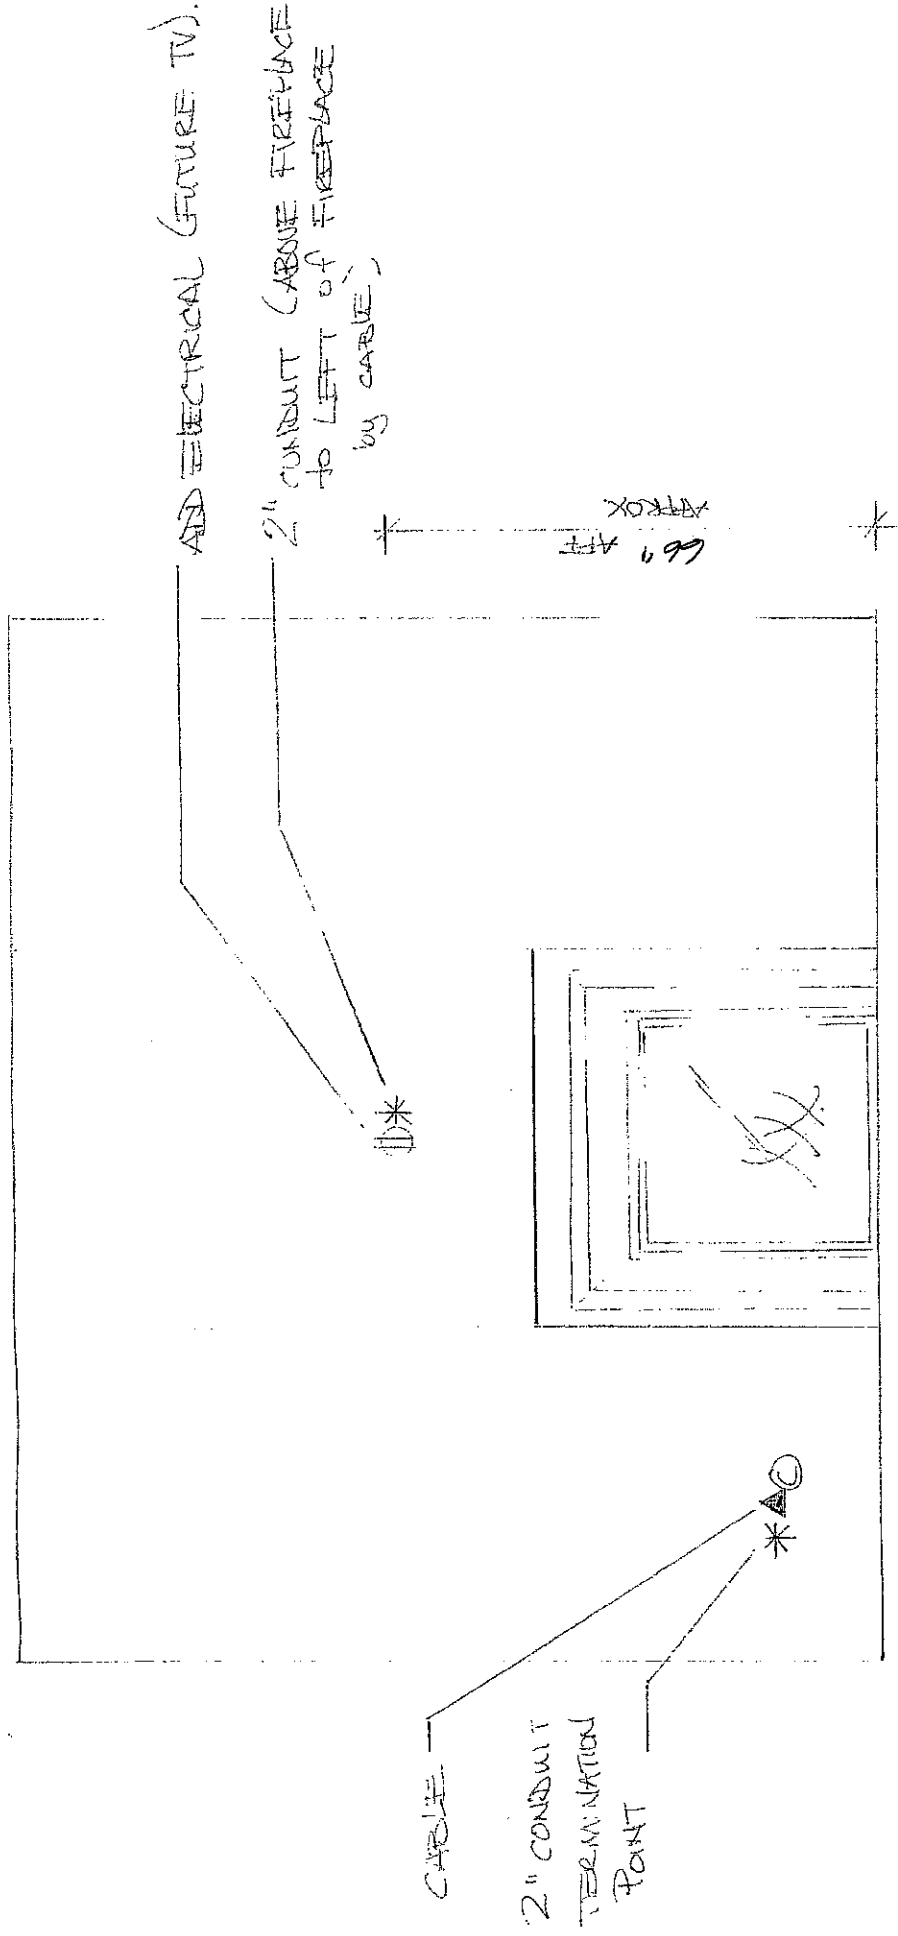

ADD ELECTRICAL (FUTURE TV).
 2" CONDUIT (ABOVE FIREPLACE
 to LEFT of FIREPLACE
 by CABLE.)

66" AFF
 ATTACK

GREAT ROOM - FIREPLACE ELEVATION.

(M)

AUGUST 22 2016.

41-L.



Stacey Carlete
Project Coordinator



Claude Azzopardi
Contracts Manager



Nancy Martini
Corporate Controller



*WALK-OUT BASEMENT.

25.1 The Riverstone			
Elevation	Circle One	A	1812.7 Square Feet
		B	1812.7 Square Feet
Taller Ceilings	Circle All that Apply	GFTC	9' Ceilings Ground Floor
		MFTC	10' Ceilings Main Floor
		SFTC	9' Ceilings Second Floor
Optional Layouts	Circle All that Apply	GFA1	GROUND FLOOR Alternative Layout Kitchen/Family Room

25.2 The Hudson			
Elevation	Circle One	A	1860.8 Square Feet
		B	1858.6 Square Feet
Taller Ceilings	Circle All that Apply	GFTC	9' Ceilings Ground Floor
		MFTC	10' Ceilings Main Floor
		SFTC	9' Ceilings Second Floor
Optional Layouts	Circle All that Apply	GFA1	GROUND FLOOR Alternative Layout Kitchen/Family Room

25.3 The Oakmount			
Elevation	Circle One	A	2013.0 Square Feet
		B	2013.0 Square Feet
Taller Ceilings	Circle All that Apply	GFTC	9' Ceilings Ground Floor
		MFTC	10' Ceilings Main Floor
		SFTC	9' Ceilings Second Floor
Optional Layouts	Circle All that Apply	GFA1	GROUND FLOOR Alternative Layout Kitchen/Family Room
		SFA4	SECOND FLOOR Alternative Layout Laundry Room
		SFA5	SECOND FLOOR Additional Bedroom

25.4 The Stanford			
Elevation	Circle One	A	2665.6 Square Feet
		B	2665.6 Square Feet
Taller Ceilings	Circle All that Apply	GFTC	9' Ceilings Ground Floor
		MFTC	10' Ceilings Main Floor
		SFTC	9' Ceilings Second Floor
Optional Layouts	Circle All that Apply	GFA2	GROUND FLOOR Optional 3-Piece Bathroom
		MFA1	MAIN FLOOR Alternative Layout Kitchen/Family Room
		SFA2	SECOND FLOOR Shower in Lieu of Tub (Master Ens.)
		SFA5	SECOND FLOOR Additional Bedroom

25.5 The Regency			
Elevation	Circle One	A	2924.0 Square Feet
		B	2924.0 Square Feet
Taller Ceilings	Circle All that Apply	GFTC	9' Ceilings Ground Floor
		MFTC	10' Ceilings Main Floor
		SFTC	9' Ceilings Second Floor
Optional Layouts	Circle All that Apply	GFA2	GROUND FLOOR Optional 3-Piece Bathroom
		MFA1	MAIN FLOOR Alternative Layout Kitchen/Family Room
		SFA2	SECOND FLOOR Shower in Lieu of Tub (Master Ens.)
		SFA5	SECOND FLOOR Additional Bedroom

25.6 The Lincoln			
Elevation	Circle One	A	3021.0 Square Feet
		B	3014.0 Square Feet
Taller Ceilings	Circle All that Apply	GFTC	9' Ceilings Ground Floor
		MFTC	10' Ceilings Main Floor
		SFTC	9' Ceilings Second Floor
Optional Layouts	Circle All that Apply	GFA2	GROUND FLOOR Optional 3-Piece Bathroom
		MFA1	MAIN FLOOR Alternative Layout Kitchen/Family Room

25.7 The Carnegie			
Elevation	Circle One	A	3150.8 Square Feet
		B	3150.8 Square Feet
Taller Ceilings	Circle All that Apply	GFTC	9' Ceilings Ground Floor
		MFTC	10' Ceilings Main Floor
		SFTC	9' Ceilings Second Floor
Optional Layouts	Circle All that Apply	GFA2	GROUND FLOOR Optional 3-Piece Bathroom
		MFA1	MAIN FLOOR Alternative Layout Kitchen/Family Room
		SFA1	SECOND FLOOR Shower in Lieu of Tub (Bedroom 2)

25.8 The Biltmore			
Elevation	Circle One	A	1980.8 Square Feet
		B	1989.3 Square Feet
Taller Ceilings	Circle All that Apply	GFTC	9' Ceilings Ground Floor
		MFTC	10' Ceilings Main Floor
		SFTC	9' Ceilings Second Floor
Optional Layouts	Circle All that Apply		

Elevation	Circle One		
Taller Ceilings	Circle All that Apply		
Optional Layouts	Circle All that Apply		

Elevation	Circle One		
Taller Ceilings	Circle All that Apply		
Optional Layouts	Circle All that Apply		

AUG. 22 2016.

LOT 41 L

