



CONSTRUCTION SUMMARY

Kleinburg Glen - 41R - 1 - 25-2 Elev.A HUDSON
CENTRAL VAC AND WIRING

Inv.793	1 - FAMILY ROOM: CONDUIT PIPE - FOR TELEVISION - Locate approx. 66" A.F.F. above fireplace, terminating right of fireplace by cable outlet. See plan for location.
Line10611	Note:
29Aug16 / 14Nov16	
Inv.793	1 - BEDROOM 2: CAT 5 WIRING - ADD EXTRA CABLE OUTLET. See plan for location.
Line10693	Note:
29Aug16 / 14Nov16	

ELECTRICAL

Inv.793	1 - FAMILY ROOM: 110V WALL RECEPTACLE ON NORMAL CIRCUIT Locate approx. 66" A.F.F. above fireplace. See plan for location.
Line10603	Note:
29Aug16 / 14Nov16	
Inv.793	1 - KITCHEN: 110V WALL RECEPTACLE ON DEDICATED CIRCUIT - FOR MICROWAVE - MICROWAVE NOT INCLUDED FOR future OTR microwave. Cabinetry adjustment to be paid for at colour appointment.
Line10619	Note:
29Aug16 / 14Nov16	

EXTERIOR COLOURS

Inv.793	1 - EXTERIOR COLOUR PACKAGE 4
Line13896	Note:
29Aug16 / 14Nov16	

FRAMING

Inv.793	1 - MANDOOR - GARAGE TO HOUSE - AS PER PLAN AND GRADE PERMITING
Line13898	Note:
29Aug16 / 14Nov16	
Inv.793	3 - MAIN FLOOR: FRAME MAIN FLOOR ARCHES AT 96 INCH -
Line10609	Note:
29Aug16 / 14Nov16	

GARAGE DOORS

Inv.793	1 - GARAGE DOOR OPENER - WITH 1 REMOTE - PRICE IS PER DOOR
Line10605	Note:
29Aug16 / 14Nov16	
Inv.793	1 - EXTRA REMOTE CONTROL FOR GARAGE DOOR
Line10607	Note:
29Aug16 / 14Nov16	
Inv.793	1 - DIGITAL ENTRY KEYPAD
Line10608	Note:
29Aug16 / 14Nov16	

INTERIOR TRIM AND DOORS

Inv.793	3 - MAIN FLOOR: EXTENDED HEIGHT ARCHWAY (PRICE PER DOORWAY) - 96"
Line10610	Note:
29Aug16 / 14Nov16	

MISC.

Kleinburg Glen - 41R - 1 - 25-2 Elev.A HUDSON


Inv.793	1 - Purchaser has attended a Structural appointment at the Decor Centre & has DECLINED any additional upgrades and accepts and acknowledges that there will be no further structural changes/additions/deletions to be made upon signing on August 29, 2016.
Line10616	Note:
29Aug16 / 14Nov16	
Inv.793	1 - Purchasers are aware & accepts that ANY changes made to upgrades after signing this Purchasers Extra Form are subject to a minimum administration fee of \$500. PLUS a 10% holdback fee.
Line10617	Note:
29Aug16 / 14Nov16	
Inv.793	1 - BONUS PACKAGE: \$5,000.00 (INCLUDING TAXES) WORTH OF UPGRADES FROM GOLD PARK HOMES DÉCOR CENTRE IS BEING APPLIED TOWARD THE STRUCTURAL APPOINTMENT. PURCHASER HAS A REMAINING AMOUNT OF \$2655.25 (INCLUDING TAXES) TO BE USED TOWARD THE COLOUR APPOINTMENT.
Line10618	Note:
29Aug16 / 14Nov16	

WINDOWS AND DOORS

Inv.793	1 - MAN DOOR GARAGE TO HOUSE - OPTIONAL - IF GRADE PERMITS
Line13897	Note:
29Aug16 / 14Nov16	

Elevation A • 1,898 sq.ft.

Elevation B • 1,898 sq.ft.

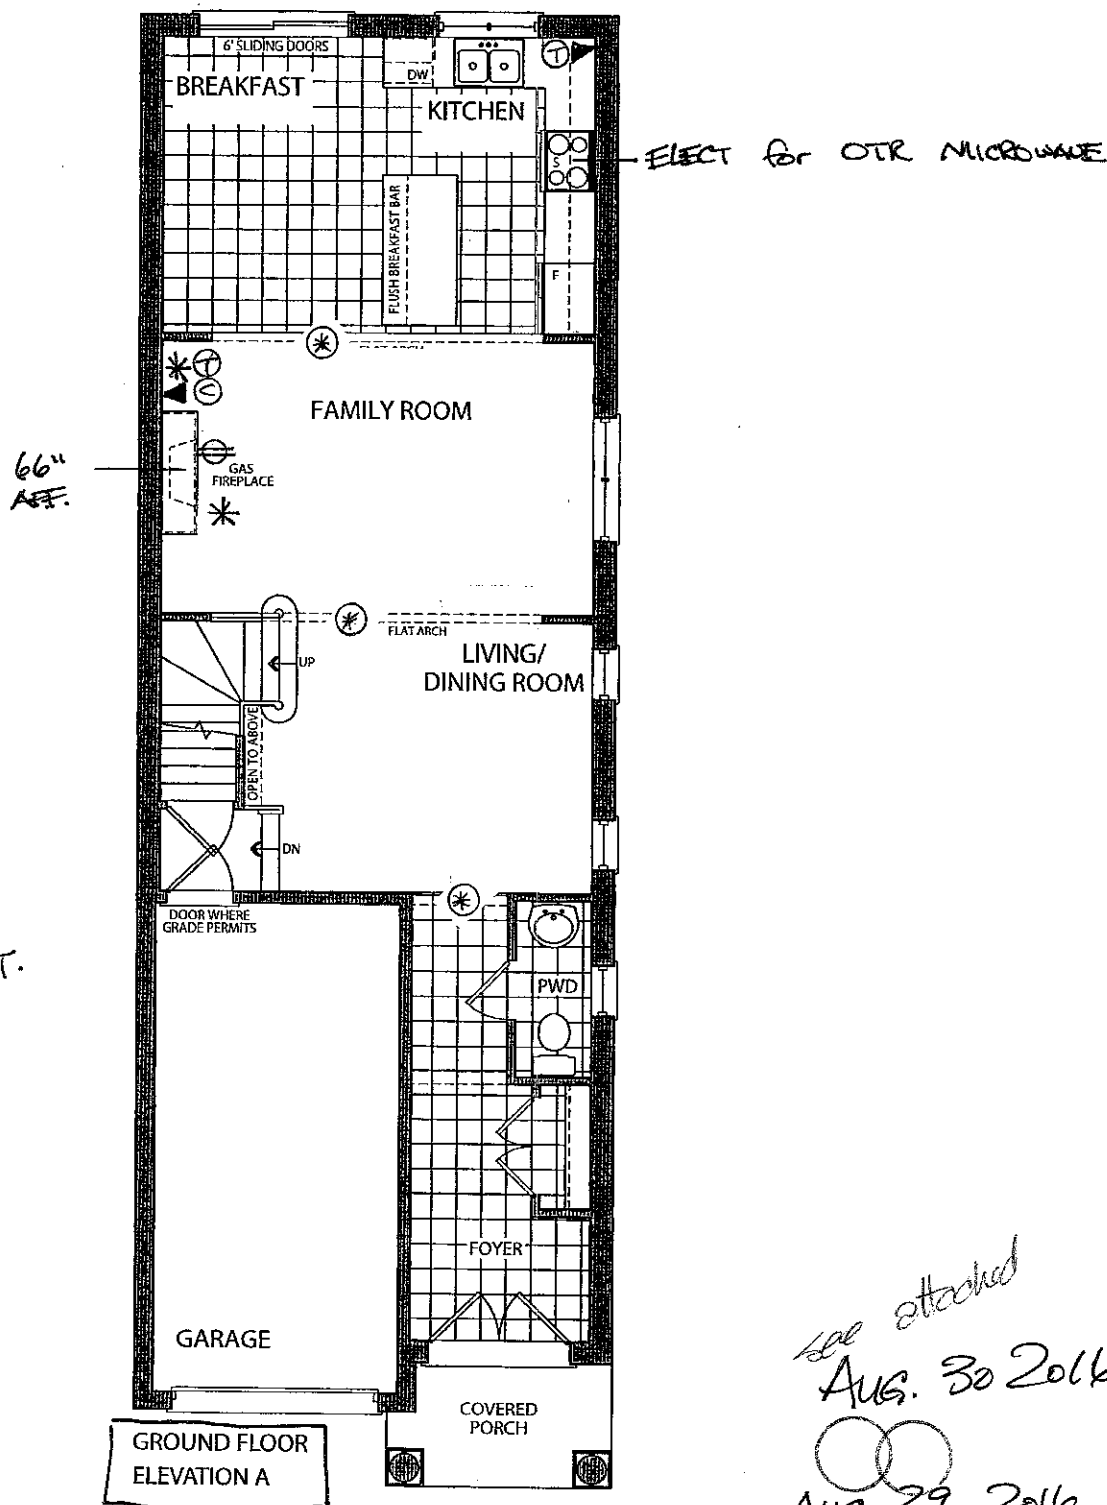

* 96" ARCH.

⊕ ELECT. OUTLET.

▲ ⊕ CABLE


▲ ⊕ PHONE

see attached
AUG. 30 2016


AUG. 29 2016

LOT 41R


(2B)

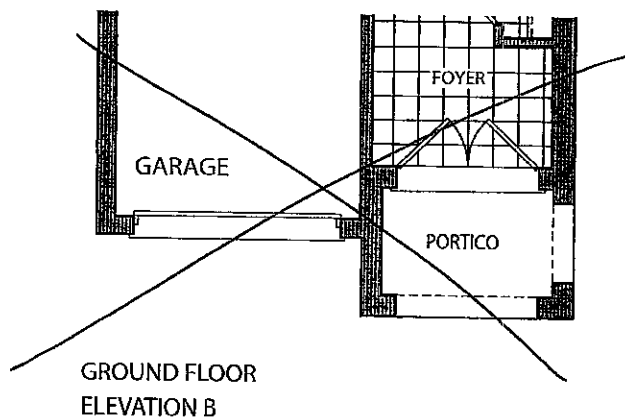

Elevation A • 1,898 sq.ft.
Elevation B • 1,898 sq.ft.

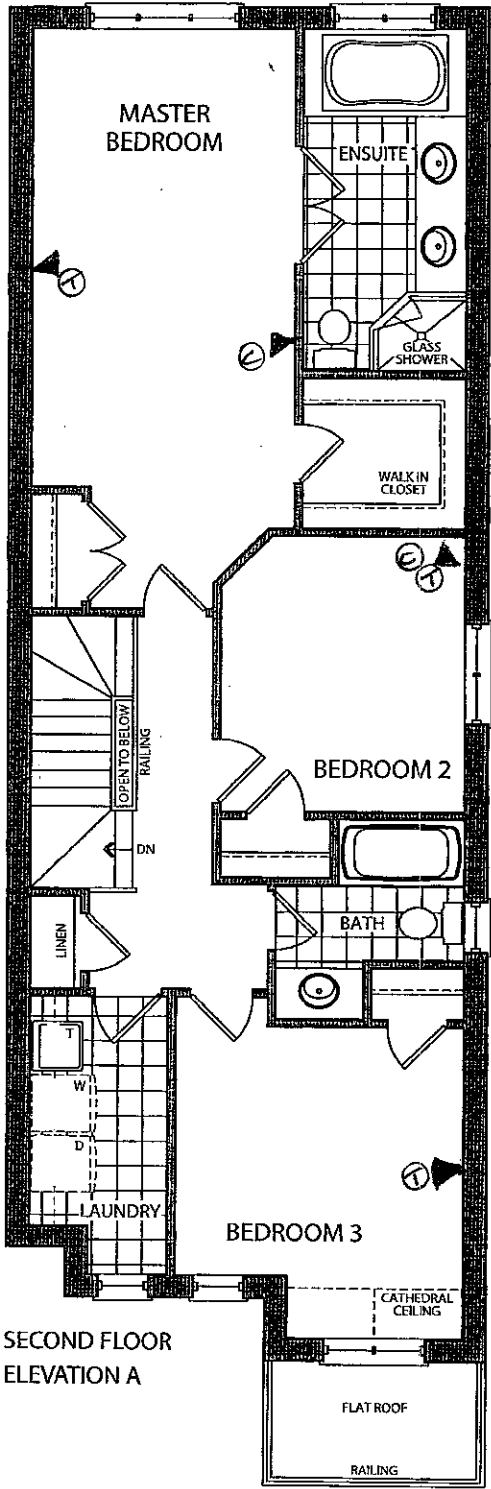

SECOND FLOOR
ELEVATION A

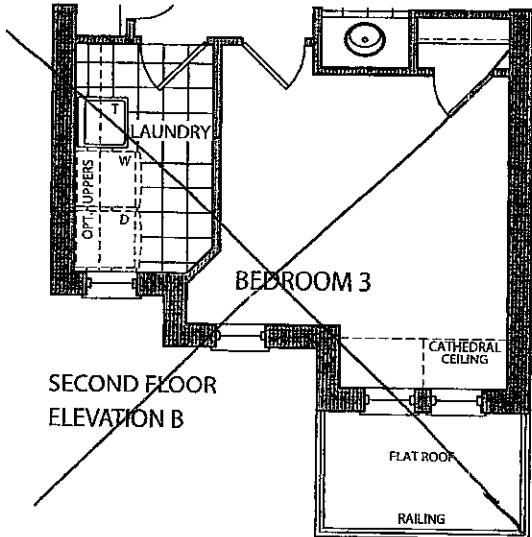

SECOND FLOOR
ELEVATION B

see attached
Aug 30 2016




AUG. 29 2016
LOT 412




Elevation A • 1,898 sq.ft.

Elevation B • 1,898 sq.ft.

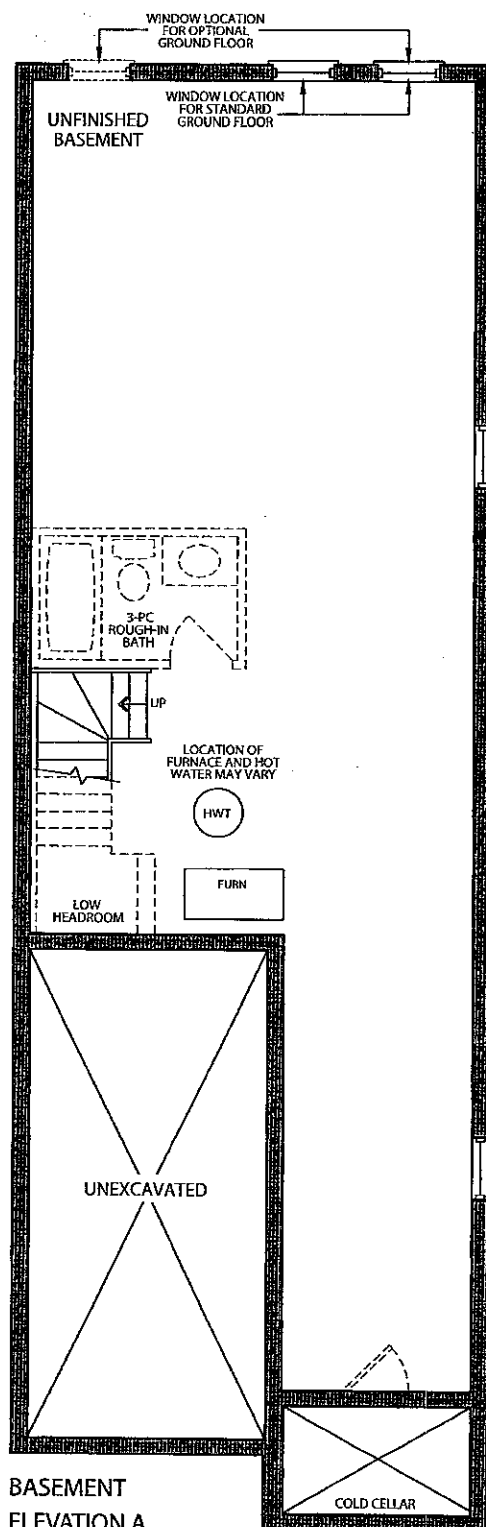

BASEMENT
ELEVATION A

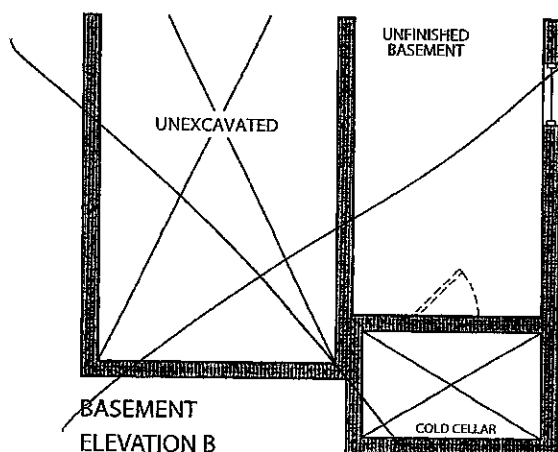

BASEMENT
ELEVATION B

see attached
Aug 30 2016
Aug. 29 2016
LOT 41R

28



Stacey Carlete
Project Coordinator



Claude Azzopardi
Contracts Manager



Nancy Martini
Corporate Controller



25.1 The Riverstone			
Elevation	Circle One	A	1812.7 Square Feet
		B	1812.7 Square Feet
Taller Ceilings	Circle All that Apply	GFTC	9' Ceilings Ground Floor
		MFTC	10' Ceilings Main Floor
		SFTC	9' Ceilings Second Floor
Optional Layouts	Circle All that Apply	GFA1	GROUND FLOOR Alternative Layout Kitchen/Family Room

25.2 The Hudson			
Elevation	Circle One	A	1860.8 Square Feet
		B	1858.6 Square Feet
Taller Ceilings	Circle All that Apply	GFTC	9' Ceilings Ground Floor
		MFTC	10' Ceilings Main Floor
		SFTC	9' Ceilings Second Floor
Optional Layouts	Circle All that Apply	GFA1	GROUND FLOOR Alternative Layout Kitchen/Family Room

25.3 The Oakmount			
Elevation	Circle One	A	2013.0 Square Feet
		B	2013.0 Square Feet
Taller Ceilings	Circle All that Apply	GFTC	9' Ceilings Ground Floor
		MFTC	10' Ceilings Main Floor
		SFTC	9' Ceilings Second Floor
Optional Layouts	Circle All that Apply	GFA1	GROUND FLOOR Alternative Layout Kitchen/Family Room
		SFA4	SECOND FLOOR Alternative Layout Laundry Room
		SFA5	SECOND FLOOR Additional Bedroom

25.4 The Stanford			
Elevation	Circle One	A	2665.6 Square Feet
		B	2665.6 Square Feet
Taller Ceilings	Circle All that Apply	GFTC	9' Ceilings Ground Floor
		MFTC	10' Ceilings Main Floor
		SFTC	9' Ceilings Second Floor
Optional Layouts	Circle All that Apply	GFA2	GROUND FLOOR Optional Piece Bathroom
		MFA1	MAIN FLOOR Alternative Layout Kitchen/Family Room
		SFA2	SECOND FLOOR Shower in Lieu of Tub (Master Ens.)
		SFA5	SECOND FLOOR Additional Bedroom

25.5 The Regency			
Elevation	Circle One	A	2924.0 Square Feet
		B	2924.0 Square Feet
Taller Ceilings	Circle All that Apply	GFTC	9' Ceilings Ground Floor
		MFTC	10' Ceilings Main Floor
		SFTC	9' Ceilings Second Floor
Optional Layouts	Circle All that Apply	GFA2	GROUND FLOOR Optional Piece Bathroom
		MFA1	MAIN FLOOR Alternative Layout Kitchen/Family Room
		SFA2	SECOND FLOOR Shower in Lieu of Tub (Master Ens.)
		SFA5	SECOND FLOOR Additional Bedroom

25.6 The Lincoln			
Elevation	Circle One	A	3021.0 Square Feet
		B	3014.0 Square Feet
Taller Ceilings	Circle All that Apply	GFTC	9' Ceilings Ground Floor
		MFTC	10' Ceilings Main Floor
		SFTC	9' Ceilings Second Floor
Optional Layouts	Circle All that Apply	GFA2	GROUND FLOOR Optional Piece Bathroom
		MFA1	MAIN FLOOR Alternative Layout Kitchen/Family Room

25.7 The Carnegie			
Elevation	Circle One	A	3150.8 Square Feet
		B	3150.8 Square Feet
Taller Ceilings	Circle All that Apply	GFTC	9' Ceilings Ground Floor
		MFTC	10' Ceilings Main Floor
		SFTC	9' Ceilings Second Floor
Optional Layouts	Circle All that Apply	GFA2	GROUND FLOOR Optional Piece Bathroom
		MFA1	MAIN FLOOR Alternative Layout Kitchen/Family Room
		SFA1	SECOND FLOOR Shower in Lieu of Tub (Bedroom 2)

25.8 The Biltmore			
Elevation	Circle One	A	1980.8 Square Feet
		B	1989.3 Square Feet
Taller Ceilings	Circle All that Apply	GFTC	9' Ceilings Ground Floor
		MFTC	10' Ceilings Main Floor
		SFTC	9' Ceilings Second Floor
Optional Layouts	Circle All that Apply		

Elevation	Circle One		
Taller Ceilings	Circle All that Apply		
Optional Layouts	Circle All that Apply		

Elevation	Circle One		
Taller Ceilings	Circle All that Apply		
Optional Layouts	Circle All that Apply		

attached
Aug. 30 2016
Aug 29 2016
LOT 41R

2B