

Kleinburg Glen - 42R - 1 - 25-2 Elev.B HUDSON
CERAMIC

Inv.786	1 - BEDROOM 3: **DELETE** closet in bedroom, making bathroom larger. See plan for location.
Line13616	Note:
25Aug16 / 9Nov16	

ELECTRICAL

Inv.786	1 - KITCHEN: In addition to builders standard ceiling light, ROUGH - IN 1 CEILING OUTLET ON SAME SWITCH - DOES NOT INCLUDE FIXTURE - Locate above island, see plan for location.
Line10569	Note:
25Aug16 / 9Nov16	

EXTERIOR COLOURS

Inv.786	1 - EXTERIOR COLOUR PACKAGE 12
Line13617	Note:
25Aug16 / 9Nov16	

FRAMING

Inv.786	1 - FAMILY ROOM: OPTIONAL COFFERED CEILING - FAMILY ROOM (PER ROOM AS PER PLAN)
Line10570	Note:
25Aug16 / 9Nov16	
Inv.786	2 - MAIN FLOOR: FRAME MAIN FLOOR ARCH AT 96 INCH See plan for location.
Line10572	Note:
25Aug16 / 9Nov16	
Inv.786	1 - BEDROOM 3: **DELETE** closet in bedroom, making bathroom larger. See plan for location.
Line10574	Note:
25Aug16 / 9Nov16	
Inv.957	1 - MANDOOR - GARAGE TO HOUSE - AS PER PLAN AND GRADE PERMITING
Line13619	Note: as per aps
9Nov16 / 9Nov16	

INTERIOR TRIM AND DOORS

Inv.786	2 - MAIN FLOOR: EXTENDED HEIGHT ARCHWAY (PRICE PER DOORWAY) 96" See plan for location.
Line10573	Note:
25Aug16 / 9Nov16	
Inv.786	1 - BEDROOM 3: **DELETE** closet in bedroom, making bathroom larger. See plan for location.
Line13615	Note:
25Aug16 / 9Nov16	

MISC.

Inv.786	1 - BONUS PACKAGE: \$5,000.00 (INCLUDING TAXES) WORTH OF UPGRADES FROM GOLD PARK HOMES DÉCOR CENTRE IS BEING APPLIED TOWARD THE STRUCTURAL APPOINTMENT. PURCHASER HAS A REMAINING AMOUNT OF \$00 (INCLUDING TAXES) TO BE USED TOWARD THE COLOUR APPOINTMENT.
Line10578	Note:
25Aug16 / 9Nov16	

Kleinburg Glen - 42R - 1 - 25-2 Elev.B HUDSON

Inv.786	1 - Purchaser has attended a Structural appointment at the Decor Centre & has DECLINED any additional upgrades and accepts and acknowledges that there will be no further structural changes/additions/deletions to be made upon signing on August 25, 2016.
Line10576	Note:
25Aug16 / 9Nov16	
Inv.786	1 - Purchasers are aware & accepts that ANY changes made to upgrades after signing this Purchasers Extra Form are subject to a minimum administration fee of \$500. PLUS a 10% holdback fee.
Line10577	Note:
25Aug16 / 9Nov16	

WINDOWS - BASEMENT


Inv.786	2 - BASEMENT WINDOWS - UPGRADE EXISTING BASEMENT WINDOW TO 30 INCH X 24 INCH - MAY REQUIRE INSTALLATION OF WINDOW WELL
Line10571	Note:
25Aug16 / 9Nov16	

WINDOWS AND DOORS

Inv.957	1 - MAN DOOR GARAGE TO HOUSE - OPTIONAL - IF GRADE PERMITS
Line13618	Note: as per aps
9Nov16 / 9Nov16	

Elevation A • 1,898 sq.ft.

Elevation B • 1,898 sq.ft.

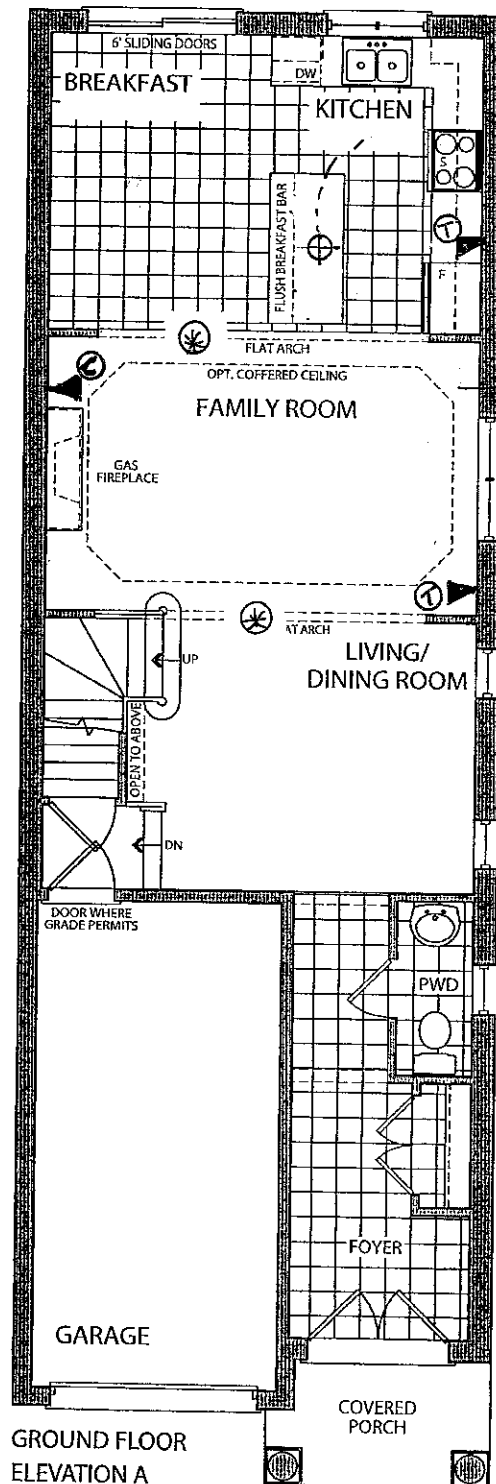


⊙ 96" Arch.

⊕ ROUGH IN
CEILING LIGHT

▲ ① R/W/E

▲ ② CABLE

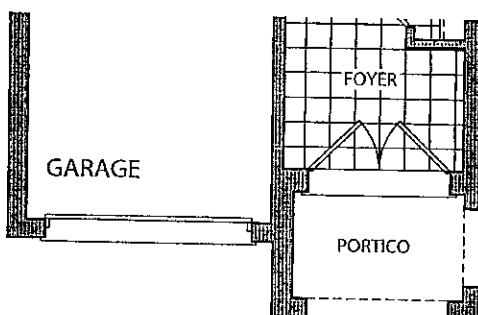


GROUND FLOOR
ELEVATION B

AUGUST 25 2016
LOT 42R

NB NB

✗ Elevation A • 1,898 sq.ft.

✓ Elevation B • 1,898 sq.ft.

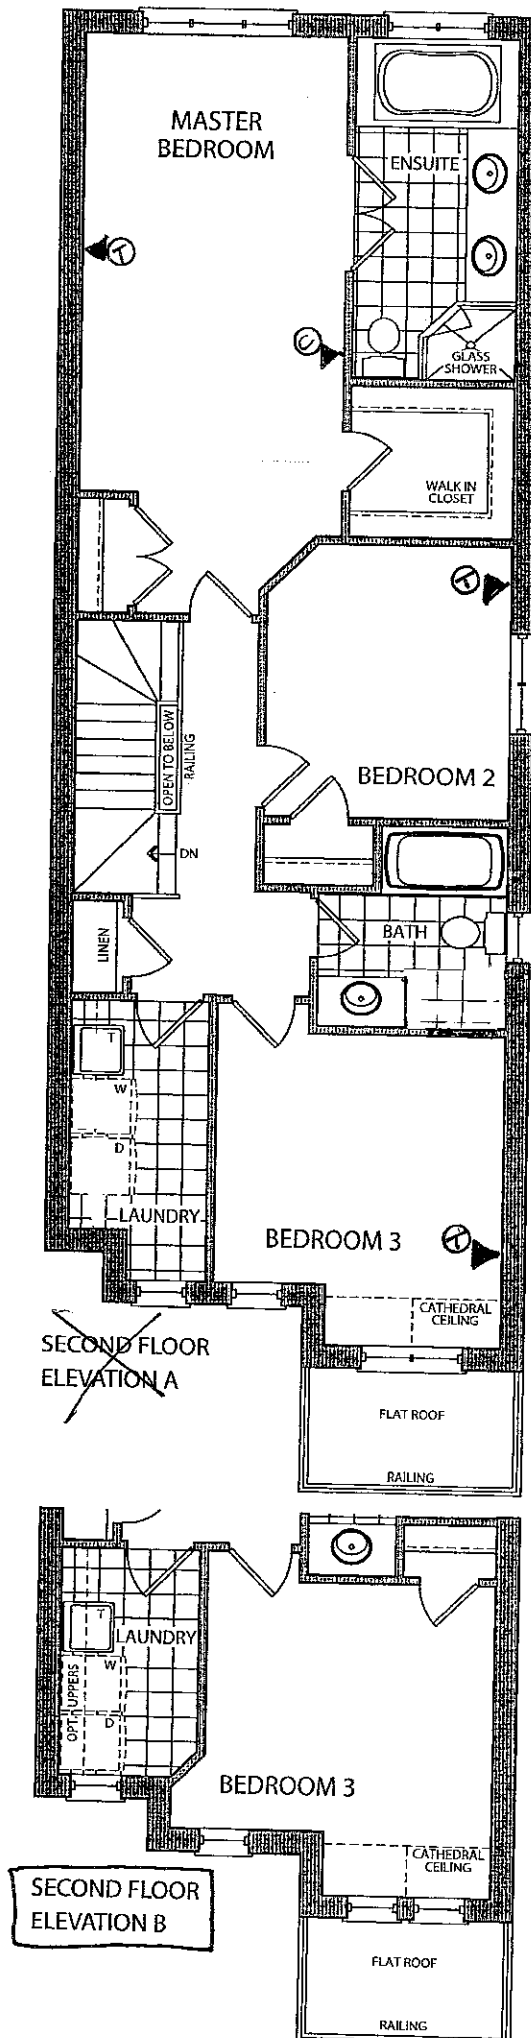

REVISED BATHROOM
LAY OUT

↙ ~~DELETE CLOSET~~
MAKE BATHROOM
LARGER.

- NO CLOSET IN
BEDROOM 3!



AUGUST 25 2016
LOT 42R

NB NB

* WALK-OUT
BASEMENT

Elevation A • 1,898 sq.ft.

Elevation B • 1,898 sq.ft.

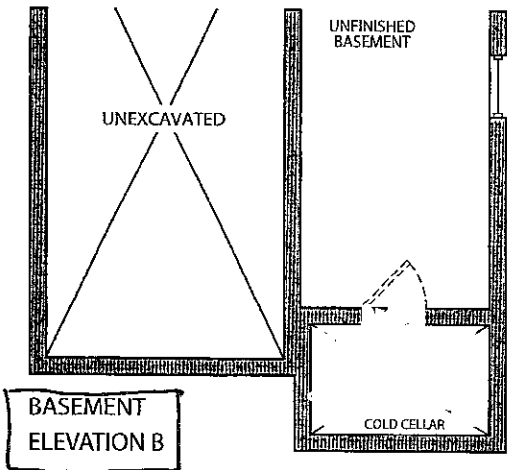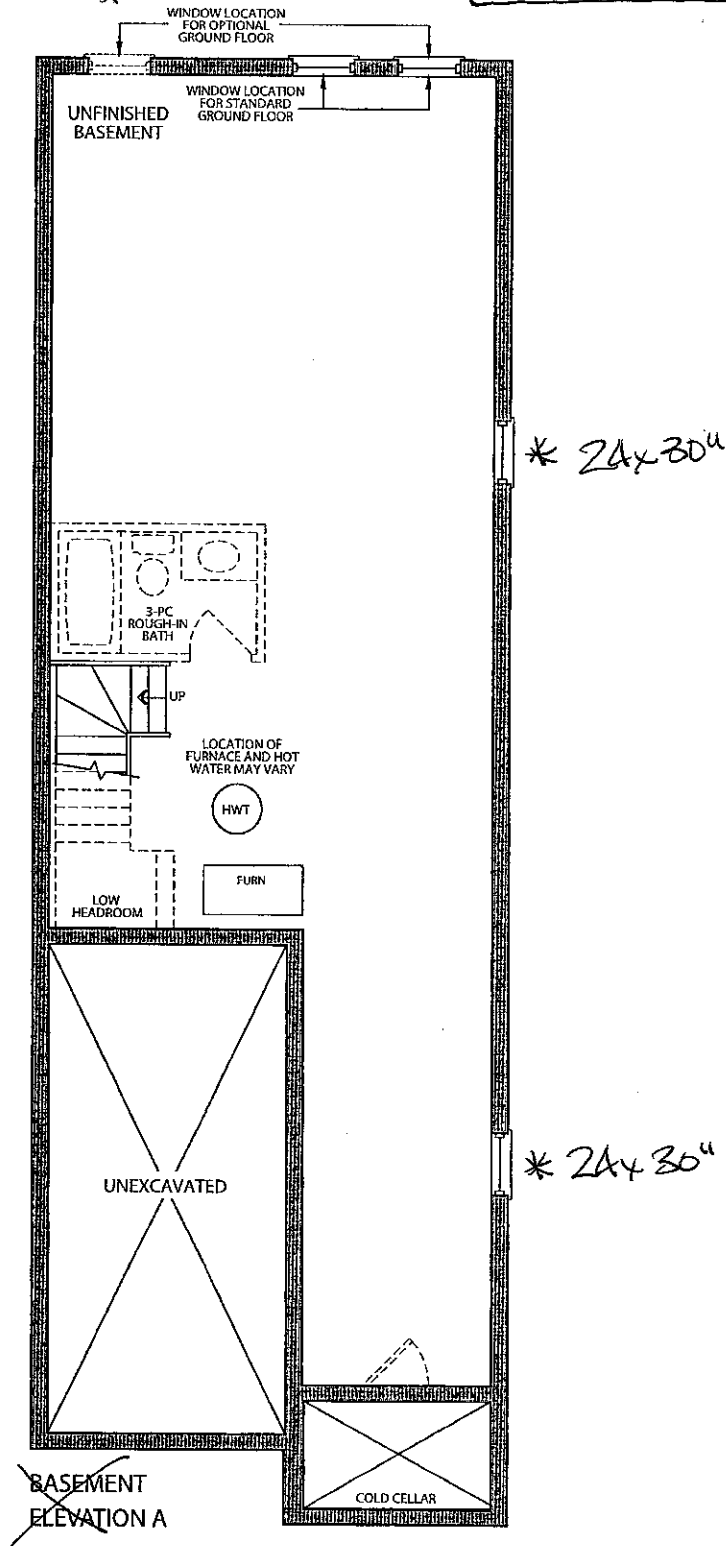

AUGUST 25 2a6
LOT 42R

NB 11B



Stacey Carlete
Project Coordinator



Claude Azzopardi
Contracts Manager



Nancy Martini
Corporate Controller



* WALK-OUT BASEMENT.

25.1 The Riverstone			
Elevation	Circle One	A	1812.7 Square Feet
		B	1812.7 Square Feet
Taller Ceilings	Circle All that Apply	GFTC	9' Ceilings Ground Floor
		MFTC	10' Ceilings Main Floor
		SFTC	9' Ceilings Second Floor
Optional Layouts	Circle All that Apply	GFA1	GROUND FLOOR Alternative Layout Kitchen/Family Room

25.2 The Hudson			
Elevation	Circle One	A	1860.8 Square Feet
		B	1858.6 Square Feet
Taller Ceilings	Circle All that Apply	GFTC	9' Ceilings Ground Floor
		MFTC	10' Ceilings Main Floor
		SFTC	9' Ceilings Second Floor
Optional Layouts	Circle All that Apply	GFA1	GROUND FLOOR Alternative Layout Kitchen/Family Room

25.3 The Oakmount			
Elevation	Circle One	A	2013.0 Square Feet
		B	2013.0 Square Feet
Taller Ceilings	Circle All that Apply	GFTC	9' Ceilings Ground Floor
		MFTC	10' Ceilings Main Floor
		SFTC	9' Ceilings Second Floor
Optional Layouts	Circle All that Apply	GFA1	GROUND FLOOR Alternative Layout Kitchen/Family Room
		SFA4	SECOND FLOOR Alternative Layout Laundry Room
		SFA5	SECOND FLOOR Additional Bedroom

25.4 The Stanford			
Elevation	Circle One	A	2665.6 Square Feet
		B	2665.6 Square Feet
Taller Ceilings	Circle All that Apply	GFTC	9' Ceilings Ground Floor
		MFTC	10' Ceilings Main Floor
		SFTC	9' Ceilings Second Floor
Optional Layouts	Circle All that Apply	GFA2	GROUND FLOOR Optional Piece Bathroom
		MFA1	MAIN FLOOR Alternative Layout Kitchen/Family Room
		SFA2	SECOND FLOOR Shower in Lieu of Tub (Master Ens.)
		SFA5	SECOND FLOOR Additional Bedroom

25.5 The Regency			
Elevation	Circle One	A	2924.0 Square Feet
		B	2924.0 Square Feet
Taller Ceilings	Circle All that Apply	GFTC	9' Ceilings Ground Floor
		MFTC	10' Ceilings Main Floor
		SFTC	9' Ceilings Second Floor
Optional Layouts	Circle All that Apply	GFA2	GROUND FLOOR Optional Piece Bathroom
		MFA1	MAIN FLOOR Alternative Layout Kitchen/Family Room
		SFA2	SECOND FLOOR Shower in Lieu of Tub (Master Ens.)
		SFA5	SECOND FLOOR Additional Bedroom

25.6 The Lincoln			
Elevation	Circle One	A	3021.0 Square Feet
		B	3014.0 Square Feet
Taller Ceilings	Circle All that Apply	GFTC	9' Ceilings Ground Floor
		MFTC	10' Ceilings Main Floor
		SFTC	9' Ceilings Second Floor
Optional Layouts	Circle All that Apply	GFA2	GROUND FLOOR Optional Piece Bathroom
		MFA1	MAIN FLOOR Alternative Layout Kitchen/Family Room

25.7 The Carnegie			
Elevation	Circle One	A	3150.8 Square Feet
		B	3150.8 Square Feet
Taller Ceilings	Circle All that Apply	GFTC	9' Ceilings Ground Floor
		MFTC	10' Ceilings Main Floor
		SFTC	9' Ceilings Second Floor
Optional Layouts	Circle All that Apply	GFA2	GROUND FLOOR Optional Piece Bathroom
		MFA1	MAIN FLOOR Alternative Layout Kitchen/Family Room
		SFA1	SECOND FLOOR Shower in Lieu of Tub (Bedroom 2)

25.8 The Biltmore			
Elevation	Circle One	A	1980.8 Square Feet
		B	1989.3 Square Feet
Taller Ceilings	Circle All that Apply	GFTC	9' Ceilings Ground Floor
		MFTC	10' Ceilings Main Floor
		SFTC	9' Ceilings Second Floor
Optional Layouts	Circle All that Apply		

Elevation	Circle One		
Taller Ceilings	Circle All that Apply		
Optional Layouts	Circle All that Apply		

Elevation	Circle One		
Taller Ceilings	Circle All that Apply		
Optional Layouts	Circle All that Apply		

AUGUST 25 2016
LOT 42 R

NP

1/3