

Kleinburg Glen - 43L - 1 - 25-10 Elev.A WILTSHIRE OPT- GFA1 AND SFA5

ELECTRICAL

Inv.751	1 - FAMILY ROOM: 110V WALL RECEPTACLE ON NORMAL CIRCUIT - LOCATE APPROX. 66" A.F.F. above fireplace.
Line10129	Note:
16Aug16 / 9Nov16	
Inv.751	1 - KITCHEN: RELOCATE STANDARD FIXTURE - Move to approx. center above island. See plan for location.
Line10131	Note:
16Aug16 / 9Nov16	
Inv.751	1 - 200 AMP ELECTRICAL SERVICE
Line10132	Note:
16Aug16 / 9Nov16	
Inv.751	6 - KITCHEN: POT LIGHT: 4 INCH HALOGEN POT LIGHT - 440 WH - PRICED PER LIGHT - 10 OR MORE See plan for location.
Line10137	Note:
16Aug16 / 9Nov16	
Inv.751	1 - KITCHEN: Single pole switch for potlights
Line10138	Note:
16Aug16 / 9Nov16	
Inv.751	6 - FAMILY ROOM: POT LIGHT: 4 INCH HALOGEN POT LIGHT - 440 WH - PRICED PER LIGHT - 10 OR MORE See plan for location.
Line10139	Note:
16Aug16 / 9Nov16	
Inv.751	1 - FAMILY ROOM: Single pole switch for potlights.
Line10140	Note:
16Aug16 / 9Nov16	
Inv.751	1 - BASEMENT: Add an additional laundry in basement. Electrical, Plumbing, HVAC.
Line13637	Note:
16Aug16 / 9Nov16	

EXTERIOR COLOURS

Inv.751	1 - EXTERIOR COLOUR PACKAGE 4
Line13636	Note:
16Aug16 / 9Nov16	

FRAMING

Inv.751	1 - OPTIONAL GROUND FLOOR PLAN
Line13641	Note:
16Aug16 / 9Nov16	
Inv.751	1 - OPTIONAL 4TH BEDROOM
Line13642	Note:
16Aug16 / 9Nov16	

HVAC

Inv.751	1 - BASEMENT: Add an additional laundry in basement. Electrical, Plumbing, HVAC.
Line13638	Note:
16Aug16 / 9Nov16	

MISC.

Kleinburg Glen - 43L - 1 - 25-10 Elev.A WILTSHIRE OPT- GFA1 AND SEA5


Inv.751	1 - Purchaser has attended a Structural appointment at the Decor Centre & has DECLINED any additional upgrades and accepts and acknowledges that there will be no further structural changes/additions/deletions to be made upon signing on August 16, 2016.
Line10148	Note:
16Aug16 / 9Nov16	
Inv.751	1 - Purchasers are aware & accepts that ANY changes made to upgrades after signing this Purchasers Extra Form are subject to a minimum administration fee of \$500. PLUS a 10% holdback fee.
Line10149	Note:
16Aug16 / 9Nov16	
Inv.751	1 - BONUS PACKAGE: \$5,000.00 (INCLUDING TAXES) WORTH OF UPGRADES FROM GOLD PARK HOMES DÉCOR CENTRE IS BEING APPLIED TOWARD THE STRUCTURAL APPOINTMENT. PURCHASER HAS A REMAINING AMOUNT OF \$00 (INCLUDING TAXES) TO BE USED TOWARD THE COLOUR APPOINTMENT.
Line10150	Note:
16Aug16 / 9Nov16	
Inv.751	1 - DELETED ITEMS SEE CREDIT PE 773
Line13643	Note:
16Aug16 / 9Nov16	

PLUMBING

Inv.751	1 - BASEMENT: Add an additional laundry in basement. Electrical, Plumbing, HVAC.
Line10143	Note:
16Aug16 / 9Nov16	
Inv.751	1 - KITCHEN: ROUGH - IN - WATERLINE FOR FRIDGE
Line10147	Note:
16Aug16 / 9Nov16	

Elevation A • 2,187 sq.ft.



Elevation B • 2,187 sq.ft.

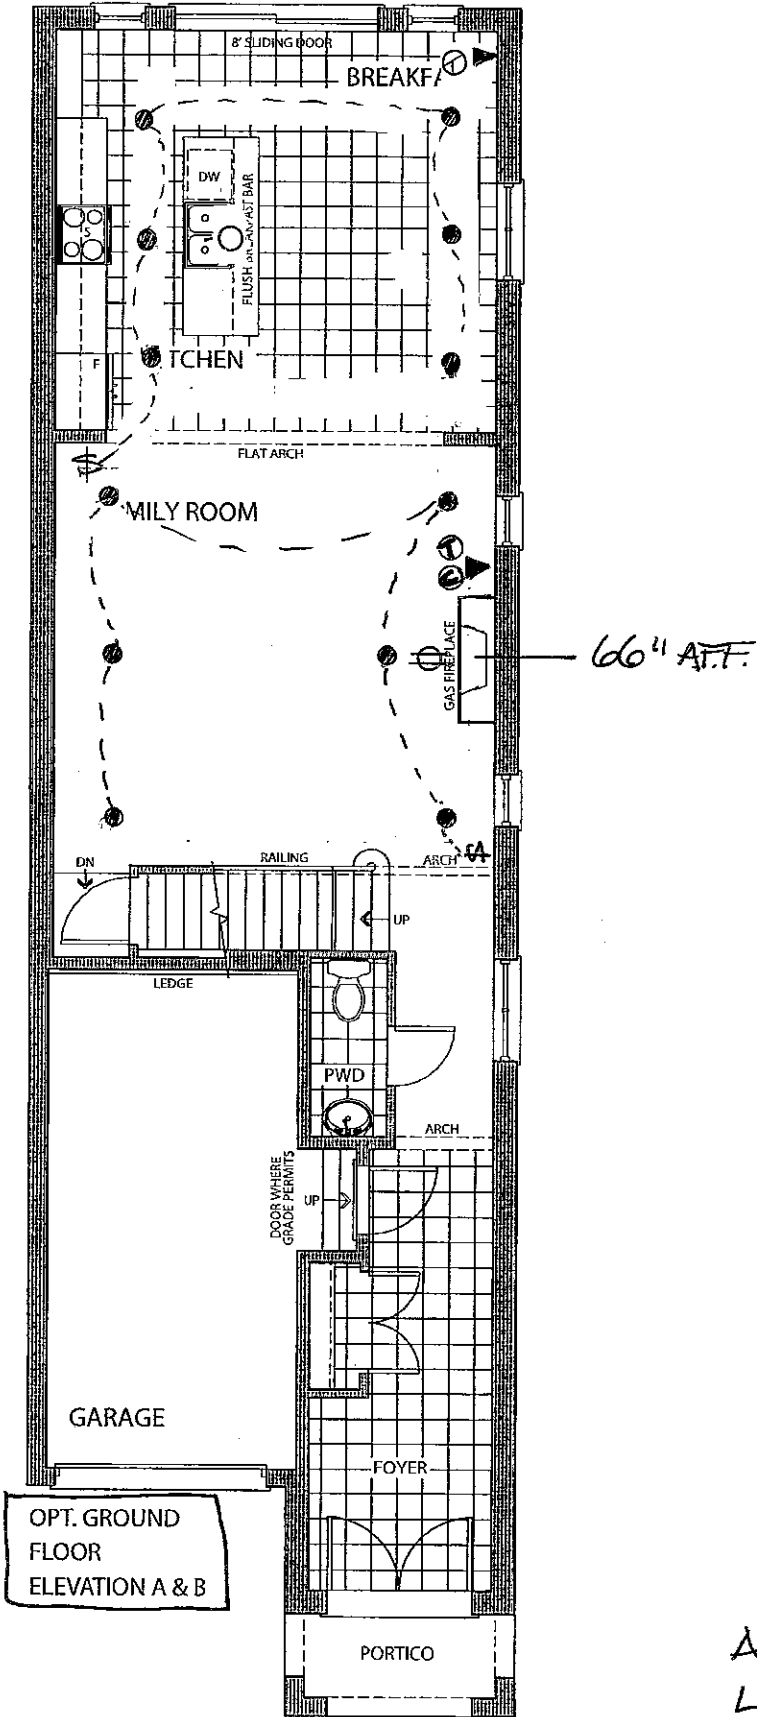

Aug. 16 2016
LOT 43L

24



Elevation A • 2,187 sq.ft.
Elevation B • 2,187 sq.ft.

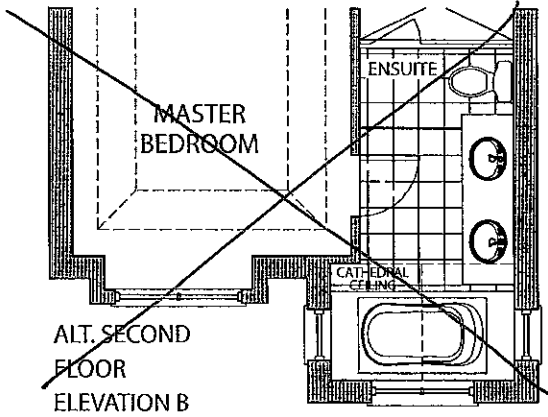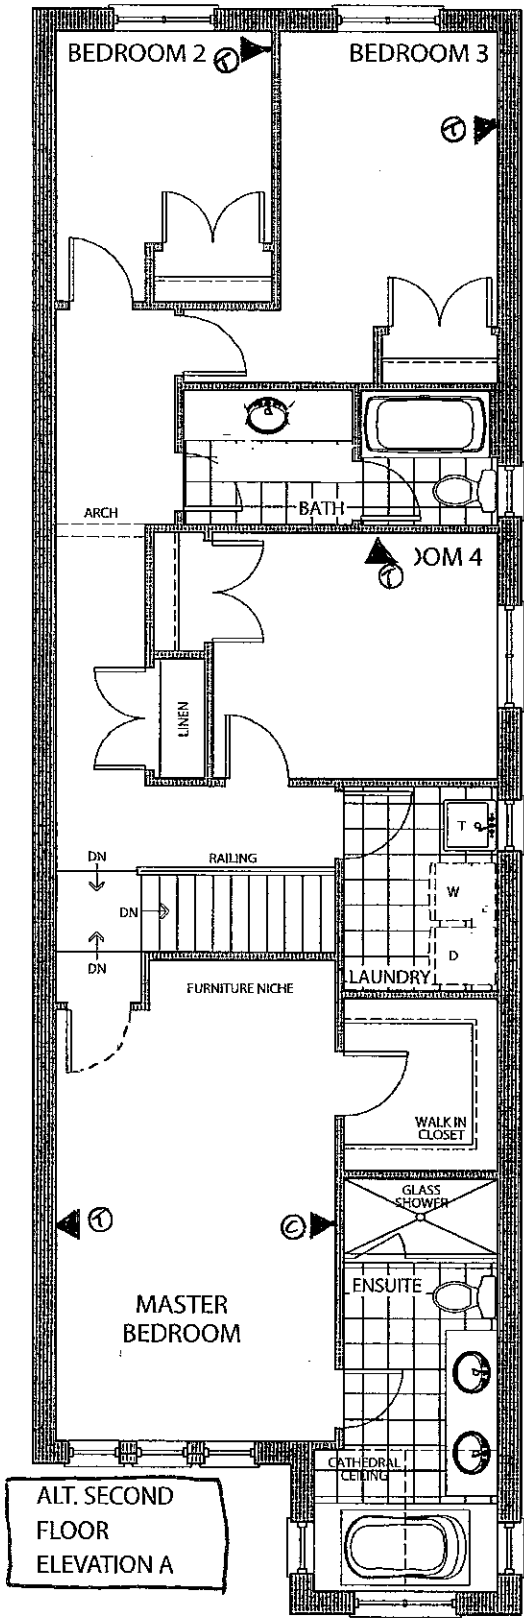

AUG. 16 2016
LOT 43L

20

Elevation A • 2,187 sq.ft.
Elevation B • 2,187 sq.ft.

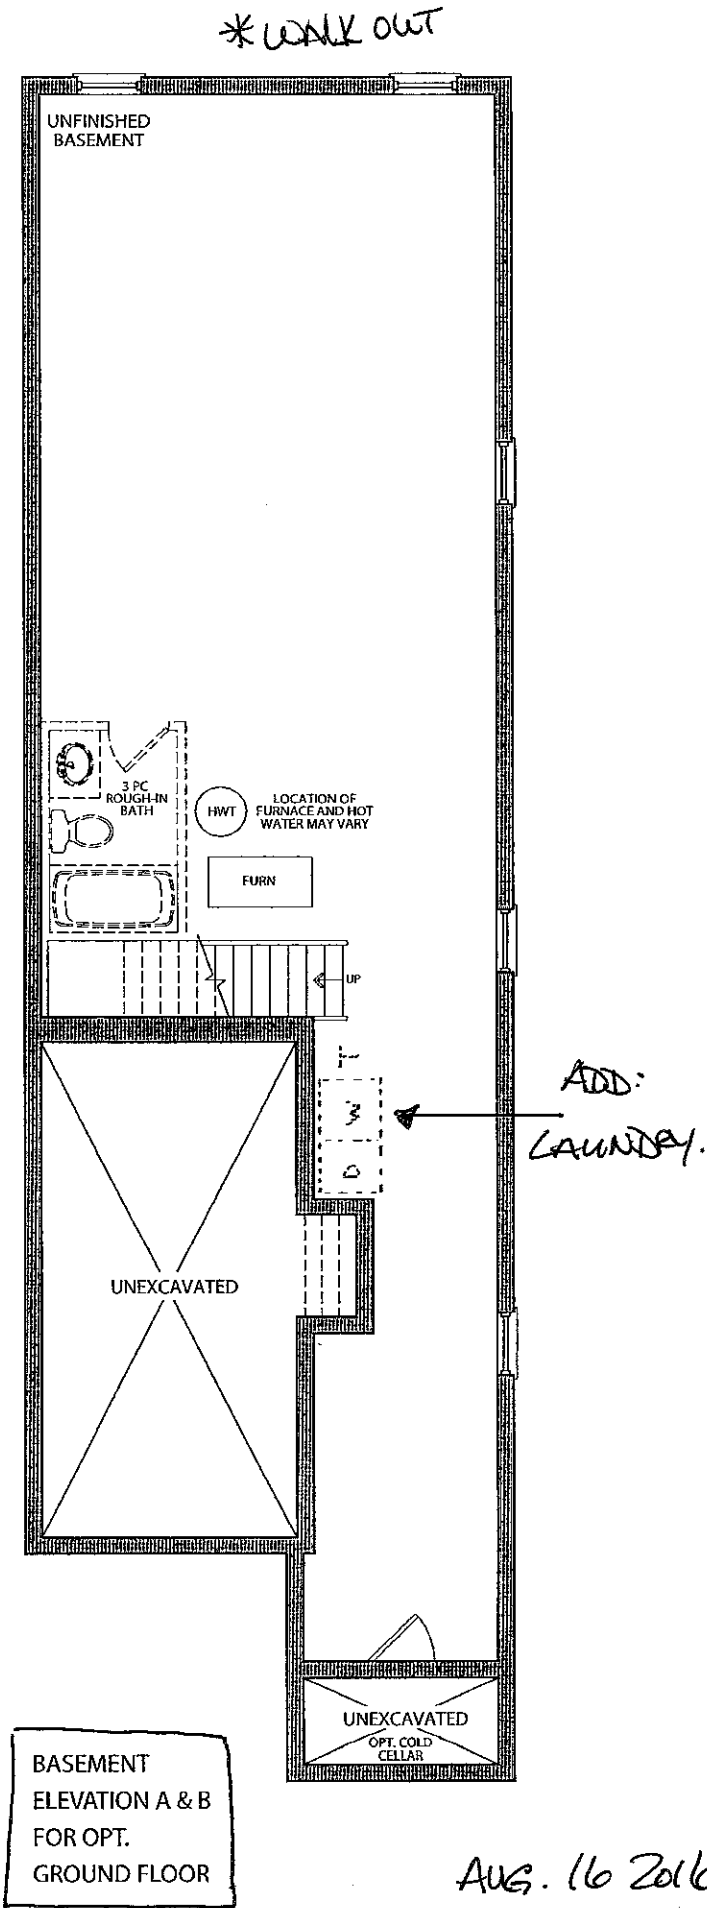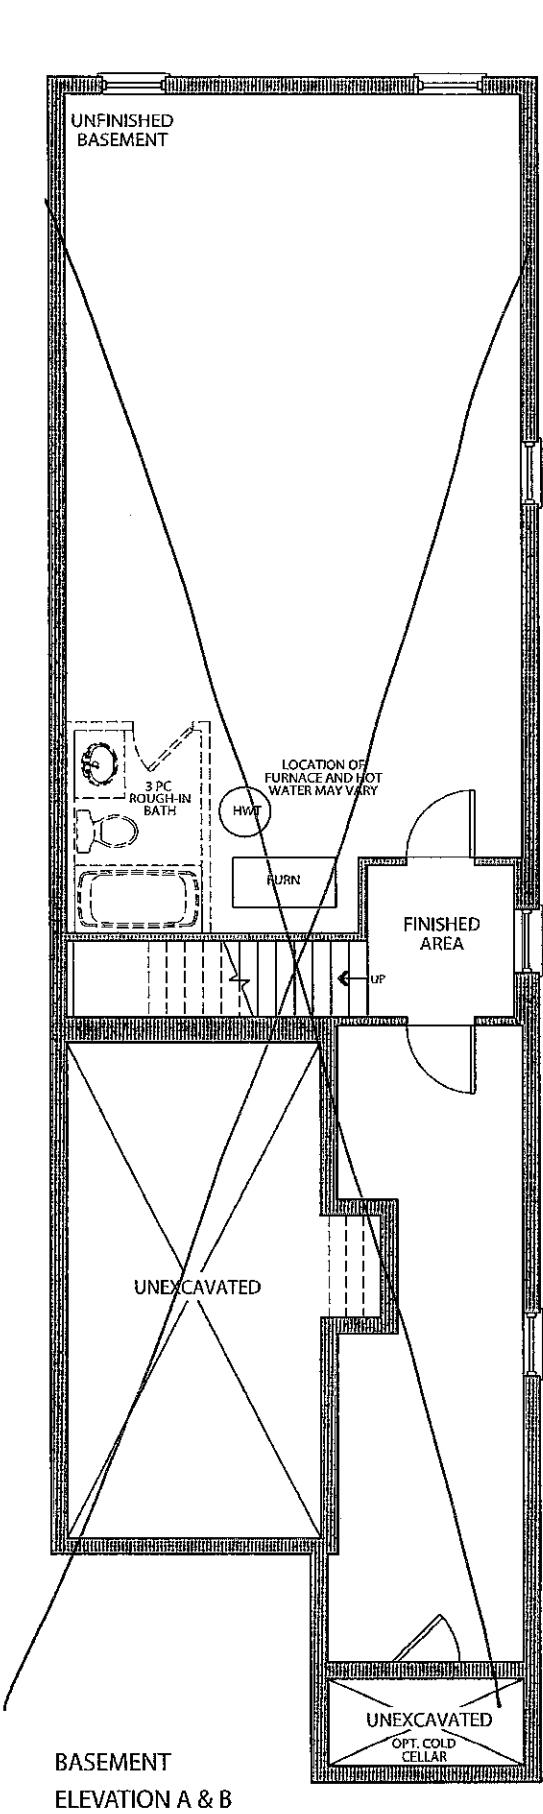

AUG. 16 2016
LOT 43L

24



Stacey Carlete
Project Coordinator



Claude Azzopardi
Contracts Manager



Nancy Martini
Corporate Controller



25.1 The Riverstone			
Elevation	Circle One	A	1812.7 Square Feet
		B	1812.7 Square Feet
Taller Ceilings	Circle All that Apply	GFTC	9' Ceilings Ground Floor
		MFTC	10' Ceilings Main Floor
		SFTC	9' Ceilings Second Floor
Optional Layouts	Circle All that Apply	GFA1	GROUND FLOOR Alternative Layout Kitchen/Family Room

25.2 The Hudson			
Elevation	Circle One	A	1860.8 Square Feet
		B	1858.6 Square Feet
Taller Ceilings	Circle All that Apply	GFTC	9' Ceilings Ground Floor
		MFTC	10' Ceilings Main Floor
		SFTC	9' Ceilings Second Floor
Optional Layouts	Circle All that Apply	GFA1	GROUND FLOOR Alternative Layout Kitchen/Family Room

25.3 The Oakmount			
Elevation	Circle One	A	2013.0 Square Feet
		B	2013.0 Square Feet
Taller Ceilings	Circle All that Apply	GFTC	9' Ceilings Ground Floor
		MFTC	10' Ceilings Main Floor
		SFTC	9' Ceilings Second Floor
Optional Layouts	Circle All that Apply	GFA1	GROUND FLOOR Alternative Layout Kitchen/Family Room
		SFA4	SECOND FLOOR Alternative Layout Laundry Room
		SFA5	SECOND FLOOR Additional Bedroom

25.4 The Stanford			
Elevation	Circle One	A	2665.6 Square Feet
		B	2665.6 Square Feet
Taller Ceilings	Circle All that Apply	GFTC	9' Ceilings Ground Floor
		MFTC	10' Ceilings Main Floor
		SFTC	9' Ceilings Second Floor
Optional Layouts	Circle All that Apply	GFA2	GROUND FLOOR Optional Piece Bathroom
		MFA1	MAIN FLOOR Alternative Layout Kitchen/Family Room
		SFA2	SECOND FLOOR Shower in Lieu of Tub (Master Ens.)
		SFA5	SECOND FLOOR Additional Bedroom

25.5 The Regency			
Elevation	Circle One	A	2924.0 Square Feet
		B	2924.0 Square Feet
Taller Ceilings	Circle All that Apply	GFTC	9' Ceilings Ground Floor
		MFTC	10' Ceilings Main Floor
		SFTC	9' Ceilings Second Floor
Optional Layouts	Circle All that Apply	GFA2	GROUND FLOOR Optional Piece Bathroom
		MFA1	MAIN FLOOR Alternative Layout Kitchen/Family Room
		SFA2	SECOND FLOOR Shower in Lieu of Tub (Master Ens.)
		SFA5	SECOND FLOOR Additional Bedroom

25.6 The Lincoln			
Elevation	Circle One	A	3021.0 Square Feet
		B	3014.0 Square Feet
Taller Ceilings	Circle All that Apply	GFTC	9' Ceilings Ground Floor
		MFTC	10' Ceilings Main Floor
		SFTC	9' Ceilings Second Floor
Optional Layouts	Circle All that Apply	GFA2	GROUND FLOOR Optional Piece Bathroom
		MFA1	MAIN FLOOR Alternative Layout Kitchen/Family Room

25.7 The Carnegie			
Elevation	Circle One	A	3150.8 Square Feet
		B	3150.8 Square Feet
Taller Ceilings	Circle All that Apply	GFTC	9' Ceilings Ground Floor
		MFTC	10' Ceilings Main Floor
		SFTC	9' Ceilings Second Floor
Optional Layouts	Circle All that Apply	GFA2	GROUND FLOOR Optional Piece Bathroom
		MFA1	MAIN FLOOR Alternative Layout Kitchen/Family Room
		SFA1	SECOND FLOOR Shower in Lieu of Tub (Bedroom 2)

25.8 The Biltmore			
Elevation	Circle One	A	1980.8 Square Feet
		B	1989.3 Square Feet
Taller Ceilings	Circle All that Apply	GFTC	9' Ceilings Ground Floor
		MFTC	10' Ceilings Main Floor
		SFTC	9' Ceilings Second Floor
Optional Layouts	Circle All that Apply		

25-10 Wiltshire			
Elevation	Circle One	(A)	2187
Taller Ceilings	Circle All that Apply		
Optional Layouts	Circle All that Apply		

Elevation	Circle One		
Taller Ceilings	Circle All that Apply		
Optional Layouts	Circle All that Apply		

* WALK-OUT BASEMENT.

AUGUST 16 2016.
LOT 43L

24