

Kleinburg Glen - 43R - 1 - 25-10 Elev.B WILTSHIRE

CENTRAL VAC AND WIRING

Inv.652	1 - FAMILY ROOM: CONDUIT PIPE - FOR TELEVISION - Locate above fireplace, approx. 66" A.F.F.. See plan for location.
Line8290	Note:
12Jul16 / 14Nov16	
Inv.652	1 - CONDUIT PIPE - FROM ATTIC TO ELECTRICAL PANEL - Locate approx. center of attic.
Line8301	Note:
12Jul16 / 14Nov16	
Inv.652	1 - BEDROOM 3: CAT 6 WIRING - UPGRADE AN OUTLET TO CAT 6 - See plan for location.
Line10842	Note:
12Jul16 / 14Nov16	

CERAMIC

Inv.652	1 - THRU OUT: *DELETE* ALL ACCESSORIES AND MIRRORS
Line8321	Note:
12Jul16 / 14Nov16	

ELECTRICAL

Inv.652	1 - FAMILY ROOM: 110V WALL RECEPTACLE ON NORMAL CIRCUIT - Locate approx. 66" A.F.F. for future tv above fireplace.
Line8291	Note:
12Jul16 / 14Nov16	
Inv.652	1 - KITCHEN CABINET STRIP VALANCE LIGHTS (UNDER CABINETS) - ROUGH - IN - DOES NOT INCLUDE (AND REQUIRES) KITCHEN UPGRADE PRICING
Line8303	Note:
12Jul16 / 14Nov16	
Inv.652	1 - KITCHEN: RELOCATE STANDARD FIXTURE - Move to above island, approx. 18" from ceiling arch. See plan for location.
Line8308	Note:
12Jul16 / 14Nov16	
Inv.652	1 - KITCHEN: 110V WALL RECEPTACLE ON DEDICATED CIRCUIT - FOR MICROWAVE - MICROWAVE NOT INCLUDED. See plan for location.
Line8309	Note:
12Jul16 / 14Nov16	
Inv.652	1 - KITCHEN: 110V WALL RECEPTACLE ON DEDICATED CIRCUIT - For future 600+ cfm hood fan.
Line8310	Note:
12Jul16 / 14Nov16	
Inv.652	1 - UPPER HALL: *REQUEST* Standard light above stairs to be centered above stairs, if possible. See plan for location.
Line8320	Note:
12Jul16 / 14Nov16	
Inv.652	2 - MASTER ENSUITE: ROUGH - IN WALL OUTLET ON SAME SWITCH - DOES NOT INCLUDE FIXTURE - In addition to standard vanity light, install 2 rough-in vanity lights on same switch - at same height as standard. See plan for location.
Line8313	Note:
12Jul16 / 14Nov16	
Inv.652	1 - BASEMENT: Rough-in for future laundry room in basement. See plan for *preferred* location.
Line10840	Note:
12Jul16 / 14Nov16	

Kleinburg Glen - 43R - 1 - 25-10 Elev.B WILTSHIRE

Inv.652	1 - KITCHEN: delete peninsula, install small island - approx. 60" in length to accomodate sink and dishwasher. *NOTE: homeowner acknowledges may result in limited space between fridge/island & island may encroach into family room. See plan for location.
Line13793	Note:
12Jul16 / 14Nov16	

FORMING

Inv.652	1 - BASEMENT ADDITIONAL 1 FT TO CEILING-INCLUDES 10" FOUNDATION WALL AND 30" X 14" BASEMENT WINDOWS
Line9179	Note:
12Jul16 / 14Nov16	

FRAMING

Inv.652	7 - MAIN FLOOR: FRAME MAIN FLOOR DOORS & ARCHES AT 96 INCH
Line8304	Note:
12Jul16 / 14Nov16	

GLASS AND MIRROR

Inv.652	1 - THRU OUT: *DELETE* ALL ACCESSORIES AND MIRRORS
Line13789	Note:
12Jul16 / 14Nov16	

HVAC

Inv.652	1 - BASEMENT: Rough-in for future laundry room in basement. See plan for *preferred* location.
Line13791	Note:
12Jul16 / 14Nov16	

INTERIOR TRIM AND DOORS

Inv.652	4 - MAIN FLOOR: EXTENDED HEIGHT ARCHWAY (PRICE PER DOORWAY) - INCREASE TO 96"
Line8305	Note:
12Jul16 / 14Nov16	
Inv.652	3 - MAIN FLOOR: STANDARD DOOR EXTENDED HEIGHT 96 INCH (PRICE PER DOOR) - GROUND FLOOR 2 STOREY MODELS
Line8306	Note:
12Jul16 / 14Nov16	

KITCHEN AND BATH CABINETRY

Inv.652	1 - KITCHEN: delete peninsula, install small island - approx. 60" in length to accomodate sink and dishwasher. *NOTE: homeowner acknowledges may result in limited space between fridge/island & island may encroach into family room. See plan for location.
Line8394	Note:
12Jul16 / 14Nov16	

MISC.

Inv.652	1 - Purchasers are aware & accepts that ANY changes made to upgrades after signing this Purchasers Extra Form are subject to a minimum administration fee of \$500. PLUS a 10% holdback fee.
Line10849	Note:
12Jul16 / 14Nov16	
Inv.652	1 - *DELETE* 4 BEDROOM PLAN - **BUILD 3 BEDROOM PLAN**
Line10847	Note:
12Jul16 / 14Nov16	

Kleinburg Glen - 43R - 1 - 25-10 Elev.B WILTSHIRE

Inv.652	1 - Purchaser has attended a Structural appointment at the Decor Centre & has DECLINED any additional upgrades and accepts and acknowledges that there will be no further structural changes/additions/deletions to be made upon signing on September 1, 2016
Line10848	Note:
12Jul16 / 14Nov16	
Inv.652	1 - BONUS PACKAGE: \$5,000.00 (INCLUDING TAXES) WORTH OF UPGRADES FROM GOLD PARK HOMES DÉCOR CENTRE IS BEING APPLIED TOWARD THE STRUCTURAL APPOINTMENT. PURCHASER HAS A REMAINING AMOUNT OF \$00 (INCLUDING TAXES) TO BE USED TOWARD THE COLOUR APPOINTMENT.
Line10850	Note:
12Jul16 / 14Nov16	

PLUMBING

Inv.652	1 - BASEMENT: Rough-in for future laundry room in basement. See plan for *preferred* location.
Line13790	Note:
12Jul16 / 14Nov16	
Inv.652	1 - KITCHEN: delete peninsula, install small island - approx. 60" in length to accomodate sink and dishwasher. *NOTE: homeowner acknowledges may result in limited space between fridge/island & island may encroach into family room. See plan for location.
Line13792	Note:
12Jul16 / 14Nov16	

WINDOWS - BASEMENT

Inv.652	3 - 3X- 30" X 14" BASEMENT WINDOWS FOR TALLER BASEMENT PACKAGE WOB CONDITION FOR REAR WINDOWS
Line13788	Note:
12Jul16 / 14Nov16	

WINDOWS AND DOORS

Inv.652	1 - HOUSE/GARAGE DOOR: Increase door to 96"
Line8834	Note:
12Jul16 / 14Nov16	

Elevation A • 2,187 sq.ft.

✓ Elevation B • 2,187 sq.ft.

43R

SEPT 1 2016

AB AB

STD
CEILING
LIGHT

8" DUCT
+
DED. ELET.

MICRO
SHELF

○ STD LIGHT

⊕ ELEC. OUTLET

⊖ WALL SOURCE


⊗ 96" ARCH.

▲ ⑦ PHONE

▲ ⑧ CABLE

▲ ⑨ CAT 6.

* CONDUIT

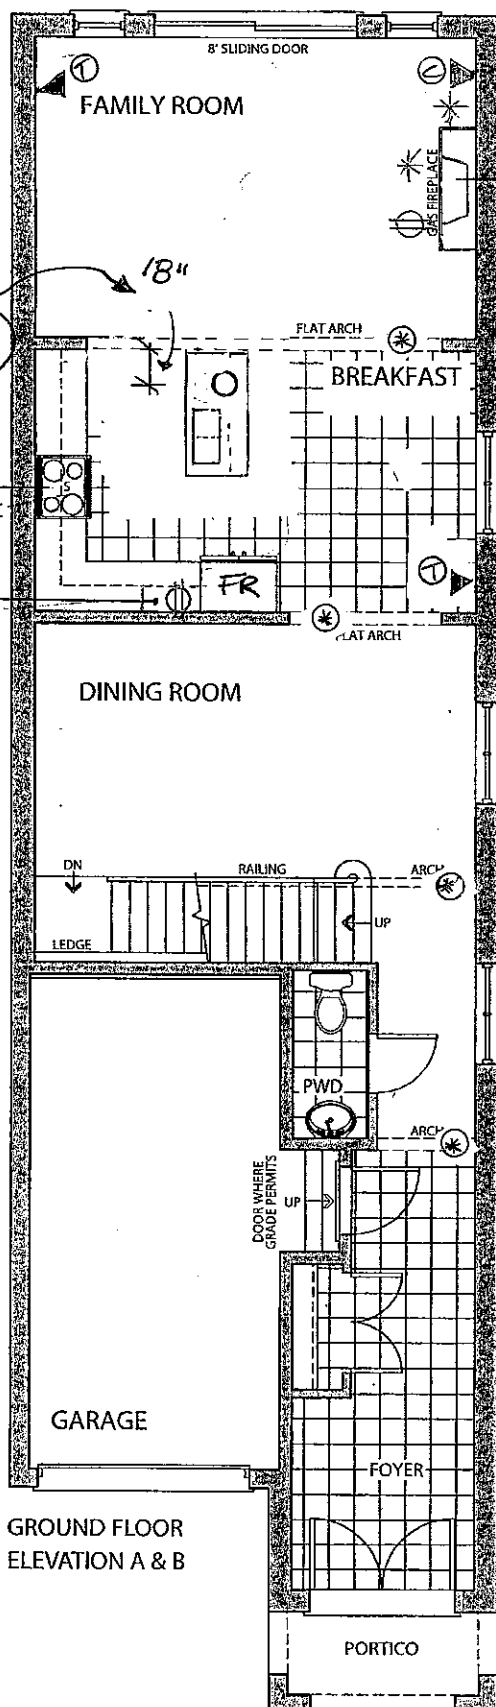



GROUND FLOOR
ELEVATION A & B

Elevation A • ~~2,187~~ sq.ft.

✓ Elevation B • 2,187 sq.ft.

43 R
SEPT 1 2016
AD AGG


CENTER
STD LIGHT
ABOVE STAIRS

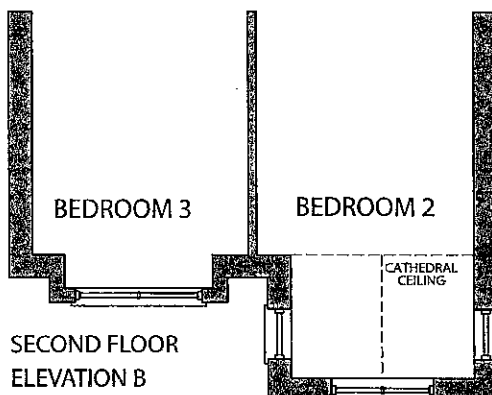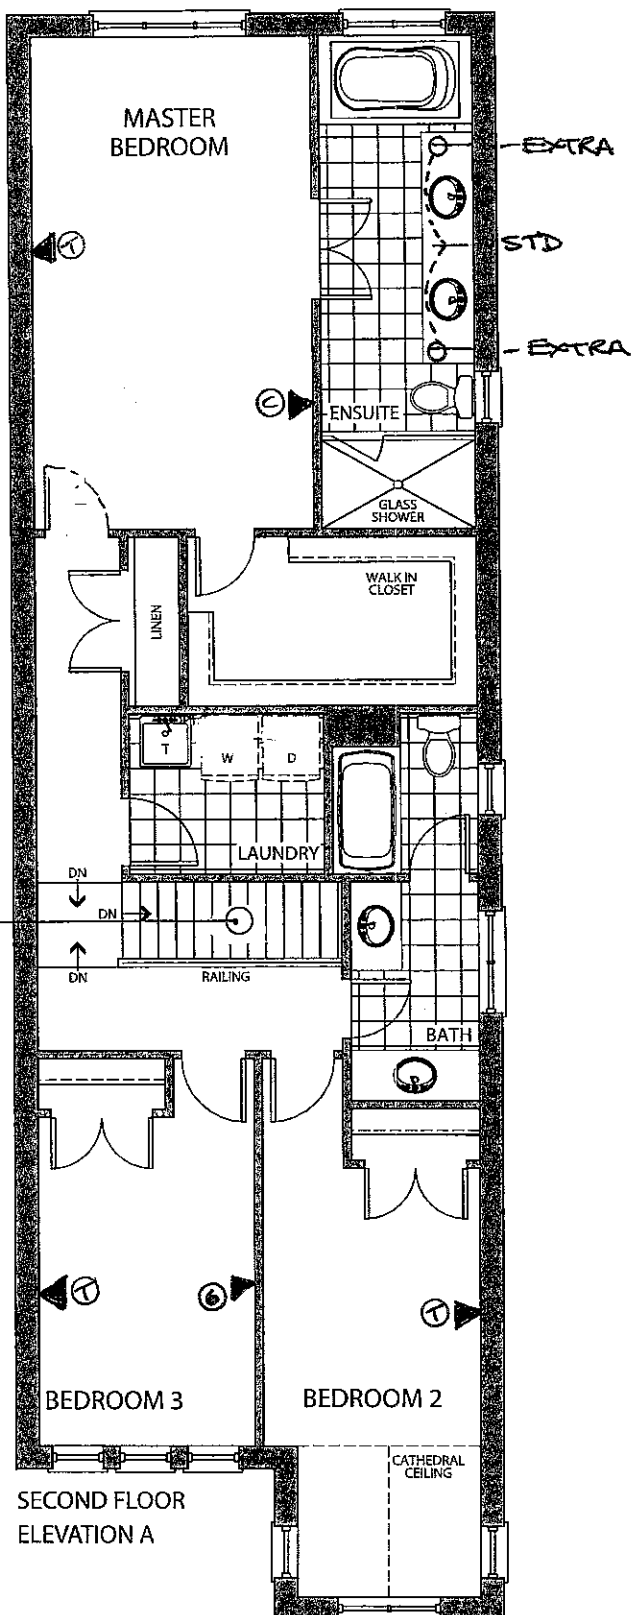


AB 43R
SEPT. 1 2016

the Wiltshire

Elevation A • 2,187 sq.ft.
Elevation B • 2,187 sq.ft.

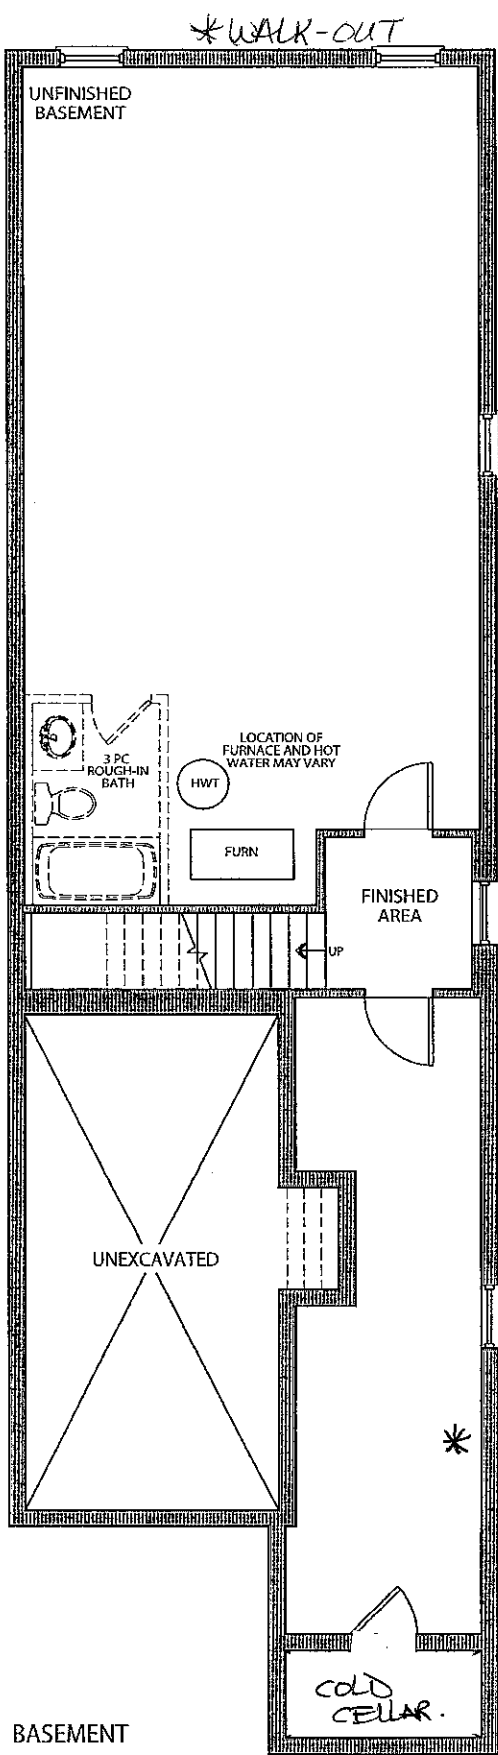


BASEMENT
ELEVATION A & B

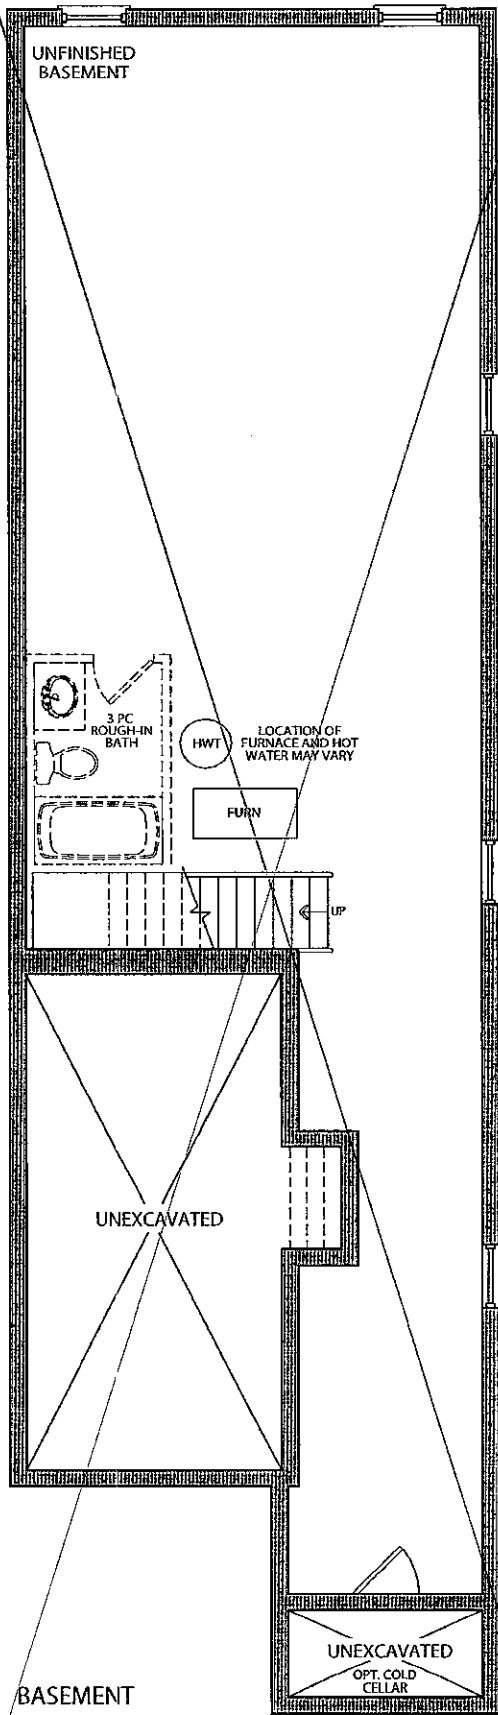

BASEMENT
ELEVATION A & B
FOR OPT.
GROUND FLOOR

PREFERRED
* LAUNDRY
LOCATION

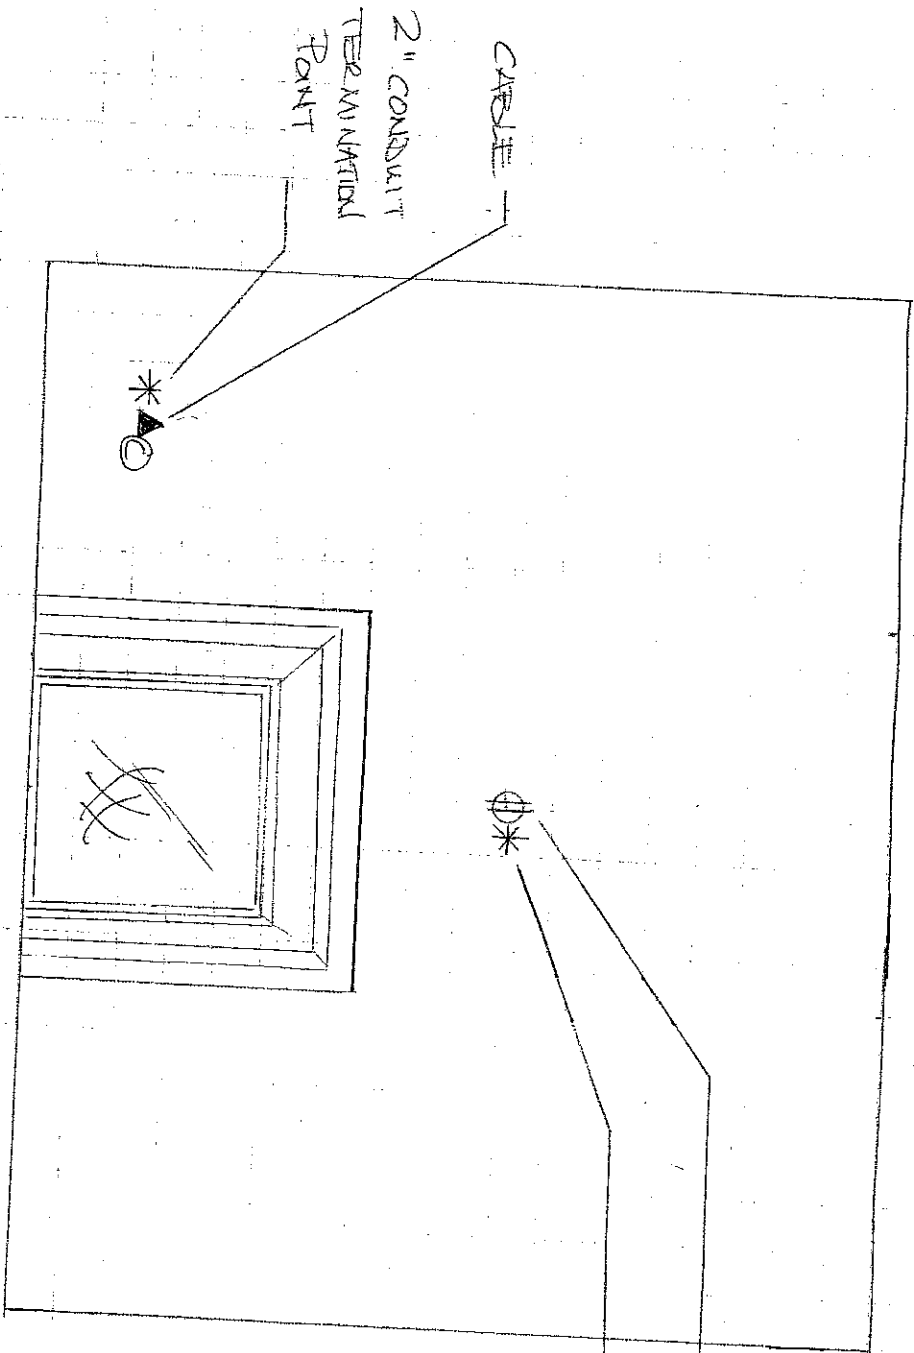

2" CONDUIT
TERMINATION
POINT

CABLE

⊕*

ELECTRICAL (FUTURE TV)

2" CONDUIT (ABOVE FIREPLACE
to LEFT of FIREPLACE
by CABLE)

60" AFF
APPROX

LOT 43-R
FAMILY ROOM - FIREPLACE ELEV.

SEPT 1 2016



Stacey Carlete
Project Coordinator



Claude Azzopardi
Contracts Manager



Nancy Martini
Corporate Controller



25.1 The Riverstone			
Elevation	Circle One	A	1812.7 Square Feet
		B	1812.7 Square Feet
Taller Ceilings	Circle All that Apply	GFTC	9' Ceilings Ground Floor
		MFTC	10' Ceilings Main Floor
		SFTC	9' Ceilings Second Floor
Optional Layouts	Circle All that Apply	GFA1	GROUND FLOOR Alternative Layout Kitchen/Family Room

25.2 The Hudson			
Elevation	Circle One	A	1860.8 Square Feet
		B	1858.6 Square Feet
Taller Ceilings	Circle All that Apply	GFTC	9' Ceilings Ground Floor
		MFTC	10' Ceilings Main Floor
		SFTC	9' Ceilings Second Floor
Optional Layouts	Circle All that Apply	GFA1	GROUND FLOOR Alternative Layout Kitchen/Family Room

25.3 The Oakmount			
Elevation	Circle One	A	2013.0 Square Feet
		B	2013.0 Square Feet
Taller Ceilings	Circle All that Apply	GFTC	9' Ceilings Ground Floor
		MFTC	10' Ceilings Main Floor
		SFTC	9' Ceilings Second Floor
Optional Layouts	Circle All that Apply	GFA1	GROUND FLOOR Alternative Layout Kitchen/Family Room
		SFA4	SECOND FLOOR Alternative Layout Laundry Room
		SFA5	SECOND FLOOR Additional Bedroom

25.4 The Stanford			
Elevation	Circle One	A	2665.6 Square Feet
		B	2665.6 Square Feet
Taller Ceilings	Circle All that Apply	GFTC	9' Ceilings Ground Floor
		MFTC	10' Ceilings Main Floor
		SFTC	9' Ceilings Second Floor
Optional Layouts	Circle All that Apply	GFA2	GROUND FLOOR Optional Piece Bathroom
		MFA1	MAIN FLOOR Alternative Layout Kitchen/Family Room
		SFA2	SECOND FLOOR Shower in Lieu of Tub (Master Ens.)
		SFA5	SECOND FLOOR Additional Bedroom

25.5 The Regency			
Elevation	Circle One	A	2924.0 Square Feet
		B	2924.0 Square Feet
Taller Ceilings	Circle All that Apply	GFTC	9' Ceilings Ground Floor
		MFTC	10' Ceilings Main Floor
		SFTC	9' Ceilings Second Floor
Optional Layouts	Circle All that Apply	GFA2	GROUND FLOOR Optional Piece Bathroom
		MFA1	MAIN FLOOR Alternative Layout Kitchen/Family Room
		SFA2	SECOND FLOOR Shower in Lieu of Tub (Master Ens.)
		SFA5	SECOND FLOOR Additional Bedroom

25.6 The Lincoln			
Elevation	Circle One	A	3021.0 Square Feet
		B	3014.0 Square Feet
Taller Ceilings	Circle All that Apply	GFTC	9' Ceilings Ground Floor
		MFTC	10' Ceilings Main Floor
		SFTC	9' Ceilings Second Floor
Optional Layouts	Circle All that Apply	GFA2	GROUND FLOOR Optional Piece Bathroom
		MFA1	MAIN FLOOR Alternative Layout Kitchen/Family Room

25.7 The Carnegie			
Elevation	Circle One	A	3150.8 Square Feet
		B	3150.8 Square Feet
Taller Ceilings	Circle All that Apply	GFTC	9' Ceilings Ground Floor
		MFTC	10' Ceilings Main Floor
		SFTC	9' Ceilings Second Floor
Optional Layouts	Circle All that Apply	GFA2	GROUND FLOOR Optional Piece Bathroom
		MFA1	MAIN FLOOR Alternative Layout Kitchen/Family Room
		SFA1	SECOND FLOOR Shower in Lieu of Tub (Bedroom 2)

25.8 The Biltmore			
Elevation	Circle One	A	1980.8 Square Feet
		B	1989.3 Square Feet
Taller Ceilings	Circle All that Apply	GFTC	9' Ceilings Ground Floor
		MFTC	10' Ceilings Main Floor
		SFTC	9' Ceilings Second Floor
Optional Layouts	Circle All that Apply		

Elevation	Circle One		
Taller Ceilings	Circle All that Apply		
Optional Layouts	Circle All that Apply		

25-10 Wiltshire			
Elevation	Circle One	ⓑ	
Taller Ceilings	Circle All that Apply	✓	BASEMENT
Optional Layouts	Circle All that Apply		

LOT 43-R
SEPT 1 2016

AR AGG

* WALK-OUT Basement