

Kleinburg Glen - 45R - 1 - 25-10 Elev.B WILTSHIRE OPT- GFA1
CENTRAL VAC AND WIRING

Inv.608	1 - FAMILY ROOM: CONDUIT PIPE - FOR TELEVISION - Locate approx. 60" A.F.F. above fireplace terminating at cable location, right of fireplace. See plan for location.
Line7489	Note:
27Jun16 / 11Nov16	

ELECTRICAL

Inv.608	1 - FAMILY ROOM: Install a 110V WALL RECEPTACLE ON NORMAL CIRCUIT - for future TV above fireplace. Locate approx. 60" A.F.F.-See plan for location
Line7490	Note:
27Jun16 / 11Nov16	

Inv.608	4 - FAMILY ROOM: POT LIGHT: 4 INCH HALOGEN POT LIGHT - 440 WH - PRICED PER LIGHT - 10 OR MORE - Locate in corners of room approx. 30" from each wall, see plan for location
Line7491	Note:
27Jun16 / 11Nov16	

Inv.608	1 - FAMILY ROOM: Install a single pole switch for potlights. See plan for location.
Line7492	Note:
27Jun16 / 11Nov16	

Inv.608	1 - KITCHEN: Install a 110V WALL RECEPTACLE ON DEDICATED CIRCUIT - FOR MICROWAVE - MICROWAVE NOT INCLUDED. See plan for location. Cabinetry customization to be priced at colour appointment.
Line7493	Note:
27Jun16 / 11Nov16	

Inv.608	1 - KITCHEN: RELOCATE STANDARD FIXTURE - TO ABOVE ISLAND. See plan for location.
Line7494	Note:
27Jun16 / 11Nov16	

Inv.608	1 - KITCHEN: Install an ADDITIONAL STANDARD FIXTURE ON SAME SWITCH, total 2 standard fixtures above island - to be centered above island. See plan for location.
Line7495	Note:
27Jun16 / 11Nov16	

Inv.608	6 - KITCHEN: POT LIGHT: 4 INCH HALOGEN POT LIGHT - 440 WH - PRICED PER LIGHT - 10 OR MORE. See plan for location.
Line7496	Note:
27Jun16 / 11Nov16	

Inv.608	1 - KITCHEN: Install a single pole switch for potlights. See plan for location.
Line7497	Note:
27Jun16 / 11Nov16	

EXTERIOR COLOURS

Inv.608	1 - EXTERIOR COLOUR PACKAGE 11
Line13759	Note:
27Jun16 / 11Nov16	

FRAMING

Inv.608	3 - MAIN FLOOR: FRAME MAIN FLOOR ARCHWAYS AT 96 INCH
Line7503	Note:
27Jun16 / 11Nov16	

Inv.608	1 - MANDOOR - GARAGE TO HOUSE - AS PER PLAN AND GRADE PERMITING
Line13760	Note: AS PER APS
27Jun16 / 11Nov16	

Kleinburg Glen - 45R - 1 - 25-10 Elev.B WILTSHIRE OPT- GFA1

INTERIOR TRIM AND DOORS

Inv.608	3 - MAIN FLOOR: EXTENDED HEIGHT ARCHWAY (PRICE PER DOORWAY) - Archways to be 8'-0"
Line7507	Note:
27Jun16 / 11Nov16	

MISC.

Inv.608	1 - Purchasers are aware & accepts that ANY changes made to upgrades after signing this Purchasers Extra Form are subject to a minimum administration fee of \$500. PLUS a 10% holdback fee.
Line9066	Note:
27Jun16 / 11Nov16	

Inv.608	1 - Purchaser has attended a Structural appointment at the Decor Centre & has DECLINED any additional upgrades and accepts and acknowledges that there will be no further structural changes/additions/deletions to be made upon signing on June 27, 2016.
Line9065	Note:
27Jun16 / 11Nov16	

Inv.608	1 - BONUS PACKAGE: \$5,000.00 (INCLUDING TAXES) WORTH OF UPGRADES FROM GOLD PARK HOMES DÉCOR CENTRE IS BEING APPLIED TOWARD THE STRUCTURAL APPOINTMENT. PURCHASER HAS A REMAINING AMOUNT OF \$677.75 (INCLUDING TAXES) TO BE USED TOWARD THE COLOUR APPOINTMENT.
Line9067	Note:
27Jun16 / 11Nov16	

WINDOWS AND DOORS

Inv.608	1 - MAN DOOR GARAGE TO HOUSE - OPTIONAL - IF GRADE PERMITS
Line13761	Note: AS PER APS
27Jun16 / 11Nov16	

Elevation A • 2,187 sq.ft.

✓ Elevation B • 2,187 sq.ft.

LOT 45R
JULY 27 2016



MICRO - SELF

30" AFF
ARCH

LEGEND

○ MOVE STD CEILING LIGHT

⊕ ADDITIONAL LIGHT

● POTLIGHT

\$ SINGLE POLE SWITCH


* CONDUIT FOR TV

⊕ ELECT. OUTLET

▲ ① PHONE

▲ ② CABLE

60" AFF - ELECTRICAL
+
CONDUIT.


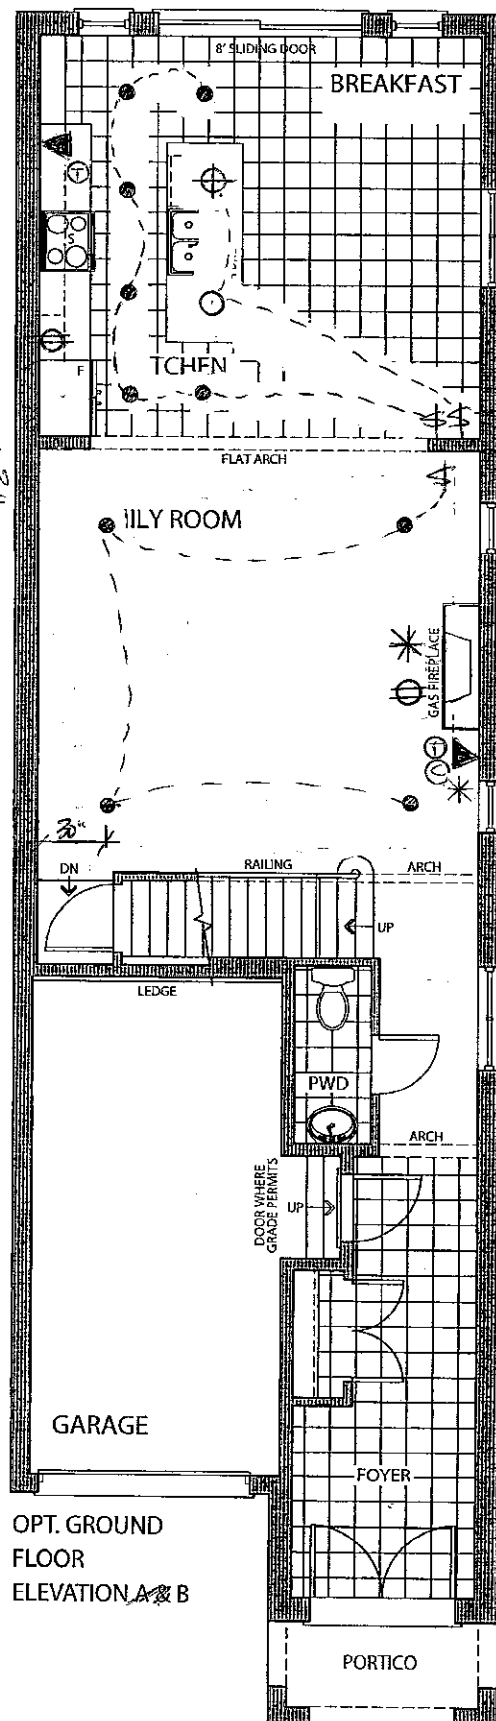


Elevation A • ~~2,187~~ sq.ft.

✓ Elevation B • ~~2,187~~ sq.ft.

LOT 45R


JULY 27 2016

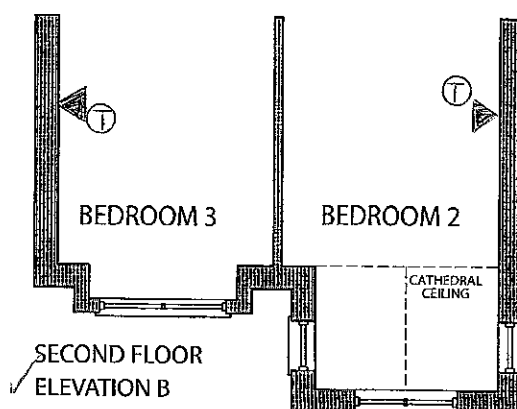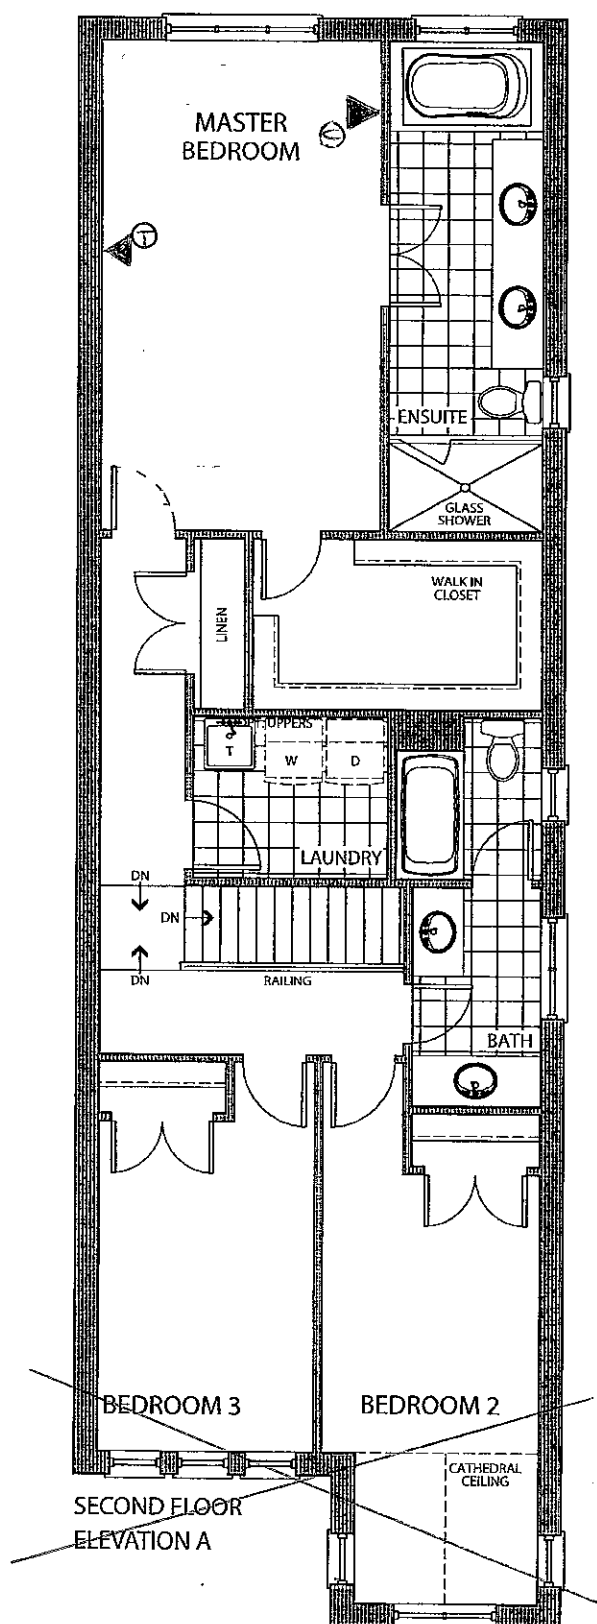


LOT 45R
July 27 2016

the Wiltshire

Elevation A • 2,187 sq.ft.
✓ Elevation B • 2,187 sq.ft.

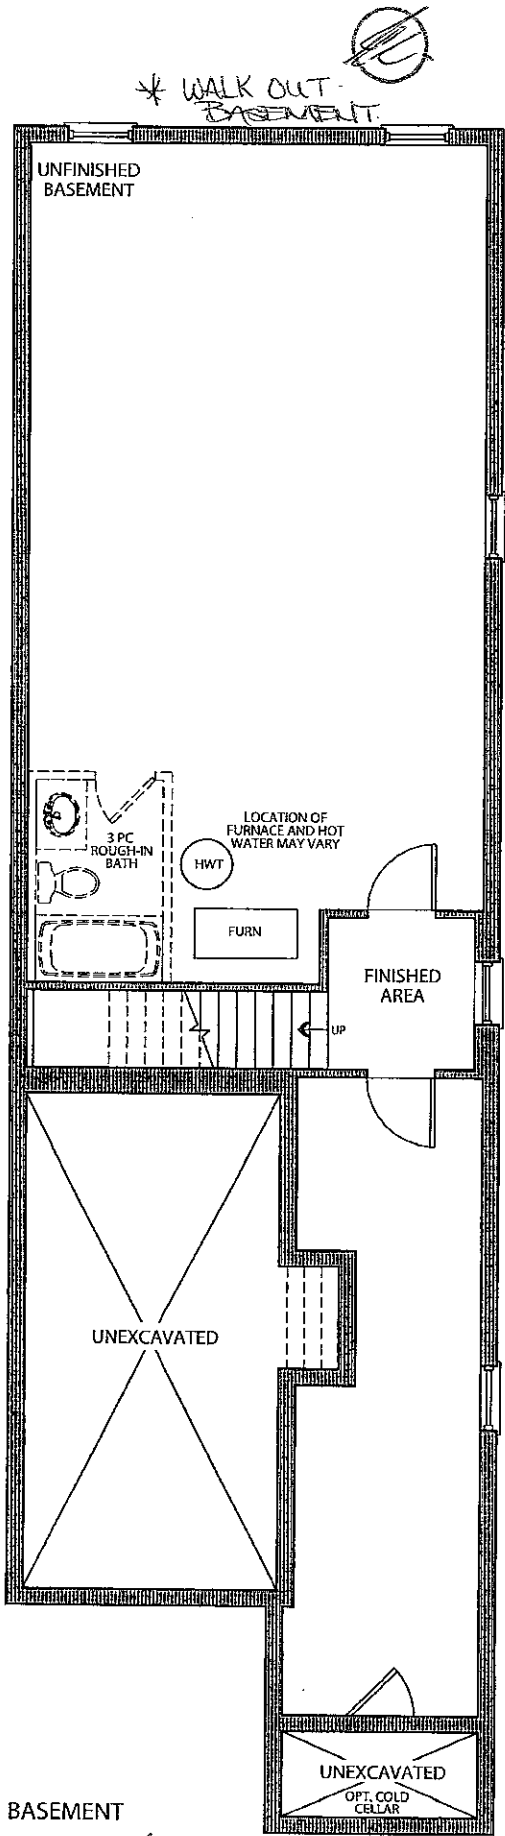


BASEMENT
ELEVATION A & B

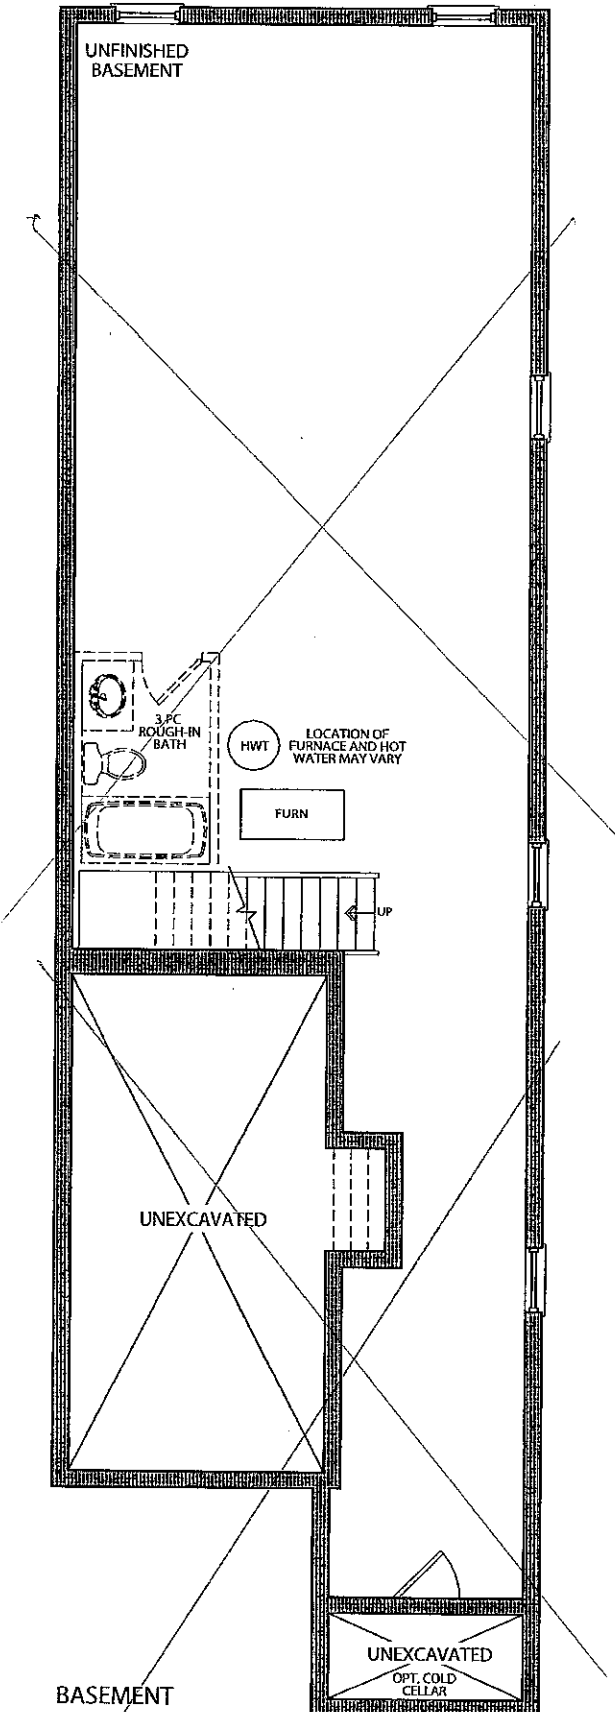

BASEMENT
ELEVATION A & B
FOR OPT.
GROUND FLOOR

Prices, figures, illustrations, sizes, features and finishes are subject to change without notice. E.&O.E. Areas and dimensions are approximate and actual usable floor space may vary from the stated area. Layout may be reverse of the unit purchased. E. & O.E.

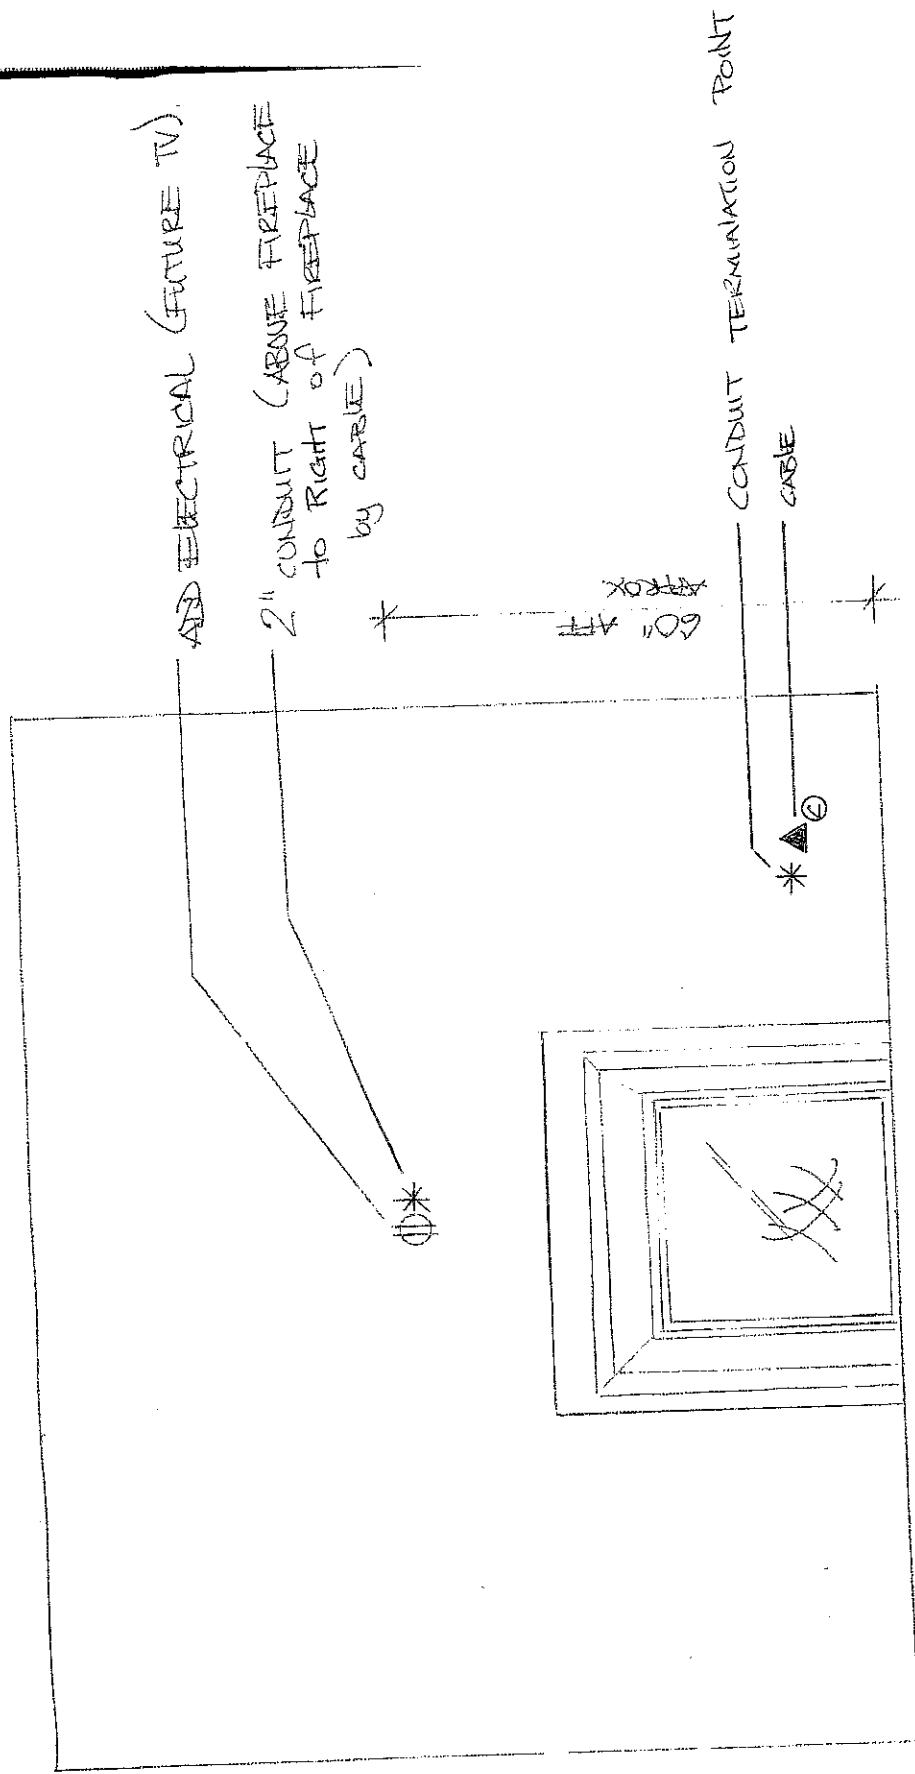

LOT 45R
 FAMILY ROOM - FIREPLACE ELEVATION

July 27, 2016





Stacey Carlete
Project Coordinator



Claude Azzopardi
Contracts Manager



Nancy Martini
Corporate Controller



Model 25.1 The Riverstone			
Elevation	Circle One	A	1812.7 Square Feet
		B	1812.7 Square Feet
Taller Ceilings	Circle All that Apply	GFTC	9' Ceilings Ground Floor
		MFTC	10' Ceilings Main Floor
		SFTC	9' Ceilings Second Floor
Optional Layouts	Circle All that Apply	GFA1	GROUND FLOOR Alternative Layout Kitchen/Family Room

Model 25.2 The Hudson			
Elevation	Circle One	A	1860.8 Square Feet
		B	1858.6 Square Feet
Taller Ceilings	Circle All that Apply	GFTC	9' Ceilings Ground Floor
		MFTC	10' Ceilings Main Floor
		SFTC	9' Ceilings Second Floor
Optional Layouts	Circle All that Apply	GFA1	GROUND FLOOR Alternative Layout Kitchen/Family Room

Model 25.3 The Oakmount			
Elevation	Circle One	A	2013.0 Square Feet
		B	2013.0 Square Feet
Taller Ceilings	Circle All that Apply	GFTC	9' Ceilings Ground Floor
		MFTC	10' Ceilings Main Floor
		SFTC	9' Ceilings Second Floor
Optional Layouts	Circle All that Apply	GFA1	GROUND FLOOR Alternative Layout Kitchen/Family Room
		SFA4	SECOND FLOOR Alternative Layout Laundry Room
		SFA5	SECOND FLOOR Additional Bedroom

Model 25.4 The Stanford			
Elevation	Circle One	A	2665.6 Square Feet
		B	2665.6 Square Feet
Taller Ceilings	Circle All that Apply	GFTC	9' Ceilings Ground Floor
		MFTC	10' Ceilings Main Floor
		SFTC	9' Ceilings Second Floor
Optional Layouts	Circle All that Apply	GFA2	GROUND FLOOR Optional Piece Bathroom
		MFA1	MAIN FLOOR Alternative Layout Kitchen/Family Room
		SFA2	SECOND FLOOR Shower in Lieu of Tub (Master Ens.)
		SFA5	SECOND FLOOR Additional Bedroom

Model 25.5 The Regency			
Elevation	Circle One	A	2924.0 Square Feet
		B	2924.0 Square Feet
Taller Ceilings	Circle All that Apply	GFTC	9' Ceilings Ground Floor
		MFTC	10' Ceilings Main Floor
		SFTC	9' Ceilings Second Floor
Optional Layouts	Circle All that Apply	GFA2	GROUND FLOOR Optional Piece Bathroom
		MFA1	MAIN FLOOR Alternative Layout Kitchen/Family Room
		SFA2	SECOND FLOOR Shower in Lieu of Tub (Master Ens.)
		SFA5	SECOND FLOOR Additional Bedroom

Model 25.6 The Lincoln			
Elevation	Circle One	A	3021.0 Square Feet
		B	3014.0 Square Feet
Taller Ceilings	Circle All that Apply	GFTC	9' Ceilings Ground Floor
		MFTC	10' Ceilings Main Floor
		SFTC	9' Ceilings Second Floor
Optional Layouts	Circle All that Apply	GFA2	GROUND FLOOR Optional Piece Bathroom
		MFA1	MAIN FLOOR Alternative Layout Kitchen/Family Room

Model 25.7 The Carnegie			
Elevation	Circle One	A	3150.8 Square Feet
		B	3150.8 Square Feet
Taller Ceilings	Circle All that Apply	GFTC	9' Ceilings Ground Floor
		MFTC	10' Ceilings Main Floor
		SFTC	9' Ceilings Second Floor
Optional Layouts	Circle All that Apply	GFA2	GROUND FLOOR Optional Piece Bathroom
		MFA1	MAIN FLOOR Alternative Layout Kitchen/Family Room
		SFA1	SECOND FLOOR Shower in Lieu of Tub (Bedroom 2)

Model 25.8 The Biltmore			
Elevation	Circle One	A	1980.8 Square Feet
		B	1989.3 Square Feet
Taller Ceilings	Circle All that Apply	GFTC	9' Ceilings Ground Floor
		MFTC	10' Ceilings Main Floor
		SFTC	9' Ceilings Second Floor
Optional Layouts	Circle All that Apply		

Model 25-10 WILTHIRE			
Elevation	Circle One	(B)	
Taller Ceilings	Circle All that Apply		
Optional Layouts	Circle All that Apply	(GFA1)	OPT. GROUND FLOOR

Model			
Elevation	Circle One		
Taller Ceilings	Circle All that Apply		
Optional Layouts	Circle All that Apply		

*WALK OUT BASEMENT.

LOT 45R
JULY 27-2016

