

Kleinburg Glen - 46R - 1 - 25-2 Elev.A HUDSON
CENTRAL VAC AND WIRING

Inv.705	2 - BEDROOM 2 & 3: ADD RG6 CABLE TO BOTH BEDROOMS. PLEASE SEE FLOORPLAN FOR LOCATIONS.
Line9419	Note:
27Jul16 / 10Nov16	

ELECTRICAL

Inv.705	1 - KITCHEN: 110V WALL RECEPTACLE ON DEDICATED CIRCUIT - FOR MICROWAVE - MICROWAVE NOT INCLUDED. TO ISLAND UNDERCOUNTER. RIGHT SIDE. PLEASE SEE FLOORPLAN FOR LOCATION
Line9415	Note:
27Jul16 / 10Nov16	

EXTERIOR COLOURS

Inv.705	1 - EXTERIOR COLOUR PACKAGE 7
Line13728	Note:
27Jul16 / 10Nov16	

FRAMING

Inv.705	1 - MAIN FLOOR: EXTENDED HEIGHT ARCHWAY (PRICE PER DOORWAY)
Line13729	Note:
27Jul16 / 10Nov16	

Inv.705	1 - MAIN FLOOR: STANDARD DOOR EXTENDED HEIGHT 96 INCH (PRICE PER DOOR) - GROUND FLOOR 2 STOREY MODELS
Line13730	Note:
27Jul16 / 10Nov16	

Inv.705	1 - MANDOOR - GARAGE TO HOUSE - AS PER PLAN AND GRADE PERMITING
Line13734	Note: AS PER APS
27Jul16 / 10Nov16	

HVAC

Inv.705	1 - FAMILY ROOM: DELETE FIREPLACE FROM FAMILY ROOM AS PER PURCHASERS REQUEST.
Line9418	Note:
27Jul16 / 10Nov16	

INTERIOR TRIM AND DOORS

Inv.705	2 - MAIN FLOOR: EXTENDED HEIGHT ARCHWAY (PRICE PER DOORWAY)
Line9416	Note:
27Jul16 / 10Nov16	

Inv.705	4 - MAIN FLOOR: STANDARD DOOR EXTENDED HEIGHT 96 INCH (PRICE PER DOOR) - GROUND FLOOR 2 STOREY MODELS
Line9417	Note:
27Jul16 / 10Nov16	

MISC.

Inv.705	1 - BONUS PACKAGE: \$5,000.00 (INCLUDING TAXES) WORTH OF UPGRADES FROM GOLD PARK HOMES DÉCOR CENTRE IS BEING APPLIED TOWARD THE STRUCTURAL APPOINTMENT. PURCHASER HAS A REMAINING AMOUNT OF \$2,949.05 (INCLUDING TAXES) TO BE USED TOWARD THE COLOUR APPOINTMENT.
Line9422	Note:
27Jul16 / 10Nov16	

Kleinburg Glen - 46R - 1 - 25-2 Elev.A HUDSON


Inv.705	1 - Purchasers are aware & accepts that ANY changes made to upgrades after signing this Purchasers Extra Form are subject to a minimum administration fee of \$500. PLUS a 10% holdback fee.
Line9421	Note:
27Jul16 / 10Nov16	
Inv.705	1 - Purchaser has attended a Structural appointment at the Decor Centre & has DECLINED any additional upgrades and accepts and acknowledges that there will be no further structural changes/additions/deletions to be made upon signing on July 27, 2016.
Line9420	Note:
27Jul16 / 10Nov16	

WINDOWS AND DOORS

Inv.705	1 - MAN DOOR GARAGE TO HOUSE - OPTIONAL - IF GRADE PERMITS
Line13733	Note: AS PER APS
27Jul16 / 10Nov16	


Elevation A • 1,898 sq.ft.

Elevation B • 1,898 sq.ft.

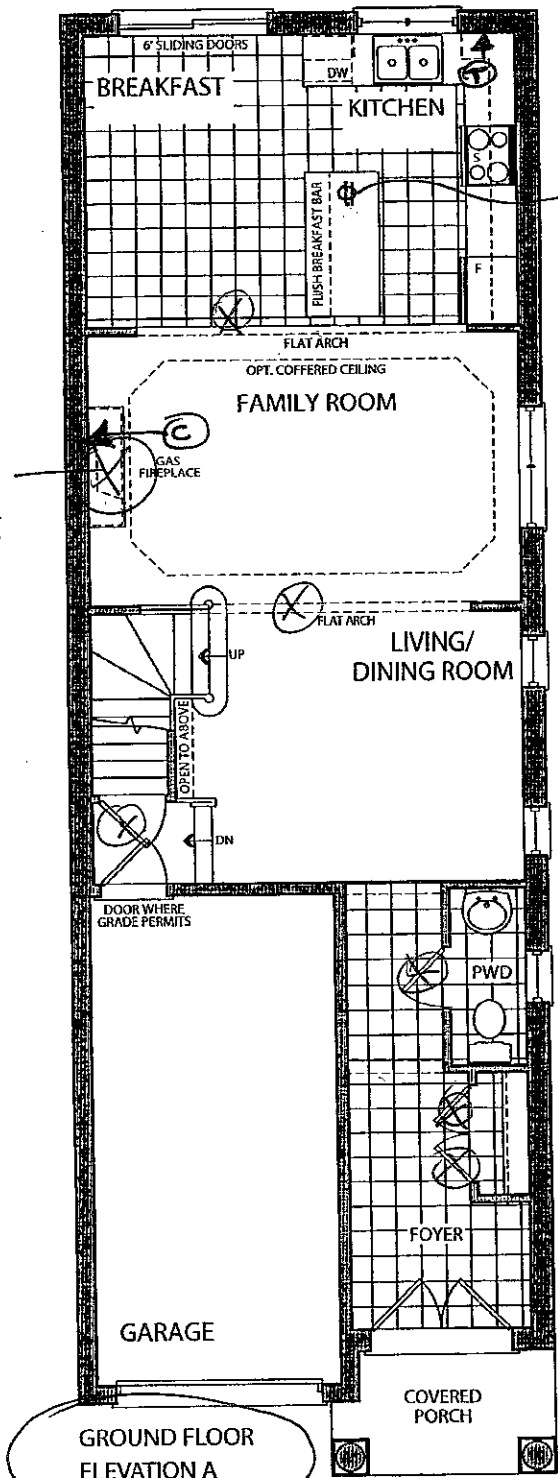

110V DEDICATED RECEPTACLE FOR MICROWAVE UNDER COUNTER

DELETE FIREPLACE

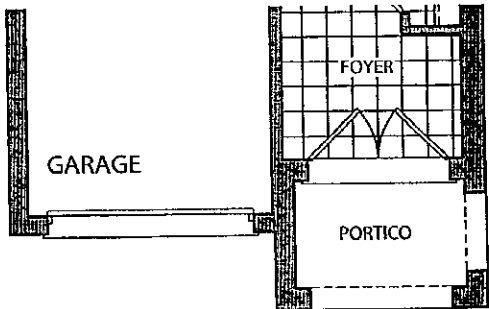


- Ⓢ - CABLE
- Ⓣ - TELEPHONE
- ⓧ EXTENDED ARCHWAYS + DOOR HEIGHTS

LOT 46R

V.H.


July 28, 2016

Elevation A • 1,898 sq.ft.
Elevation B • 1,898 sq.ft.

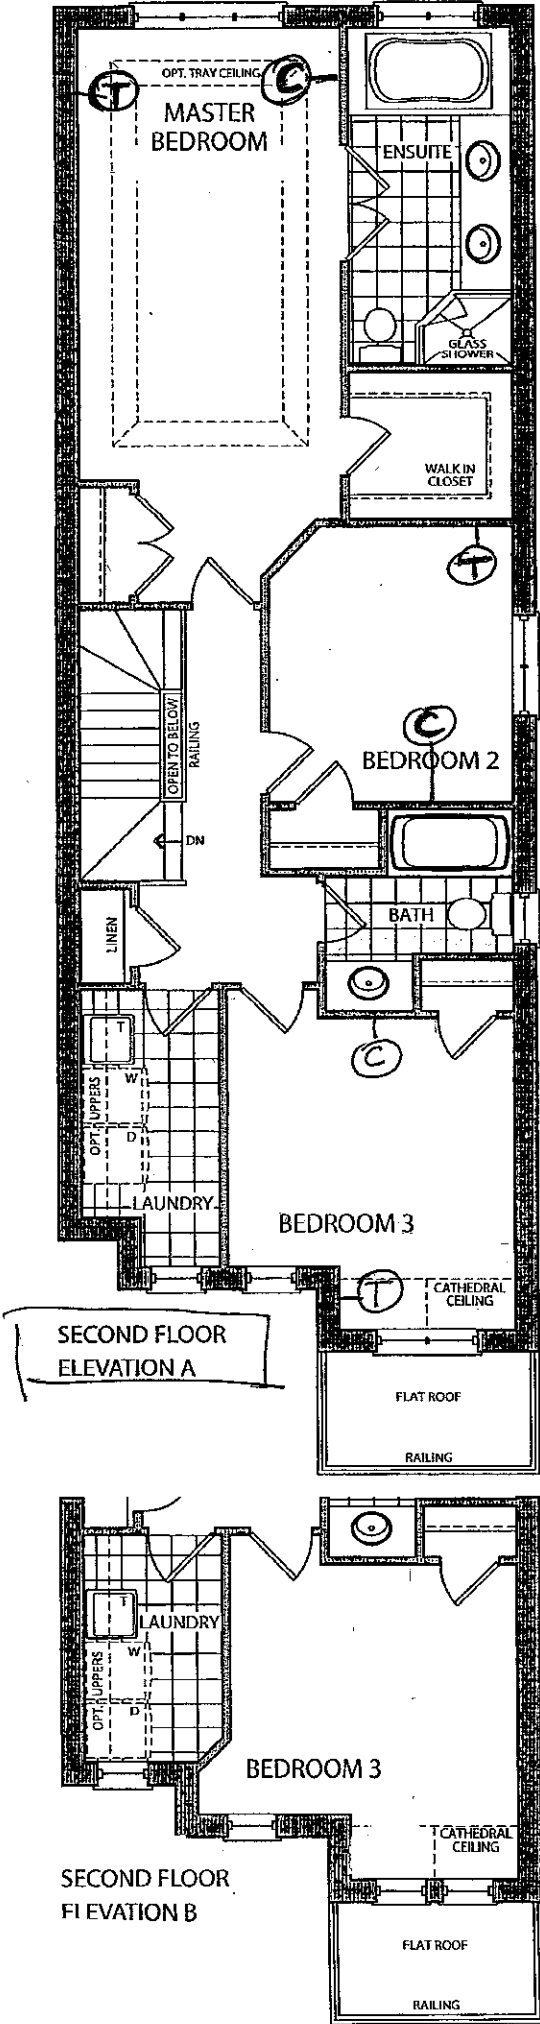

LOT 46R
V/K
JULY 28, 2016

Elevation A • 1,898 sq.ft.
Elevation B • 1,898 sq.ft.

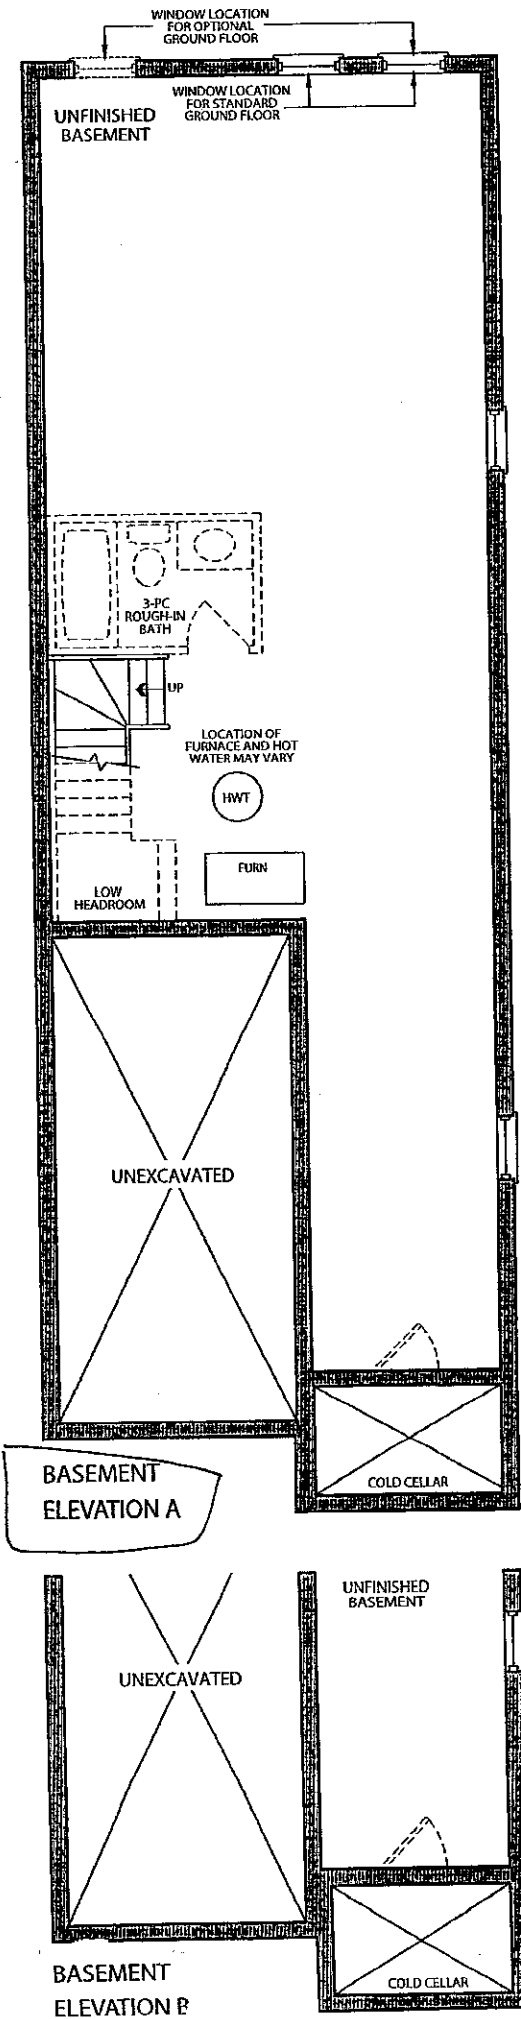

LOT 46R

V.K.

JULY 28, 2016



Stacey Carlete
Project Coordinator



Claude Azzopardi
Contracts Manager



Nancy Martini
Corporate Controller


Kleinburg
GLEN

25.1 The Riverstone			
Elevation	Circle One	A	1812.7 Square Feet
		B	1812.7 Square Feet
Taller Ceilings	Circle All that Apply	GFTC	9' Ceilings Ground Floor
		MFTC	10' Ceilings Main Floor
		SFTC	9' Ceilings Second Floor
Optional Layouts	Circle All that Apply	GFA1	GROUND FLOOR Alternative Layout Kitchen/Family Room

25.2 The Hudson			
Elevation	Circle One	A	1860.8 Square Feet
		B	1858.6 Square Feet
Taller Ceilings	Circle All that Apply	GFTC	9' Ceilings Ground Floor
		MFTC	10' Ceilings Main Floor
		SFTC	9' Ceilings Second Floor
Optional Layouts	Circle All that Apply	GFA1	GROUND FLOOR Alternative Layout Kitchen/Family Room

25.3 The Oakmount			
Elevation	Circle One	A	2013.0 Square Feet
		B	2013.0 Square Feet
Taller Ceilings	Circle All that Apply	GFTC	9' Ceilings Ground Floor
		MFTC	10' Ceilings Main Floor
		SFTC	9' Ceilings Second Floor
Optional Layouts	Circle All that Apply	GFA1	GROUND FLOOR Alternative Layout Kitchen/Family Room
		SFA4	SECOND FLOOR Alternative Layout Laundry Room
		SFA3	SECOND FLOOR Additional Bedroom

25.4 The Stanford			
Elevation	Circle One	A	2665.6 Square Feet
		B	2665.6 Square Feet
Taller Ceilings	Circle All that Apply	GFTC	9' Ceilings Ground Floor
		MFTC	10' Ceilings Main Floor
		SFTC	9' Ceilings Second Floor
Optional Layouts	Circle All that Apply	GFA2	GROUND FLOOR Optional Piece Bathroom
		MFA1	MAIN FLOOR Alternative Layout Kitchen/Family Room
		SFA2	SECOND FLOOR Shower in Lieu of Tub (Master Ens.)
		SFA5	SECOND FLOOR Additional Bedroom

25.5 The Regency			
Elevation	Circle One	A	2924.0 Square Feet
		B	2924.0 Square Feet
Taller Ceilings	Circle All that Apply	GFTC	9' Ceilings Ground Floor
		MFTC	10' Ceilings Main Floor
		SFTC	9' Ceilings Second Floor
Optional Layouts	Circle All that Apply	GFA2	GROUND FLOOR Optional Piece Bathrooms
		MFA1	MAIN FLOOR Alternative Layout Kitchen/Family Room
		SFA2	SECOND FLOOR Shower in Lieu of Tub (Master Ens.)
		SFA5	SECOND FLOOR Additional Bedroom

25.6 The Lincoln			
Elevation	Circle One	A	3021.0 Square Feet
		B	3014.0 Square Feet
Taller Ceilings	Circle All that Apply	GFTC	9' Ceilings Ground Floor
		MFTC	10' Ceilings Main Floor
		SFTC	9' Ceilings Second Floor
Optional Layouts	Circle All that Apply	GFA2	GROUND FLOOR Optional Piece Bathroom
		MFA1	MAIN FLOOR Alternative Layout Kitchen/Family Room

25.7 The Carnegie			
Elevation	Circle One	A	3150.8 Square Feet
		B	3150.8 Square Feet
Taller Ceilings	Circle All that Apply	GFTC	9' Ceilings Ground Floor
		MFTC	10' Ceilings Main Floor
		SFTC	9' Ceilings Second Floor
Optional Layouts	Circle All that Apply	GFA2	GROUND FLOOR Optional Piece Bathroom
		MFA1	MAIN FLOOR Alternative Layout Kitchen/Family Room
		SFA1	SECOND FLOOR Shower in Lieu of Tub (Bedroom 2)

25.8 The Biltmore			
Elevation	Circle One	A	1980.8 Square Feet
		B	1980.3 Square Feet
Taller Ceilings	Circle All that Apply	GFTC	9' Ceilings Ground Floor
		MFTC	10' Ceilings Main Floor
		SFTC	9' Ceilings Second Floor
Optional Layouts	Circle All that Apply		

Elevation	Circle One		
Taller Ceilings	Circle All that Apply		
Optional Layouts	Circle All that Apply		

Elevation	Circle One		
Taller Ceilings	Circle All that Apply		
Optional Layouts	Circle All that Apply		

Lot 46R

VK

July 28, 2014