

Kleinburg Glen - 47R - 1 - 25-10 Elev.B WILTSHIRE OPT- GFA1

CENTRAL VAC AND WIRING

Inv.760	1 - FAMILY ROOM: CONDUIT PIPE - FOR TELEVISION - ABOVE FIREPLACE APPROX. 66" AFF. NEXT TO PLUG AND CABLE. TERMINATING LEFT OF FIREPLACE AT STANDARD HEIGHT. PLEASE SEE FLOORPLAN FOR LOCATION
Line10235	Note:
17Aug16 / 10Nov16	
Inv.760	1 - MASTER BEDROOM: ROUGH - IN FOR EXTRA SECURITY KEY PAD. PLEASE SEE FLOORPLAN FOR LOCATION
Line10242	Note:
17Aug16 / 10Nov16	

DRYWALL

Inv.760	1 - SMOOTH CEILINGS - (2 - Story Design) SECOND FLOOR
Line10231	Note:
17Aug16 / 10Nov16	

ELECTRICAL

Inv.760	8 - KITCHEN: POT LIGHT: 4 INCH HALOGEN POT LIGHT - 440 WH - PLEASE SEE FLOORPLAN FOR LOCATION. ALL ON ONE SWITCH. PRICED BELOW.
Line10246	Note:
17Aug16 / 10Nov16	
Inv.760	1 - KITCHEN: 110V WALL RECEPTACLE ON DEDICATED CIRCUIT - GAS FIRED APPLIANCE - FOR AUX. EQUIPMENT - NOT A STOVE PLUG.
Line10232	Note:
17Aug16 / 10Nov16	
Inv.760	1 - FAMILY ROOM: 110V WALL RECEPTACLE ON NORMAL CIRCUIT - ABOVE FIREPLACE. APPROX 66" AFF. NEXT TO CABLE AND CONDUIT. PLEASE SEE DRAWING FOR LOCATION
Line10234	Note:
17Aug16 / 10Nov16	
Inv.760	8 - FAMILY ROOM: POT LIGHT: 4 INCH HALOGEN POT LIGHT - 440 WH - PLEASE SEE FLOORPLAN FOR LOCATION
Line10241	Note:
17Aug16 / 10Nov16	
Inv.760	1 - KITCHEN: 240V DEDICATED RECEPTACLE FOR FUTURE DOUBLE OVEN. PLEASE SEE FLOORPLAN FOR LOCATION
Line10244	Note:
17Aug16 / 10Nov16	
Inv.760	1 - KITCHEN: SWITCH (WITH COVER PLATE) - FOR POTLIGHTS. PLEASE SEE FLOORPLAN FOR LOCATION
Line10247	Note:
17Aug16 / 10Nov16	
Inv.760	1 - KITCHEN: RELOCATE STANDARD KITCHEN CEILING LIGHT TO CENTER OF ISLAND.
Line10252	Note:
17Aug16 / 10Nov16	
Inv.760	1 - FAMILY ROOM: UPGRADE TO DIMMER SWITCH - ONE UNIT. PLEASE SEE FLOORPLAN FOR LOCATION
Line10250	Note:
17Aug16 / 10Nov16	
Inv.760	4 - FOYER HALLWAY: DELETE STANDARD CEILING LIGHT AND RECPLACE WITH 4 POT LIGHTS: 4 INCH HALOGEN POT LIGHT - 440 WH. PLEASE SEE FLOORPLAN FOR LOCATION
Line10251	Note:
17Aug16 / 10Nov16	

Kleinburg Glen - 47R - 1 - 25-10 Elev.B WILTSHIRE OPT- GFA1

EXTERIOR COLOURS

Inv.760	1 - EXTERIOR COLOUR PACKAGE 4
Line13712	Note:
17Aug16 / 10Nov16	

FRAMING

Inv.760	1 - MAIN FLOOR: EXTENDED HEIGHT ARCHWAY (PRICE PER DOORWAY) - INCLUDE FRAMING NOTE
Line13710	Note:
17Aug16 / 10Nov16	

Inv.760	1 - STANDARD DOOR EXTENDED HEIGHT 96 INCH (PRICE PER DOOR) - GROUND FLOOR 2 STOREY MODELS
Line13711	Note:
17Aug16 / 10Nov16	

Inv.965	1 - OPTIONAL GROUND FLOOR
Line13713	Note:
10Nov16 / 10Nov16	

GLASS AND MIRROR

Inv.760	1 - MASTER ENSUITE: CONVERT FRAMED SHOWER TO 10MM FRAMLESS SHOWER ENCLOSURE WITH DOOR AND 10MM SIDE PANEL
Line10239	Note:
17Aug16 / 10Nov16	

HVAC

Inv.760	1 - KITCHEN: GAS LINE ROUGH - FOR FUTURE GAS RANGE
Line10233	Note:
17Aug16 / 10Nov16	

Inv.760	1 - HUMIDIFIER: WB3 - 17 (UP TO 3,000 SQ.FT.)
Line10253	Note:
17Aug16 / 10Nov16	

INTERIOR TRIM AND DOORS

Inv.760	3 - MAIN FLOOR: EXTENDED HEIGHT ARCHWAY (PRICE PER DOORWAY) - INCLUDE FRAMING NOTE
Line10236	Note:
17Aug16 / 10Nov16	

Inv.760	4 - STANDARD DOOR EXTENDED HEIGHT 96 INCH (PRICE PER DOOR) - GROUND FLOOR 2 STOREY MODELS
Line10237	Note:
17Aug16 / 10Nov16	

MISC.

Inv.760	1 - Purchaser has attended a Structural appointment at the Decor Centre & has DECLINED any additional upgrades and accepts and acknowledges that there will be no further structural changes/additions/deletions to be made upon signing on August 17, 2016.
Line10254	Note:
17Aug16 / 10Nov16	

Inv.760	1 - Purchasers are aware & accepts that ANY changes made to upgrades after signing this Purchasers Extra Form are subject to a minimum administration fee of \$500. PLUS a 10% holdback fee.
Line10255	Note:
17Aug16 / 10Nov16	

Kleinburg Glen - 47R - 1 - 25-10 Elev.B WILTSHIRE OPT- GFA1


Inv.760	1 - BONUS PACKAGE: \$5,000.00 (INCLUDING TAXES) WORTH OF UPGRADES FROM GOLD PARK HOMES DÉCOR CENTRE IS BEING APPLIED TOWARD THE STRUCTURAL APPOINTMENT. PURCHASER HAS A REMAINING AMOUNT OF \$00 (INCLUDING TAXES) TO BE USED TOWARD THE COLOUR APPOINTMENT.
Line10256	Note:
17Aug16 / 10Nov16	

Inv.760	1 - Purchaser request that all upgrades from this purchaser's extras form to be added to the purchase price. Purchaser is aware that upgrades will be processed only after the builder receives approval letter from the bank.
Line10257	Note:
17Aug16 / 10Nov16	

Inv.760	1 - BALANCE AFTER CREDIT: \$12,277.70 50% PAID BY CREDIT CARD: \$6,138.85 50% PAID ON CLOSING: \$6,138.85
Line10258	Note:
17Aug16 / 10Nov16	

PLUMBING

Inv.760	1 - EXTERIOR REAR OF HOUSE: HOSE BIB - STANDARD TO UPGRADED WITH HOT AND COLD WATER VALVE
Line10243	Note:
17Aug16 / 10Nov16	

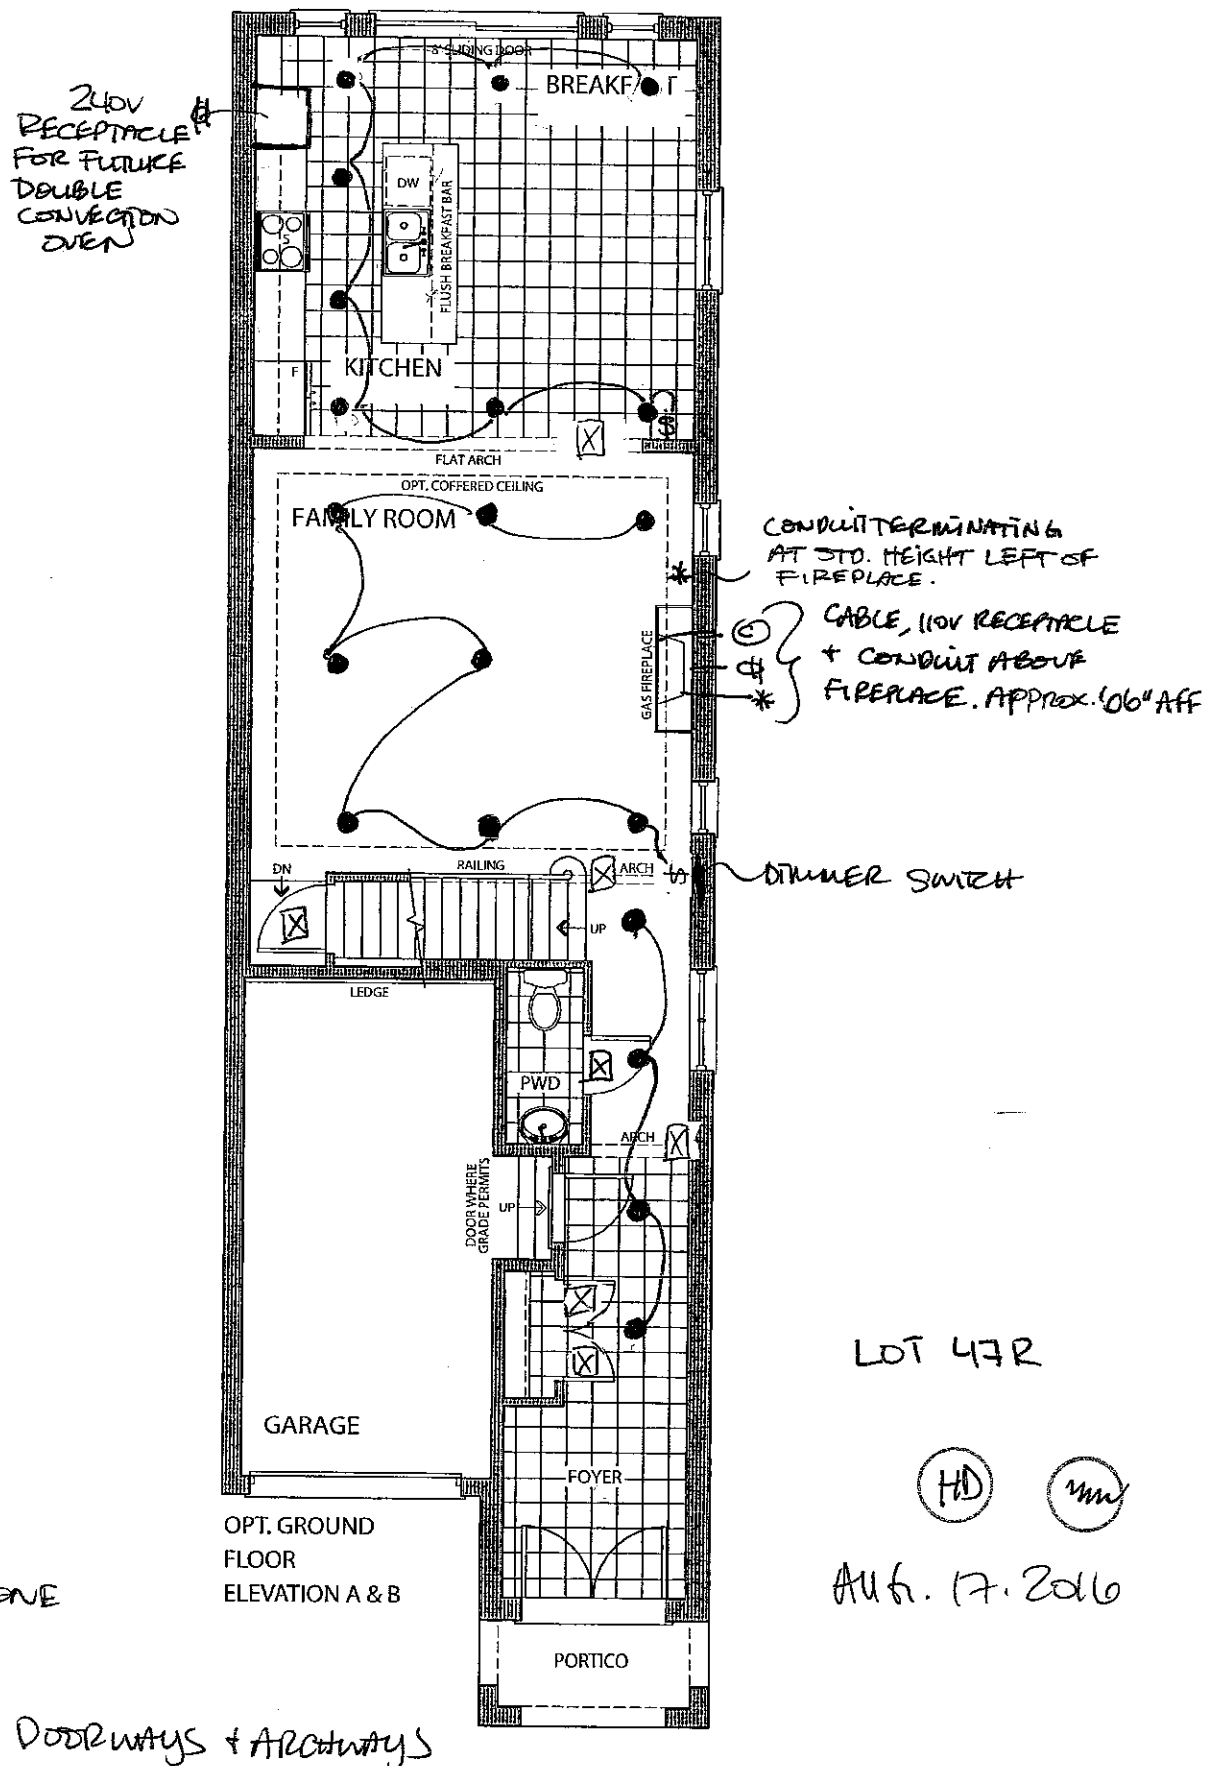

LOT 47R

HD mm

AUG. 17, 2016

Ⓣ - TELEPHONE

Ⓢ - CABLE

ⓧ - EXTEND DOORWAYS + ARCHWAYS



● - POT LIGHTS

Ⓢ - 110V / 240V

\$ - SWITCH

Elevation A • 2,187 sq.ft.

Elevation B • 2,187 sq.ft.

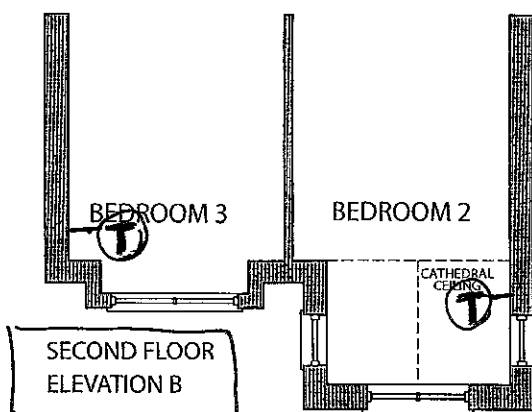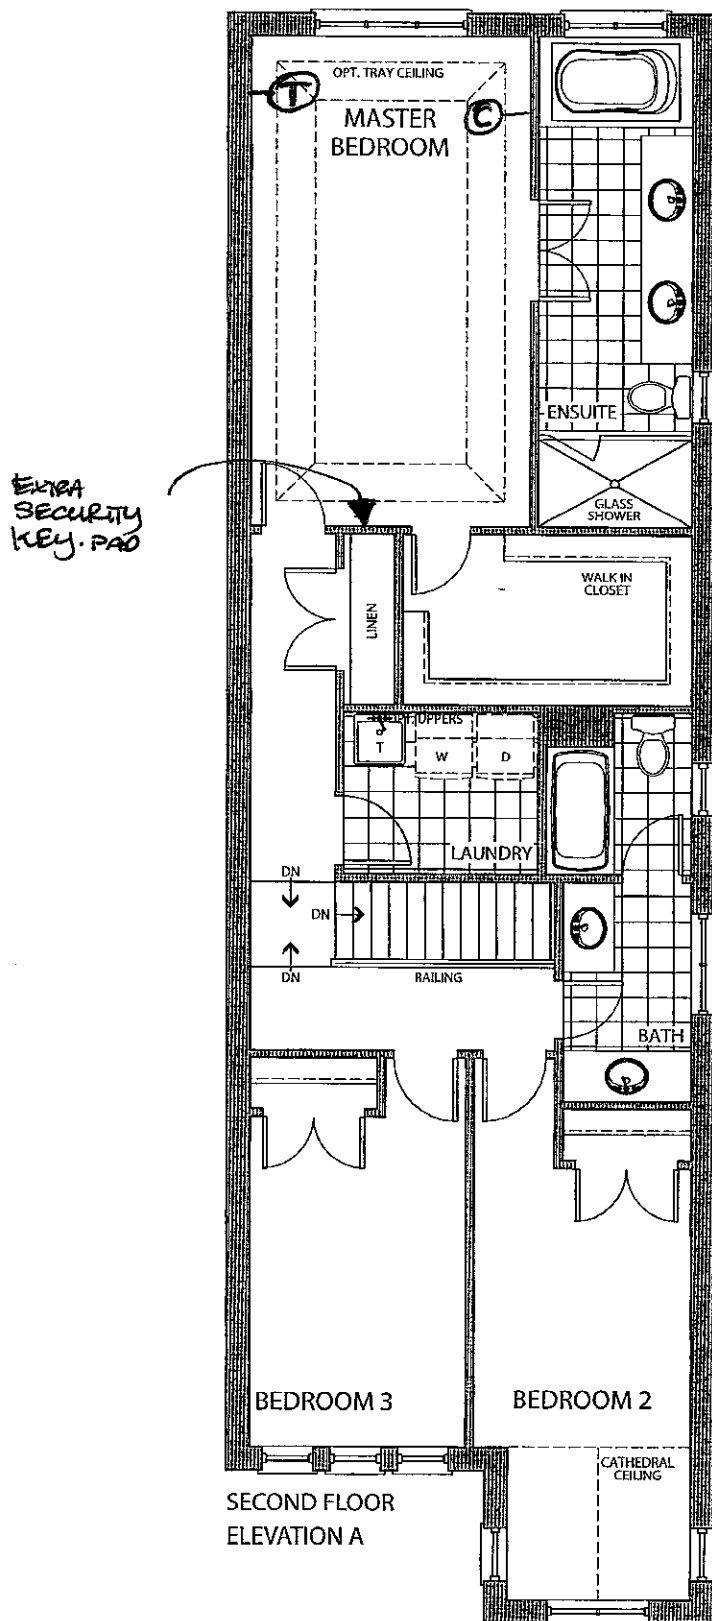

LOT 47R


HD

me


AUG. 17. 2016

Elevation A • 2,187 sq.ft.

Elevation B • 2,187 sq.ft.

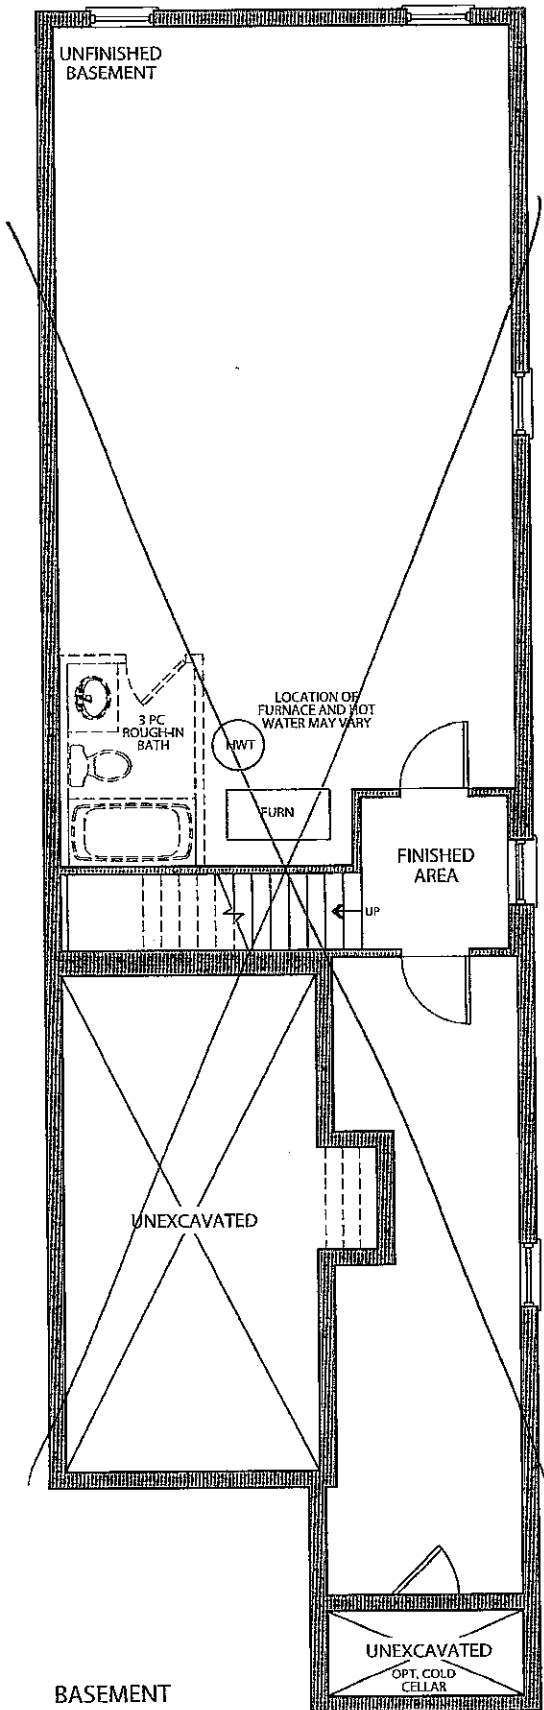

BASEMENT
ELEVATION A & B

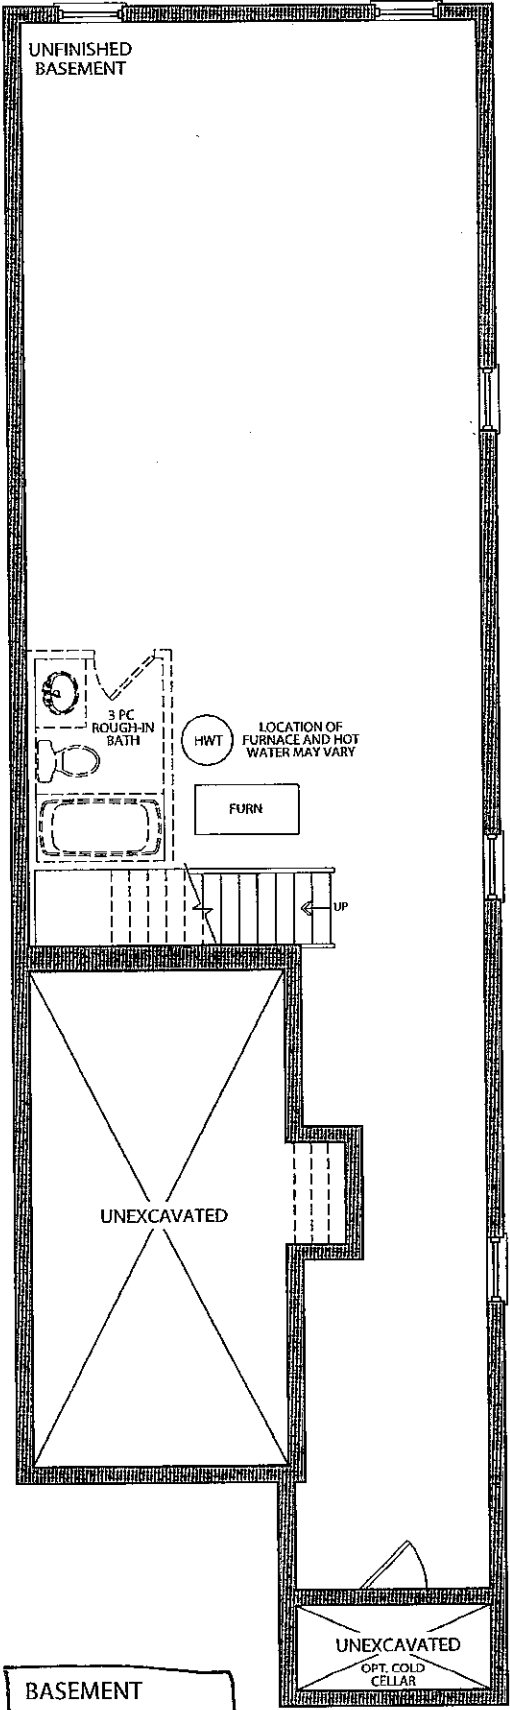

BASEMENT
ELEVATION A & B
FOR OPT.
GROUND FLOOR

LOT 47 R

Aug. 17, 2016

GOLDPARK
HOMES

Prices, figures, illustrations, sizes, features and finishes are subject to change without notice. E.&O.E. Areas and dimensions are approximate and actual usable floor space may vary from the stated area. Layout may be reverse of the unit purchased. E. & O.E.



Stacey Carlete
Project Coordinator



Claude Azzopardi
Contracts Manager



Nancy Martini
Corporate Controller



25.1 The Riverstone			
Elevation	Circle One	A	1812.7 Square Feet
		B	1812.7 Square Feet
Taller Ceilings	Circle All that Apply	GFTC	9' Ceilings Ground Floor
		MFTC	10' Ceilings Main Floor
		SFTC	9' Ceilings Second Floor
Optional Layouts	Circle All that Apply	GFA1	GROUND FLOOR Alternative Layout Kitchen/Family Room

25.2 The Hudson			
Elevation	Circle One	A	1860.8 Square Feet
		B	1858.6 Square Feet
Taller Ceilings	Circle All that Apply	GFTC	9' Ceilings Ground Floor
		MFTC	10' Ceilings Main Floor
		SFTC	9' Ceilings Second Floor
Optional Layouts	Circle All that Apply	GFA1	GROUND FLOOR Alternative Layout Kitchen/Family Room

25.3 The Oakmount			
Elevation	Circle One	A	2013.0 Square Feet
		B	2013.0 Square Feet
Taller Ceilings	Circle All that Apply	GFTC	9' Ceilings Ground Floor
		MFTC	10' Ceilings Main Floor
		SFTC	9' Ceilings Second Floor
Optional Layouts	Circle All that Apply	GFA1	GROUND FLOOR Alternative Layout Kitchen/Family Room
		SFA4	SECOND FLOOR Alternative Layout Laundry Room
		SFA5	SECOND FLOOR Additional Bedroom

25.4 The Stanford			
Elevation	Circle One	A	2665.6 Square Feet
		B	2665.6 Square Feet
Taller Ceilings	Circle All that Apply	GFTC	9' Ceilings Ground Floor
		MFTC	10' Ceilings Main Floor
		SFTC	9' Ceilings Second Floor
Optional Layouts	Circle All that Apply	GFA2	GROUND FLOOR Optional Piece Bathroom
		MFA1	MAIN FLOOR Alternative Layout Kitchen/Family Room
		SFA2	SECOND FLOOR Shower in Lieu of Tub (Master Ens.)
		SFA5	SECOND FLOOR Additional Bedroom

25.5 The Regency			
Elevation	Circle One	A	2924.0 Square Feet
		B	2924.0 Square Feet
Taller Ceilings	Circle All that Apply	GFTC	9' Ceilings Ground Floor
		MFTC	10' Ceilings Main Floor
		SFTC	9' Ceilings Second Floor
Optional Layouts	Circle All that Apply	GFA2	GROUND FLOOR Optional Piece Bathroom
		MFA1	MAIN FLOOR Alternative Layout Kitchen/Family Room
		SFA2	SECOND FLOOR Shower in Lieu of Tub (Master Ens.)
		SFA5	SECOND FLOOR Additional Bedroom

25.6 The Lincoln			
Elevation	Circle One	A	3021.0 Square Feet
		B	3014.0 Square Feet
Taller Ceilings	Circle All that Apply	GFTC	9' Ceilings Ground Floor
		MFTC	10' Ceilings Main Floor
		SFTC	9' Ceilings Second Floor
Optional Layouts	Circle All that Apply	GFA2	GROUND FLOOR Optional Piece Bathroom
		MFA1	MAIN FLOOR Alternative Layout Kitchen/Family Room

25.7 The Carnegie			
Elevation	Circle One	A	3150.8 Square Feet
		B	3150.8 Square Feet
Taller Ceilings	Circle All that Apply	GFTC	9' Ceilings Ground Floor
		MFTC	10' Ceilings Main Floor
		SFTC	9' Ceilings Second Floor
Optional Layouts	Circle All that Apply	GFA2	GROUND FLOOR Optional Piece Bathroom
		MFA1	MAIN FLOOR Alternative Layout Kitchen/Family Room
		SFA1	SECOND FLOOR Shower in Lieu of Tub (Bedroom 2)

25.8 The Biltmore			
Elevation	Circle One	A	1980.8 Square Feet
		B	1989.3 Square Feet
Taller Ceilings	Circle All that Apply	GFTC	9' Ceilings Ground Floor
		MFTC	10' Ceilings Main Floor
		SFTC	9' Ceilings Second Floor
Optional Layouts	Circle All that Apply		

Elevation	Circle One		
Taller Ceilings	Circle All that Apply		
Optional Layouts	Circle All that Apply		

WILTSHIRE			
Elevation	Circle One	(B)	
Taller Ceilings	Circle All that Apply	GFTC	9' CEILING GROUND FLOOR
Optional Layouts	Circle All that Apply		OPTIONAL GROUND FLOOR

LOT 47R

HD

1mm

AUG. 17. 2016