

**Kleinburg Glen - 51L - 1 - 25-2 Elev.A HUDSON OPT- GFA1**

**CENTRAL VAC AND WIRING**

|                  |                                                                                                                                                  |
|------------------|--------------------------------------------------------------------------------------------------------------------------------------------------|
| Inv.630          | 1 - CONDUIT PIPE - FROM ATTIC TO ELECTRICAL PANEL - MUST SPECIFY LOCATION AND TERMINATION POINT                                                  |
| Line7969         | Note:                                                                                                                                            |
| 7Jul16 / 10Nov16 |                                                                                                                                                  |
| Inv.630          | 1 - FAMILY ROOM: CONDUIT PIPE - FOR TELEVISION Locate above fireplace, approx. 60" A.F.F. terminating right of fireplace. See plan for location. |
| Line7987         | Note:                                                                                                                                            |
| 7Jul16 / 10Nov16 |                                                                                                                                                  |
| Inv.630          | 1 - FAMILY ROOM: CAT 6 WIRING - UPGRADE AN OUTLET TO CAT 6. See plan for location.                                                               |
| Line7999         | Note:                                                                                                                                            |
| 7Jul16 / 10Nov16 |                                                                                                                                                  |

**DRYWALL**

|                  |                                                                                                                                               |
|------------------|-----------------------------------------------------------------------------------------------------------------------------------------------|
| Inv.630          | 1 - SECOND FLOOR CEILING 9 FOOT - 25 FOOT MODELS ONLY- INCLUDES TALLER FRONT AND REAR ELEVATION WINDOWS, 8' INTERIOR DOORS, TALER FLAT ARCHES |
| Line13704        | Note:                                                                                                                                         |
| 7Jul16 / 10Nov16 |                                                                                                                                               |

**ELECTRICAL**

|                  |                                                                                                                                                                                             |
|------------------|---------------------------------------------------------------------------------------------------------------------------------------------------------------------------------------------|
| Inv.630          | 1 - 200 AMP ELECTRICAL SERVICE                                                                                                                                                              |
| Line7968         | Note:                                                                                                                                                                                       |
| 7Jul16 / 10Nov16 |                                                                                                                                                                                             |
| Inv.630          | 1 - GARAGE: 220V WALL RECEPTICAL ON DEDICATED CIRCUIT - FOR FUTURE ELECTRIC CAR. SEE PLAN FOR LOCATION.                                                                                     |
| Line7971         | Note:                                                                                                                                                                                       |
| 7Jul16 / 10Nov16 |                                                                                                                                                                                             |
| Inv.630          | 1 - KITCHEN: RELOCATE STANDARD FIXTURE to above island. See plan for location.                                                                                                              |
| Line7972         | Note:                                                                                                                                                                                       |
| 7Jul16 / 10Nov16 |                                                                                                                                                                                             |
| Inv.630          | 1 - KITCHEN: ROUGH - IN CEILING OUTLET ON SAME SWITCH - DOES NOT INCLUDE FIXTURE - locate: to be centered above island (with standard kitchen light, on same switch) See plan for location. |
| Line7973         | Note:                                                                                                                                                                                       |
| 7Jul16 / 10Nov16 |                                                                                                                                                                                             |
| Inv.630          | 4 - KITCHEN: POT LIGHT: 4 INCH HALOGEN POT LIGHT - 440 WH - PRICED PER LIGHT - 10 OR MORE. See plan for location.                                                                           |
| Line7974         | Note:                                                                                                                                                                                       |
| 7Jul16 / 10Nov16 |                                                                                                                                                                                             |
| Inv.630          | 1 - KITCHEN: Install single pole switch for potlights in kitchen.                                                                                                                           |
| Line7975         | Note:                                                                                                                                                                                       |
| 7Jul16 / 10Nov16 |                                                                                                                                                                                             |
| Inv.630          | 6 - FAMILY ROOM: POT LIGHT: 4 INCH HALOGEN POT LIGHT - 440 WH - PRICED PER LIGHT - 10 OR MORE See plan for location.                                                                        |
| Line7976         | Note:                                                                                                                                                                                       |
| 7Jul16 / 10Nov16 |                                                                                                                                                                                             |
| Inv.630          | 1 - FAMILY ROOM: Single pole switch for pot lights.                                                                                                                                         |
| Line7977         | Note:                                                                                                                                                                                       |
| 7Jul16 / 10Nov16 |                                                                                                                                                                                             |

**Kleinburg Glen - 51L - 1 - 25-2 Elev.A HUDSON OPT- GFA1**

|                  |                                                                                                                                                                                    |
|------------------|------------------------------------------------------------------------------------------------------------------------------------------------------------------------------------|
| Inv.630          | 3 - MAIN HALL: *DELETE STANDARD CEILING LIGHT* INSTALL 3 POT LIGHT: 4 INCH HALOGEN POT LIGHT - 440 WH - PRICED PER LIGHT - 10 OR MORE. See plan for location. Use standard switch. |
| Line7978         | Note:                                                                                                                                                                              |
| 7Jul16 / 10Nov16 |                                                                                                                                                                                    |
| Inv.630          | 1 - FAMILY ROOM: 110V WALL RECEPTACLE ON NORMAL CIRCUIT - Locate approx. 66" A.F.F above fireplace. See plan for location.                                                         |
| Line7986         | Note:                                                                                                                                                                              |
| 7Jul16 / 10Nov16 |                                                                                                                                                                                    |

**EXTERIOR COLOURS**

|                  |                                |
|------------------|--------------------------------|
| Inv.630          | 1 - EXTERIOR COLOUR PACKAGE 11 |
| Line13706        | Note:                          |
| 7Jul16 / 10Nov16 |                                |

**FRAMING**

|                   |                                                                                                                                               |
|-------------------|-----------------------------------------------------------------------------------------------------------------------------------------------|
| Inv.630           | 1 - SECOND FLOOR CEILING 9 FOOT - 25 FOOT MODELS ONLY- INCLUDES TALLER FRONT AND REAR ELEVATION WINDOWS, 8' INTERIOR DOORS, TALER FLAT ARCHES |
| Line7997          | Note:                                                                                                                                         |
| 7Jul16 / 10Nov16  |                                                                                                                                               |
| Inv.630           | 1 - MANDOOR - GARAGE TO HOUSE - AS PER PLAN AND GRADE PERMITTING                                                                              |
| Line13707         | Note: AS PER APS                                                                                                                              |
| 7Jul16 / 10Nov16  |                                                                                                                                               |
| Inv.964           | 1 - OPTIONAL GROUND FLOOR                                                                                                                     |
| Line13709         | Note:                                                                                                                                         |
| 10Nov16 / 10Nov16 |                                                                                                                                               |

**INTERIOR TRIM AND DOORS**

|                  |                                                                                                                                               |
|------------------|-----------------------------------------------------------------------------------------------------------------------------------------------|
| Inv.630          | 1 - SECOND FLOOR CEILING 9 FOOT - 25 FOOT MODELS ONLY- INCLUDES TALLER FRONT AND REAR ELEVATION WINDOWS, 8' INTERIOR DOORS, TALER FLAT ARCHES |
| Line13703        | Note:                                                                                                                                         |
| 7Jul16 / 10Nov16 |                                                                                                                                               |

**MISC.**

|                  |                                                                                                                                                                                                                                                              |
|------------------|--------------------------------------------------------------------------------------------------------------------------------------------------------------------------------------------------------------------------------------------------------------|
| Inv.630          | 1 - BONUS PACKAGE: \$5,000.00 (INCLUDING TAXES) WORTH OF UPGRADES FROM GOLD PARK HOMES DÉCOR CENTRE IS BEING APPLIED TOWARD THE STRUCTURAL APPOINTMENT. PURCHASER HAS A REMAINING AMOUNT OF \$00 (INCLUDING TAXES) TO BE USED TOWARD THE COLOUR APPOINTMENT. |
| Line8001         | Note:                                                                                                                                                                                                                                                        |
| 7Jul16 / 10Nov16 |                                                                                                                                                                                                                                                              |
| Inv.630          | 1 - Purchasers are aware & accepts that ANY changes made to upgrades after signing this Purchasers Extra Form are subject to a minimum administration fee of \$500. PLUS a 10% holdback fee.                                                                 |
| Line8002         | Note:                                                                                                                                                                                                                                                        |
| 7Jul16 / 10Nov16 |                                                                                                                                                                                                                                                              |
| Inv.630          | 1 - Purchaser has attended a Structural appointment at the Decor Centre & has DECLINED any additional upgrades and accepts and acknowledges that there will be no further structural changes/additions/deletions to be made upon signing on July 7, 2016.    |
| Line8004         | Note:                                                                                                                                                                                                                                                        |
| 7Jul16 / 10Nov16 |                                                                                                                                                                                                                                                              |

**WINDOWS AND DOORS**

Kleinburg Glen - 51L - 1 - 25-2 Elev.A HUDSON OPT- GFA1

|                  |                                                                                                                                               |
|------------------|-----------------------------------------------------------------------------------------------------------------------------------------------|
| Inv.630          | 1 - FRENCH DOORS IN LIEU OF PATIO SLIDERS - 6FT X 80 INCH FRENCH DOORS - NO SCREEN CLEAR GLASS                                                |
| Line7992         | Note:                                                                                                                                         |
| 7Jul16 / 10Nov16 |                                                                                                                                               |
| Inv.630          | 1 - SIDELITES - 1 PAIR - 12 INCH x 80 INCH HEIGHT - MUST ADD WITH 6 FOOT DOORS IN LIEU OF 8 FOOT SLIDERS                                      |
| Line7993         | Note:                                                                                                                                         |
| 7Jul16 / 10Nov16 |                                                                                                                                               |
| Inv.630          | 1 - SECOND FLOOR CEILING 9 FOOT - 25 FOOT MODELS ONLY- INCLUDES TALLER FRONT AND REAR ELEVATION WINDOWS, 8' INTERIOR DOORS, TALER FLAT ARCHES |
| Line13705        | Note:                                                                                                                                         |
| 7Jul16 / 10Nov16 |                                                                                                                                               |
| Inv.630          | 1 - MAN DOOR GARAGE TO HOUSE - OPTIONAL - IF GRADE PERMITS                                                                                    |
| Line13708        | Note: AS PER APS                                                                                                                              |
| 7Jul16 / 10Nov16 |                                                                                                                                               |


✓Elevation A • 1,898 sq.ft.

—Elevation B • 1,898 sq.ft.

LOT 51 L

July 7 2016

FRONT DOOR + SIDE LITES.

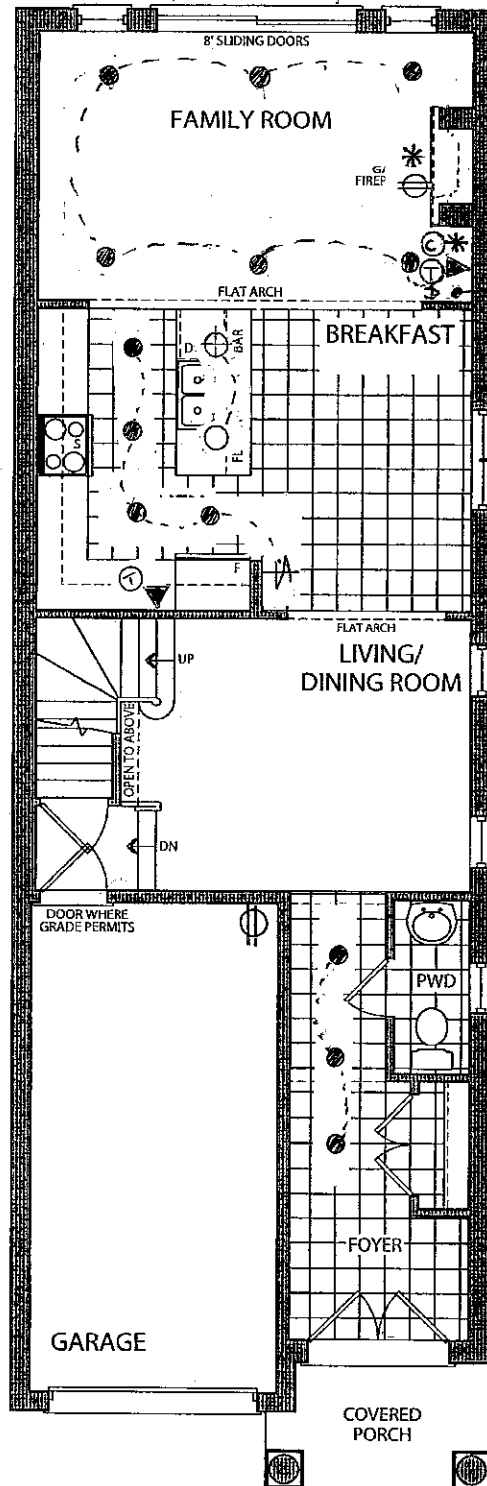



ADD: CAT 6.

✓OPT. GROUND FLOOR  
ELEVATION A

✓ Elevation A • 1,898 sq.ft.

✓ Elevation B • 1,898 sq.ft.



✓ Lot 51L  
July 7 2016

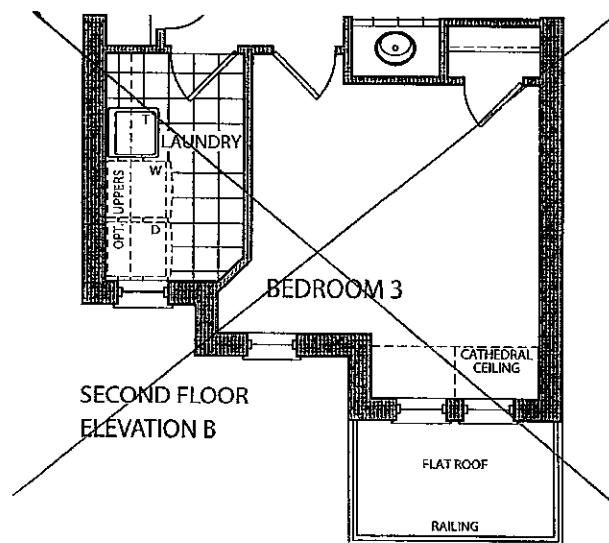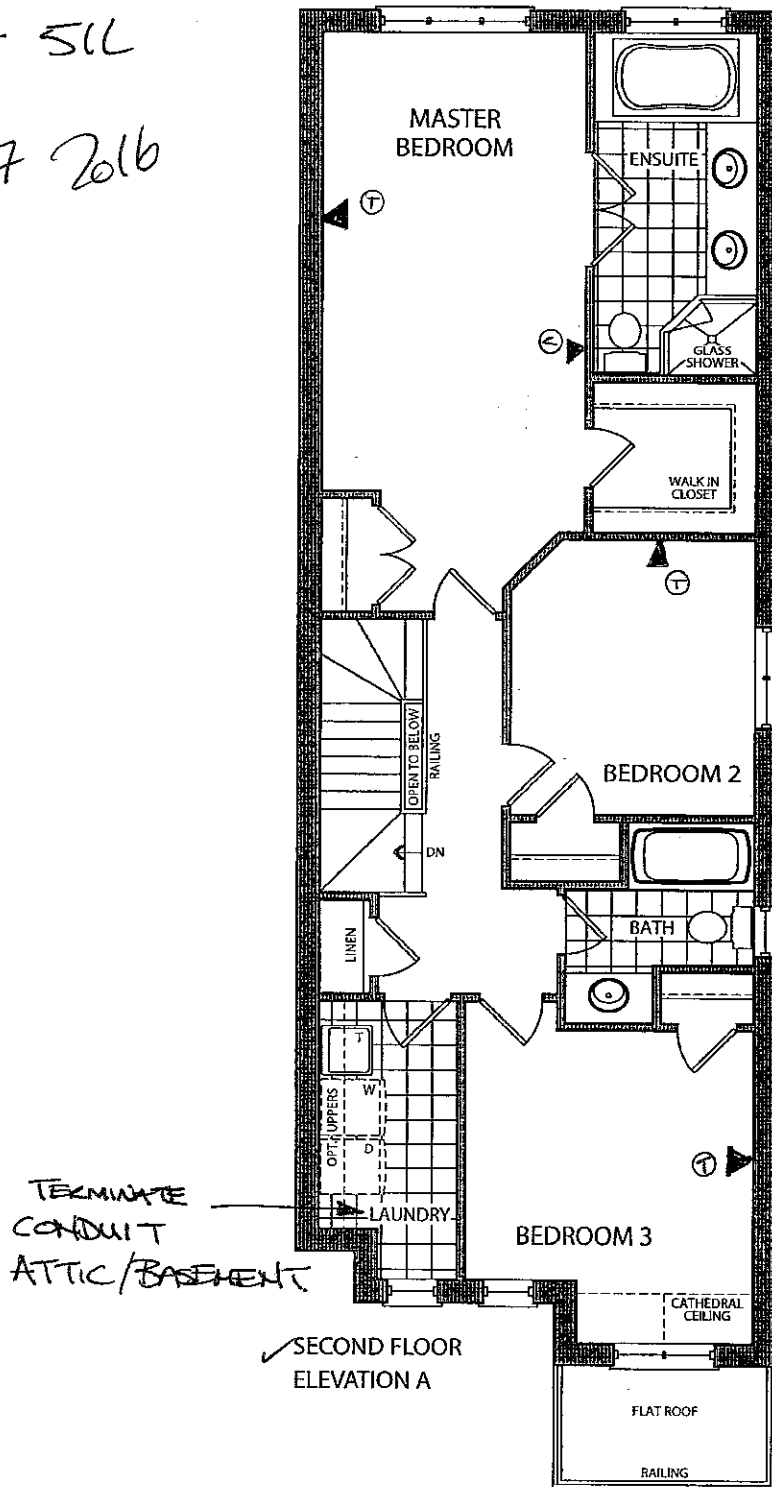


Elevation A • 1,898 sq.ft.

Elevation B • 1,898 sq.ft.

LOT 512  
July 7 2016

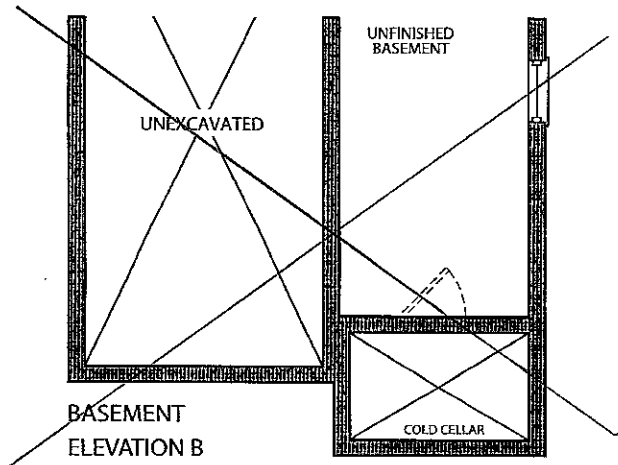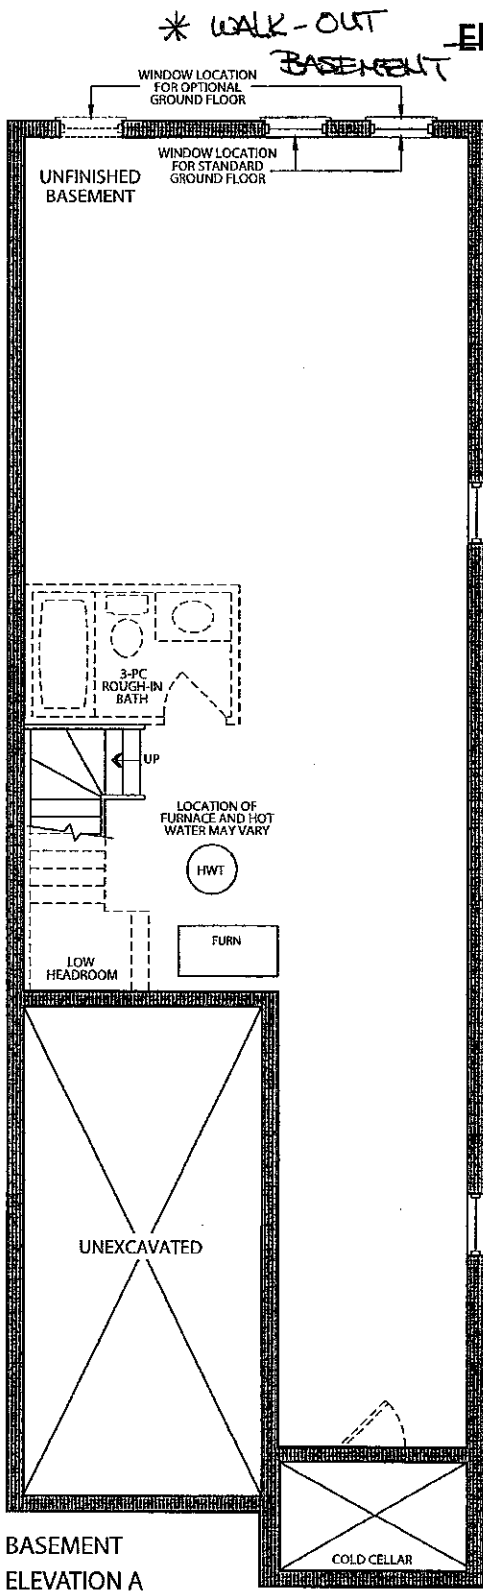

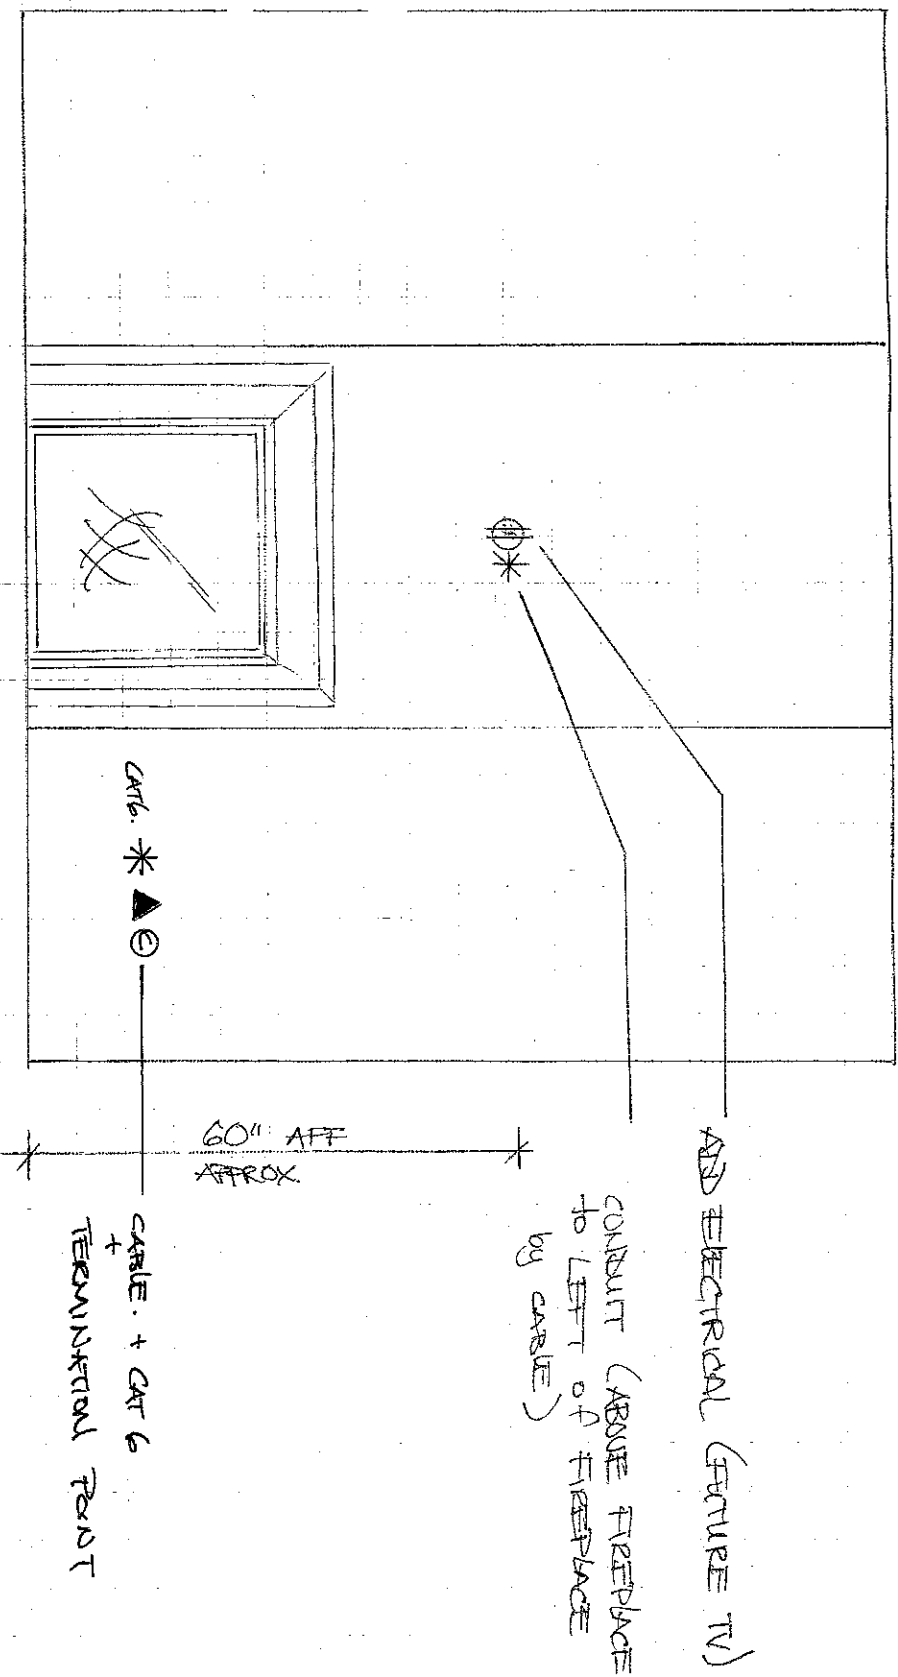

210

LOT 51.2

FAMILY ROOM FIREPLACE ELEVATION.

211

July 7 2016



Stacey Carlete  
Project Coordinator



Claude Azzopardi  
Contracts Manager



Nancy Martini  
Corporate Controller



\* WALK-OUT BASEMENT

| 25.1 The Riverstone |                       |      |                                                     |
|---------------------|-----------------------|------|-----------------------------------------------------|
| Elevation           | Circle One            | A    | 1812.7 Square Feet                                  |
|                     |                       | B    | 1812.7 Square Feet                                  |
| Taller Ceilings     | Circle All that Apply | GFTC | 9' Ceilings Ground Floor                            |
|                     |                       | MFTC | 10' Ceilings Main Floor                             |
|                     |                       | SFTC | 9' Ceilings Second Floor                            |
| Optional Layouts    | Circle All that Apply | GFA1 | GROUND FLOOR Alternative Layout Kitchen/Family Room |
|                     |                       |      |                                                     |
|                     |                       |      |                                                     |

| 25.2 The Hudson  |                       |      |                                                     |
|------------------|-----------------------|------|-----------------------------------------------------|
| Elevation        | Circle One            | A    | 1860.8 Square Feet                                  |
|                  |                       | B    | 1858.6 Square Feet                                  |
| Taller Ceilings  | Circle All that Apply | GFTC | 9' Ceilings Ground Floor                            |
|                  |                       | MFTC | 10' Ceilings Main Floor                             |
|                  |                       | SFTC | 9' Ceilings Second Floor                            |
| Optional Layouts | Circle All that Apply | GFA1 | GROUND FLOOR Alternative Layout Kitchen/Family Room |
|                  |                       |      |                                                     |
|                  |                       |      |                                                     |

| 25.3 The Oakmount |                       |      |                                                     |
|-------------------|-----------------------|------|-----------------------------------------------------|
| Elevation         | Circle One            | A    | 2013.0 Square Feet                                  |
|                   |                       | B    | 2013.0 Square Feet                                  |
| Taller Ceilings   | Circle All that Apply | GFTC | 9' Ceilings Ground Floor                            |
|                   |                       | MFTC | 10' Ceilings Main Floor                             |
|                   |                       | SFTC | 9' Ceilings Second Floor                            |
| Optional Layouts  | Circle All that Apply | GFA1 | GROUND FLOOR Alternative Layout Kitchen/Family Room |
|                   |                       | SFA4 | SECOND FLOOR Alternative Layout Laundry Room        |
|                   |                       | SFA5 | SECOND FLOOR Additional Bedroom                     |

| 25.4 The Stanford |                       |      |                                                   |
|-------------------|-----------------------|------|---------------------------------------------------|
| Elevation         | Circle One            | A    | 2665.6 Square Feet                                |
|                   |                       | B    | 2665.6 Square Feet                                |
| Taller Ceilings   | Circle All that Apply | GFTC | 9' Ceilings Ground Floor                          |
|                   |                       | MFTC | 10' Ceilings Main Floor                           |
|                   |                       | SFTC | 9' Ceilings Second Floor                          |
| Optional Layouts  | Circle All that Apply | GFA2 | GROUND FLOOR Optional Piece Bathroom              |
|                   |                       | MFA1 | MAIN FLOOR Alternative Layout Kitchen/Family Room |
|                   |                       | SFA2 | SECOND FLOOR Shower in Lieu of Tub (Master Ens.)  |
|                   |                       | SFA5 | SECOND FLOOR Additional Bedroom                   |

| 25.5 The Regency |                       |      |                                                   |
|------------------|-----------------------|------|---------------------------------------------------|
| Elevation        | Circle One            | A    | 2924.0 Square Feet                                |
|                  |                       | B    | 2924.0 Square Feet                                |
| Taller Ceilings  | Circle All that Apply | GFTC | 9' Ceilings Ground Floor                          |
|                  |                       | MFTC | 10' Ceilings Main Floor                           |
|                  |                       | SFTC | 9' Ceilings Second Floor                          |
| Optional Layouts | Circle All that Apply | GFA2 | GROUND FLOOR Optional Piece Bathroom              |
|                  |                       | MFA1 | MAIN FLOOR Alternative Layout Kitchen/Family Room |
|                  |                       | SFA2 | SECOND FLOOR Shower in Lieu of Tub (Master Ens.)  |
|                  |                       | SFA5 | SECOND FLOOR Additional Bedroom                   |

| 25.6 The Lincoln |                       |      |                                                   |
|------------------|-----------------------|------|---------------------------------------------------|
| Elevation        | Circle One            | A    | 3021.0 Square Feet                                |
|                  |                       | B    | 3014.0 Square Feet                                |
| Taller Ceilings  | Circle All that Apply | GFTC | 9' Ceilings Ground Floor                          |
|                  |                       | MFTC | 10' Ceilings Main Floor                           |
|                  |                       | SFTC | 9' Ceilings Second Floor                          |
| Optional Layouts | Circle All that Apply | GFA2 | GROUND FLOOR Optional Piece Bathroom              |
|                  |                       | MFA1 | MAIN FLOOR Alternative Layout Kitchen/Family Room |
|                  |                       |      |                                                   |

| 25.7 The Carnegie |                       |      |                                                   |
|-------------------|-----------------------|------|---------------------------------------------------|
| Elevation         | Circle One            | A    | 3150.8 Square Feet                                |
|                   |                       | B    | 3150.8 Square Feet                                |
| Taller Ceilings   | Circle All that Apply | GFTC | 9' Ceilings Ground Floor                          |
|                   |                       | MFTC | 10' Ceilings Main Floor                           |
|                   |                       | SFTC | 9' Ceilings Second Floor                          |
| Optional Layouts  | Circle All that Apply | GFA2 | GROUND FLOOR Optional Piece Bathroom              |
|                   |                       | MFA1 | MAIN FLOOR Alternative Layout Kitchen/Family Room |
|                   |                       | SFA1 | SECOND FLOOR Shower in Lieu of Tub (Bedroom 2)    |
|                   |                       |      |                                                   |

| 25.8 The Biltmore |                       |      |                          |
|-------------------|-----------------------|------|--------------------------|
| Elevation         | Circle One            | A    | 1980.8 Square Feet       |
|                   |                       | B    | 1989.3 Square Feet       |
| Taller Ceilings   | Circle All that Apply | GFTC | 9' Ceilings Ground Floor |
|                   |                       | MFTC | 10' Ceilings Main Floor  |
|                   |                       | SFTC | 9' Ceilings Second Floor |
| Optional Layouts  | Circle All that Apply |      |                          |
|                   |                       |      |                          |
|                   |                       |      |                          |

| Elevation        | Circle One            |  |  |
|------------------|-----------------------|--|--|
|                  |                       |  |  |
| Taller Ceilings  | Circle All that Apply |  |  |
|                  |                       |  |  |
|                  |                       |  |  |
| Optional Layouts | Circle All that Apply |  |  |
|                  |                       |  |  |
|                  |                       |  |  |

| Elevation        | Circle One            |  |  |
|------------------|-----------------------|--|--|
|                  |                       |  |  |
| Taller Ceilings  | Circle All that Apply |  |  |
|                  |                       |  |  |
|                  |                       |  |  |
| Optional Layouts | Circle All that Apply |  |  |
|                  |                       |  |  |
|                  |                       |  |  |

LOT 51L  
July 7 2016  
L.V. Plee