

**Kleinburg Glen - 53 - 1 - 38-4 Elev.B BRIDGEPORT
CENTRAL VAC AND WIRING**

Inv.664	1 - INSTALL VAC PAN UNDER KITCHEN SINK
Line8531	Note:
14Jul16 / 11Nov16	
Inv.664	1 - DEN: CAT 5 WIRING - ADD EXTRA OUTLET (PHONE ROUGH-IN) See plan for location.
Line8532	Note:
14Jul16 / 11Nov16	

ELECTRICAL

Inv.664	1 - KITCHEN: ROUGH - IN CEILING OUTLET ON SAME SWITCH - DOES NOT INCLUDE FIXTURE - Locate above island, use same switch as standard ceiling light. See plan for location.
Line8537	Note:
14Jul16 / 11Nov16	
Inv.664	1 - GREAT ROOM: Single pole switch for pot lights in great room. See plan for location.
Line8543	Note:
14Jul16 / 11Nov16	
Inv.664	1 - KITCHEN: Single pole switch for potlights in kitchen. See plan for location.
Line8539	Note:
14Jul16 / 11Nov16	
Inv.664	1 - KITCHEN: 110V WALL RECEPTACLE ON DEDICATED CIRCUIT - For future 600+ cfm hood fan.
Line8545	Note:
14Jul16 / 11Nov16	
Inv.664	1 - KITCHEN: RELOCATE STANDARD FIXTURE - locate above island, see plan for location.
Line8536	Note:
14Jul16 / 11Nov16	
Inv.664	6 - KITCHEN: POT LIGHT: 4 INCH HALOGEN POT LIGHT - 440 WH - PRICED PER LIGHT - 10 OR MORE. See plan for location.
Line8538	Note:
14Jul16 / 11Nov16	
Inv.664	1 - KITCHEN: 110V WALL RECEPTACLE ON DEDICATED CIRCUIT - FOR MICROWAVE - MICROWAVE NOT INCLUDED. Locate beside fridge. See plan for location.
Line8544	Note:
14Jul16 / 11Nov16	
Inv.664	4 - GREAT ROOM: POT LIGHT: 4 INCH HALOGEN POT LIGHT - 440 WH - PRICED PER LIGHT - 10 OR MORE. See plan for location.
Line8542	Note:
14Jul16 / 11Nov16	
Inv.782	1 - KITCHEN: 110V WALL RECEPTACLE ON DEDICATED CIRCUIT - GAS FIRED APPLIANCE - FOR AUX. EQUIPMENT - NOT A STOVE PLUG
Line10529	Note:
23Aug16 / 11Nov16	

EXTERIOR COLOURS

Inv.664	1 - EXTERIOR COLOUR PACKAGE 11
Line13830	Note:
14Jul16 / 11Nov16	

FRAMING

Kleinburg Glen - 53 - 1 - 38-4 Elev.B BRIDGEPORT

Inv.664	4 - MAIN FLOOR FRAME MAIN FLOOR ARCHES AT 96"
Line8549	Note:
14Jul16 / 11Nov16	

Inv.664	1 - MANDOOR - GARAGE TO HOUSE - AS PER PLAN AND GRADE PERMITING
Line13831	Note: AS PER APS
14Jul16 / 11Nov16	

HVAC

Inv.664	1 - KITCHEN: UPGRADE VENTING FOR STOVE TO 8 INCH PIPE EXTERIOR WALL
Line8547	Note:
14Jul16 / 11Nov16	

Inv.664	1 - KITCHEN: GAS LINE ROUGH - GROUND FLOOR for future gas stove.
Line8546	Note:
14Jul16 / 11Nov16	

Inv.664	1 - HUMIDIFIER: WB3 - 17 (UP TO 3,000 SQ.FT.)
Line8548	Note:
14Jul16 / 11Nov16	

INTERIOR TRIM AND DOORS

Inv.664	4 - MAIN FLOOR: EXTENDED HEIGHT ARCHWAY (PRICE PER DOORWAY) - 96"
Line8550	Note:
14Jul16 / 11Nov16	

KITCHEN AND BATH CABINETRY

Inv.664	1 - INSTALL VAC PAN UNDER KITCHEN SINK
Line13833	Note:
14Jul16 / 11Nov16	

MISC.

Inv.664	1 - Purchaser has attended a Structural appointment at the Decor Centre & has DECLINED any additional upgrades and accepts and acknowledges that there will be no further structural changes/additions/deletions to be made upon signing on July 14, 2016.
Line8557	Note:
14Jul16 / 11Nov16	

Inv.664	1 - Purchasers are aware & accepts that ANY changes made to upgrades after signing this Purchasers Extra Form are subject to a minimum administration fee of \$500. PLUS a 10% holdback fee.
Line8559	Note:
14Jul16 / 11Nov16	



Inv.664	1 - BONUS PACKAGE: \$7,500.00 (INCLUDING TAXES) WORTH OF UPGRADES FROM GOLD PARK HOMES DÉCOR CENTRE IS BEING APPLIED TOWARD THE STRUCTURAL APPOINTMENT. PURCHASER HAS A REMAINING AMOUNT OF \$115.45 (INCLUDING TAXES) TO BE USED TOWARD THE COLOUR APPOINTMENT.
Line8562	Note:
14Jul16 / 11Nov16	

WINDOWS AND DOORS

Inv.664	1 - MAN DOOR GARAGE TO HOUSE - OPTIONAL - IF GRADE PERMITS
Line13832	Note: AS PER APS
14Jul16 / 11Nov16	

Elevation A • 2,778 sq.ft.


Elevation B • 2,817 sq.ft.

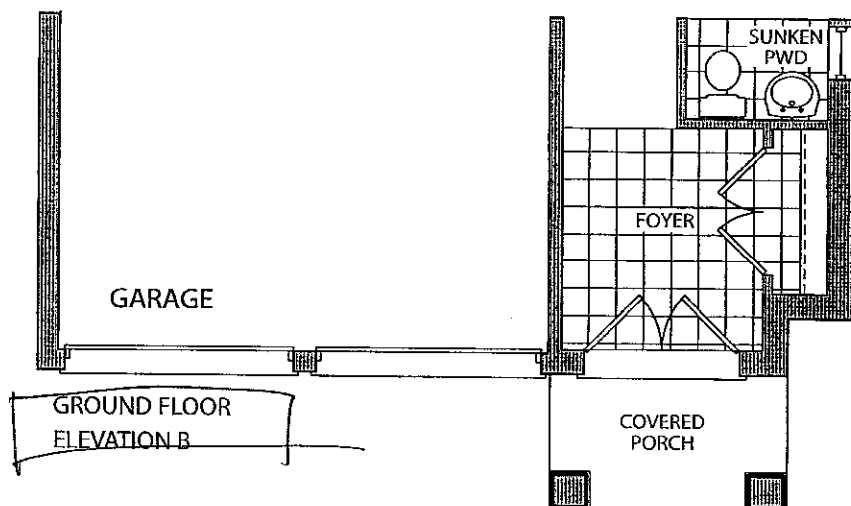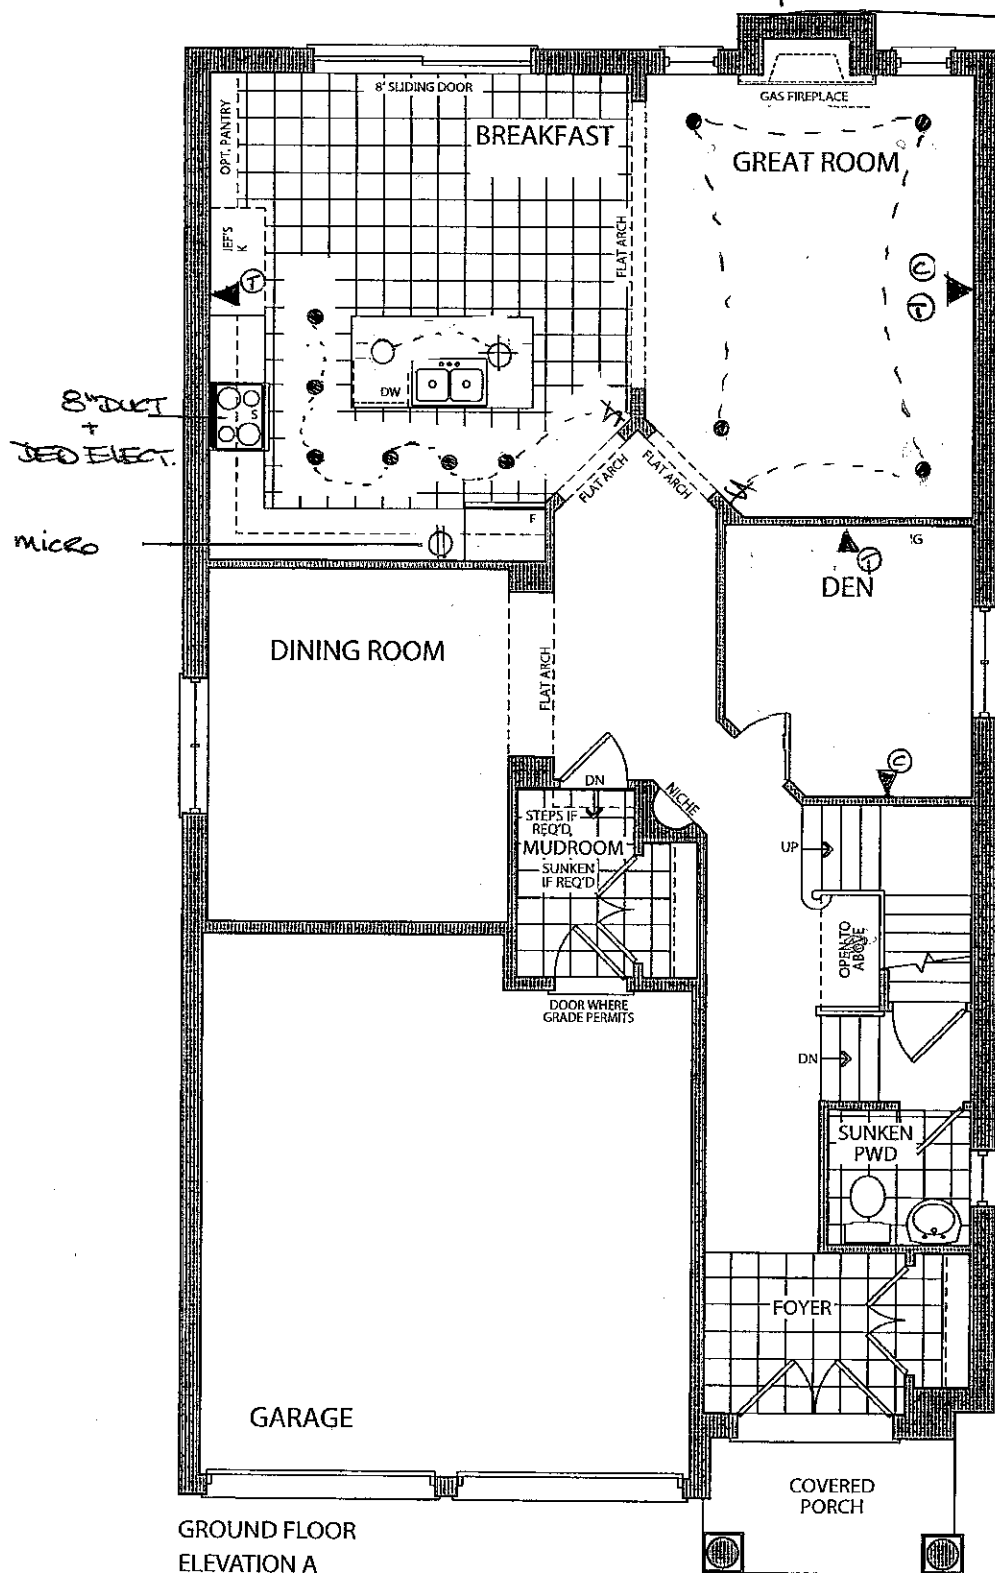


Lot 53

(Handwritten signatures)


July 14, 2016

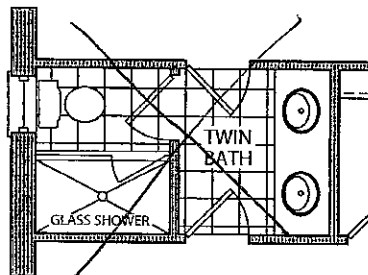

OPT. TWIN BATH
ELEVATION A & B

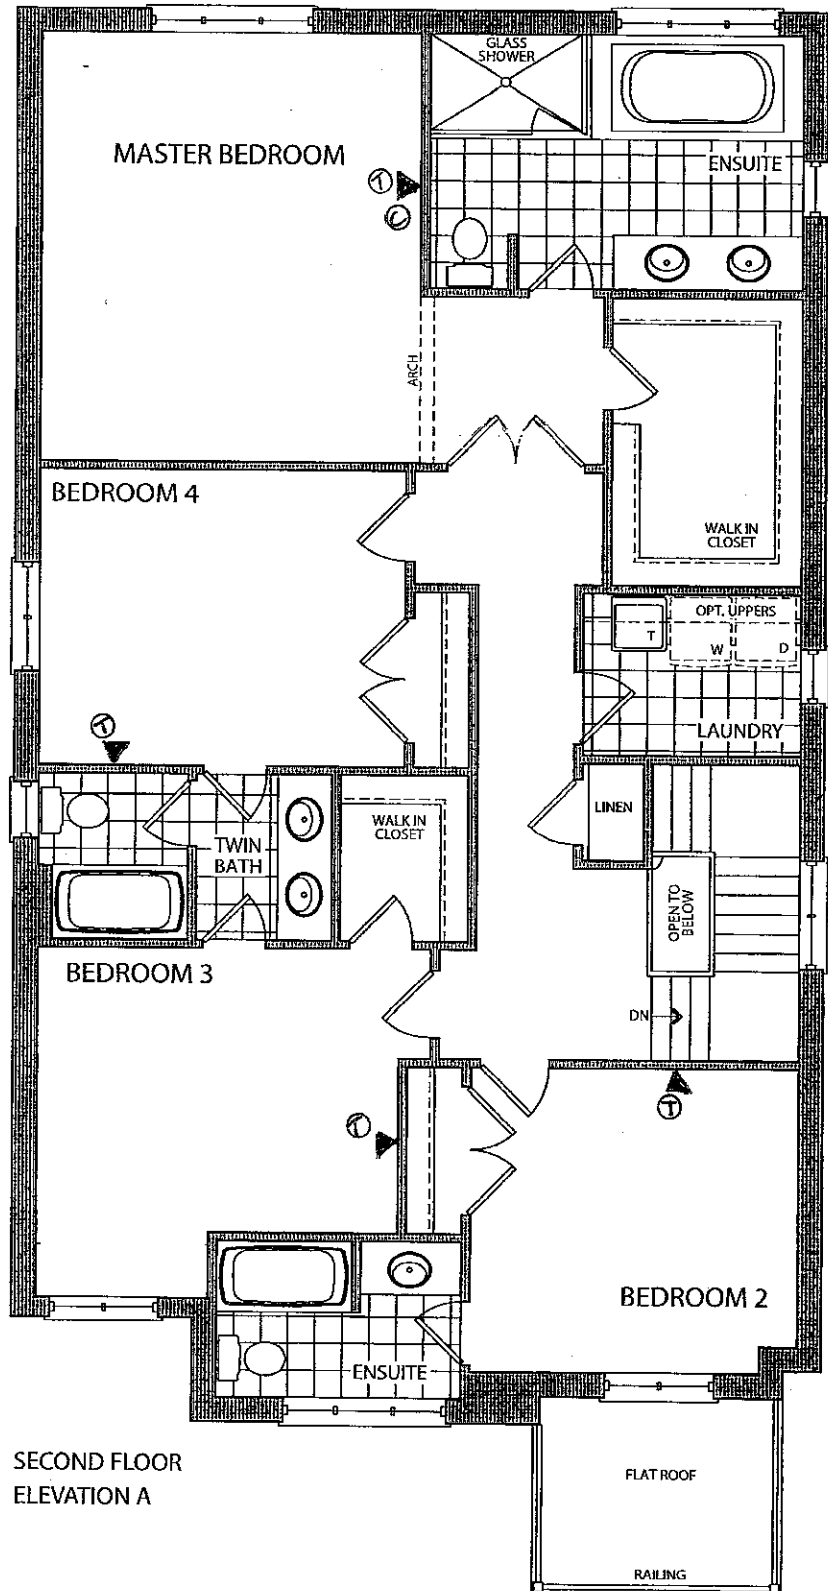

SECOND FLOOR
ELEVATION A

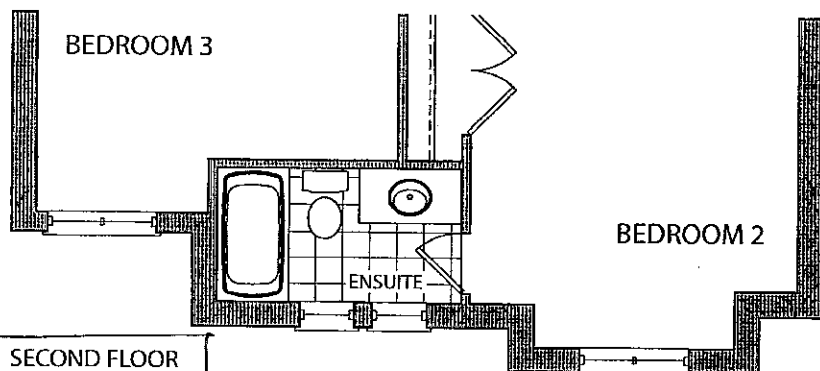

SECOND FLOOR
ELEVATION B


Lot 53



July 14, 2016

~~Elevation A • 2,778 sq.ft.~~

✓ Elevation B • 2,817 sq.ft.

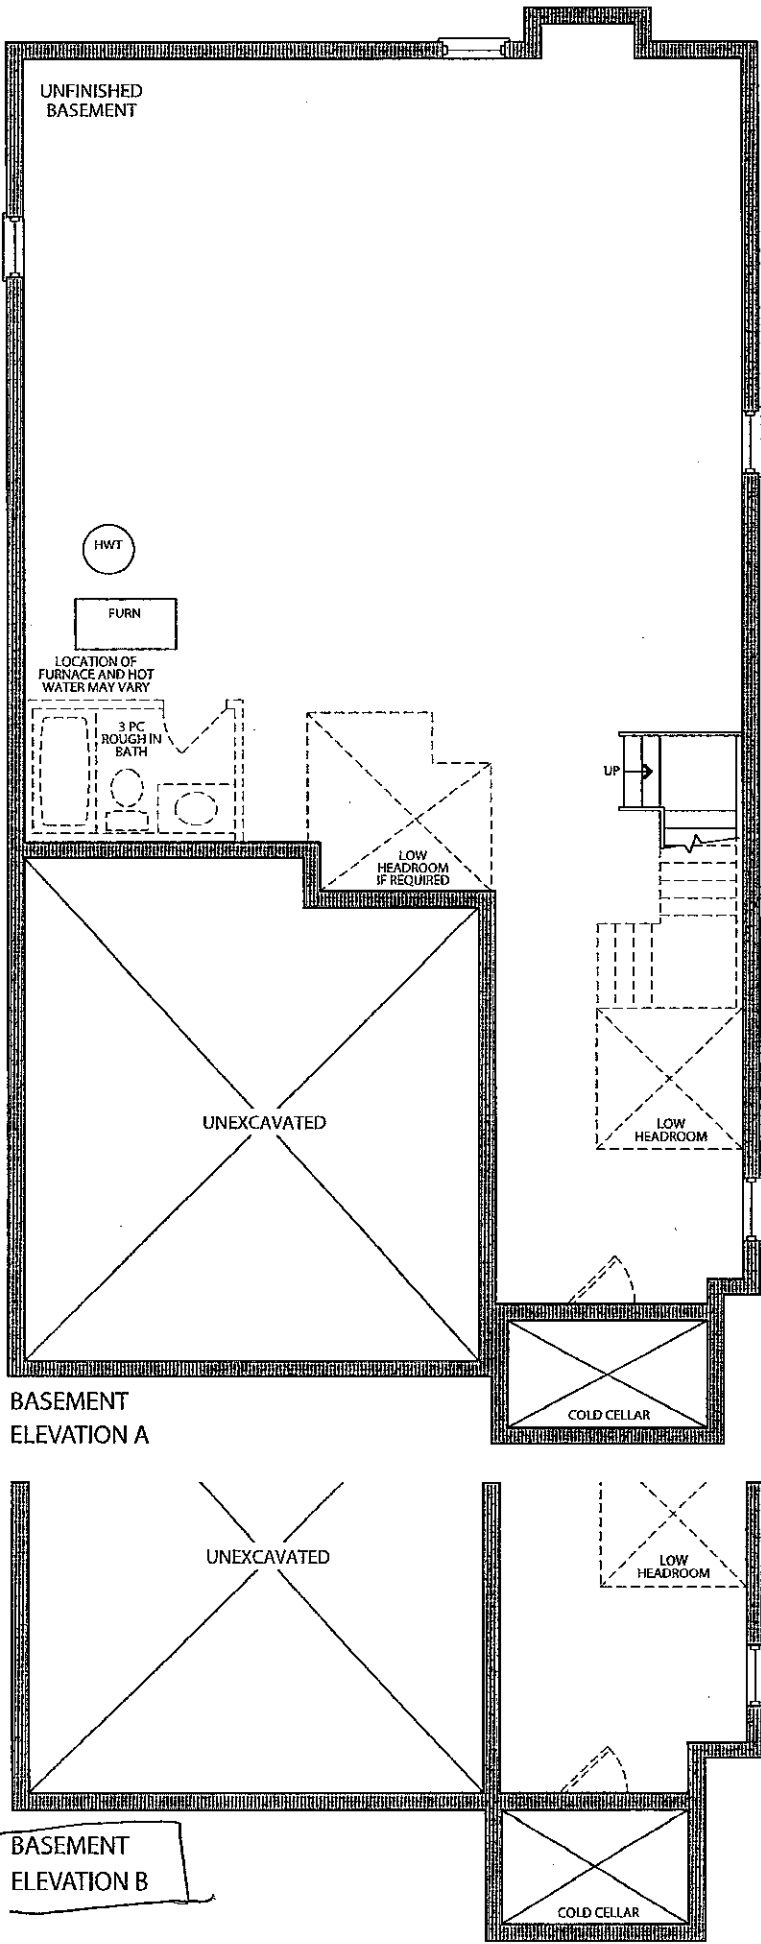

Lot 53



July 14, 2016



Stacey Carlete
Project Coordinator



Claude Azzopardi
Contracts Manager



Nancy Martini
Corporate Controller



38.1 The Hampton			
Elevation	Circle One	A	2339.9 Square Feet
		B	2327.8 Square Feet
Taller Ceilings	Circle All that Apply	GFTC	9' Ceilings Ground Floor
		MFTC	10' Ceilings Main Floor
		SFTC	9' Ceilings Second Floor
Optional Layouts	Circle All that Apply		

38.2 The Kingston			
Elevation	Circle One	A	2445.9 Square Feet
		B	2445.9 Square Feet
Taller Ceilings	Circle All that Apply	GFTC	9' Ceilings Ground Floor
		MFTC	10' Ceilings Main Floor
		SFTC	9' Ceilings Second Floor
Optional Layouts	Circle All that Apply	SFA1	SECOND FLOOR Shower in Lieu of Tub (Bedroom 2)

38.3 The Birkdale			
Elevation	Circle One	A	2574.1 Square Feet
		B	2575.5 Square Feet
Taller Ceilings	Circle All that Apply	GFTC	9' Ceilings Ground Floor
		MFTC	10' Ceilings Main Floor
		SFTC	9' Ceilings Second Floor
Optional Layouts	Circle All that Apply	SFA1	SECOND FLOOR Shower in Lieu of Tub (Bedroom 2)

38.4 The Bridgeport			
Elevation	Circle One	A	2723.2 Square Feet
		<u>B</u>	<u>2707</u> 2702.0 Square Feet
Taller Ceilings	Circle All that Apply	GFTC	9' Ceilings Ground Floor
		MFTC	10' Ceilings Main Floor
		SFTC	9' Ceilings Second Floor
Optional Layouts	Circle All that Apply	SFA3	SECOND FLOOR Shower in Lieu of Tub (Twin Bath)

38.5 The Rosemont			
Elevation	Circle One	A	2804.9 Square Feet
		B	2804.5 Square Feet
Taller Ceilings	Circle All that Apply	GFTC	9' Ceilings Ground Floor
		MFTC	10' Ceilings Main Floor
		SFTC	9' Ceilings Second Floor
Optional Layouts	Circle All that Apply	SFA1	SECOND FLOOR Shower in Lieu of Tub (Bedroom 2)
		SFA3	SECOND FLOOR Shower in Lieu of Tub (Twin Bath)
		SFA5	SECOND FLOOR Additional Bedroom

38.6 The Wyndham			
Elevation	Circle One	A	2893.5 Square Feet
		B	2896.0 Square Feet
Taller Ceilings	Circle All that Apply	GFTC	9' Ceilings Ground Floor
		MFTC	10' Ceilings Main Floor
		SFTC	9' Ceilings Second Floor
Optional Layouts	Circle All that Apply	SFA1	SECOND FLOOR Shower in Lieu of Tub (Bedroom 2)
		SFA3	SECOND FLOOR Shower in Lieu of Tub (Twin Bath)
		SFA5	SECOND FLOOR Additional Bedroom

* LOOK-OUT BASEMENT.

Lot 53

July 14, 2016