

Kleinburg Glen - 55 - 1 - 38-2 Elev.B KINGSTON
CENTRAL VAC AND WIRING

Inv.723	1 - Main Hall: ROUGH - IN FOR EXTRA SECURITY KEY PAD at garage to house door. See plan for location.
Line9790	Note:
4Aug16 / 11Nov16	

ELECTRICAL

Inv.723	1 - KITCHEN: RELOCATE STANDARD FIXTURE - Locate above island, see plan for location.
Line9791	Note:
4Aug16 / 11Nov16	
Inv.723	1 - KITCHEN: ROUGH - IN CEILING OUTLET ON SAME SWITCH - DOES NOT INCLUDE FIXTURE - Locate above island, use same switch as standard light. See plan for location.
Line9792	Note:
4Aug16 / 11Nov16	
Inv.723	1 - KITCHEN: 110V WALL RECEPTACLE ON DEDICATED CIRCUIT - FOR MICROWAVE - MICROWAVE & CABINETRY CUSTOMIZATION NOT INCLUDED. See plan for location. (future microwave shelf)
Line9793	Note:
4Aug16 / 11Nov16	
Inv.723	1 - 200 AMP ELECTRICAL SERVICE
Line9794	Note:
4Aug16 / 11Nov16	

EXTERIOR COLOURS

Inv.723	1 - EXTERIOR COLOUR PACKAGE 5
Line13817	Note:
4Aug16 / 11Nov16	

FRAMING

Inv.723	4 - MAIN FLOOR; FRAME MAIN FLOOR ARCHES AT 96 INCH
Line9798	Note:
4Aug16 / 11Nov16	
Inv.723	1 - MANDOOR - GARAGE TO HOUSE - AS PER PLAN AND GRADE PERMITING
Line13818	Note: AS PER APS
4Aug16 / 11Nov16	

GLASS AND MIRROR

Inv.723	1 - MASTER ENSUITE: CONVERT FRAMED SHOWER TO 10MM FRAMLESS SHOWER ENCLOSURE WITH DOOR AND 10MM SIDE PANEL
Line9795	Note:
4Aug16 / 11Nov16	

HVAC

Inv.723	1 - HUMIDIFIER: WB3 - 17 (UP TO 3,000 SQ.FT.)
Line9803	Note:
4Aug16 / 11Nov16	

INTERIOR TRIM AND DOORS

Kleinburg Glen - 55 - 1 - 38-2 Elev.B KINGSTON

Inv.723	4 - MAIN FLOOR: EXTENDED HEIGHT ARCHWAY (PRICE PER DOORWAY) - 96"
Line9799	Note:
4Aug16 / 11Nov16	

MISC.

Inv.723	1 - Purchaser has attended a Structural appointment at the Decor Centre & has DECLINED any additional upgrades and accepts and acknowledges that there will be no further structural changes/additions/deletions to be made upon signing on August 4, 2016
Line9800	Note:
4Aug16 / 11Nov16	

Inv.723	1 - Purchasers are aware & accepts that ANY changes made to upgrades after signing this Purchasers Extra Form are subject to a minimum administration fee of \$500. PLUS a 10% holdback fee.
Line9801	Note:
4Aug16 / 11Nov16	

Inv.723	1 - BONUS PACKAGE: \$7,500.00 (INCLUDING TAXES) WORTH OF UPGRADES FROM GOLD PARK HOMES DÉCOR CENTRE IS BEING APPLIED TOWARD THE STRUCTURAL APPOINTMENT. PURCHASER HAS A REMAINING AMOUNT OF \$946.00 (INCLUDING TAXES) TO BE USED TOWARD THE COLOUR APPOINTMENT.
Line9802	Note:
4Aug16 / 11Nov16	

WINDOWS - BASEMENT


Inv.723	2 - BASEMENT WINDOWS - EXTRA BASEMENT WINDOW 30 INCH X 12 INCH *MOVE* standard window location and add 2 windows so they are equidistant and symmetrical. See plan for location.
Line9797	Note:
4Aug16 / 11Nov16	

WINDOWS AND DOORS

Inv.723	1 - MAN DOOR GARAGE TO HOUSE - OPTIONAL - IF GRADE PERMITS
Line13819	Note: AS PER APS
4Aug16 / 11Nov16	

the *Kingston*




Elevation A • 2,495 sq.ft.
Elevation B • 2,495 sq.ft.

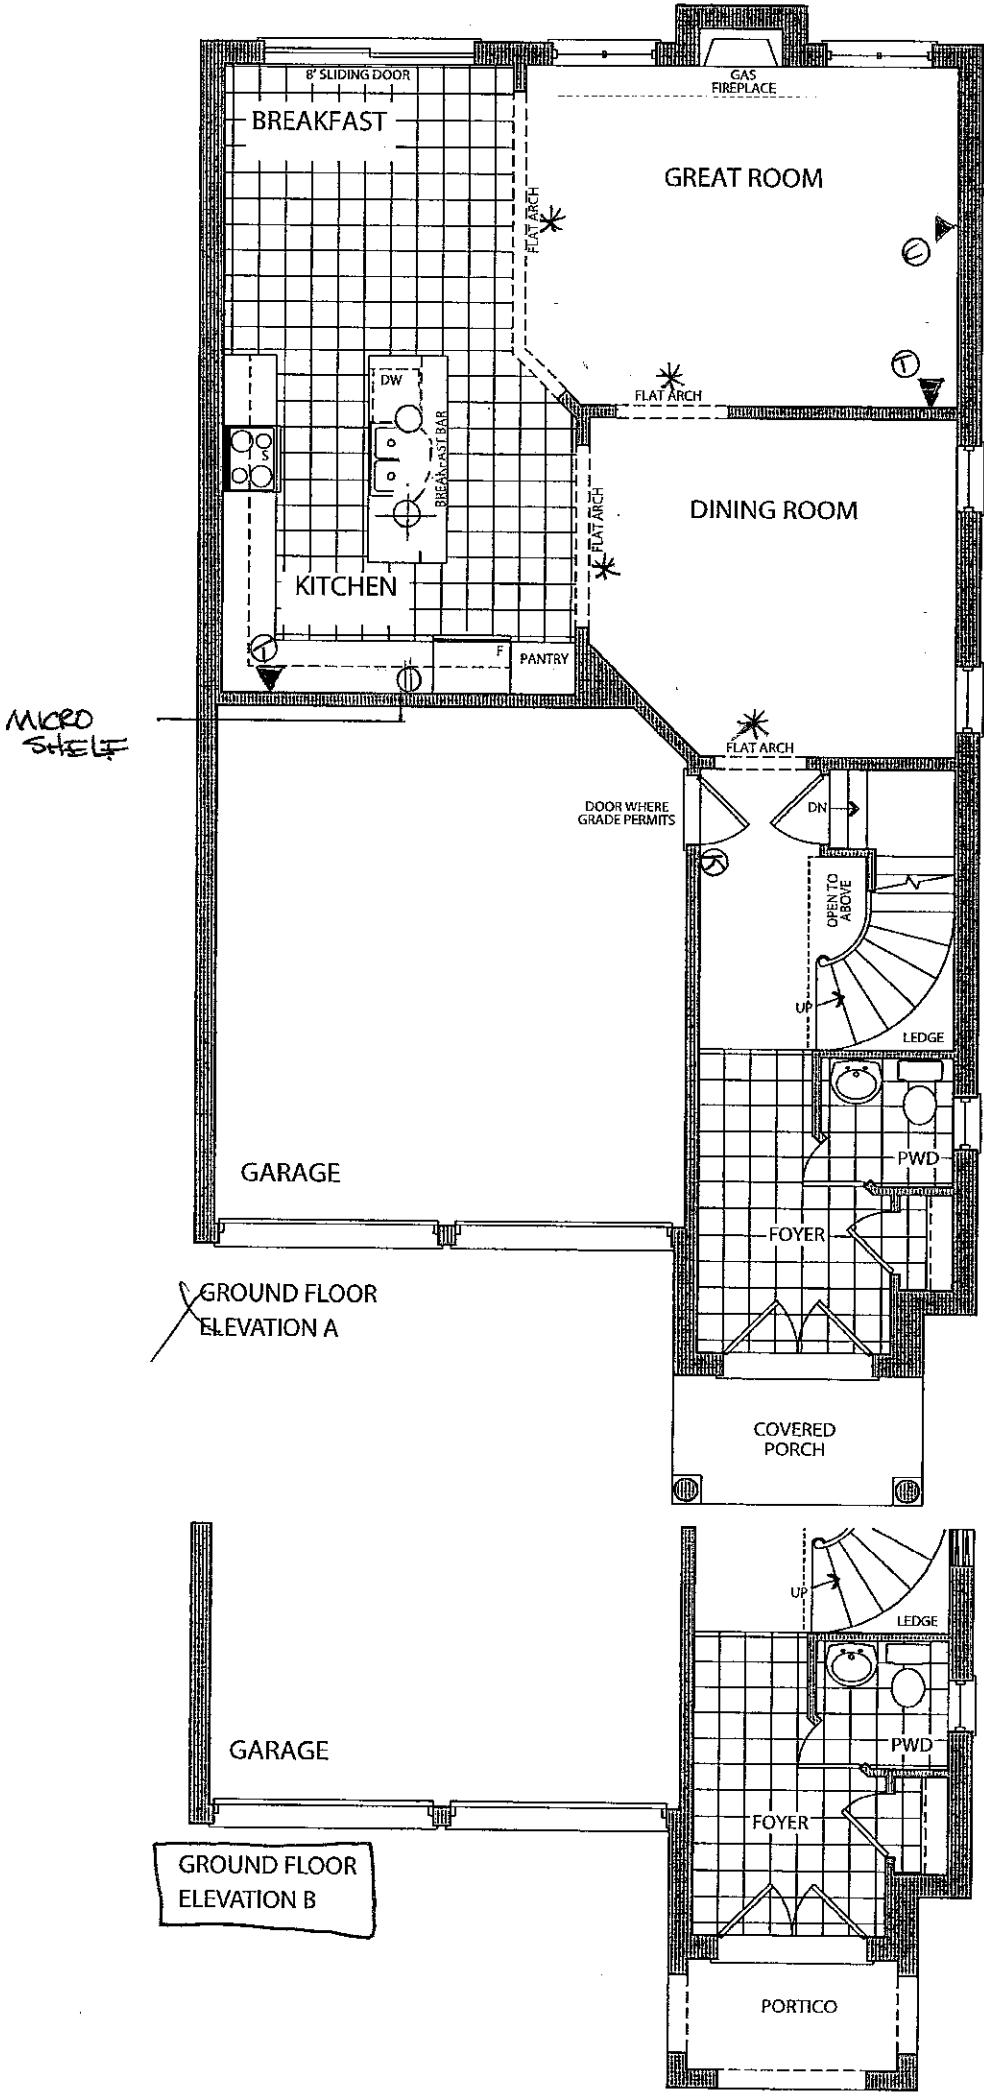

Prices, figures, illustrations, sizes, features and finishes are subject to change without notice. E.&O.E. Areas and dimensions are approximate and actual usable floor space may vary from the stated area. Layout may be reverse of the unit purchased. E. & O.E.

~~X~~ **Elevation A • 2,495 sq.ft.**

Elevation B • **2,495** sq.ft.

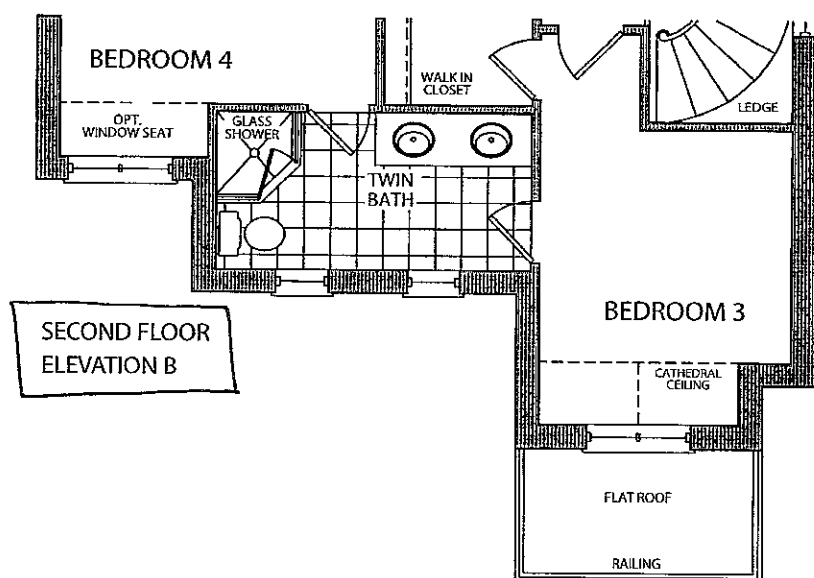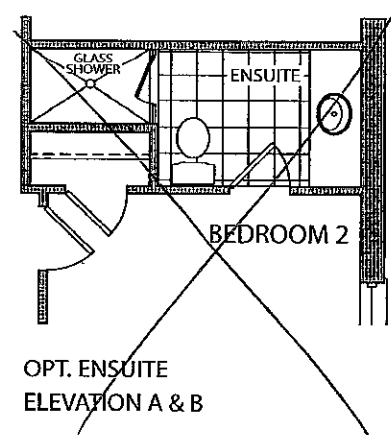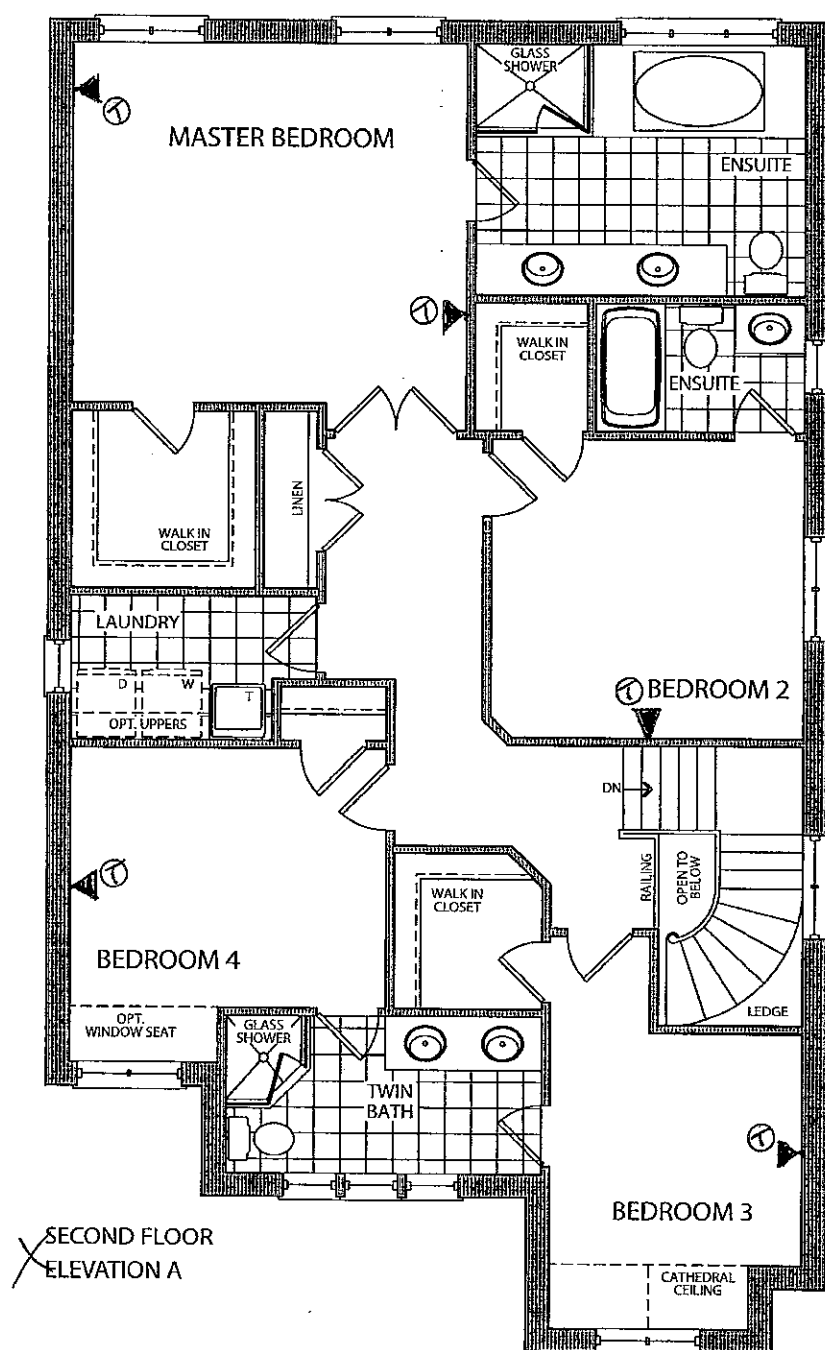


AUGUST 4 2016
LOT 55

22

*Elevation A • 2,495 sq.ft.

Elevation B • 2,495 sq.ft.

LOCATION
* WINDOWS to be
symmetrical

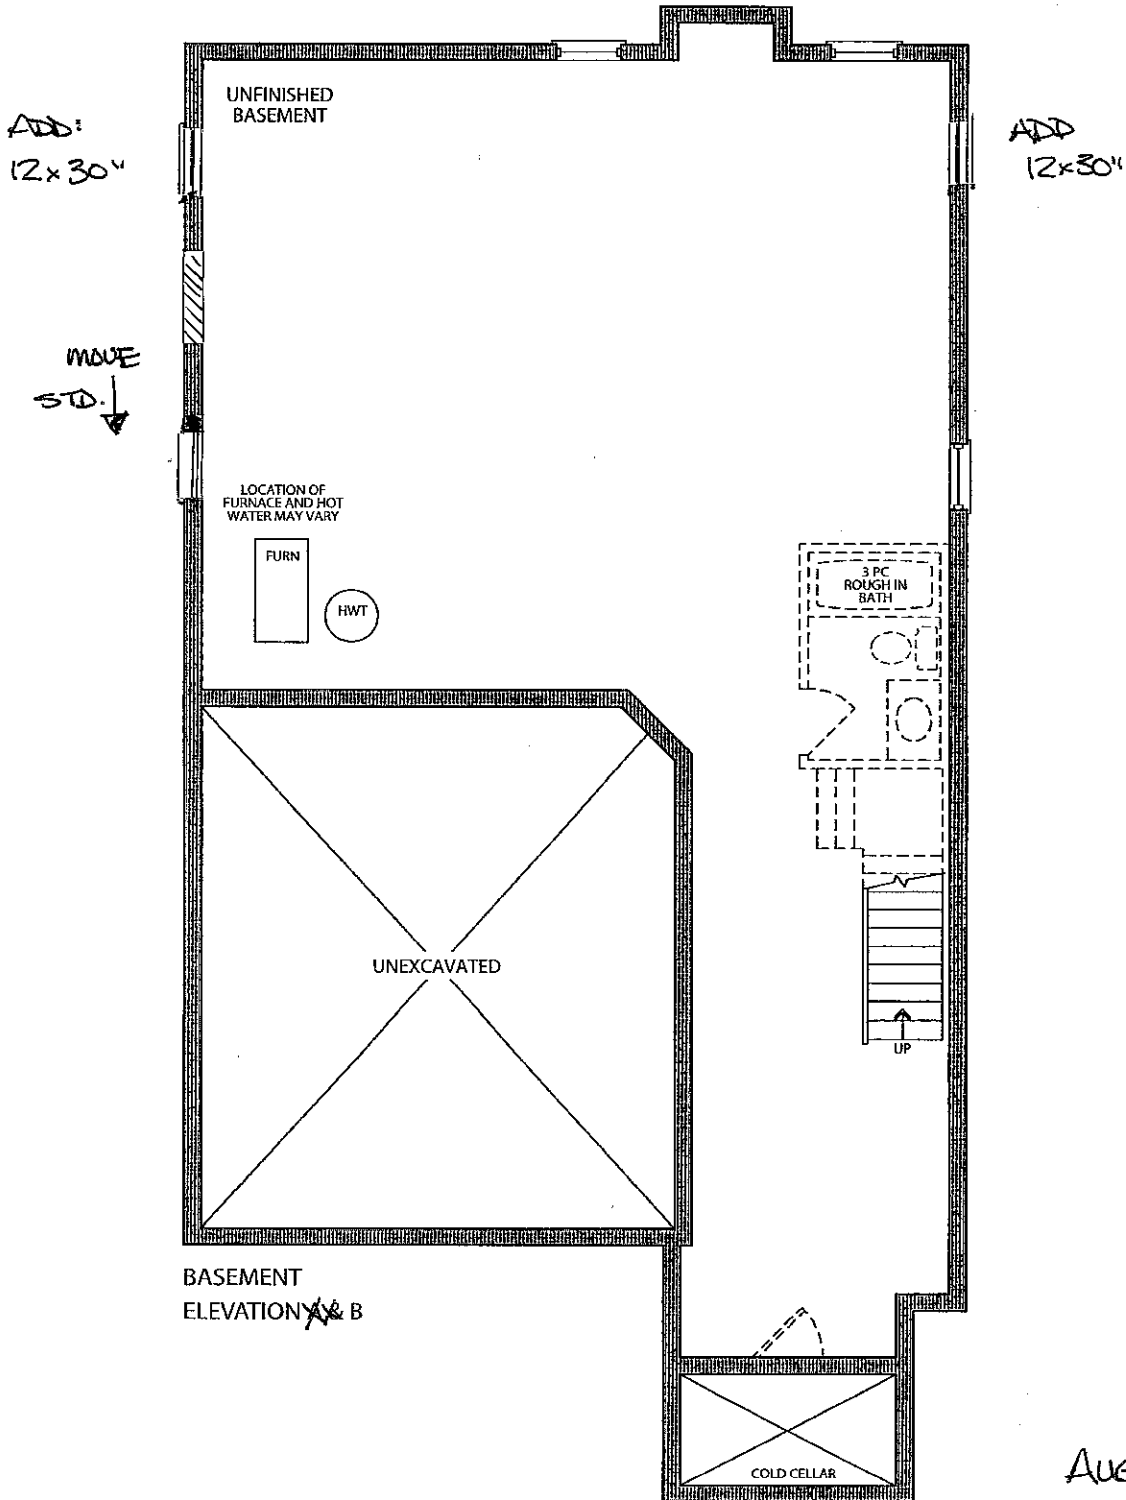

AUG. 4 2016
LOT 55

(X13)



Stacey Carlete
Project Coordinator



Claude Azzopardi
Contracts Manager



Nancy Martini
Corporate Controller



38.1 The Hampton			
Elevation	Circle One	A	2339.9 Square Feet
		B	2327.8 Square Feet
Taller Ceilings	Circle All that Apply	GFTC	9' Ceilings Ground Floor
		MFTC	10' Ceilings Main Floor
		SFTC	9' Ceilings Second Floor
Optional Layouts	Circle All that Apply		

38.2 The Kingston			
Elevation	Circle One	A	2445.9 Square Feet
		B	2445.9 Square Feet
Taller Ceilings	Circle All that Apply	GFTC	9' Ceilings Ground Floor
		MFTC	10' Ceilings Main Floor
		SFTC	9' Ceilings Second Floor
Optional Layouts	Circle All that Apply	SFA1	SECOND FLOOR Shower in Lieu of Tub (Bedroom 2)

38.3 The Birkdale			
Elevation	Circle One	A	2574.1 Square Feet
		B	2575.5 Square Feet
Taller Ceilings	Circle All that Apply	GFTC	9' Ceilings Ground Floor
		MFTC	10' Ceilings Main Floor
		SFTC	9' Ceilings Second Floor
Optional Layouts	Circle All that Apply	SFA1	SECOND FLOOR Shower in Lieu of Tub (Bedroom 2)

38.4 The Bridgeport			
Elevation	Circle One	A	2723.2 Square Feet
		B	2762.0 Square Feet
Taller Ceilings	Circle All that Apply	GFTC	9' Ceilings Ground Floor
		MFTC	10' Ceilings Main Floor
		SFTC	9' Ceilings Second Floor
Optional Layouts	Circle All that Apply	SFA3	SECOND FLOOR Shower in Lieu of Tub (Twin Bath)

38.5 The Rosemont			
Elevation	Circle One	A	2804.9 Square Feet
		B	2804.5 Square Feet
Taller Ceilings	Circle All that Apply	GFTC	9' Ceilings Ground Floor
		MFTC	10' Ceilings Main Floor
		SFTC	9' Ceilings Second Floor
Optional Layouts	Circle All that Apply	SFA1	SECOND FLOOR Shower in Lieu of Tub (Bedroom 2)
		SFA3	SECOND FLOOR Shower in Lieu of Tub (Twin Bath)
		SFA5	SECOND FLOOR Additional Bedroom

38.6 The Wyndham			
Elevation	Circle One	A	2893.5 Square Feet
		B	2896.0 Square Feet
Taller Ceilings	Circle All that Apply	GFTC	9' Ceilings Ground Floor
		MFTC	10' Ceilings Main Floor
		SFTC	9' Ceilings Second Floor
Optional Layouts	Circle All that Apply	SFA1	SECOND FLOOR Shower in Lieu of Tub (Bedroom 2)
		SFA3	SECOND FLOOR Shower in Lieu of Tub (Twin Bath)
		SFA5	SECOND FLOOR Additional Bedroom

August 4 2016
LOT 55
KMS