

**Kleinburg Glen - 56 - 1 - 38-6 Elev.A WYNDHAM  
CENTRAL VAC AND WIRING**

Inv.749	1 - LAUNDRY ROOM: ROUGH - IN FOR EXTRA SECURITY KEY PAD
Line10097	Note:
16Aug16 / 11Nov16	
Inv.749	1 - BEDROOM 3: CAT 5 WIRING - ADD EXTRA OUTLET. See plan for location.
Line10104	Note:
16Aug16 / 11Nov16	

**ELECTRICAL**

Inv.749	1 - KITCHEN: RELOCATE STANDARD FIXTURE - MUST PROVIDE LOCATION Move to above island. See plan for location.
Line10100	Note:
16Aug16 / 11Nov16	
Inv.749	1 - KITCHEN: ROUGH - IN CEILING OUTLET ON SAME SWITCH - DOES NOT INCLUDE FIXTURE - Locate above island, use same switch as standard light.
Line10101	Note:
16Aug16 / 11Nov16	
Inv.749	1 - KITCHEN CABINET VALANCE LIGHTS (UNDER CABINETS) - WITH STRIP LIGHTS - DOES NOT INCLUDE (AND REQUIRES) KITCHEN UPGRADE PRICING
Line10112	Note:
16Aug16 / 11Nov16	

**EXTERIOR COLOURS**

Inv.749	1 - EXTERIOR COLOUR PACKAGE 1
Line13814	Note:
16Aug16 / 11Nov16	

**FRAMING**

Inv.749	2 - MAIN FLOOR: FRAME MAIN FLOOR ARCHES AT 96 INCH
Line10114	Note:
16Aug16 / 11Nov16	
Inv.749	1 - MANDOOR - GARAGE TO HOUSE - AS PER PLAN AND GRADE PERMITING
Line13815	Note: AS PER APS
16Aug16 / 11Nov16	

**INTERIOR TRIM AND DOORS**

Inv.749	2 - MAIN FLOOR: EXTENDED HEIGHT ARCHWAY (PRICE PER DOORWAY) - INCREASE TO 96"
Line10115	Note:
16Aug16 / 11Nov16	

**MISC.**

Inv.749	1 - Purchaser has attended a Structural appointment at the Decor Centre & has DECLINED any additional upgrades and accepts and acknowledges that there will be no further structural changes/additions/deletions to be made upon signing on August 16, 2016.
Line10109	Note:
16Aug16 / 11Nov16	
Inv.749	1 - Purchasers are aware & accepts that ANY changes made to upgrades after signing this Purchasers Extra Form are subject to a minimum administration fee of \$500. PLUS a 10% holdback fee.
Line10110	Note:
16Aug16 / 11Nov16	

**Kleinburg Glen - 56 - 1 - 38-6 Elev.A WYNDHAM**

Inv.749	1 - BONUS PACKAGE: \$7,500.00 (INCLUDING TAXES) WORTH OF UPGRADES FROM GOLD PARK HOMES DÉCOR CENTRE IS BEING APPLIED TOWARD THE STRUCTURAL APPOINTMENT. PURCHASER HAS A REMAINING AMOUNT OF \$5042.25 (INCLUDING TAXES) TO BE USED TOWARD THE COLOUR APPOINTMENT.
Line10111	Note:
16Aug16 / 11Nov16	

**WINDOWS - BASEMENT**


Inv.749	1 - BASEMENT WINDOWS - EXTRA BASEMENT WINDOW 30 INCH X 12 INCH. See plan for location.
Line10119	Note:
16Aug16 / 11Nov16	

**WINDOWS AND DOORS**

Inv.749	1 - MAN DOOR GARAGE TO HOUSE - OPTIONAL - IF GRADE PERMITS
Line13816	Note: AS PER APS
16Aug16 / 11Nov16	



**Elevation B • 2,954 sq.ft.**

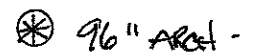


LOT 56




Elevation A • 2,951 sq.ft.

Elevation B • 2,954 sq.ft.

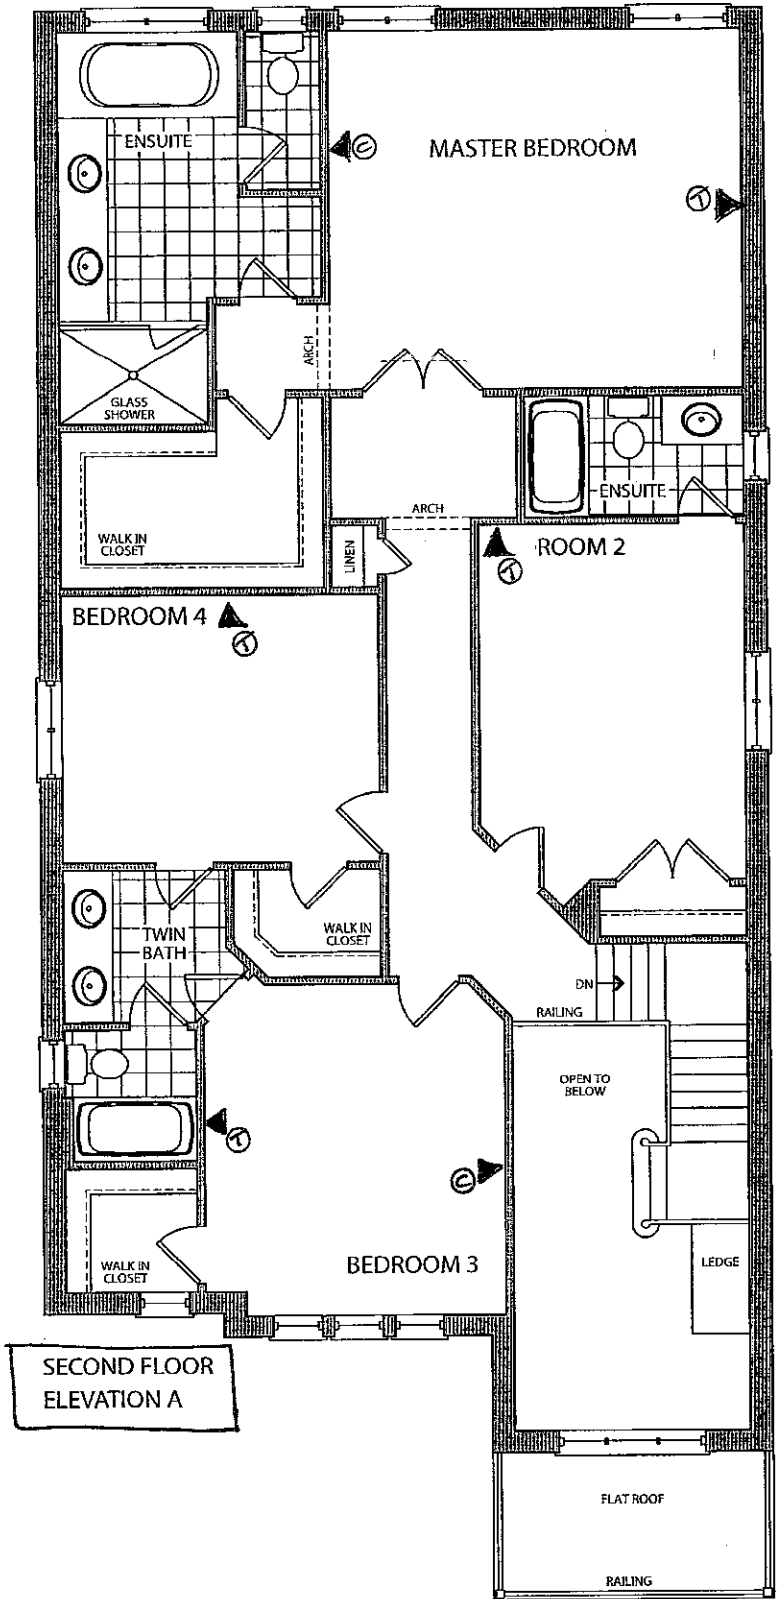


SECOND FLOOR  
ELEVATION A

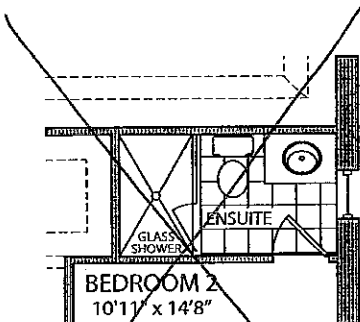

OPT. ENSUITE  
ELEVATION A & B

AUG. 16 2016

LOT 56

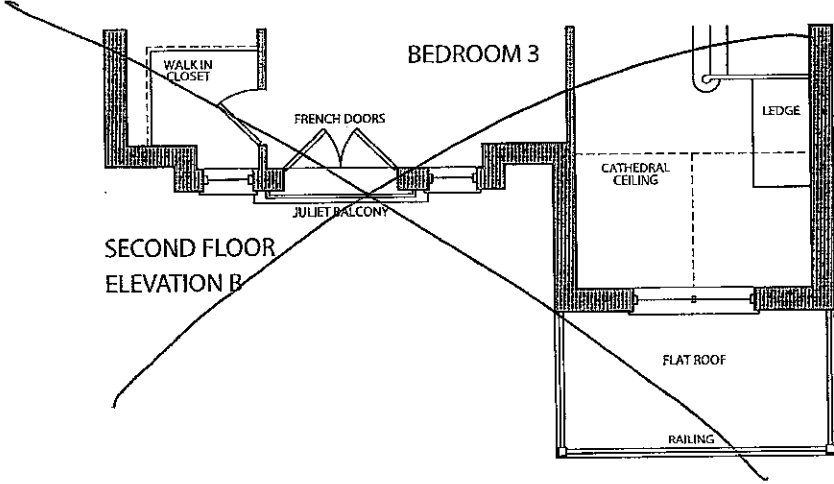


SECOND FLOOR  
ELEVATION B

Prices, figures, illustrations, sizes, features and finishes are subject to change without notice. E.&O.F. Areas and dimensions are approximate and actual usable floor space may vary from the stated area. Layout may be reverse of the unit purchased. E. & O.E.

Elevation A • 2,951 sq.ft.

Elevation B • 2,954 sq.ft.

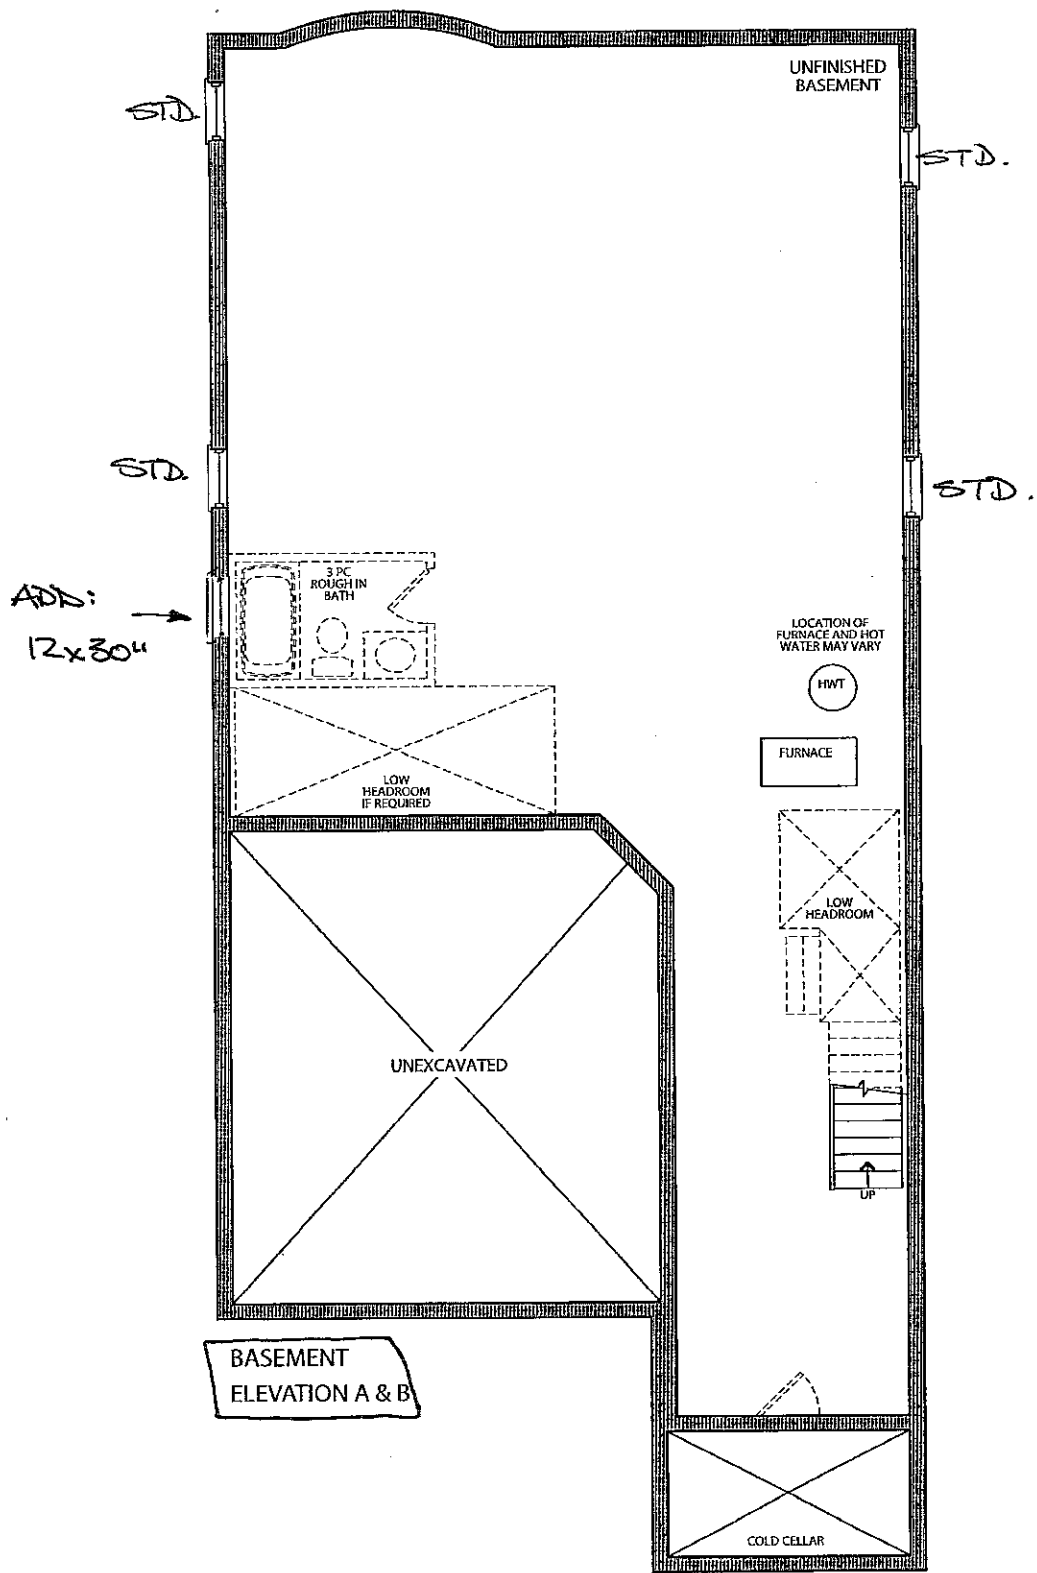

AUGUST 16 2016  
LOT 56



Stacey Carlete  
Project Coordinator



Claude Azzopardi  
Contracts Manager



Nancy Martini  
Corporate Controller



38.1 The Hampton			
Elevation	Circle One	A	2339.9 Square Feet
		B	2327.8 Square Feet
Taller Ceilings	Circle All that Apply	GFTC	9' Ceilings Ground Floor
		MFTC	10' Ceilings Main Floor
		SFTC	9' Ceilings Second Floor
Optional Layouts	Circle All that Apply		

38.2 The Kingston			
Elevation	Circle One	A	2445.9 Square Feet
		B	2445.9 Square Feet
Taller Ceilings	Circle All that Apply	GFTC	9' Ceilings Ground Floor
		MFTC	10' Ceilings Main Floor
		SFTC	9' Ceilings Second Floor
Optional Layouts	Circle All that Apply	SFA1	SECOND FLOOR Shower in Lieu of Tub (Bedroom 2)

38.3 The Birkdale			
Elevation	Circle One	A	2574.1 Square Feet
		B	2575.5 Square Feet
Taller Ceilings	Circle All that Apply	GFTC	9' Ceilings Ground Floor
		MFTC	10' Ceilings Main Floor
		SFTC	9' Ceilings Second Floor
Optional Layouts	Circle All that Apply	SFA1	SECOND FLOOR Shower in Lieu of Tub (Bedroom 2)

38.4 The Bridgeport			
Elevation	Circle One	A	2723.2 Square Feet
		B	2762.0 Square Feet
Taller Ceilings	Circle All that Apply	GFTC	9' Ceilings Ground Floor
		MFTC	10' Ceilings Main Floor
		SFTC	9' Ceilings Second Floor
Optional Layouts	Circle All that Apply	SFA3	SECOND FLOOR Shower in Lieu of Tub (Twin Bath)

38.5 The Rosemont			
Elevation	Circle One	A	2804.9 Square Feet
		B	2804.5 Square Feet
Taller Ceilings	Circle All that Apply	GFTC	9' Ceilings Ground Floor
		MFTC	10' Ceilings Main Floor
		SFTC	9' Ceilings Second Floor
Optional Layouts	Circle All that Apply	SFA1	SECOND FLOOR Shower in Lieu of Tub (Bedroom 2)
		SFA3	SECOND FLOOR Shower in Lieu of Tub (Twin Bath)
		SFA5	SECOND FLOOR Additional Bedroom

38.6 The Wyndham			
Elevation	Circle One	A	2893.5 Square Feet
		B	2896.0 Square Feet
Taller Ceilings	Circle All that Apply	GFTC	9' Ceilings Ground Floor
		MFTC	10' Ceilings Main Floor
		SFTC	9' Ceilings Second Floor
Optional Layouts	Circle All that Apply	SFA1	SECOND FLOOR Shower in Lieu of Tub (Bedroom 2)
		SFA3	SECOND FLOOR Shower in Lieu of Tub (Twin Bath)
		SFA5	SECOND FLOOR Additional Bedroom

AUGUST 16 2016  
LOT 56

