

Kleinburg Glen - 58 - 1 - 38-6 Elev.A WYNDHAM
CENTRAL VAC AND WIRING

Inv.671	2 - LAUNDRY ROOM & UPPER HALL: ROUGH - IN FOR EXTRA SECURITY KEY PAD. See plan for locations.
Line8723	Note:
16Jul16 / 18Oct16	
Inv.671	1 - KITCHEN: INSTALL VAC PAN UNDER KITCHEN SINK
Line8724	Note:
16Jul16 / 18Oct16	
Inv.671	1 - GREAT ROOM: CONDUIT PIPE - FOR TELEVISION -Locate above fireplace, approx. 60" A.F.F., terminating on right side of fireplace by cable outlet. See plan for location.
Line8725	Note:
16Jul16 / 18Oct16	
Inv.671	1 - MAIN HALL: rough in additional motion sensor. See plan for location.
Line8912	Note:
16Jul16 / 18Oct16	

DRYWALL

Inv.671	1 - SMOOTH CEILINGS - (2 - Story Design) 2ND FLOOR
Line8736	Note:
16Jul16 / 18Oct16	

ELECTRICAL

Inv.671	1 - GREAT ROOM: 110V WALL RECEPTACLE ON NORMAL CIRCUIT Locate above fireplace, approx. 60" A.F.F. for future TV. See sketch for location
Line8726	Note:
16Jul16 / 18Oct16	
Inv.671	1 - KITCHEN: RELOCATE STANDARD FIXTURE - to approx. center above island. See plan for location.
Line8727	Note:
16Jul16 / 18Oct16	
Inv.671	1 - KITCHEN: ROUGH - IN CEILING OUTLET & SWITCH (WITH COVER PLATE) - DOES NOT INCLUDE FIXTURE - Locate near fridge, see plan for location.
Line8729	Note:
16Jul16 / 18Oct16	
Inv.671	1 - MASTER ENSUITE: RELOCATE STANDARD FIXTURE Locate above sink. See plan for location.
Line8733	Note:
16Jul16 / 18Oct16	
Inv.671	1 - MASTER ENSUITE: ROUGH - IN WALL OUTLET ON SAME SWITCH - DOES NOT INCLUDE FIXTURE - Locate above 2nd sink, use same switch as standard. (standard height)
Line8734	Note:
16Jul16 / 18Oct16	
Inv.671	1 - MASTER ENSUITE: ROUGH - IN CEILING OUTLET & SWITCH (WITH COVER PLATE) - DOES NOT INCLUDE FIXTURE - Locate above tub, see plan for location.
Line8735	Note:
16Jul16 / 18Oct16	
Inv.671	2 - REAR EXTERIOR: ADDITIONAL EXTERIOR COACH LIGHT ON SAME SWITCH - Add 1 standard coach light beside patio door & 1 at basement walk-out door, using same switch as std. (1 std coach light + 1 extra coach light/same switch on either side of doors). See plan
Line8739	Note:
16Jul16 / 18Oct16	

Kleinburg Glen - 58 - 1 - 38-6 Elev.A WYNDHAM

Inv.671	1 - POT LIGHT: 4 INCH LINE VOLTAGE POT LIGHT - (EXTERIOR) - EACH
Line8743	Note:
16Jul16 / 18Oct16	
Inv.671	1 - FOYER: Single pole switch for exterior soffit light. Locate with other standard switches in foyer.
Line8744	Note:
16Jul16 / 18Oct16	

EXTERIOR COLOURS

Inv.671	1 - EXTERIOR COLOUR PACKAGE 10
Line12798	Note:
16Jul16 / 18Oct16	

FRAMING

Inv.671	1 - MASTER ENSUITE: Install SHOWER STALL SEAT
Line8737	Note:
16Jul16 / 18Oct16	
Inv.671	1 - DELETE KITCHEN BULK - HEAD - MUST BE APPROVED BY H.O. - (extended cabinetry and crown moulding are not included)
Line8911	Note:
16Jul16 / 18Oct16	
Inv.671	8 - MAIN FLOOR: FRAME MAIN FLOOR DOORS & ARCHES AT 96 INCH - ADDED WITH THE ADDITION OF TALLER INTERIOR DOORS
Line9130	Note:
16Jul16 / 18Oct16	
Inv.671	1 - MASTER ENSUITE: UPGRADE TO FREE STANDING TUB - UPG1 ONLY
Line12797	Note:
16Jul16 / 18Oct16	

GLASS AND MIRROR

Inv.671	1 - MASTER ENSUITE: CONVERT FRAMED SHOWER TO 10MM FRAMELESS SHOWER ENCLOSURE WITH DOOR AND 10MM SIDE PANEL
Line8738	Note:
16Jul16 / 18Oct16	

INTERIOR TRIM AND DOORS

Inv.671	2 - MAIN FLOOR: EXTENDED HEIGHT ARCHWAY (PRICE PER DOORWAY) - INCLUDE FRAMING NOTE
Line9131	Note:
16Jul16 / 18Oct16	
Inv.671	6 - MAIN FLOOR: STANDARD DOOR EXTENDED HEIGHT 96 INCH (PRICE PER DOOR) - GROUND FLOOR 2 STOREY MODELS
Line9132	Note:
16Jul16 / 18Oct16	

MISC.

Inv.671	1 - Purchaser has attended a Structural appointment at the Decor Centre & has DECLINED any additional upgrades and accepts and acknowledges that there will be no further structural changes/additions/deletions to be made upon signing on July 25, 2016.
Line9138	Note:
16Jul16 / 18Oct16	

Kleinburg Glen - 58 - 1 - 38-6 Elev.A WYNDHAM

Inv.671	1 - Purchasers are aware & accepts that ANY changes made to upgrades after signing this Purchasers Extra Form are subject to a minimum administration fee of \$500. PLUS a 10% holdback fee.
Line9139	Note:
16Jul16 / 18Oct16	

Inv.671	1 - BONUS PACKAGE: \$7,500.00 (INCLUDING TAXES) WORTH OF UPGRADES FROM GOLD PARK HOMES DÉCOR CENTRE IS BEING APPLIED TOWARD THE STRUCTURAL APPOINTMENT. PURCHASER HAS A REMAINING AMOUNT OF \$00 (INCLUDING TAXES) TO BE USED TOWARD THE COLOUR APPOINTMENT.
Line9140	Note:
16Jul16 / 18Oct16	




PLUMBING

Inv.671	1 - MASTER ENSUITE: UPGRADE TO FREE STANDING TUB - UPG1 ONLY -
Line8740	Note:
16Jul16 / 18Oct16	

WINDOWS AND DOORS


Inv.671	1 - SIDELITES - 1 PAIR - 12 INCH x 80 INCH HEIGHT - MUST ADD WITH 6 FOOT DOORS IN LIEU OF 8 FOOT SLIDERS
Line9136	Note:
16Jul16 / 18Oct16	

Inv.671	1 - GARDEN DOORS IN LIEU OF PATIO SLIDERS - 6FT X 80 INCH WITH CLEAR GLASS
Line9137	Note:
16Jul16 / 18Oct16	

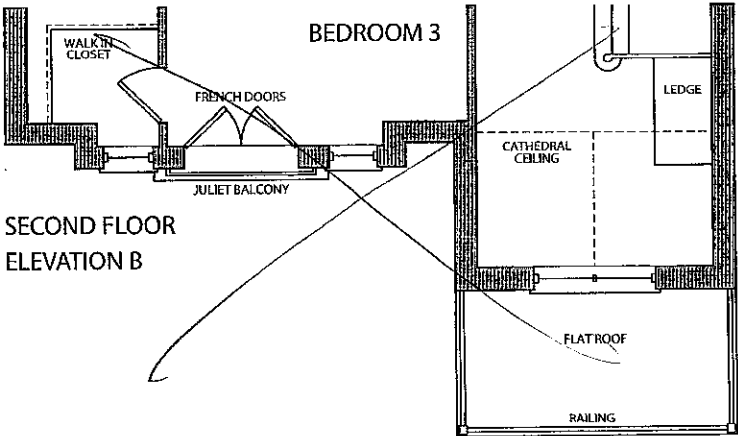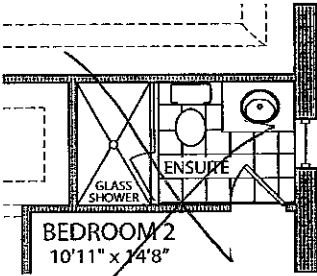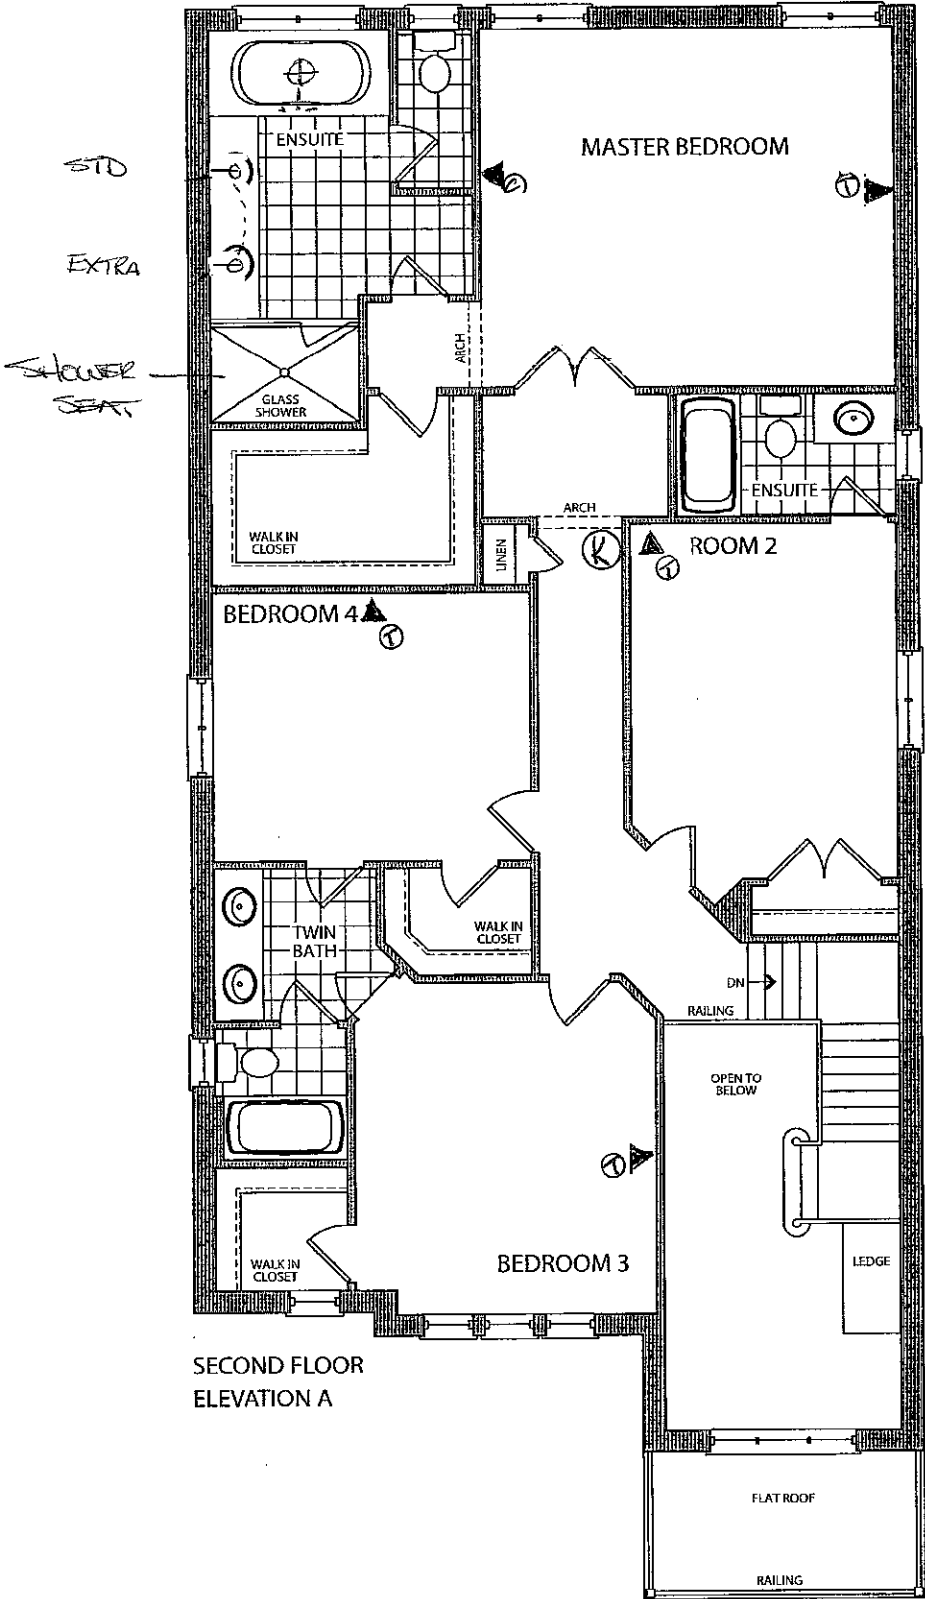

lot 58

July 25, 2016

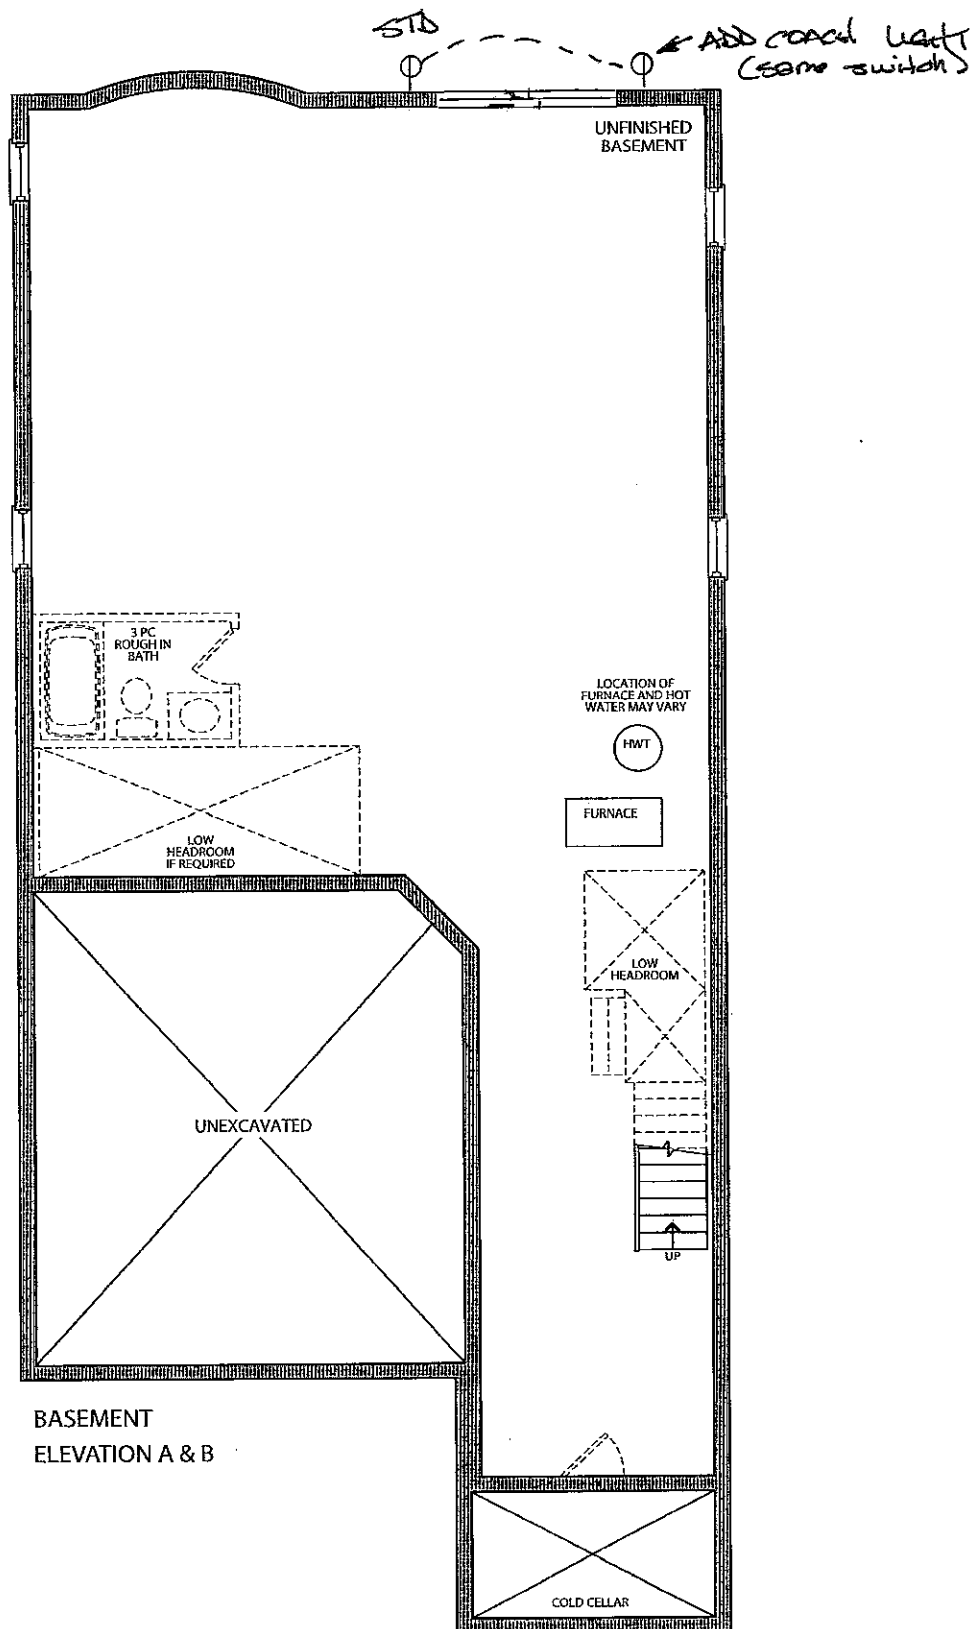

LOT 58

 July 25, 2016



Stacey Carlete
Project Coordinator



Claude Azzopardi
Contracts Manager



Nancy Martini
Corporate Controller



38.1 The Hampton			
Elevation	Circle One	A	2339.9 Square Feet
		B	2327.8 Square Feet
Taller Ceilings	Circle All that Apply	GFTC	9' Ceilings Ground Floor
		MFTC	10' Ceilings Main Floor
		SFTC	9' Ceilings Second Floor
Optional Layouts	Circle All that Apply		

38.2 The Kingston			
Elevation	Circle One	A	2445.9 Square Feet
		B	2445.9 Square Feet
Taller Ceilings	Circle All that Apply	GFTC	9' Ceilings Ground Floor
		MFTC	10' Ceilings Main Floor
		SFTC	9' Ceilings Second Floor
Optional Layouts	Circle All that Apply	SFA1	SECOND FLOOR Shower in Lieu of Tub (Bedroom 2)

38.3 The Birkdale			
Elevation	Circle One	A	2574.1 Square Feet
		B	2575.5 Square Feet
Taller Ceilings	Circle All that Apply	GFTC	9' Ceilings Ground Floor
		MFTC	10' Ceilings Main Floor
		SFTC	9' Ceilings Second Floor
Optional Layouts	Circle All that Apply	SFA1	SECOND FLOOR Shower in Lieu of Tub (Bedroom 2)


38.4 The Bridgeport			
Elevation	Circle One	A	2723.2 Square Feet
		B	2762.0 Square Feet
Taller Ceilings	Circle All that Apply	GFTC	9' Ceilings Ground Floor
		MFTC	10' Ceilings Main Floor
		SFTC	9' Ceilings Second Floor
Optional Layouts	Circle All that Apply	SFA3	SECOND FLOOR Shower in Lieu of Tub (Twin Bath)

38.5 The Rosemont			
Elevation	Circle One	A	2804.9 Square Feet
		B	2804.5 Square Feet
Taller Ceilings	Circle All that Apply	GFTC	9' Ceilings Ground Floor
		MFTC	10' Ceilings Main Floor
		SFTC	9' Ceilings Second Floor
Optional Layouts	Circle All that Apply	SFA1	SECOND FLOOR Shower in Lieu of Tub (Bedroom 2)
		SFA3	SECOND FLOOR Shower in Lieu of Tub (Twin Bath)
		SFA5	SECOND FLOOR Additional Bedroom


38.6 The Wyndham			
Elevation	Circle One	A	2893.5 Square Feet
		B	2896.0 Square Feet
Taller Ceilings	Circle All that Apply	GFTC	9' Ceilings Ground Floor
		MFTC	10' Ceilings Main Floor
		SFTC	9' Ceilings Second Floor
Optional Layouts	Circle All that Apply	SFA1	SECOND FLOOR Shower in Lieu of Tub (Bedroom 2)
		SFA3	SECOND FLOOR Shower in Lieu of Tub (Twin Bath)
		SFA5	SECOND FLOOR Additional Bedroom

* WALK-OUT BASEMENT.

Lot 58

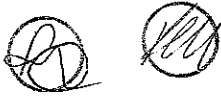

July 25, 2016

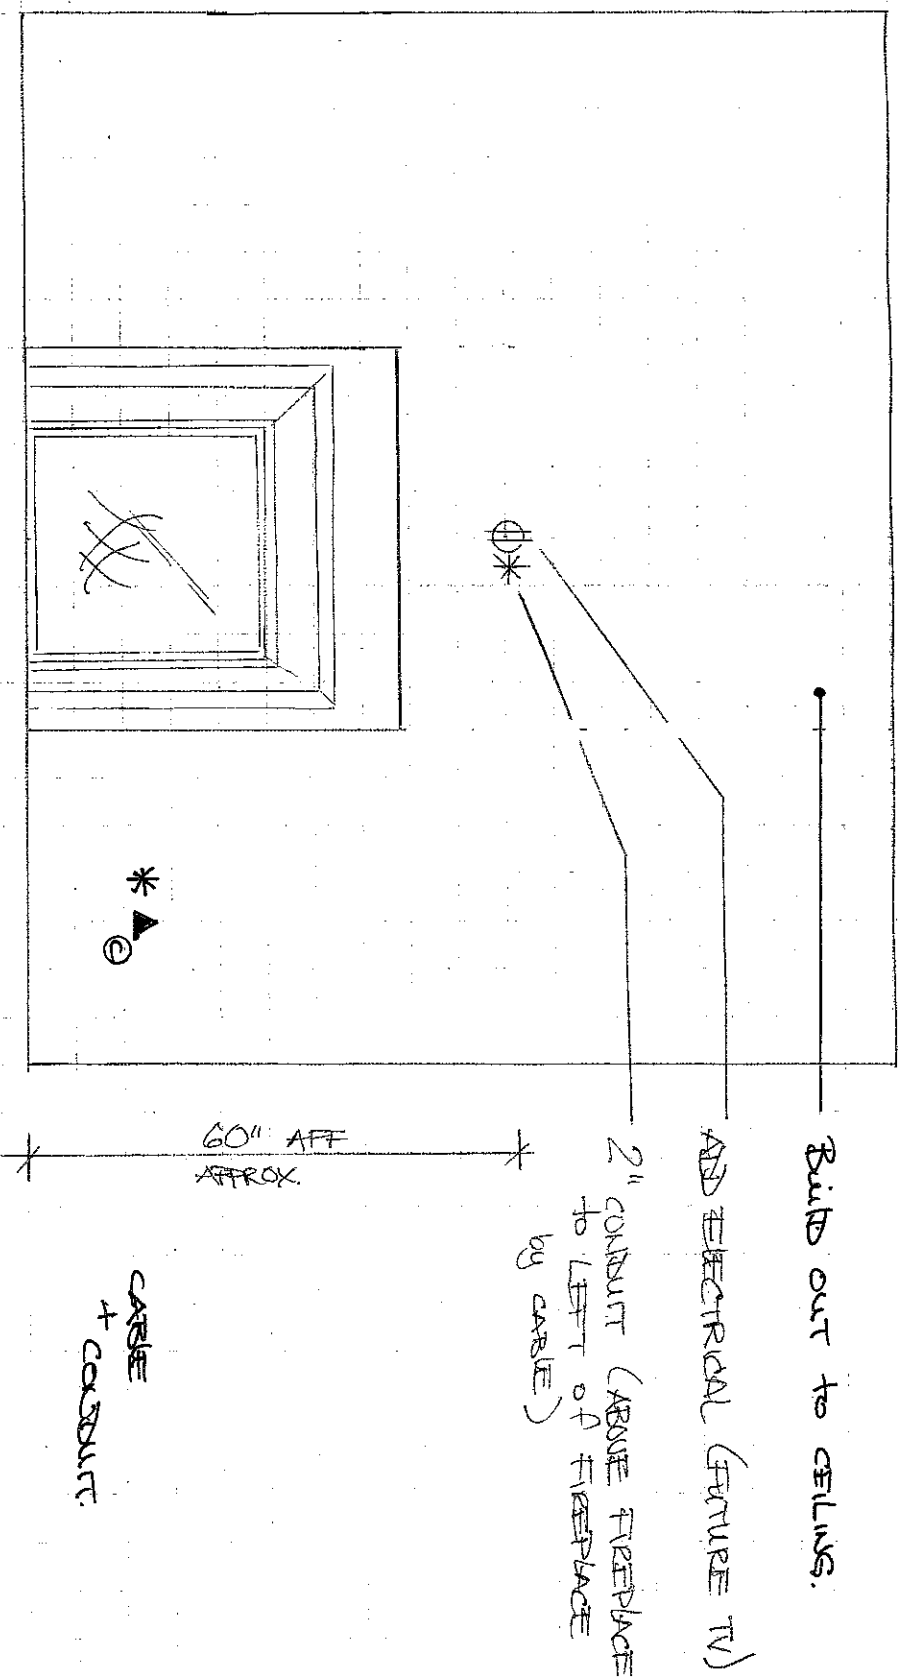

Build out to ceiling.

ADD ELECTRICAL (FEATURE TV)

2" CONDUIT (ABOVE FIREPLACE to LEFT of FIREPLACE by CABLE)

CABLE + CONDUIT.

LOT 58

GREAT ROOM - FIREPLACE ELEVATION.

July 25 2016.