

Kleinburg Glen - 64 - 1 - 38-3 Elev.A BIRKDALE
CENTRAL VAC AND WIRING

Inv.531	1 - GREAT ROOM - Install CONDUIT PIPE - FOR TELEVISION above fireplace - See sketch
Line6416	Note:
1Jun16 / 4Oct16	

ELECTRICAL

Inv.531	1 - GREAT ROOM - install 110V WALL RECEPTACLE ON NORMAL CIRCUIT - in the great room to accomodate future TV above fireplace - see sketch
Line6417	Note:
1Jun16 / 4Oct16	

Inv.531	1 - BREAKFAST AREA- Install builder's standard ceiling light in the center of the breakfast area, as per purchaser's request- see sketch
Line6415	Note:
1Jun16 / 4Oct16	

Inv.531	1 - KITCHEN - Install two (x2) ROUGH - IN CEILING OUTLET & SWITCH (WITH COVER PLATE) - DOES NOT INCLUDE FIXTURE Over Island. 2 rough-ins to be on one switch centered above kitchen island - See floorplan for locations
Line6413	Note:
1Jun16 / 4Oct16	

Inv.531	1 - 200 AMP ELECTRICAL SERVICE
Line6713	Note:
1Jun16 / 4Oct16	

EXTERIOR COLOURS

Inv.531	1 - EXTERIOR COLOUR PACKAGE 11
Line12328	Note:
1Jun16 / 4Oct16	


MISC.

Inv.531	1 - Purchasers are aware & accepts that ANY changes made to upgrades after signing this Purchasers Extra Form are subject to a minimum administration fee of \$500. PLUS a 10% holdback fee.
Line7062	Note:
1Jun16 / 4Oct16	


Inv.531	1 - Purchaser has attended a Structural appointment at the Decor Centre & has DECLINED any additional upgrades and accepts and acknowledges that there will be no further structural changes/additions/deletions to be made upon signing on July 15, 2016.
Line7061	Note:
1Jun16 / 4Oct16	

Inv.531	1 - BONUS PACKAGE: \$7,500.00 (INCLUDING TAXES) WORTH OF UPGRADES FROM GOLD PARK HOMES DÉCOR CENTRE IS BEING APPLIED TOWARD THE STRUCTURAL APPOINTMENT. PURCHASER HAS A REMAINING AMOUNT OF \$5,415.15 (INCLUDING TAXES) TO BE USED TOWARD THE COLOUR APPOINTMENT.
Line7063	Note:
1Jun16 / 4Oct16	

✓ Elevation A • 2,620 sq.ft.
~~Elevation B • 2,620 sq.ft.~~

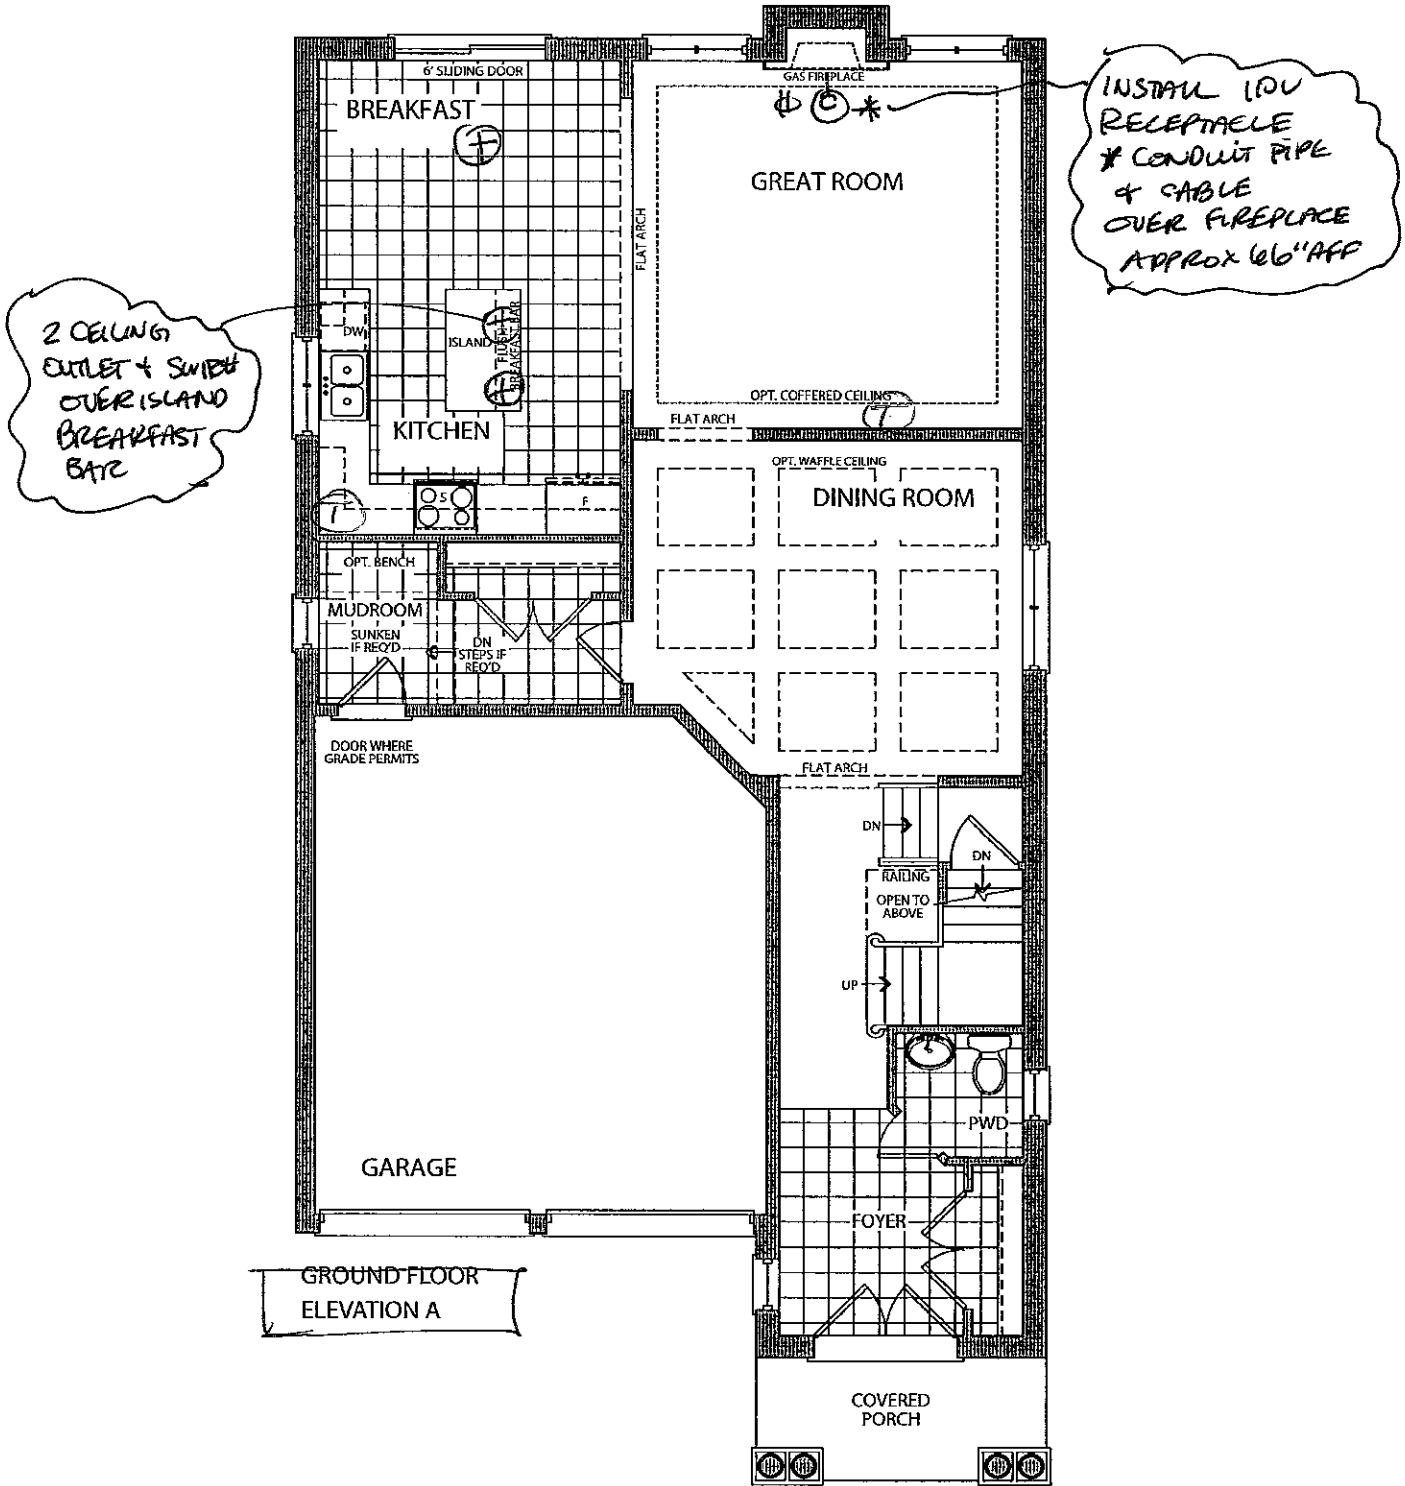

GROUND FLOOR
ELEVATION A

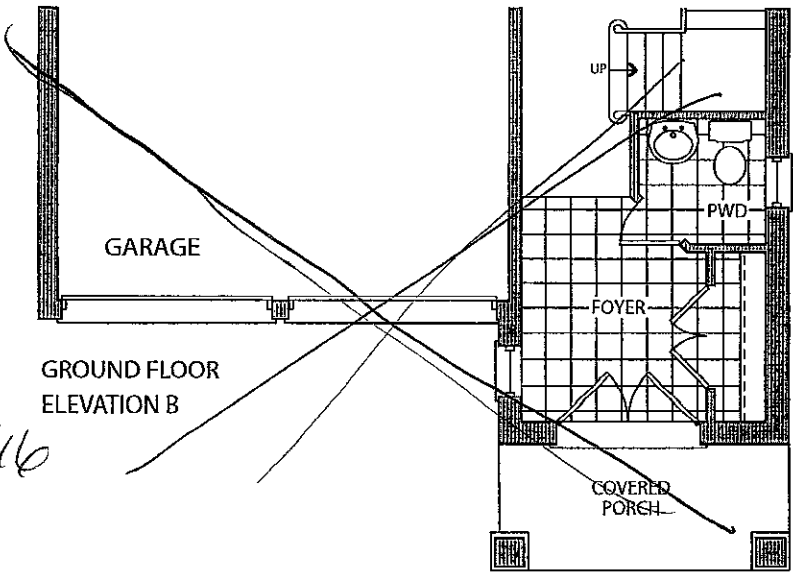


GROUND FLOOR
ELEVATION B


LOT 64
#15
DATE: July 26/16

✓ Elevation A • 2,620 sq.ft.


~~Elevation B • 2,620 sq.ft.~~

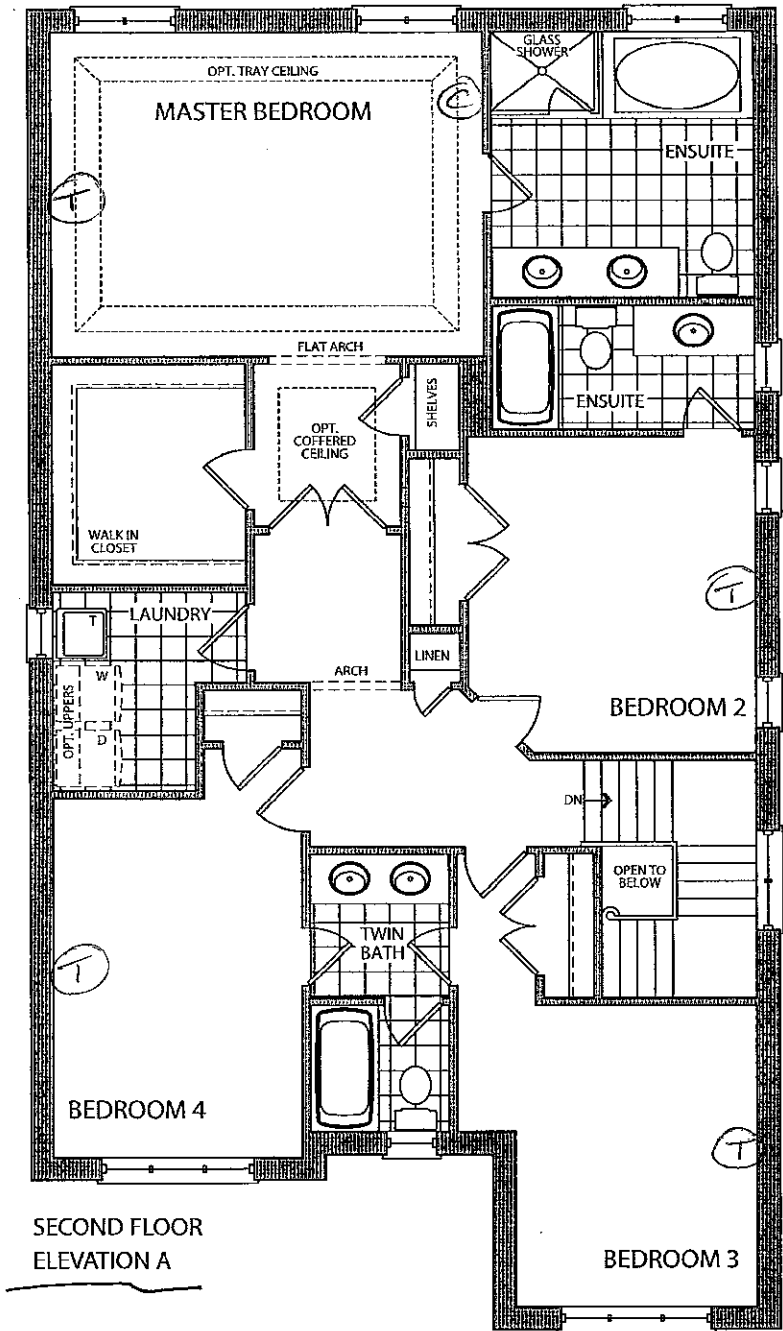

SECOND FLOOR
ELEVATION A

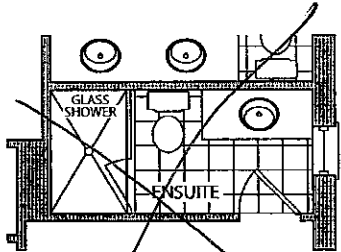


OPT. ENSUITE PLAN
ELEVATION A & B

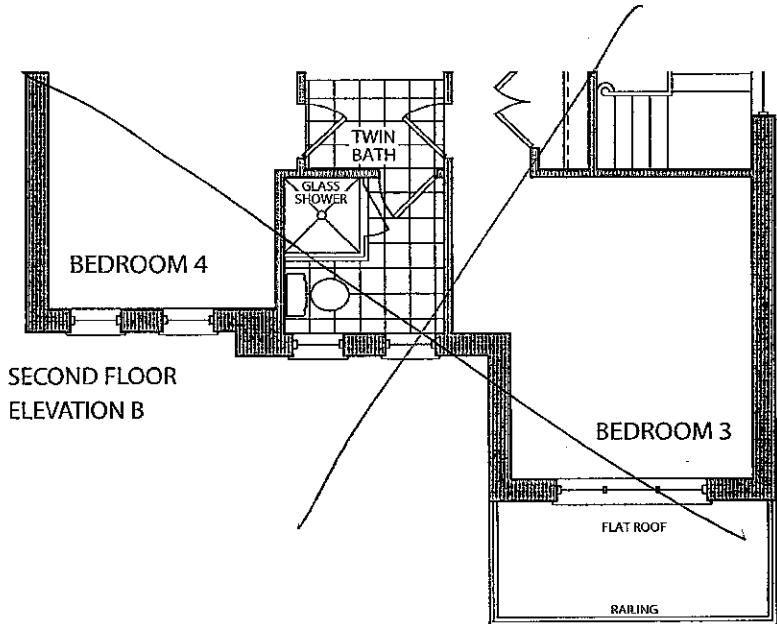

SECOND FLOOR
ELEVATION B

LOT 64
#13

DATE: July 26th 2016

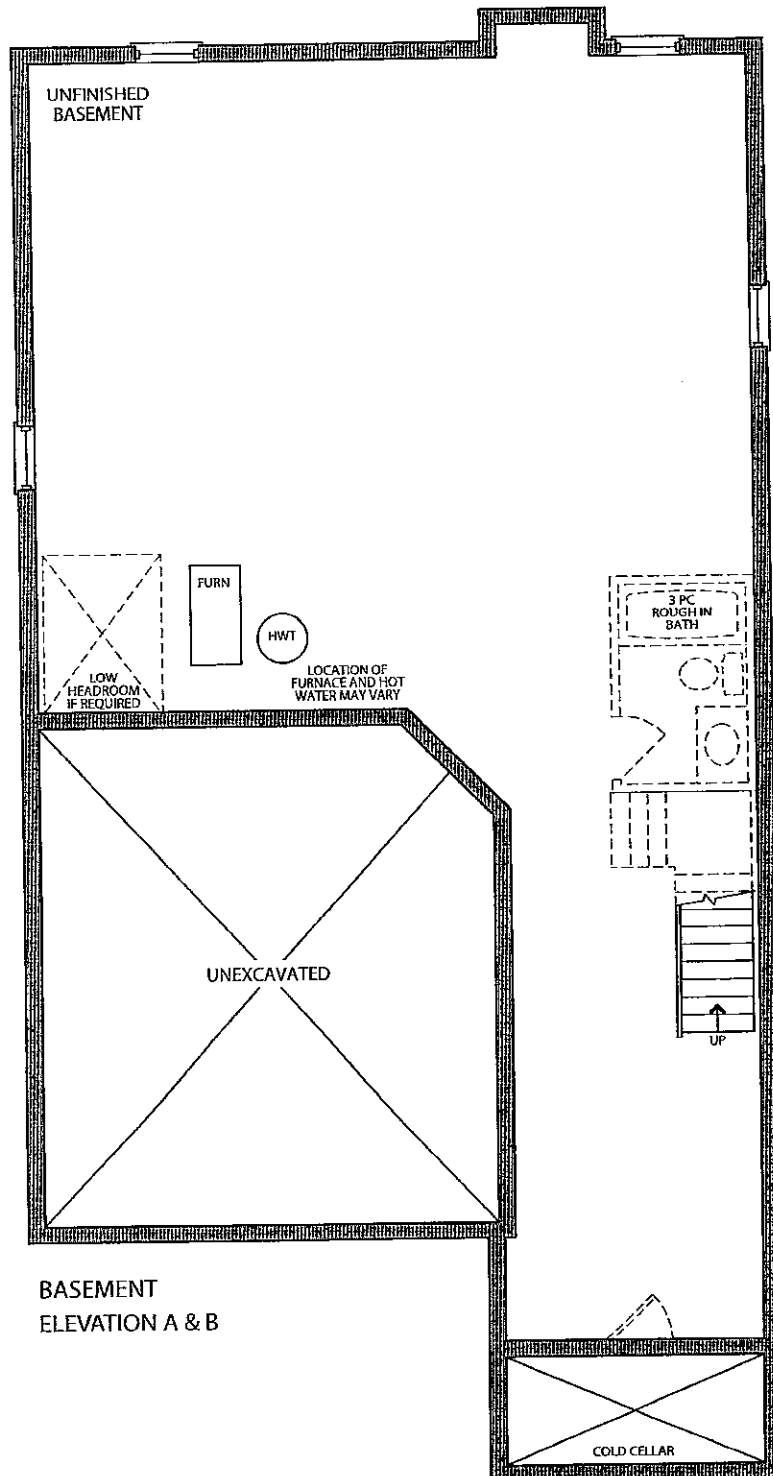

Lot 64
P/S

DATE: July 26th 2016



Stacey Carlete
Project Coordinator



Claude Azzopardi
Contracts Manager



Nancy Martini
Corporate Controller



Model	38.1 The Hampton		
Elevation	Circle One	A	2339.9 Square Feet
		B	2327.8 Square Feet
Taller Ceilings	Circle All that Apply	GFTC	9' Ceilings Ground Floor
		MFTC	10' Ceilings Main Floor
		SFTC	9' Ceilings Second Floor
Optional Layouts	Circle All that Apply		

Model	38.2 The Kingston		
Elevation	Circle One	A	2445.9 Square Feet
		B	2445.9 Square Feet
Taller Ceilings	Circle All that Apply	GFTC	9' Ceilings Ground Floor
		MFTC	10' Ceilings Main Floor
		SFTC	9' Ceilings Second Floor
Optional Layouts	Circle All that Apply	SFA1	SECOND FLOOR Shower in Lieu of Tub (Bedroom 2)

Model	38.3 The Birkdale		
Elevation	Circle One	A	2574.1 Square Feet
		B	2575.5 Square Feet
Taller Ceilings	Circle All that Apply	GFTC	9' Ceilings Ground Floor
		MFTC	10' Ceilings Main Floor
		SFTC	9' Ceilings Second Floor
Optional Layouts	Circle All that Apply	SFA1	SECOND FLOOR Shower in Lieu of Tub (Bedroom 2)

Model	38.4 The Bridgeport		
Elevation	Circle One	A	2723.2 Square Feet
		B	2762.0 Square Feet
Taller Ceilings	Circle All that Apply	GFTC	9' Ceilings Ground Floor
		MFTC	10' Ceilings Main Floor
		SFTC	9' Ceilings Second Floor
Optional Layouts	Circle All that Apply	SFA3	SECOND FLOOR Shower in Lieu of Tub (Twin Bath)

Model	38.5 The Rosemont		
Elevation	Circle One	A	2804.9 Square Feet
		B	2804.5 Square Feet
Taller Ceilings	Circle All that Apply	GFTC	9' Ceilings Ground Floor
		MFTC	10' Ceilings Main Floor
		SFTC	9' Ceilings Second Floor
Optional Layouts	Circle All that Apply	SFA1	SECOND FLOOR Shower in Lieu of Tub (Bedroom 2)
		SFA3	SECOND FLOOR Shower in Lieu of Tub (Twin Bath)
		SFA5	SECOND FLOOR Additional Bedroom

Model	38.6 The Wyndham		
Elevation	Circle One	A	2893.5 Square Feet
		B	2896.0 Square Feet
Taller Ceilings	Circle All that Apply	GFTC	9' Ceilings Ground Floor
		MFTC	10' Ceilings Main Floor
		SFTC	9' Ceilings Second Floor
Optional Layouts	Circle All that Apply	SFA1	SECOND FLOOR Shower in Lieu of Tub (Bedroom 2)
		SFA3	SECOND FLOOR Shower in Lieu of Tub (Twin Bath)
		SFA5	SECOND FLOOR Additional Bedroom



LOT 64

DATE July 26th 2016