

Kleinburg Glen - 66 - 1 - 38-6 Elev.B WYNDHAM
DRYWALL

Inv.617	1 - SMOOTH CEILINGS - (2 - Story Design) 2ND FLOOR
Line7712	Note:
30Jun16 / 4Oct16	

ELECTRICAL

Inv.617	1 - 200 AMP ELECTRICAL SERVICE
Line9175	Note:
30Jun16 / 4Oct16	

Inv.617	1 - GARAGE: 110V WALL RECEPTACLE ON NORMAL CIRCUIT - Locate on garage wall opposite standard wall outlet.
Line10536	Note:
30Jun16 / 4Oct16	

Inv.617	1 - GREAT ROOM: Add a 110V WALL RECEPTACLE ON NORMAL CIRCUIT - approx. 60" A.F.F. above fireplace. For future TV
Line7715	Note:
30Jun16 / 4Oct16	

Inv.617	1 - KITCHEN: 110V WALL RECEPTACLE ON DEDICATED CIRCUIT - For future 600+ cfm hood fan.
Line7716	Note:
30Jun16 / 4Oct16	

Inv.617	1 - KITCHEN: Add a 110V RECEPTICLE ON DEDICATED CIRCUIT - FOR MICROWAVE IN ISLAND - MICROWAVE & CABINETRY CUSTOMIZATION NOT INCLUDED. See plan for location.
Line7717	Note:
30Jun16 / 4Oct16	

Inv.617	1 - KITCHEN: RELOCATE STANDARD FIXTURE to above island. See plan for location.
Line7721	Note:
30Jun16 / 4Oct16	

Inv.617	5 - KITCHEN: Install 5 POT LIGHT: 4 INCH HALOGEN POT LIGHT - 440 WH - PRICED PER LIGHT - 10 OR MORE. See plan for location.
Line7723	Note:
30Jun16 / 4Oct16	

Inv.617	1 - KITCHEN: Single pole switch (for kitchen potlights)
Line7724	Note:
30Jun16 / 4Oct16	

Inv.617	1 - KITCHEN CABINET VALANCE LIGHTS (UNDER CABINETS) - WITH STRIP LIGHTS - DOES NOT INCLUDE (AND REQUIRES) KITCHEN UPGRADE PRICING
Line7725	Note:
30Jun16 / 4Oct16	

Inv.617	1 - BREAKFAST: RELOCATE STANDARD FIXTURE, See plan for location.
Line7726	Note:
30Jun16 / 4Oct16	

Inv.617	1 - BREAKFAST: Add a ROUGH - IN CEILING OUTLET ON SAME SWITCH as standard light - DOES NOT INCLUDE FIXTURE. (In addition to builders standard ceiling light) See plan for location.
Line7727	Note:
30Jun16 / 4Oct16	

Kleinburg Glen - 66 - 1 - 38-6 Elev.B WYNDHAM

Inv.617	6 - GREAT ROOM: Install 6 POT LIGHT: 4 INCH HALOGEN POT LIGHT - 440 WH - PRICED PER LIGHT - 10 OR MORE. See plan for location
Line7728	Note:
30Jun16 / 4Oct16	
Inv.617	1 - KITCHEN: Add a ROUGH - IN CEILING OUTLET ON SAME SWITCH as standard light.- DOES NOT INCLUDE FIXTURE. Locate above kitchen island, see plan for location.
Line7805	Note:
30Jun16 / 4Oct16	
Inv.617	1 - POWDER ROOM: *DELETE* STANDARD Vanity light above mirror, install ADDITIONAL STANDARD CEILING FIXTURE using standard SWITCH. See plan for location.
Line7809	Note:
30Jun16 / 4Oct16	
Inv.617	1 - MASTER ENSUITE: LAYOUT HAS BEEN CHANGED, move standard ceiling light to approx. center above tub. See plan for location.
Line7831	Note:
30Jun16 / 4Oct16	
Inv.617	1 - KITCHEN: 110V WALL RECEPTACLE ON DEDICATED CIRCUIT - GAS FIRED APPLIANCE - FOR AUX. EQUIPMENT - NOT A STOVE PLUG
Line8856	Note:
30Jun16 / 4Oct16	
Inv.617	3 - BASEMENT: 110V WALL RECEPTACLE ON NORMAL CIRCUIT - See plan for location.
Line10537	Note:
30Jun16 / 4Oct16	
Inv.617	1 - GREAT ROOM: *DELETE* BUILDERS STANDARD CEILING LIGHT, use standard switch for potlights. See plan for location.
Line10971	Note:
30Jun16 / 4Oct16	

EXTERIOR COLOURS

Inv.617	1 - EXTERIOR COLOUR PACKAGE 1
Line12297	Note:
30Jun16 / 4Oct16	

FRAMING

Inv.617	8 - FRAME MAIN FLOOR DOORS & ARCHES AT 96 INCH - ADDED WITH THE ADDITION OF TALLER INTERIOR DOORS
Line7708	Note:
30Jun16 / 4Oct16	
Inv.617	1 - MASTER ENSUITE: REVISE LAYOUT OF ENSUITE - MOVE LOCATION OF TOILET AND TUB, SEE PLAN
Line7799	Note:
30Jun16 / 4Oct16	
Inv.617	1 - GREAT ROOM & BREAKFAST: Add approx. 24" to each nib wall making archways smaller. See plan for location.
Line7802	Note:
30Jun16 / 4Oct16	
Inv.617	1 - DINING ROOM: Add approx. 24-30" to nib wall making archway narrower. **Entrance to dining room to be in line with kitchen tile, See plan for location.
Line8858	Note:
30Jun16 / 4Oct16	

Kleinburg Glen - 66 - 1 - 38-6 Elev.B WYNDHAM

Inv.617	1 - LAUNDRY/BASEMENT: Move standard laundry tub and rough-ins to basement. Leave entry from house to garage open for future closets
Line12295	Note:
30Jun16 / 4Oct16	

GLASS AND MIRROR

Inv.617	1 - MASTER BEDROOM: CONVERT FRAMED SHOWER TO 10MM FRAMELESS SHOWER ENCLOSURE WITH DOOR AND 10MM SIDE PANEL
Line10535	Note:
30Jun16 / 4Oct16	

HVAC

Inv.617	1 - DEN/DINING ROOM: **REQUEST** HRV & thermostat to be located inside den NOT main hall - *if possible*
Line7807	Note:
30Jun16 / 4Oct16	

Inv.617	1 - KITCHEN: UPGRADE VENTING FOR STOVE TO 8 INCH PIPE EXTERIOR WALL
Line7718	Note:
30Jun16 / 4Oct16	

Inv.617	1 - LAUNDRY/BASEMENT: Move standard laundry tub and rough-ins to basement. Leave entry from house to garage open for future closets
Line12296	Note:
30Jun16 / 4Oct16	

INTERIOR TRIM AND DOORS

Inv.617	2 - MAIN FLOOR: EXTENDED HEIGHT ARCHWAY (PRICE PER DOORWAY) - 96" ARCHWAYS
Line7709	Note:
30Jun16 / 4Oct16	

Inv.617	6 - STANDARD DOOR EXTENDED HEIGHT 96 INCH (PRICE PER DOOR) - GROUND FLOOR 2 STOREY MODELS (price includes additional door at foyer closet)
Line7710	Note:
30Jun16 / 4Oct16	

MISC.

Inv.617	1 - Purchasers are aware & accepts that ANY changes made to upgrades after signing this Purchasers Extra Form are subject to a minimum administration fee of \$500. PLUS a 10% holdback fee.
Line10540	Note:
30Jun16 / 4Oct16	

Inv.617	1 - Purchaser has attended a Structural appointment at the Decor Centre & has DECLINED any additional upgrades and accepts and acknowledges that there will be no further structural changes/additions/deletions to be made upon signing on August 25, 2016.
Line10539	Note:
30Jun16 / 4Oct16	

Inv.617	1 - BONUS PACKAGE: \$7,500.00 (INCLUDING TAXES) WORTH OF UPGRADES FROM GOLD PARK HOMES DÉCOR CENTRE IS BEING APPLIED TOWARD THE STRUCTURAL APPOINTMENT. PURCHASER HAS A REMAINING AMOUNT OF \$00 (INCLUDING TAXES) TO BE USED TOWARD THE COLOUR APPOINTMENT.
Line10541	Note:
30Jun16 / 4Oct16	

PLUMBING

Kleinburg Glen - 66 - 1 - 38-6 Elev.B WYNDHAM

Inv.617	1 - LAUNDRY/BASEMENT: Move standard laundry tub and rough-ins to basement. Leave entry from house to garage open for future closets.
Line7800	Note:
30Jun16 / 4Oct16	
Inv.617	1 - KITCHEN: Move standard sink/dishwasher from island to beside fridge. See plan for location.
Line7803	Note:
30Jun16 / 4Oct16	
Inv.617	1 - MASTER ENSUITE: UPGRADE TO FREE STANDING TUB - UPG1 ONLY
Line10305	Note:
30Jun16 / 4Oct16	
Inv.617	1 - MASTER ENSUITE: REVISE LAYOUT OF ENSUITE - MOVE LOCATION OF TOILET AND TUB, SEE PLAN
Line12318	Note:
30Jun16 / 4Oct16	

WINDOWS AND DOORS

Inv.617	1 - BREAKFAST: SIDELITES - 1 PAIR - 12 INCH x 80 INCH HEIGHT - MUST ADD WITH 6 FOOT DOORS IN LIEU OF 8 FOOT SLIDERS
Line7824	Note:
30Jun16 / 4Oct16	
Inv.617	1 - BREAKFAST: GARDEN DOORS IN LIEU OF PATIO SLIDERS - 6FT X 80 INCH WITH CLEAR GLASS
Line7826	Note:
30Jun16 / 4Oct16	

Elevation A • 2,951 sq.ft.

Elevation B • 2,954 sq.ft.

GARDEN
DOOR +
SIDE LITES

LOT 66

SEPT 6 2016



60" AFF

MOVE LAUNDRY
to
BASEMENT.

○ STD. CEILING LIGHT

⊕ RAIN CEILING
OUTLET



● POTLIGHT



⊕ ELECT. OUTLET

⊕ 96" ARCH.


⊕ PHONE

⊕ CABLE

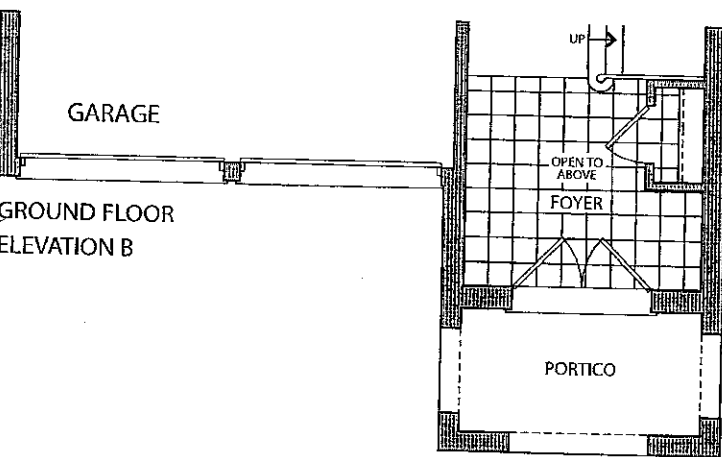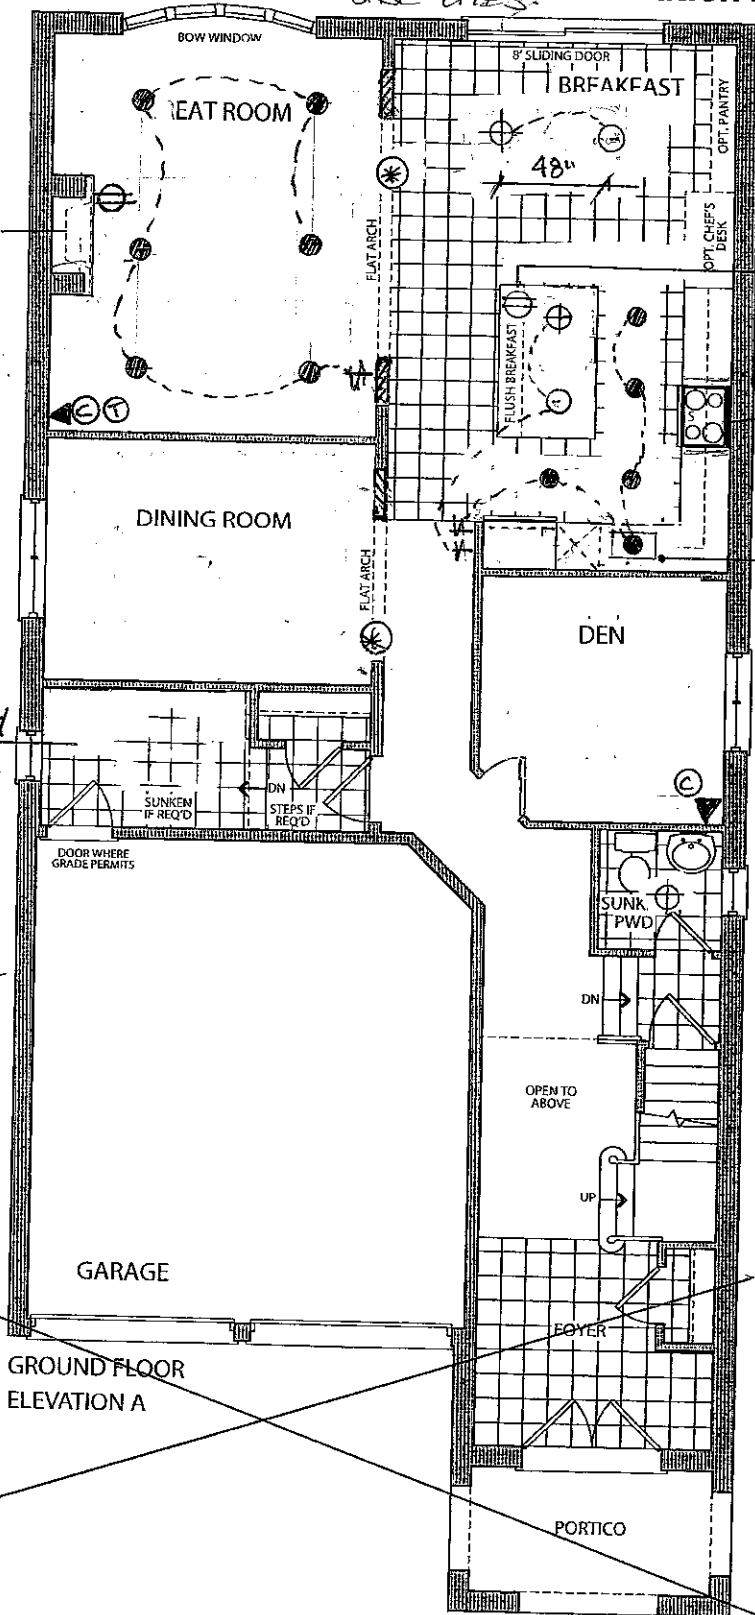

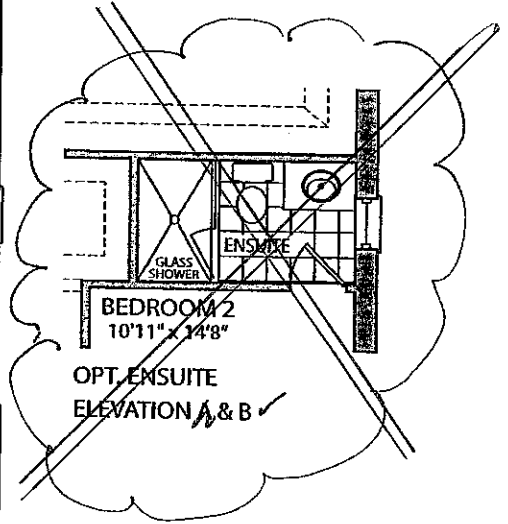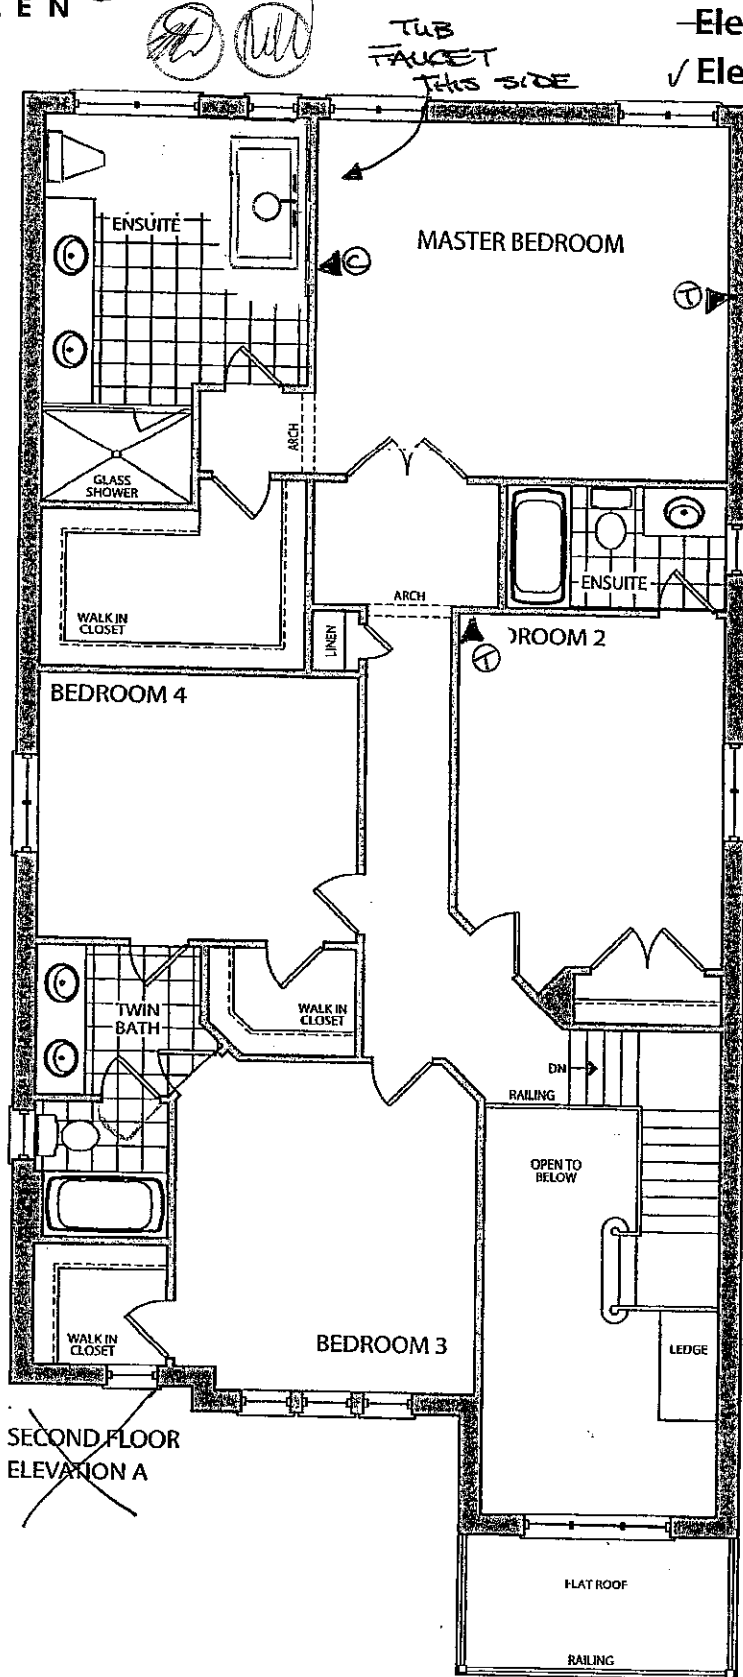

SECOND FLOOR
ELEVATION A

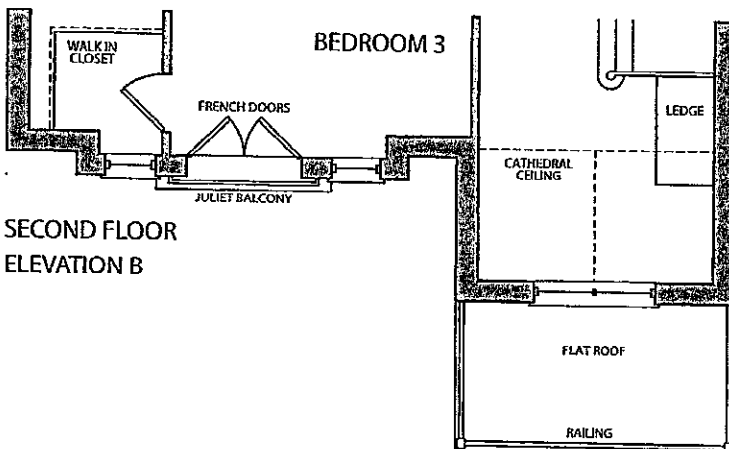


SECOND FLOOR
ELEVATION B

Lot 66

SEPT. 6 2016



* = PREFERRED
LAUNDRY
LOCATION

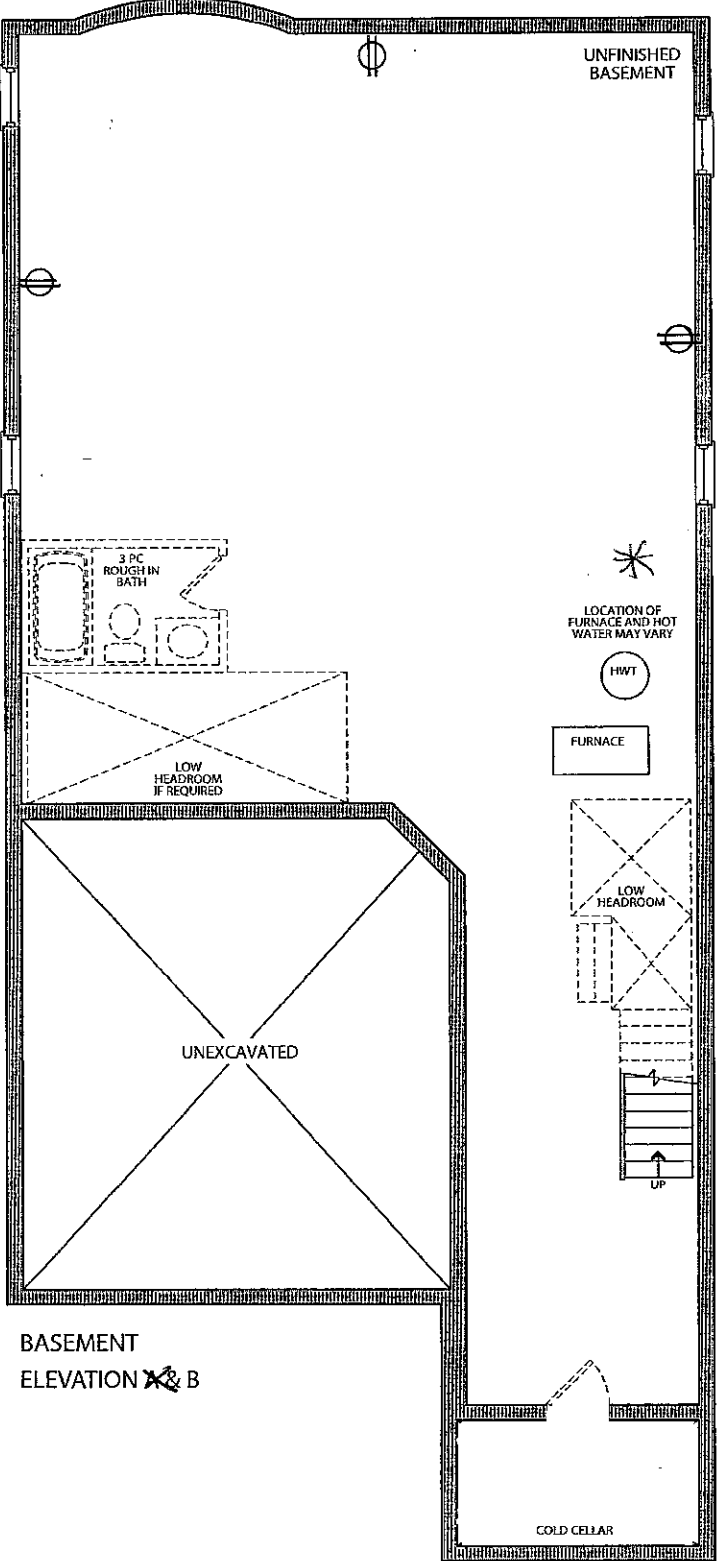



Stacey Carlete
Project Coordinator



Claude Azzopardi
Contracts Manager



Nancy Martini
Corporate Controller



38.1 The Hampton			
Elevation	Circle One	A	2339.9 Square Feet
		B	2327.8 Square Feet
Taller Ceilings	Circle All that Apply	GFTC	9' Ceilings Ground Floor
		MFTC	10' Ceilings Main Floor
		SFTC	9' Ceilings Second Floor
Optional Layouts	Circle All that Apply		

38.2 The Kingston			
Elevation	Circle One	A	2445.9 Square Feet
		B	2445.9 Square Feet
Taller Ceilings	Circle All that Apply	GFTC	9' Ceilings Ground Floor
		MFTC	10' Ceilings Main Floor
		SFTC	9' Ceilings Second Floor
Optional Layouts	Circle All that Apply	SFA1	SECOND FLOOR Shower in Lieu of Tub (Bedroom 2)

38.3 The Birkdale			
Elevation	Circle One	A	2574.1 Square Feet
		B	2575.5 Square Feet
Taller Ceilings	Circle All that Apply	GFTC	9' Ceilings Ground Floor
		MFTC	10' Ceilings Main Floor
		SFTC	9' Ceilings Second Floor
Optional Layouts	Circle All that Apply	SFA1	SECOND FLOOR Shower in Lieu of Tub (Bedroom 2)

38.4 The Bridgeport			
Elevation	Circle One	A	2723.2 Square Feet
		B	2762.0 Square Feet
Taller Ceilings	Circle All that Apply	GFTC	9' Ceilings Ground Floor
		MFTC	10' Ceilings Main Floor
		SFTC	9' Ceilings Second Floor
Optional Layouts	Circle All that Apply	SFA3	SECOND FLOOR Shower in Lieu of Tub (Twin Bath)

38.5 The Rosemont			
Elevation	Circle One	A	2804.9 Square Feet
		B	2804.5 Square Feet
Taller Ceilings	Circle All that Apply	GFTC	9' Ceilings Ground Floor
		MFTC	10' Ceilings Main Floor
		SFTC	9' Ceilings Second Floor
Optional Layouts	Circle All that Apply	SFA1	SECOND FLOOR Shower in Lieu of Tub (Bedroom 2)
		SFA3	SECOND FLOOR Shower in Lieu of Tub (Twin Bath)
		SFA5	SECOND FLOOR Additional Bedroom

38.6 The Wyndham			
Elevation	Circle One	A	2893.5 Square Feet
		<u>B</u>	2896.0 Square Feet
Taller Ceilings	Circle All that Apply	GFTC	9' Ceilings Ground Floor
		MFTC	10' Ceilings Main Floor
		SFTC	9' Ceilings Second Floor
Optional Layouts	Circle All that Apply	<u>SFA1</u>	SECOND FLOOR Shower in Lieu of Tub (Bedroom 2)
		SFA3	SECOND FLOOR Shower in Lieu of Tub (Twin Bath)
		SFA5	SECOND FLOOR Additional Bedroom

deleted.

* WALK-OUT BASEMENT.

LOT 66

SEPT 6 2016

