

Kleinburg Glen - 69 - 1 - 38-5 Elev.A ROSEMONT  
CENTRAL VAC AND WIRING

Inv.611	1 - LAUNDRY: ROUGH - IN FOR EXTRA SECURITY KEY PAD. See plan for location.
Line7549	Note:
27Jun16 / 21Sep16	
Inv.611	1 - BREAKFAST: Install CAT 5 WIRING - ADD EXTRA cable rough-in. See plan for location.
Line7551	Note:
27Jun16 / 21Sep16	
Inv.611	1 - GREAT ROOM: ROUGH - IN WIRING FOR ONE PAIR OF SPEAKERS - See plan for location. Cable to terminate by cable location (original fireplace bump out)
Line7552	Note:
27Jun16 / 21Sep16	

DRYWALL

Inv.611	1 - MASTER BEDROOM: Insulate wall between Master Bedroom and Bedroom 2. See plan for location.
Line7544	Note:
27Jun16 / 21Sep16	
Inv.611	1 - ENSUITE 2: Insulate wall between Upper Hall and Ensuite 2. See plan for location.
Line7546	Note:
27Jun16 / 21Sep16	
Inv.611	1 - GREAT ROOM: DRYWALL OVER FIREPLACE BUMP-OUT, LEAVE FLUSH WALL IN GREAT ROOM. See plan for location.
Line10187	Note:
27Jun16 / 21Sep16	

ELECTRICAL

Inv.611	1 - KITCHEN: 110V WALL RECEPTACLE ON NORMAL CIRCUIT - for future wine fridge below counter top. Locate left of fridge, see plan for location.
Line9036	Note:
27Jun16 / 21Sep16	
Inv.611	1 - KITCHEN: 110V WALL RECEPTACLE ON DEDICATED CIRCUIT - FOR MICROWAVE - MICROWAVE NOT INCLUDED. See plan for location. Cabinetry customization for microwave shelf to be priced at colour appointment.
Line7553	Note:
27Jun16 / 21Sep16	
Inv.611	1 - KITCHEN: RELOCATE STANDARD FIXTURE. Move to above island. See plan for location.
Line7556	Note:
27Jun16 / 21Sep16	
Inv.611	1 - KITCHEN: ROUGH - IN CEILING OUTLET ON SAME SWITCH - DOES NOT INCLUDE FIXTURE - Above island for future pendant light. Use same switch as standard light above island. See plan for location.
Line7557	Note:
27Jun16 / 21Sep16	
Inv.611	1 - KITCHEN CABINET STRIP VALANCE LIGHTS (UNDER CABINETS) - ROUGH - IN - DOES NOT INCLUDE (AND REQUIRES) KITCHEN UPGRADE PRICING
Line7558	Note:
27Jun16 / 21Sep16	
Inv.611	1 - KITCHEN: Install a single pole switch for potlights
Line7560	Note:
27Jun16 / 21Sep16	

Kleinburg Glen - 69 - 1 - 38-5 Elev.A ROSEMONT

Inv.611	1 - 200 AMP ELECTRICAL SERVICE
Line7561	Note:
27Jun16 / 21Sep16	
Inv.611	4 - GREAT ROOM: POT LIGHT: 4 INCH HALOGEN POT LIGHT - 440 WH - PRICED PER LIGHT - 10 OR MORE. See plan for location.
Line7562	Note:
27Jun16 / 21Sep16	
Inv.611	1 - GREAT ROOM: Install a single pole switch for potlights.
Line7563	Note:
27Jun16 / 21Sep16	
Inv.611	1 - MAIN HALL: RELOCATE STANDARD FIXTURE - To hall by den, see plan for location.
Line7564	Note:
27Jun16 / 21Sep16	
Inv.611	2 - MAIN HALL: Install 2 POT LIGHT: 4 INCH HALOGEN POT LIGHT - 440 WH - PRICED PER LIGHT - 10 OR MORE. Use same switch as standard main hall light. See plan for location
Line7565	Note:
27Jun16 / 21Sep16	
Inv.611	1 - EXTERIOR: GFI DUPLEX OUTLET WITH COVER - Install left side garage exterior. See plan for location.
Line7566	Note:
27Jun16 / 21Sep16	
Inv.611	3 - GARAGE: 110V WALL RECEPTACLE ON NORMAL CIRCUIT - See plan for location.
Line7589	Note:
27Jun16 / 21Sep16	
Inv.611	1 - KITCHEN: 110V WALL RECEPTACLE ON DEDICATED CIRCUIT - For future 600+cfm hood fan.
Line7590	Note:
27Jun16 / 21Sep16	
Inv.611	7 - KITCHEN: POT LIGHT: 4 INCH HALOGEN POT LIGHT - 440 WH - PRICED PER LIGHT - 10 OR MORE. See plan for location.
Line7592	Note:
27Jun16 / 21Sep16	
Inv.611	2 - LEFT & RIGHT ELEVATION - EXTERIOR: GFI DUPLEX OUTLET WITH COVER - Locate approx. 12' from ground. See plan for location.
Line7593	Note:
27Jun16 / 21Sep16	
Inv.611	1 - GREAT ROOM: Single pole switch for potlight above 2-sided fireplace. See plan/sketch for location.
Line9040	Note:
27Jun16 / 21Sep16	
Inv.611	1 - MASTER ENSUITE: ROUGH - IN CEILING OUTLET ON SAME SWITCH - DOES NOT INCLUDE FIXTURE - See plan for location. To be on same switch as standard vanity sconces.
Line7596	Note:
27Jun16 / 21Sep16	
Inv.611	2 - ENSUITE 2 & SEMI ENSUITE 3/4: Install POT LIGHT: 4 INCH RECESSED SHOWER POT LIGHT WITH SWITCH
Line7597	Note:
27Jun16 / 21Sep16	

Kleinburg Glen - 69 - 1 - 38-5 Elev.A ROSEMONT

Inv.611	1 - GREAT ROOM: POT LIGHT: 4 INCH HALOGEN POT LIGHT - 440 WH - PRICED PER LIGHT - 10 OR MORE - Install 1 potlight approx. center above fireplace in bulkhead. See plan/sketch for location.
Line9039	Note:
27Jun16 / 21Sep16	

EXTERIOR COLOURS

Inv.611	1 - EXTERIOR COLOUR PACKAGE 2
Line10188	Note:
27Jun16 / 21Sep16	

FIREPLACE

Inv.611	1 - GREAT ROOM/BREAKFAST: Install a 2-sided gas fireplace, in lieu of standard gas fireplace. (Price incl. fireplace, venting, gas connection, framing, tape drywall, paint, & req'd electrical & thermostat). Marble not included. See plan/sketch for location.
Line8908	Note:
27Jun16 / 21Sep16	

FRAMING

Inv.611	1 - GREAT ROOM: DRYWALL OVER FIREPLACE BUMP-OUT, LEAVE FLUSH WALL IN GREAT ROOM. See plan for location.
Line9038	Note:
27Jun16 / 21Sep16	
Inv.611	8 - FRAME MAIN FLOOR DOORS AT 96 INCH - ADDED WITH THE ADDITION OF TALLER INTERIOR DOORS
Line7604	Note:
27Jun16 / 21Sep16	
Inv.611	4 - FRAME MAIN FLOOR ARCHES AT 96 INCH
Line7608	Note:
27Jun16 / 21Sep16	
Inv.611	1 - GREAT ROOM/BREAKFAST: Install a 2-sided gas fireplace, in lieu of standard gas fireplace. (Price incl. fireplace, venting, gas connection, framing, tape drywall, paint, & req'd electrical & thermostat). Marble not included. See plan/sketch for location.
Line10186	Note:
27Jun16 / 21Sep16	

GLASS AND MIRROR

Inv.611	1 - MASTER ENSUITE: CONVERT FRAMED SHOWER TO 10MM FRAMELESS SHOWER ENCLOSURE WITH DOOR AND 10MM SIDE PANEL
Line7598	Note:
27Jun16 / 21Sep16	

HVAC

Inv.611	1 - KITCHEN: UPGRADE VENTING FOR STOVE TO 8 INCH PIPE EXTERIOR WALL
Line7555	Note:
27Jun16 / 21Sep16	

INTERIOR TRIM AND DOORS

Inv.611	4 - MAIN FLOOR: EXTENDED HEIGHT ARCHWAY (PRICE PER DOORWAY) - 96" TALL.
Line7606	Note:
27Jun16 / 21Sep16	

Kleinburg Glen - 69 - 1 - 38-5 Elev.A ROSEMONT

Inv.611	8 - MAIN FLOOR: STANDARD DOOR EXTENDED HEIGHT 96 INCH (PRICE PER DOOR) - GROUND FLOOR 2 STOREY MODELS
Line7607	Note:
27Jun16 / 21Sep16	

MISC.

Inv.611	1 - Purchasers are aware & accepts that ANY changes made to upgrades after signing this Purchasers Extra Form are subject to a minimum administration fee of \$500. PLUS a 10% holdback fee.
Line9034	Note:
27Jun16 / 21Sep16	

Inv.611	1 - Purchaser has attended a Structural appointment at the Decor Centre & has DECLINED any additional upgrades and accepts and acknowledges that there will be no further structural changes/additions/deletions to be made upon signing on July 21, 2016.
Line9033	Note:
27Jun16 / 21Sep16	

Inv.611	1 - BONUS PACKAGE: \$7,500.00 (INCLUDING TAXES) WORTH OF UPGRADES FROM GOLD PARK HOMES DÉCOR CENTRE IS BEING APPLIED TOWARD THE STRUCTURAL APPOINTMENT. PURCHASER HAS A REMAINING AMOUNT OF \$00 (INCLUDING TAXES) TO BE USED TOWARD THE COLOUR APPOINTMENT.
Line9035	Note:
27Jun16 / 21Sep16	

PLUMBING

Inv.611	1 - BASEMENT: In addition to the builder's standard laundry room on main floor, Install extra laundry room in basement. Includes Laundry tub and rough-in for washer/dryer. See plan for *requested* location.
Line7543	Note:
27Jun16 / 21Sep16	

Inv.611	1 - MASTER ENSUITE: *REQUEST* standard shower arm to be located approx. 78" A.F.F.
Line7603	Note:
27Jun16 / 21Sep16	

WINDOWS - BASEMENT

Inv.611	1 - BASEMENT WINDOWS - UPGRADE EXISTING BASEMENT WINDOW TO 30 INCH X 24 INCH - MAY REQUIRE INSTALLATION OF WINDOW WELL. See plan for location (not all windows)
Line7602	Note:
27Jun16 / 21Sep16	




Elevation A • 2,861 sq.ft.

Elevation B • 2,861 sq.ft.

Lot 69  
July 21 2016


920

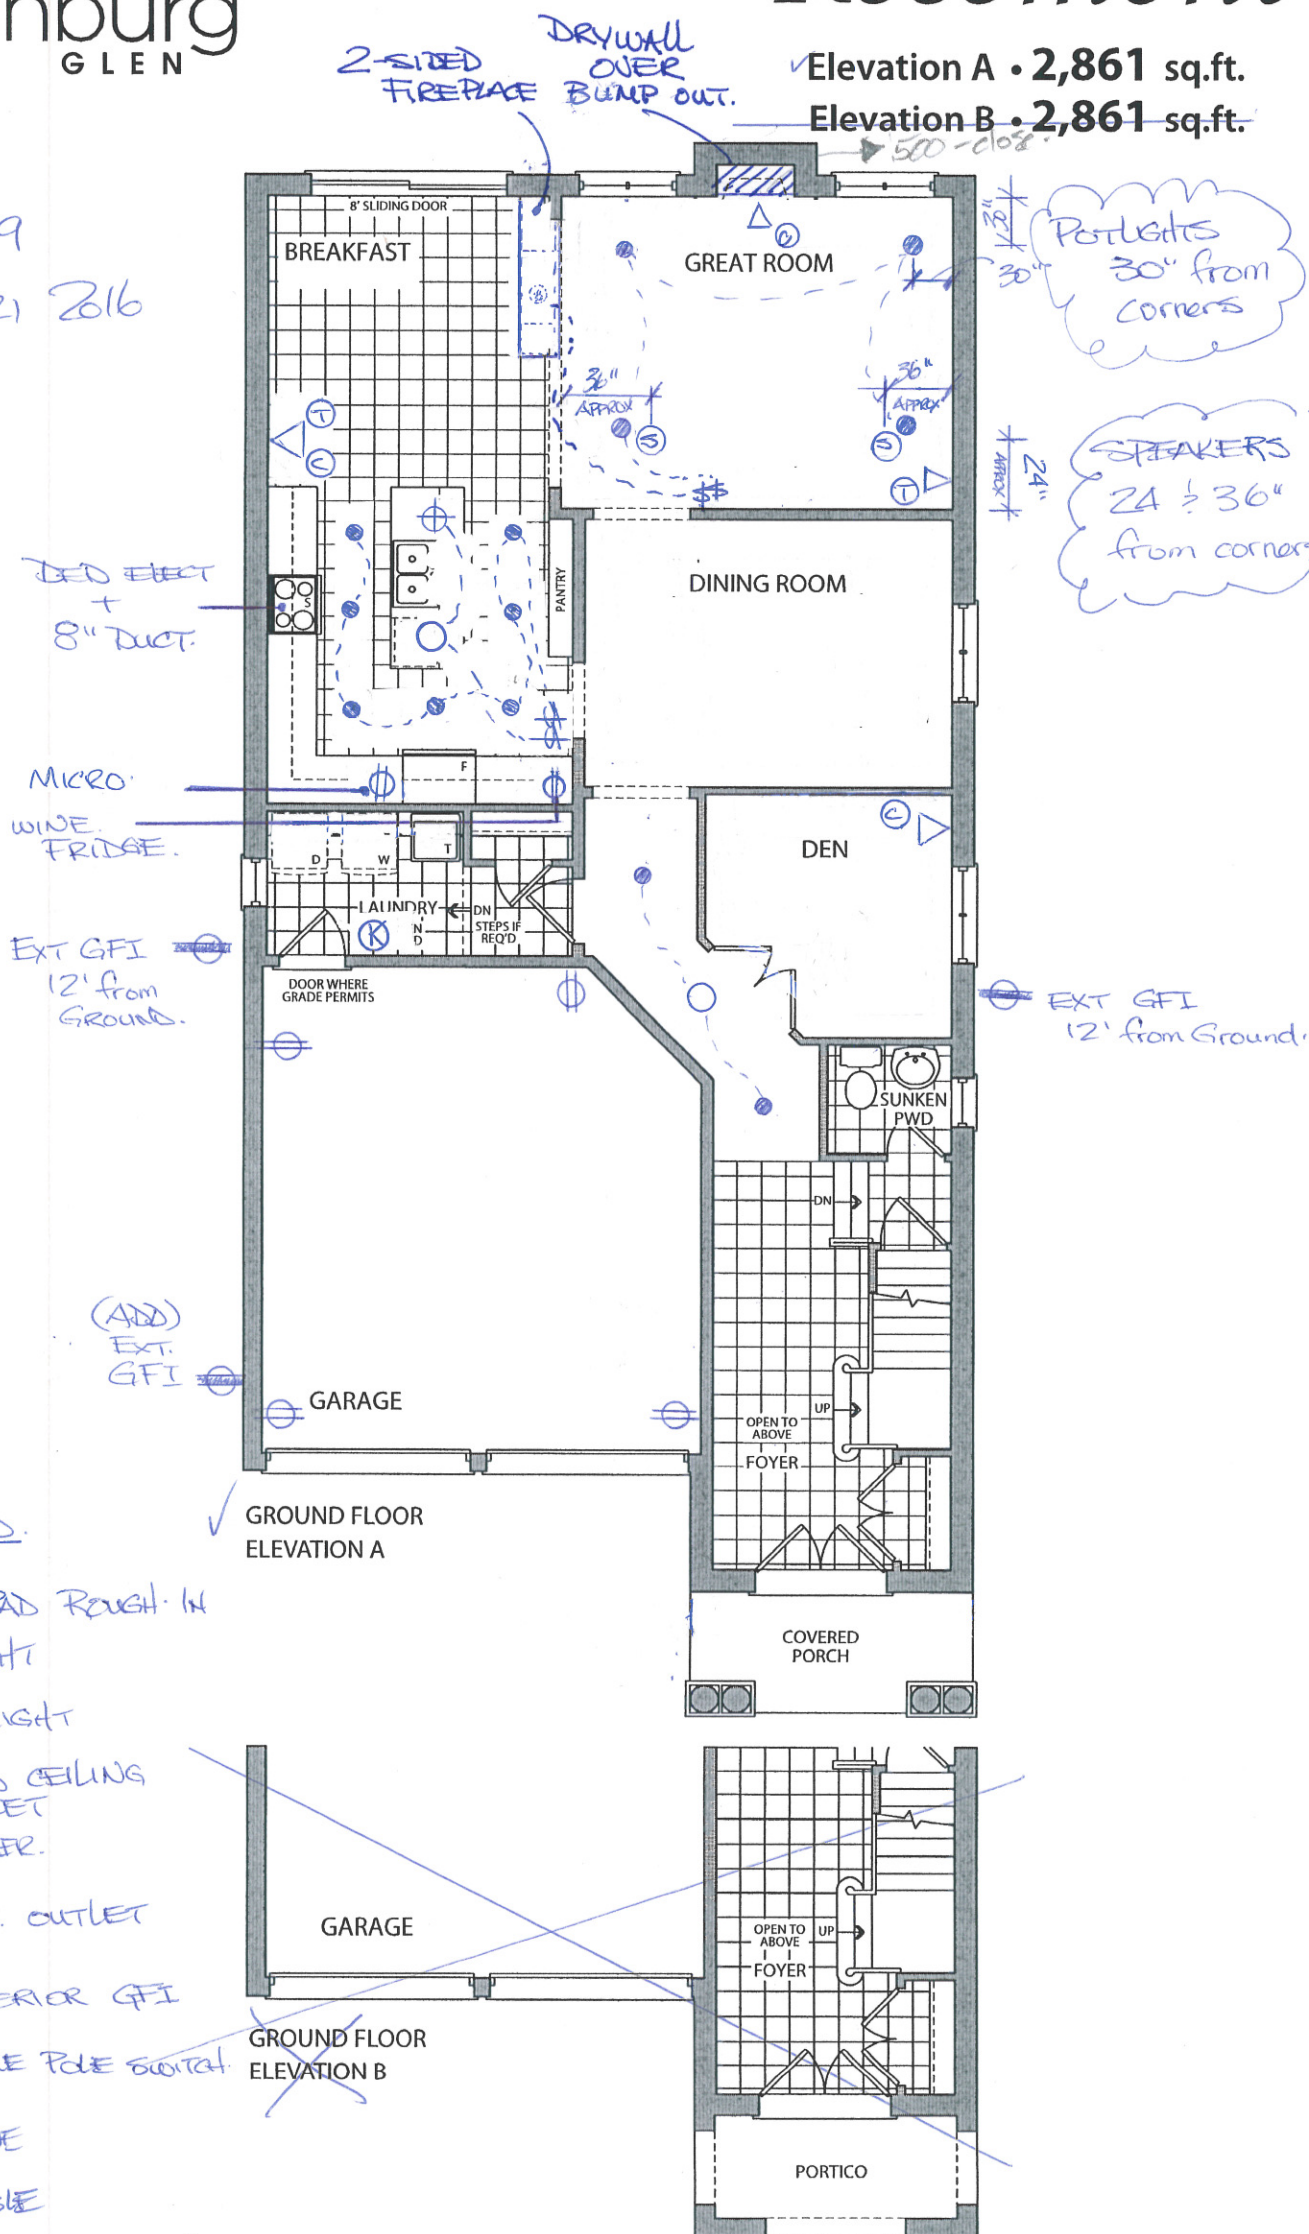


LEGEND.

- Ⓚ KEY PAD Rough IN
- Potlight
- STD LIGHT
- ⊕ CAPPED CEILING OUTLET
- Ⓢ SPEAKER
- ⊕ ELECT. OUTLET
- ⊕ EXTERIOR GFI
- ⚡ SINGLE POLE SWITCH
- △ PHONE
- △ CABLE
- //// - INSULATE WALL.


Prices, figures, illustrations, sizes, features and finishes are subject to change without notice. E.&O.E. Areas and dimensions are approximate and actual usable floor space may vary from the stated area. Layout may be reverse of the unit purchased. E. & O.E.

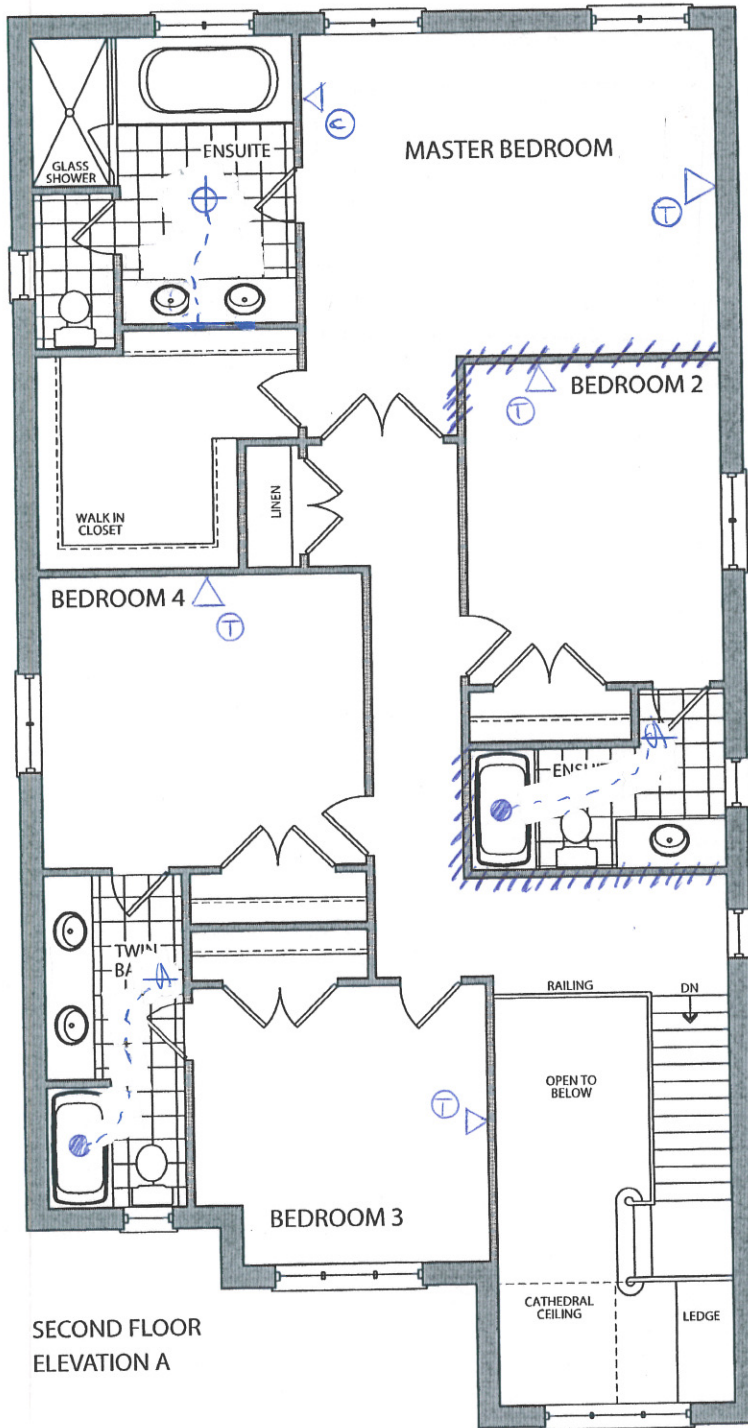

LOT 69  
JULY 21 2016  
~~Ad.~~

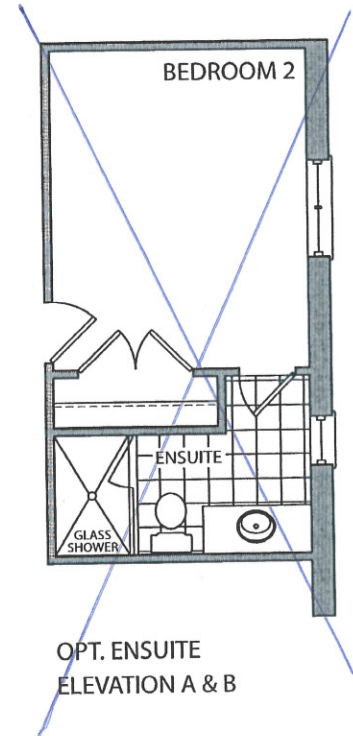

//// = INSULATE  
wall

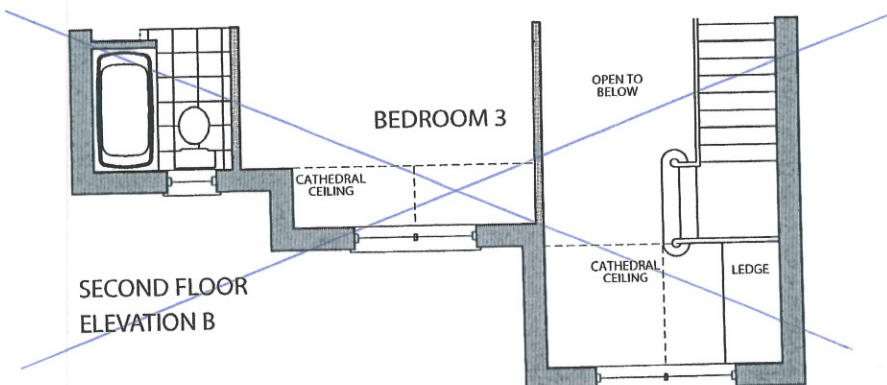




LOT 69  
JULY 21 2016

~~40~~

LARGER  
24x30" →  
(ONLY this ONE)

\*PREFERRED\*  
LAUNDRY  
LOCATION

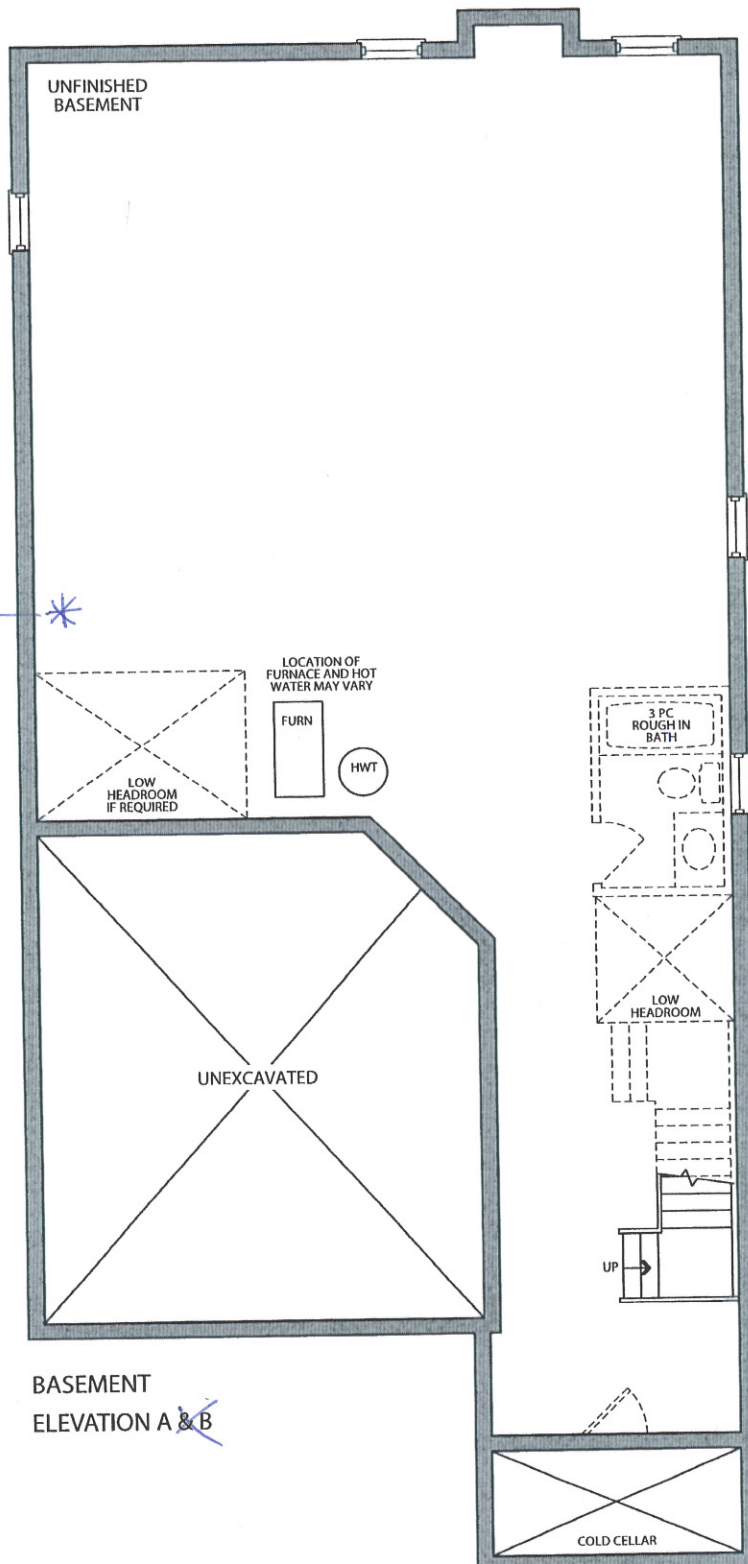



Stacey Carlete  
Project Coordinator



Claude Azzopardi  
Contracts Manager



Nancy Martini  
Corporate Controller



38.1 The Hampton			
Elevation	Circle One	A	2339.9 Square Feet
		B	2327.8 Square Feet
Taller Ceilings	Circle All that Apply	GFTC	9' Ceilings Ground Floor
		MFTC	10' Ceilings Main Floor
		SFTC	9' Ceilings Second Floor
Optional Layouts	Circle All that Apply		

38.2 The Kingston			
Elevation	Circle One	A	2445.9 Square Feet
		B	2445.9 Square Feet
Taller Ceilings	Circle All that Apply	GFTC	9' Ceilings Ground Floor
		MFTC	10' Ceilings Main Floor
		SFTC	9' Ceilings Second Floor
Optional Layouts	Circle All that Apply	SFA1	SECOND FLOOR Shower in Lieu of Tub (Bedroom 2)

38.3 The Birkdale			
Elevation	Circle One	A	2574.1 Square Feet
		B	2575.5 Square Feet
Taller Ceilings	Circle All that Apply	GFTC	9' Ceilings Ground Floor
		MFTC	10' Ceilings Main Floor
		SFTC	9' Ceilings Second Floor
Optional Layouts	Circle All that Apply	SFA1	SECOND FLOOR Shower in Lieu of Tub (Bedroom 2)

38.4 The Bridgeport			
Elevation	Circle One	A	2723.2 Square Feet
		B	2762.0 Square Feet
Taller Ceilings	Circle All that Apply	GFTC	9' Ceilings Ground Floor
		MFTC	10' Ceilings Main Floor
		SFTC	9' Ceilings Second Floor
Optional Layouts	Circle All that Apply	SFA3	SECOND FLOOR Shower in Lieu of Tub (Twin Bath)

38.5 The Rosemont			
Elevation	Circle One	A	2804.9 Square Feet
		B	2804.5 Square Feet
Taller Ceilings	Circle All that Apply	GFTC	9' Ceilings Ground Floor
		MFTC	10' Ceilings Main Floor
		SFTC	9' Ceilings Second Floor
Optional Layouts	Circle All that Apply	SFA1	SECOND FLOOR Shower in Lieu of Tub (Bedroom 2)
		SFA3	SECOND FLOOR Shower in Lieu of Tub (Twin Bath)
		SFA5	SECOND FLOOR Additional Bedroom

38.6 The Wyndham			
Elevation	Circle One	A	2893.5 Square Feet
		B	2896.0 Square Feet
Taller Ceilings	Circle All that Apply	GFTC	9' Ceilings Ground Floor
		MFTC	10' Ceilings Main Floor
		SFTC	9' Ceilings Second Floor
Optional Layouts	Circle All that Apply	SFA1	SECOND FLOOR Shower in Lieu of Tub (Bedroom 2)
		SFA3	SECOND FLOOR Shower in Lieu of Tub (Twin Bath)
		SFA5	SECOND FLOOR Additional Bedroom

LOT 69



JULY 21 2016