

Kleinburg Glen - 70 - 1 - 42-5 Elev.B MADISON- SFA5

DRYWALL

Inv.580	1 - SMOOTH CEILINGS - (2 - Story Design) 2ND FLOOR
Line7080	Note:
16Jun16 / 22Sep16	

ELECTRICAL

Inv.580	1 - KITCHEN - In addition to builders standard ceiling light, Install (2) ROUGH - IN CEILING OUTLETs & SWITCH (WITH COVER PLATE) - DOES NOT INCLUDE FIXTURE. Both Rough-ins on same switch. Locate approx. center above island, see plan for location.
Line7079	Note:
16Jun16 / 22Sep16	

Inv.580	1 - KITCHEN: 110V WALL RECEPTACLE ON DEDICATED CIRCUIT - GAS FIRED APPLIANCE - FOR AUX. EQUIPMENT - NOT A STOVE PLUG
Line9173	Note:
16Jun16 / 22Sep16	

EXTERIOR COLOURS

Inv.843	1 - EXTERIOR COLOUR PACKAGE 10
Line11739	Note:
22Sep16 / 22Sep16	

FRAMING

Inv.580	1 - MAIN FLOOR CEILING 10FT: TALLER FRONT DOOR WITH EXTRA TRANSOM, 8' INTERIOR DOORS, TALLER FLAT ARCHES, TALLER FRONT AND REAR ELEVATION WINDOWS, 12" BULK IN KITCHEN WITH CROWN AND FURRING PANEL
Line9174	Note:
16Jun16 / 22Sep16	

Inv.844	1 - OPTIONAL 5 BEDROOM PLAN
Line11740	Note:
22Sep16 / 22Sep16	

HVAC

Inv.580	1 - KITCHEN: Install a GAS LINE ROUGH - GROUND FLOOR, for future gas stove
Line7083	Note:
16Jun16 / 22Sep16	

INTERIOR TRIM AND DOORS

Inv.580	1 - MAIN FLOOR CEILING 10FT: TALLER FRONT DOOR WITH EXTRA TRANSOM, 8' INTERIOR DOORS, TALLER FLAT ARCHES, TALLER FRONT AND REAR ELEVATION WINDOWS, 12" BULK IN KITCHEN WITH CROWN AND FURRING PANEL
Line11737	Note:
16Jun16 / 22Sep16	

KITCHEN AND BATH CABINETRY

Inv.580	1 - MAIN FLOOR CEILING 10FT: TALLER FRONT DOOR WITH EXTRA TRANSOM, 8' INTERIOR DOORS, TALLER FLAT ARCHES, TALLER FRONT AND REAR ELEVATION WINDOWS, 12" BULK IN KITCHEN WITH CROWN AND FURRING PANEL
Line11738	Note:
16Jun16 / 22Sep16	

MISC.

Kleinburg Glen - 70 - 1 - 42-5 Elev.B MADISON- SFA5

Inv.580	1 - Purchasers are aware & accepts that ANY changes made to upgrades after signing this Purchasers Extra Form are subject to a minimum administration fee of \$500. PLUS a 10% holdback fee.
Line9171	Note:
16Jun16 / 22Sep16	
Inv.580	1 - STRUCTURAL & C/CHART DISCLAIMER: Purchaser has attended a Structural appointment at the Decor Centre & has DECLINED any additional upgrades and accepts and acknowledges that there will be no further structural changes/additions/deletions to be made upon
Line9170	Note:
16Jun16 / 22Sep16	
Inv.580	1 - BONUS PACKAGE: \$10,000.00 (INCLUDING TAXES) WORTH OF UPGRADES FROM GOLD PARK HOMES DÉCOR CENTRE IS BEING APPLIED TOWARD THE STRUCTURAL APPOINTMENT. PURCHASER HAS A REMAINING AMOUNT OF \$00 (INCLUDING TAXES) TO BE USED TOWARD THE COLOUR APPOINTMENT.
Line9172	Note:
16Jun16 / 22Sep16	

PLUMBING

Inv.580	1 - ROUGH - IN - WATERLINE FOR FRIDGE
Line7086	Note:
16Jun16 / 22Sep16	

WINDOWS - BASEMENT

Inv.580	1 - BASEMENT WINDOWS - EXTRA BASEMENT WINDOW 30 INCH X 24 INCH - MAY REQUIRE INSTALLATION OF WINDOW WELL
Line7077	Note:
16Jun16 / 22Sep16	

WINDOWS AND DOORS

Inv.580	1 - MAIN FLOOR CEILING 10FT: TALLER FRONT DOOR WITH EXTRA TRANSOM, 8' INTERIOR DOORS, TALLER FLAT ARCHES, TALLER FRONT AND REAR ELEVATION WINDOWS, 12" BULK IN KITCHEN WITH CROWN AND FURRING PANEL
Line11736	Note:
16Jun16 / 22Sep16	



Elevation A • 3,622 sq.ft.

✓ Elevation B • 3,623 sq.ft.

LOT 70
JULY 25 2016

go



* 10' ceiling
main floor

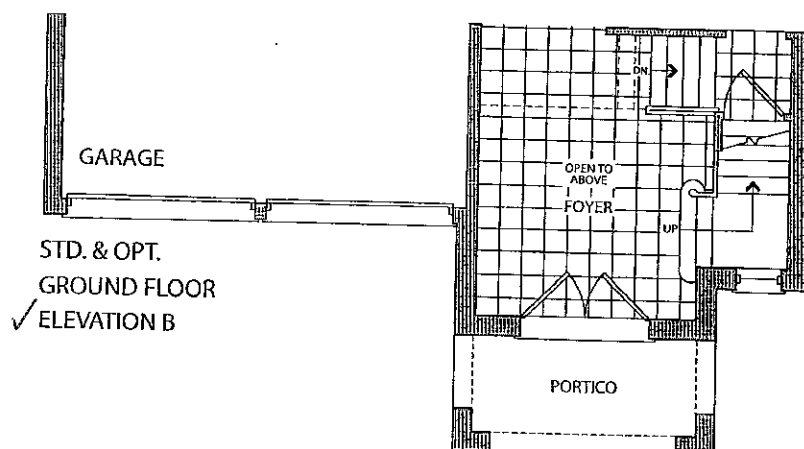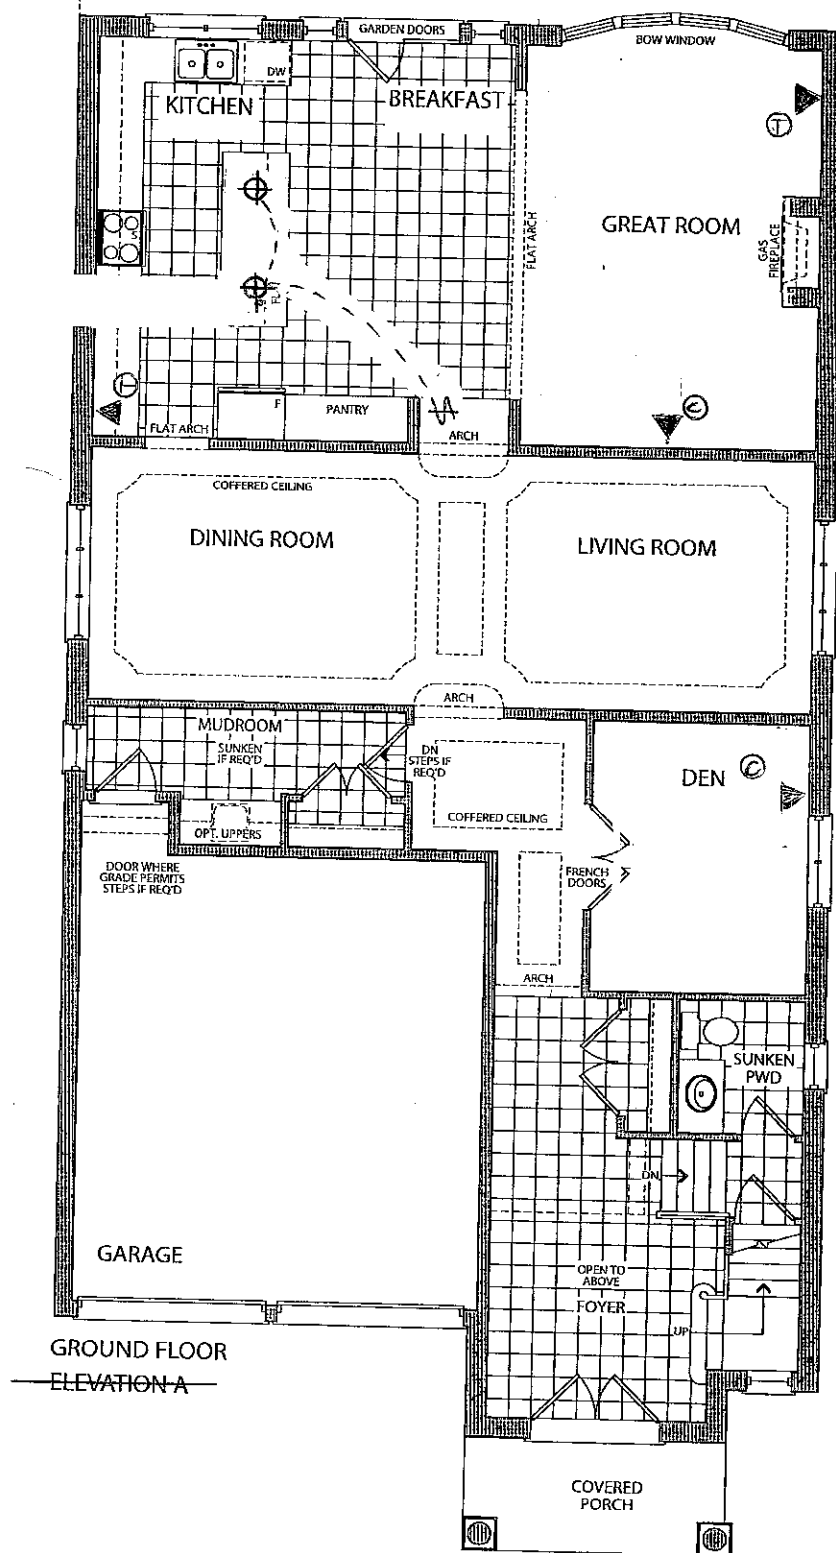

~~Elevation A • 3,622 sq.ft.~~

✓ Elevation B • 3,623 sq.ft.

LOT 70
July 25, 2016
⊗

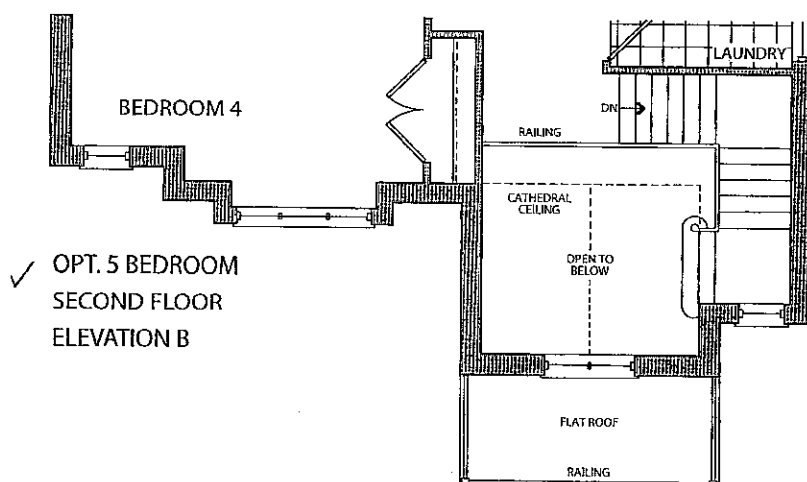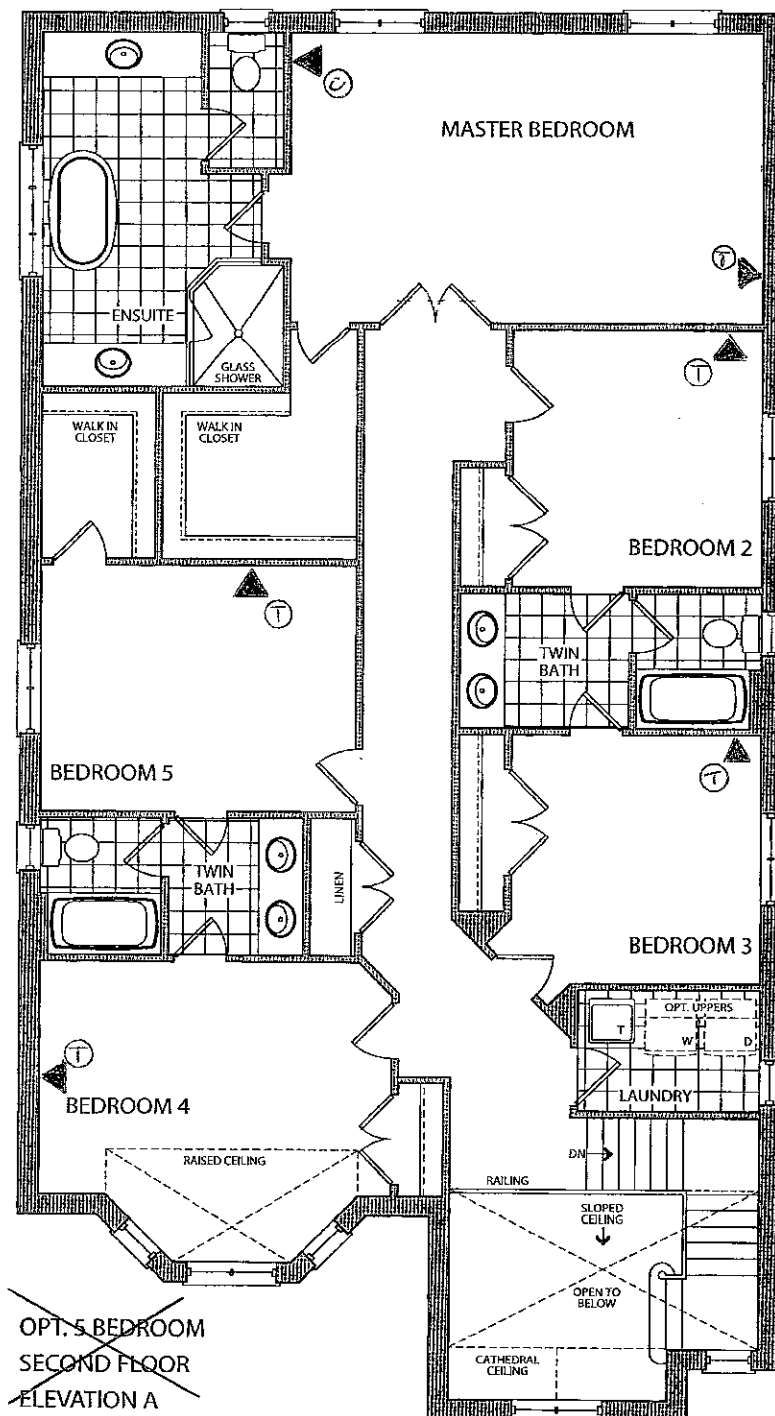


Lot 70

July 25 2016



* WALK-OUT
BASEMENT *

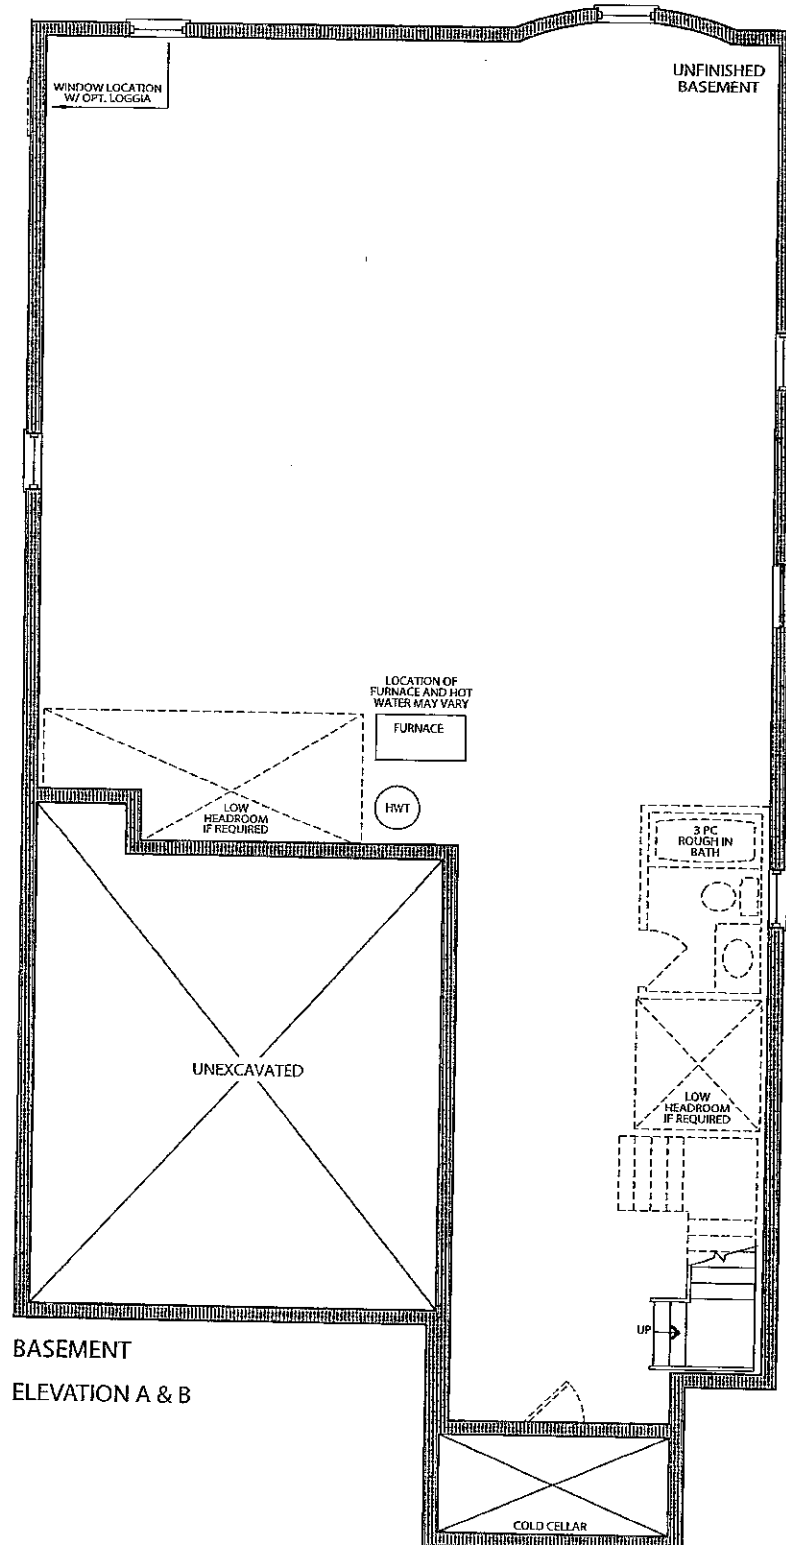

* ADD WINDOW.
30x21"

BASEMENT
ELEVATION A & B



Stacey Carlete
Project Coordinator



Claude Azzopardi
Contracts Manager



Nancy Martini
Corporate Controller



42.1 The Royalton			
Elevation	Circle One	A	2956.7 Square Feet
		B	2983.1 Square Feet
Taller Ceilings	Circle All that Apply	GFTC	9' Ceilings Ground Floor
		MFTC	10' Ceilings Main Floor
		SFTC	9' Ceilings Second Floor
Optional Layouts	Circle All that Apply	SFA5	SECOND FLOOR Additional Bedroom

42.2 The Hazelton			
Elevation	Circle One	A	3083.8 Square Feet
		B	3083.8 Square Feet
Taller Ceilings	Circle All that Apply	GFTC	9' Ceilings Ground Floor
		MFTC	10' Ceilings Main Floor
		SFTC	9' Ceilings Second Floor
Optional Layouts	Circle All that Apply	SFA5	SECOND FLOOR Additional Bedroom

42.3 The Carlton			
Elevation	Circle One	A	3287.8 Square Feet
		B	3295.5 Square Feet
Taller Ceilings	Circle All that Apply	GFTC	9' Ceilings Ground Floor
		MFTC	10' Ceilings Main Floor
		SFTC	9' Ceilings Second Floor
Optional Layouts	Circle All that Apply	SFA5	SECOND FLOOR Additional Bedroom

42.4 The National			
Elevation	Circle One	A	3371.7 Square Feet
		B	3371.7 Square Feet
Taller Ceilings	Circle All that Apply	GFTC	9' Ceilings Ground Floor
		MFTC	10' Ceilings Main Floor
		SFTC	9' Ceilings Second Floor
Optional Layouts	Circle All that Apply	SFA5	SECOND FLOOR Additional Bedroom

42.5 The Madison			
Elevation	Circle One	A	3550.9 Square Feet
		B	3551.9 Square Feet
Taller Ceilings	Circle All that Apply	GFTC	9' Ceilings Ground Floor
		MFTC	10' Ceilings Main Floor
		SFTC	9' Ceilings Second Floor
Optional Layouts	Circle All that Apply	GFA1	GROUND FLOOR Alternative Layout Kitchen/Family Room
		SFA5	SECOND FLOOR Additional Bedroom

LOT 70
JUL 25 2016